


- WATER NOTES:**
1. WATER DISTRIBUTION SYSTEM MATERIAL AND CONSTRUCTION SHALL CONFORM TO THE CITY OF ROCKWALL STANDARDS.
 2. CONCRETE BLOCKING SHALL BE INSTALLED AT ALL BENDS, VALVES, AND FIRE HYDRANTS. ALL CHANGES IN DIRECTION SHALL BE RESTRAINED BY MEGA LUG OR APPROVED EQUAL.
 3. ALL MAINS SHALL BE BURIED A MINIMUM DEPTH OF 42" BELOW TOP OF ADJACENT CURB OR AS DIRECTED BY THE ENGINEER.
 4. WATER PIPE SHALL BE PVC CLASS 200 DR14.
 5. CONTRACTOR SHALL NOTIFY ALL UTILITY COMPANIES PRIOR TO COMMENCING CONSTRUCTION. DAMAGE TO EXISTING UTILITIES SHALL BE REPAIRED AT CONTRACTOR'S EXPENSE.
 6. ALL FIRE HYDRANTS SHALL CONFORM TO THE REQUIREMENTS OF THE CITY OF ROCKWALL. CONTRACTOR SHALL NOTIFY ROCKWALL FIRE DEPARTMENT PRIOR TO PLACING OF PIPE TO ARRANGE FOR REQUIRED INSPECTIONS.
- CONTRACTOR SHALL VERIFY ALL EXISTING INVERTS AND ELEVATIONS PRIOR TO CONSTRUCTION.



- Consultants:**
- CIVIL:**
GLENN ENGINEERING CORP.
- STRUCTURAL:**
SHW GROUP, LLP
- MEP:**
ESTES MCCLURE AND ASSOCIATES
- LANDSCAPING:**
GRUBBS RAMSEY

Final Plans for Bidding and Construction

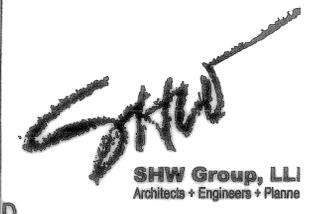

Rockwall Independent School District

AMANDA ROCHELL ELEMENTARY ADDITIONS AND RENOVATIONS

ROCKWALL, TEXAS

Project Number: 1441.04.01
 Drawing Date: 08/31/200
 Drawn: R.HOWMAI
 Checked: RA
 Scale: AS SHOWN
 ACAD File: ROCHELLE-ENG-ADD1-REV
 © 2004 SHW Group, LLP

- Revisions:**
- | | | |
|---|------------|---------------|
| 1 | 10/12/2004 | CITY COMMENTS |
| 2 | 11/8/2004 | CITY COMMENTS |
| 3 | 11/23/2004 | CITY COMMENTS |


APPROVED FOR CONSTRUCTION
 DEC 2 2 2004
 City of Rockwall Engineering Dept.
 City Engineer: _____

Sheet Title:
UTILITY PLAN

These Drawings have been modified to conform to the Construction Records.
 Glenn Engineering Corporation
 By: _____ Date: 3.23.06

GLENN ENGINEERING
 PHONE 972-717-5191 FAX 972-717-2176
 105 DECKER COURT - SUITE 910 IRVING, TEXAS 75062

CU 1.01

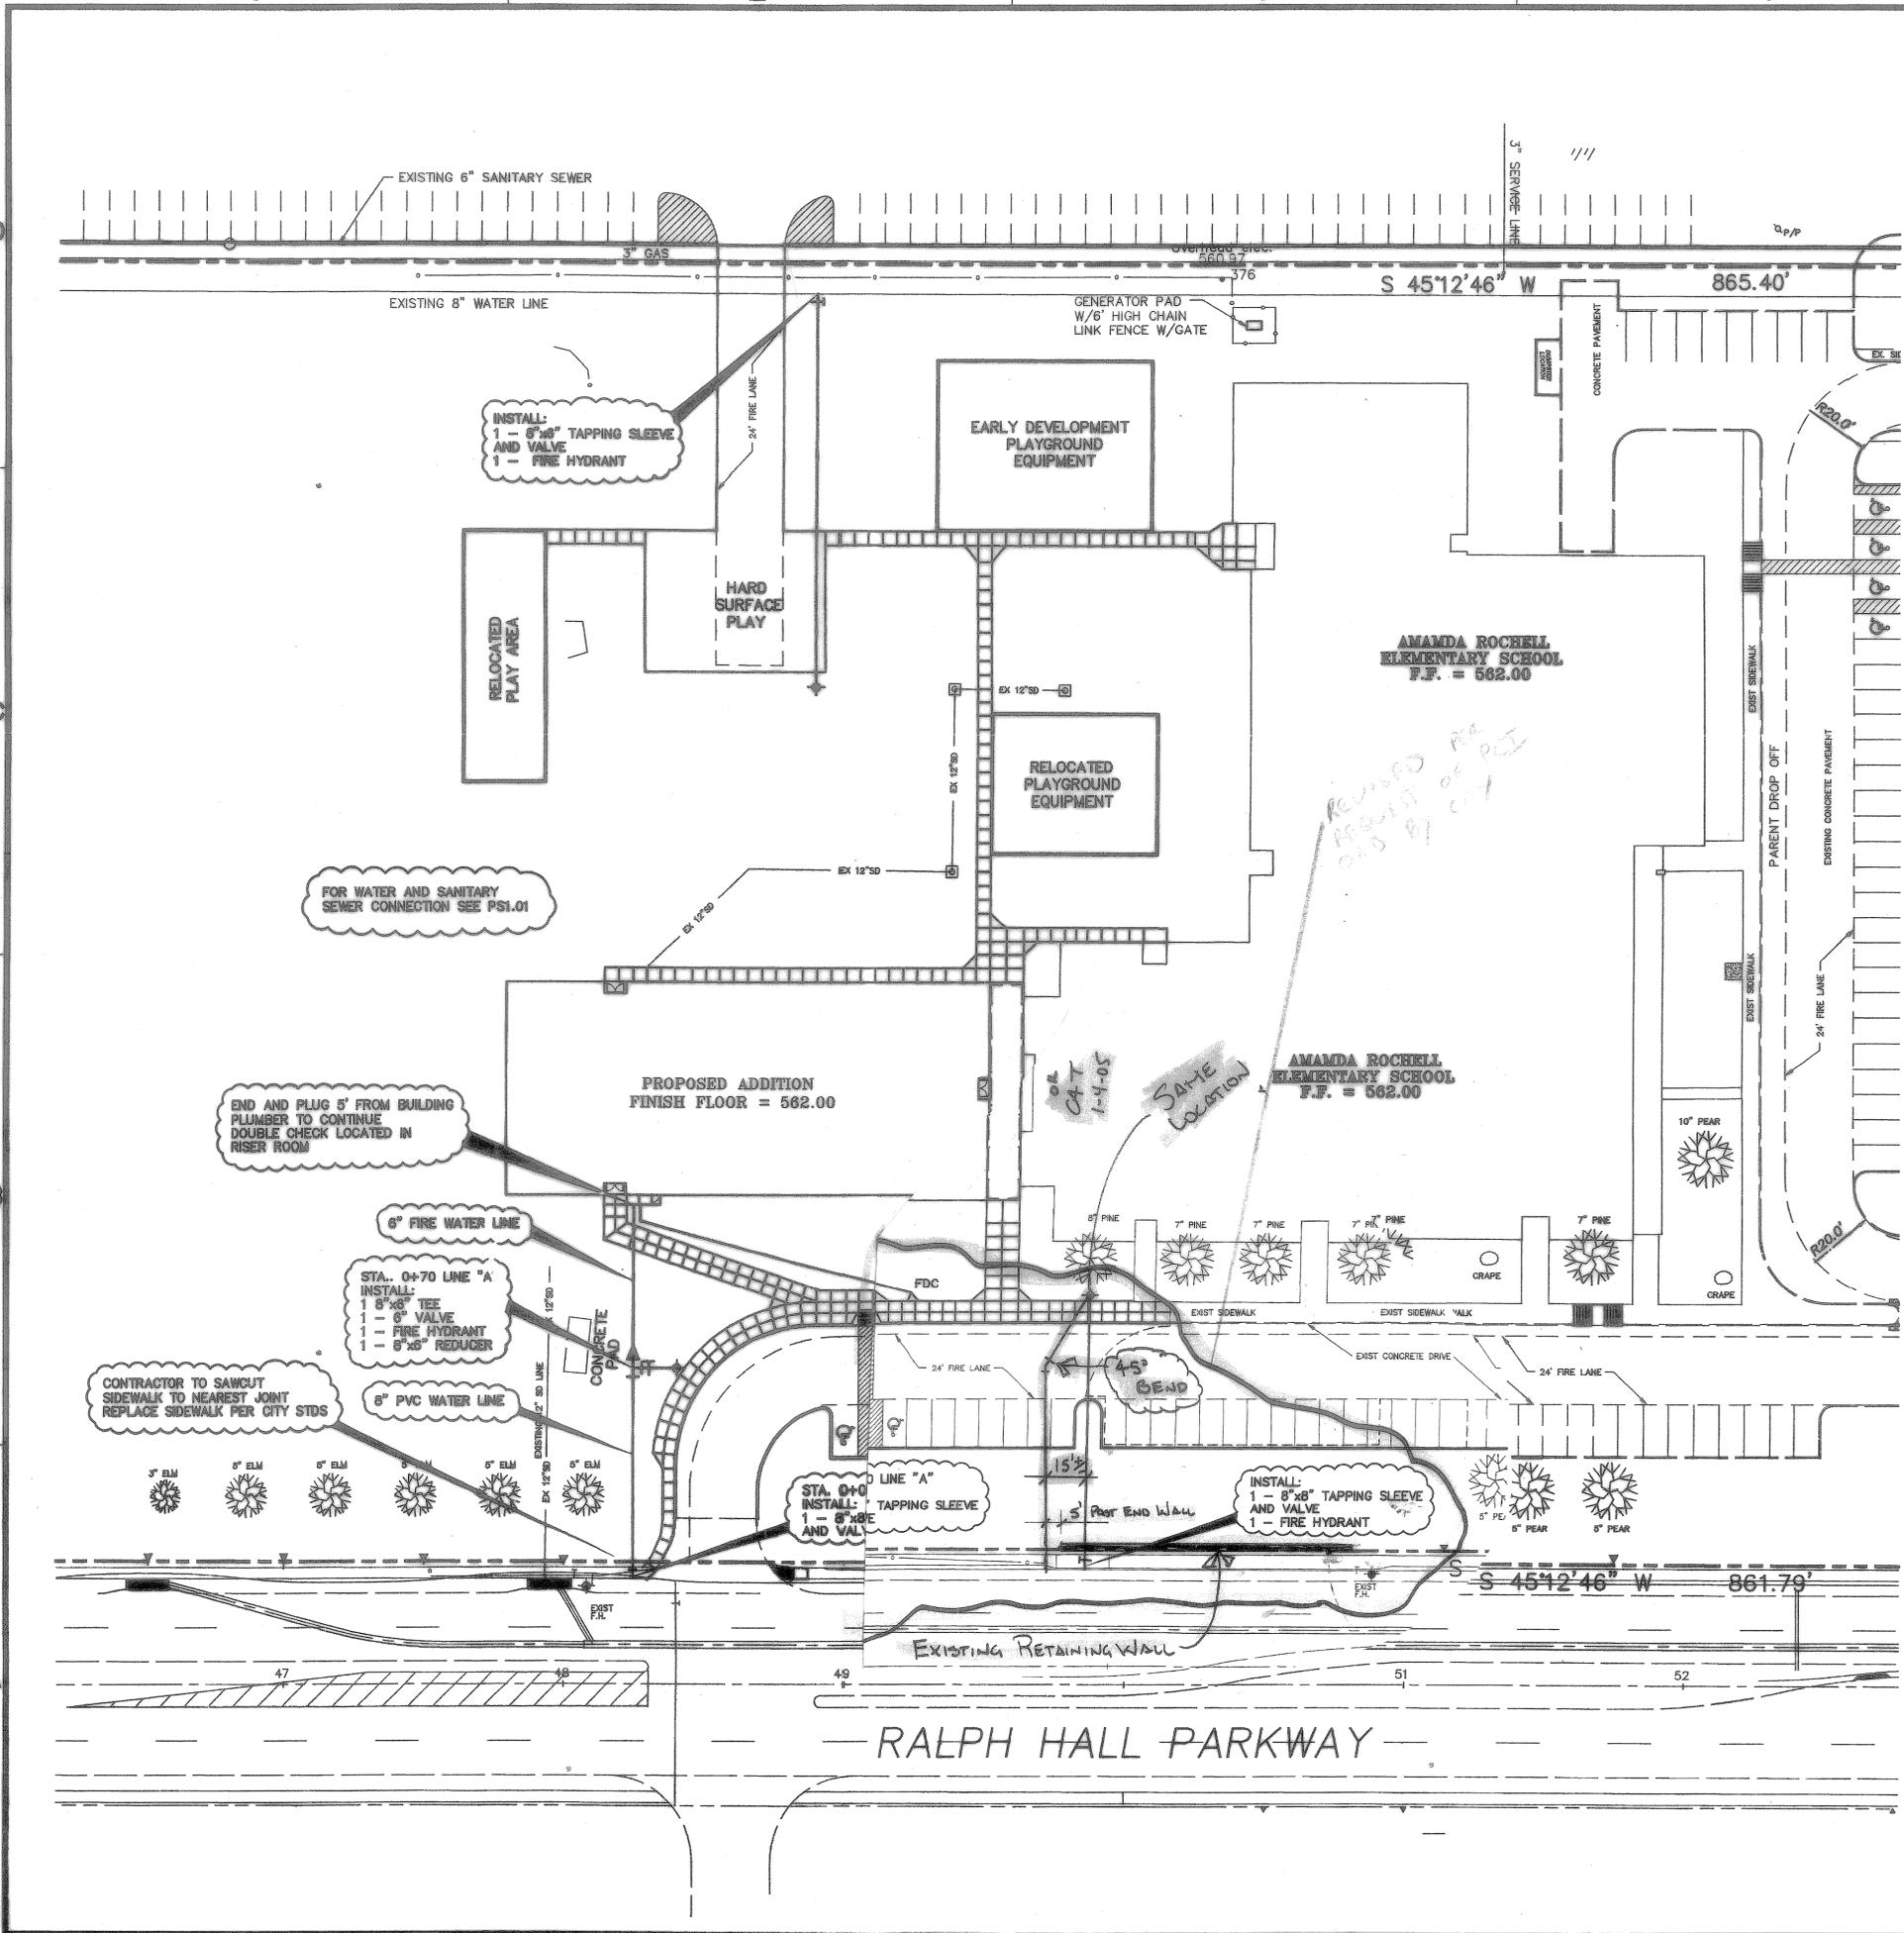

Nov 23, 2004 - 9:26am User: Rick
 \\Robert-xp\C-DRIVE\ROCKWALL\Rockel\BID-SET\ADDITION\BIDSET\ROCHELLE-ENG-ADD1-REV2.dwg
 \\Robert-xp\C-DRIVE\ROCKWALL\Rockel\BID-SET\ADDITION\BIDSET\ROCHELLE-ENG-ADD1-REV2.dwg, 1/23/2004 10:29:38 AM, Rick