


CAUTION !!
 UNDERGROUND GAS MAIN IN THIS AREA. CONTACT JOE CABEZUELA w/ LONE STAR GAS COMPANY • (214)873-3716 OR (214)362-0498 (PAGER) PRIOR TO CONSTRUCTION

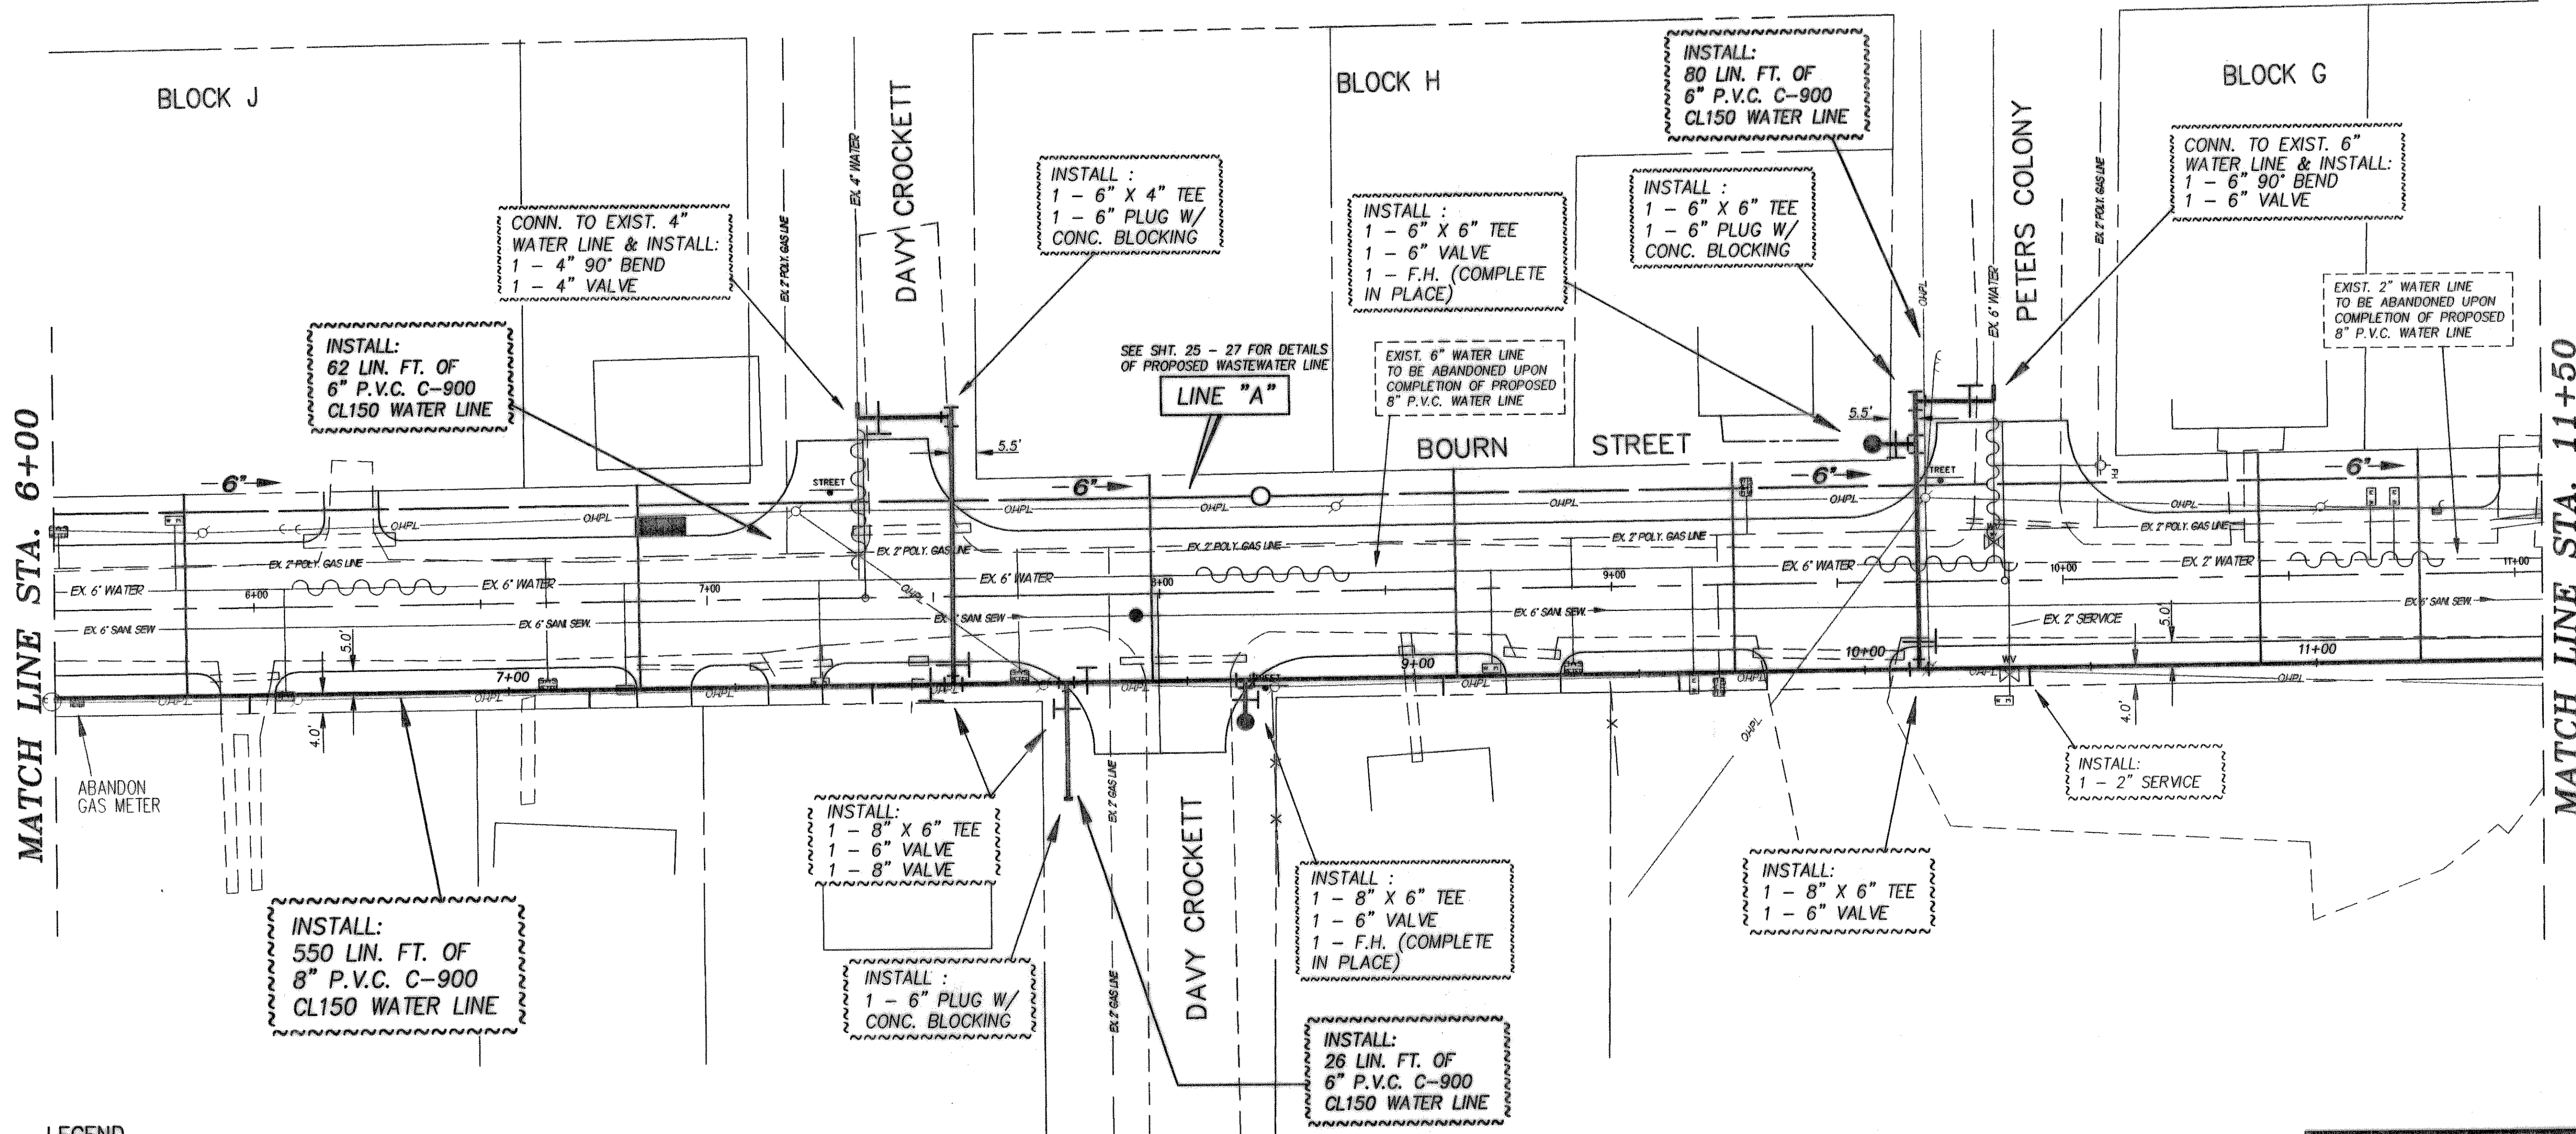

MATCH LINE STA. 6+00

MATCH LINE STA. 11+50

LEGEND

- EXISTING POWER POLE
- EXISTING TELEPHONE PEDESTAL
- EXISTING WATER METER
- EXISTING GAS METER
- EXISTING WATER VALVE
- EXISTING TELEPHONE MANHOLE
- EXISTING FIRE HYDRANT

WATER LINE IMPROVEMENTS
BOURN STREET
ROCKWALL, TEXAS
CITY OF ROCKWALL
 "THE NEW HORIZON"

REVISION NO.	REMARKS	DATE

DESIGNED:	B.W.H.	THE SEAL APPEARING ON THIS DOCUMENT WAS AUTHORIZED BY W.L. DOUPHRATE II TEXAS P.E. NO. 60102 ON 10/2/86
DRAWN:	ACAD	
JOB NO.		
DATE:	5/23/96	SHEET NO. 21 of 28

