



© 2013 la terra studio, inc. All Rights Reserved FILE:P:\12024-Downtown Rockwall PSS&E - Rockwall\CAD\SSHEETS\12024_Enlargement_Plan_key.dwg

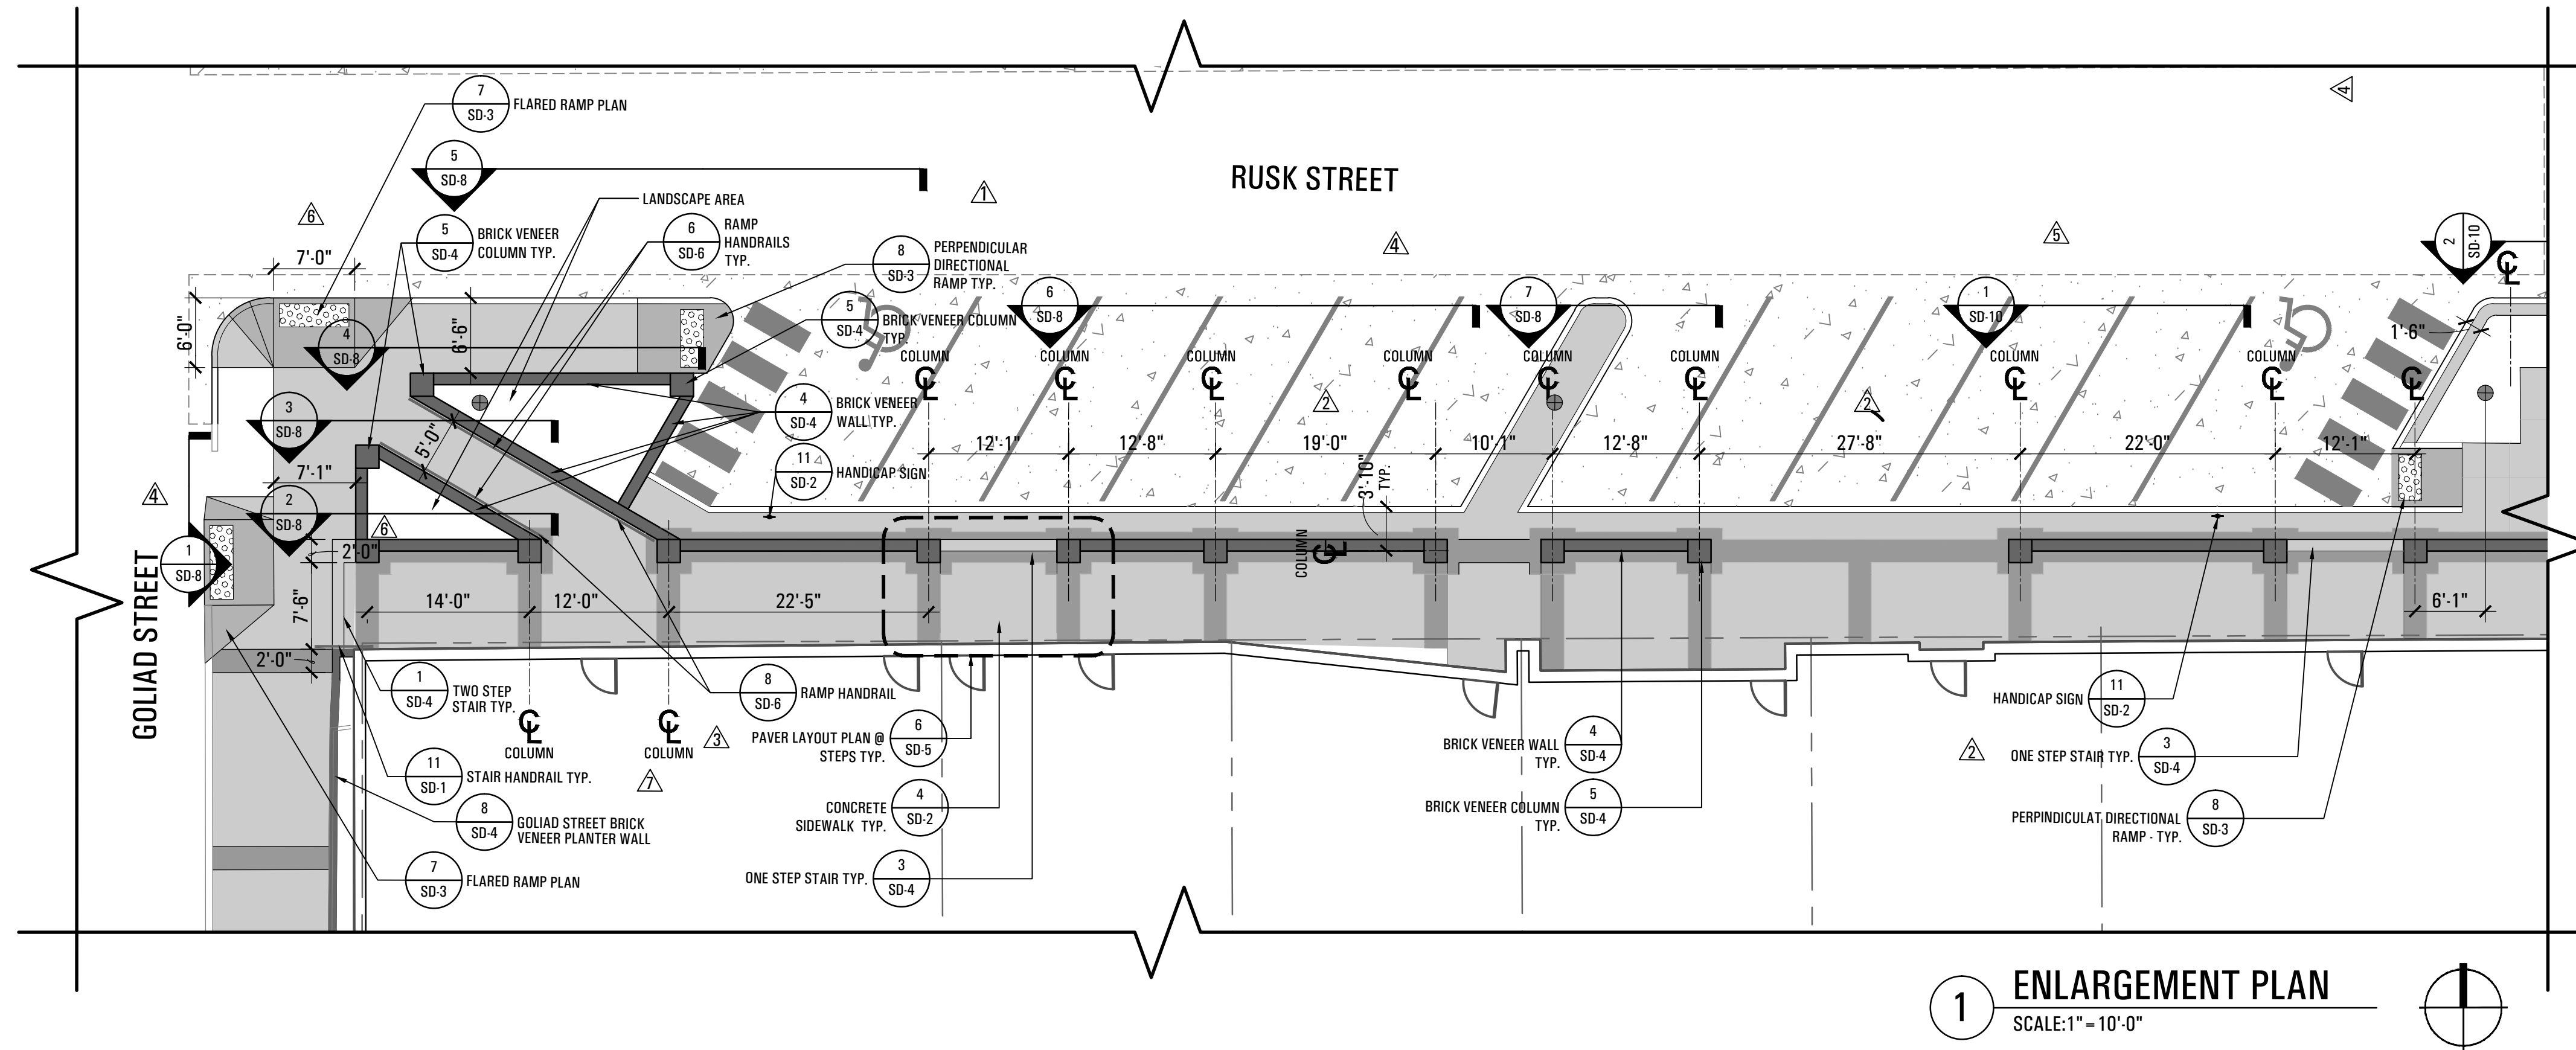

1 ENLARGEMENT PLAN
SCALE: 1" = 10'-0"

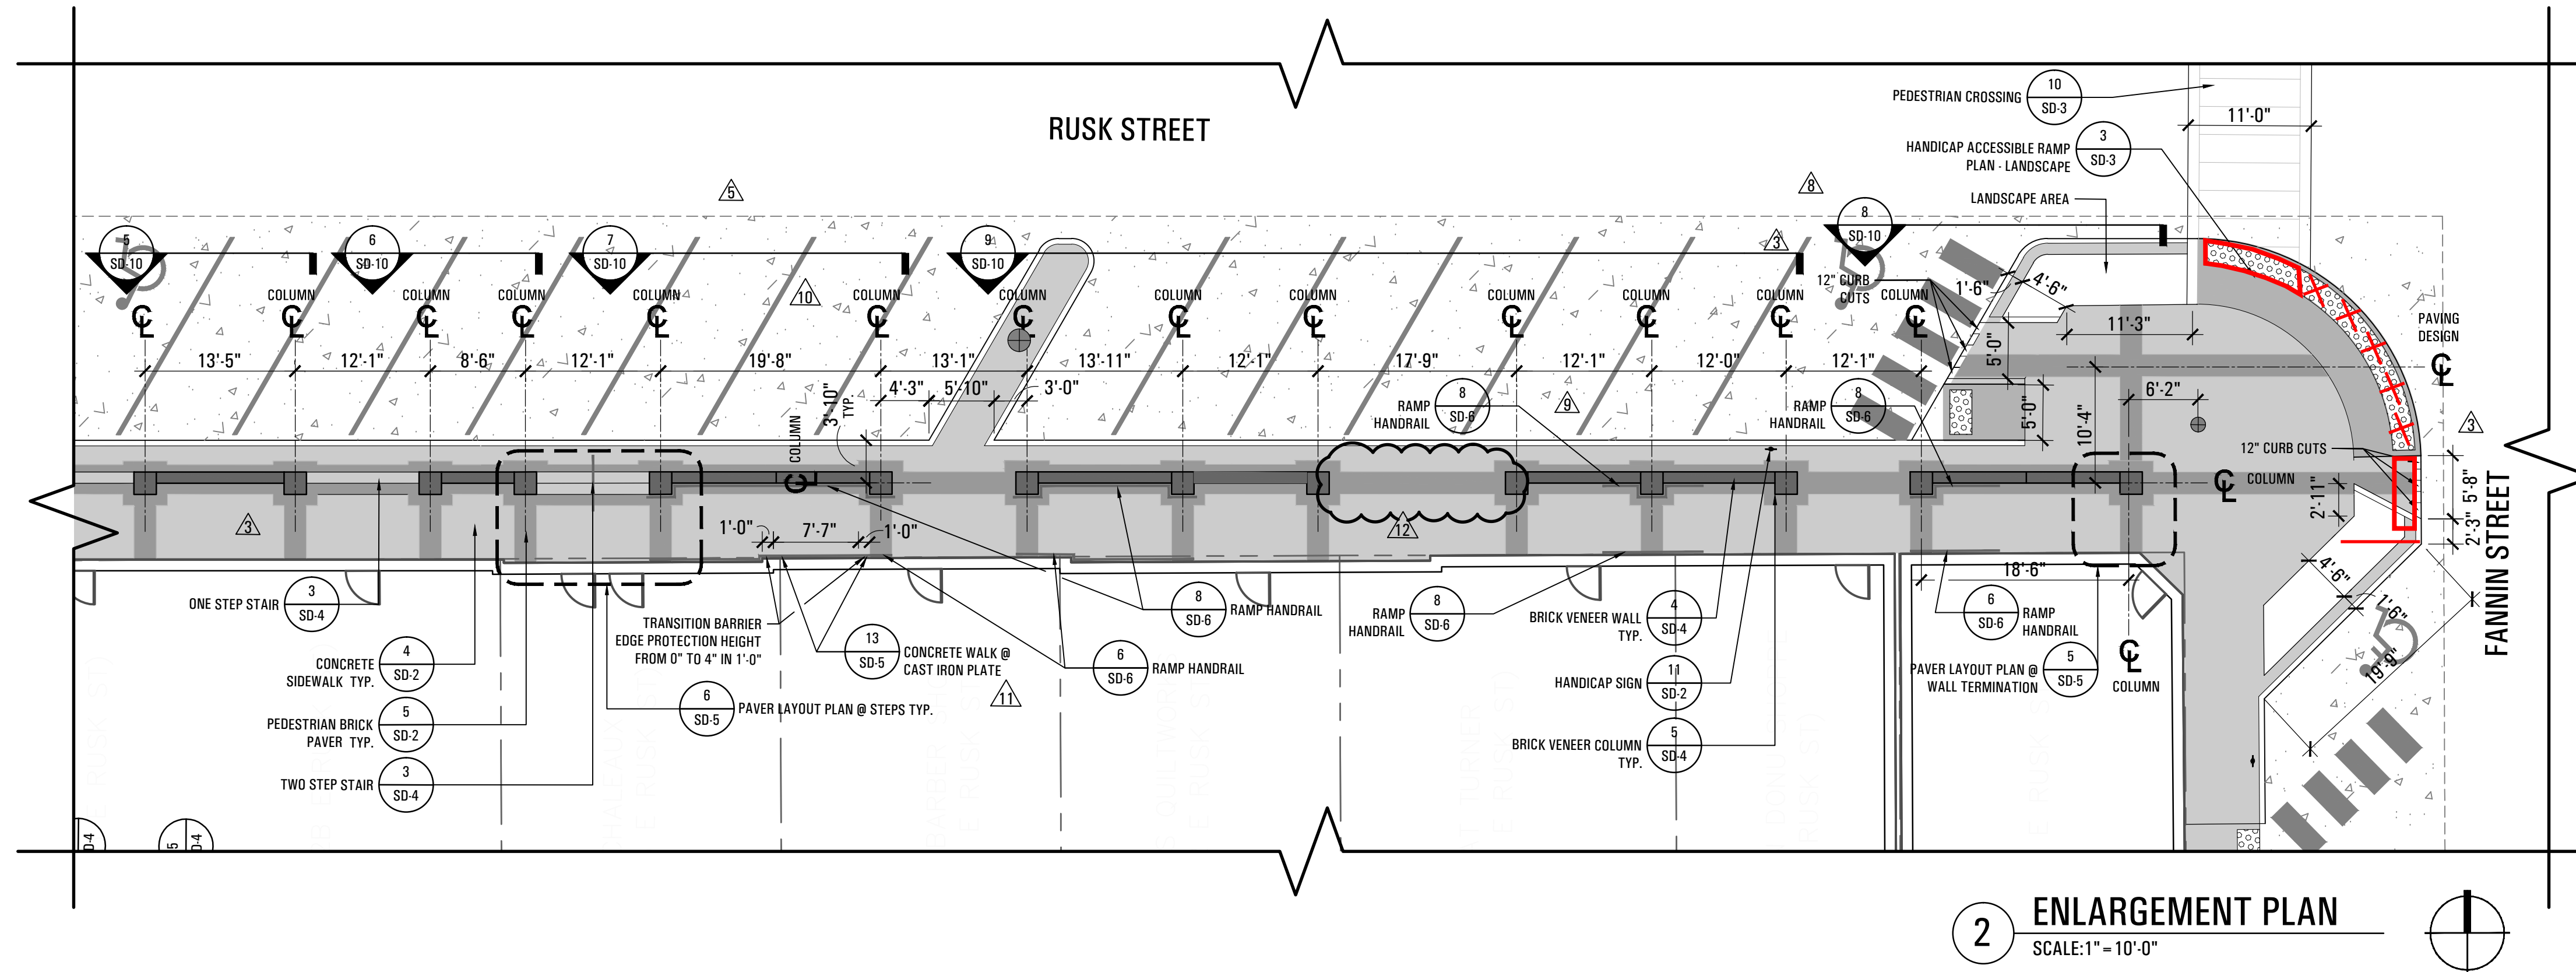

2 ENLARGEMENT PLAN
SCALE: 1" = 10'-0"

SITE PLAN LEGEND:

- EDGE OF PAVEMENT
- CONCRETE SIDEWALK PAVEMENT
- CONCRETE VEHICULAR PAVEMENT
- TYPICAL LIGHT FIXTURE

	04/27/15	RFI #177
	06/05/15	RFI #42
	07/08/15	LASI #20

no.	date	detail
	04/14/14	RFI #39
	05/02/14	RFI #77 WEST RUSK GRADING
	05/08/14	RFI #20, #38, #42, #43, #54
	06/17/14	RFI #93
	07/31/14	LASI #10
	10/27/14	RFI #140
	11/17/14	RFI #144
	11/26/14	LASI #12
	01/13/15	RFI #154

la terra studio, inc.

12024
 lts project number
 02.26.2014
 date
 rac; bhm
 drawn by
 mtb
 checked by



Enlargement Plan
 sheet number

EP-3
AS BUILT
 03/07/2016

submittals / revisions