

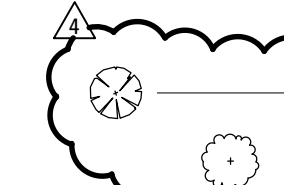


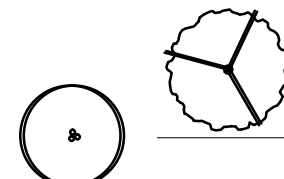



CANOPY TREES

	QNTY.	SYMBOL	COMMON NAME	BOTANIC NAME
		CP	CHINESE PISTACHE	PISTACHIA CHINENSIS
		RO	RED OAK	QUERCUS SHUMARDI

SHRUBS

	QNTY.	SYMBOL	COMMON NAME	BOTANIC NAME
		CH	CARISSA HOLLY	ILEX CORNUTA 'CARISSA'
		IH	INDIAN HAWTHORN	RHAPHIOLEPIS INDICA 'CLARA'
		MF	MEXICAN FEATHER GRASS	STIPA TENIOSSIMA


TURF

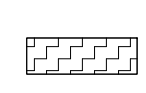	QNTY.	SYMBOL	COMMON NAME	BOTANIC NAME
		SSSAG	SOLID SOD ST. AUGUSTINE GRASS	STENOTAPHRUM SECUNDATUM
		SSBG	SOLID SOD BERMUDA GRASS	Cynodon dactylon





EXISTING TREE

	QNTY.	SYMBOL	NOTE
		PER PLAN	REFERENCE CIVIL DEMO PLANS FOR TREE PRESERVATION.

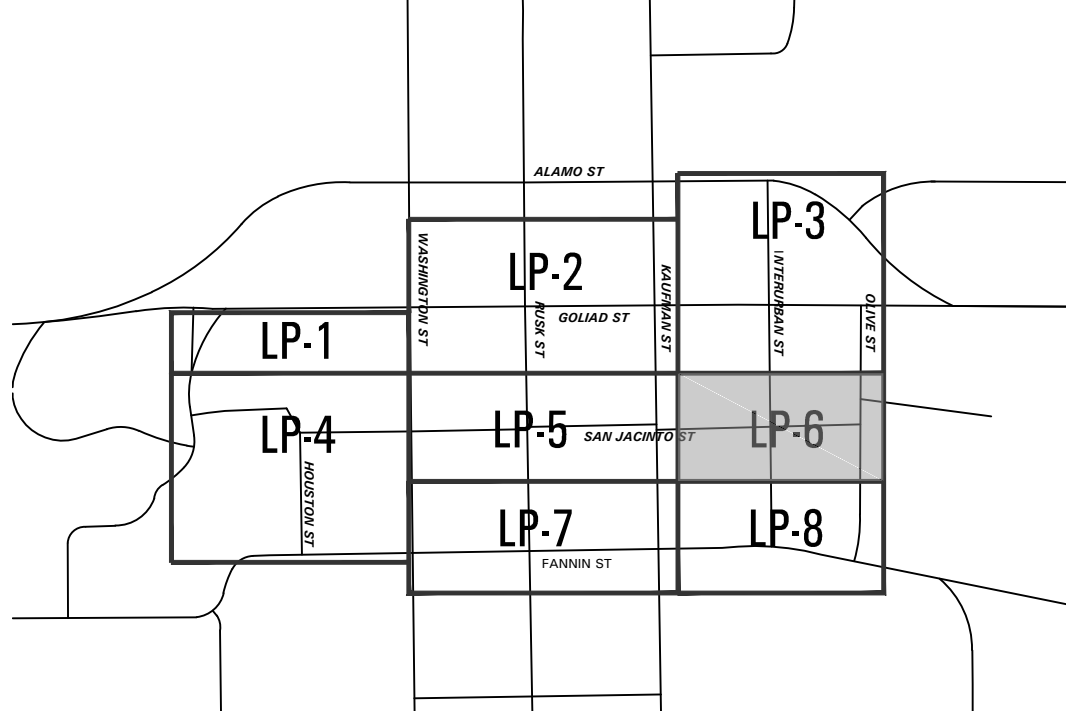sheet location

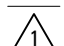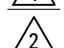


submittals / revisions

no.	date	detail
	03/11/15	RFI #162
	05/01/15	RFI #176
	07/02/15	RFI #183
	09/17/15	LASI #22

la terra studio, inc.

12024
its project number
02.26.2014
date
rac; bhm
drawn by
mtb
checked by

registration

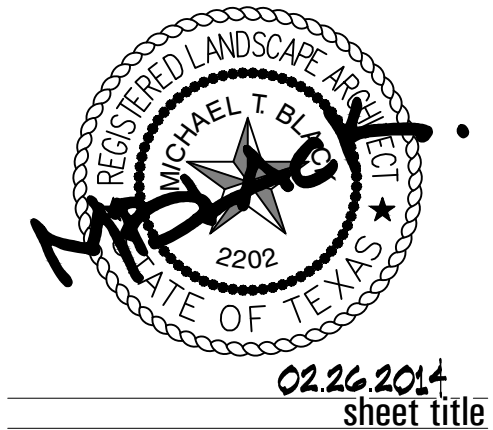

Landscape Plan
sheet number

LP-6