


SITE PLAN LEGEND:

- PHASE 1 PROJECT LIMIT LINE
- EDGE OF PAVEMENT
- CONCRETE SIDEWALK PAVEMENT
- CONCRETE VEHICULAR PAVEMENT
- CONCRETE DUMPSYER PAD PAVEMENT
- TYPICAL LIGHT FIXTURE

sheet location

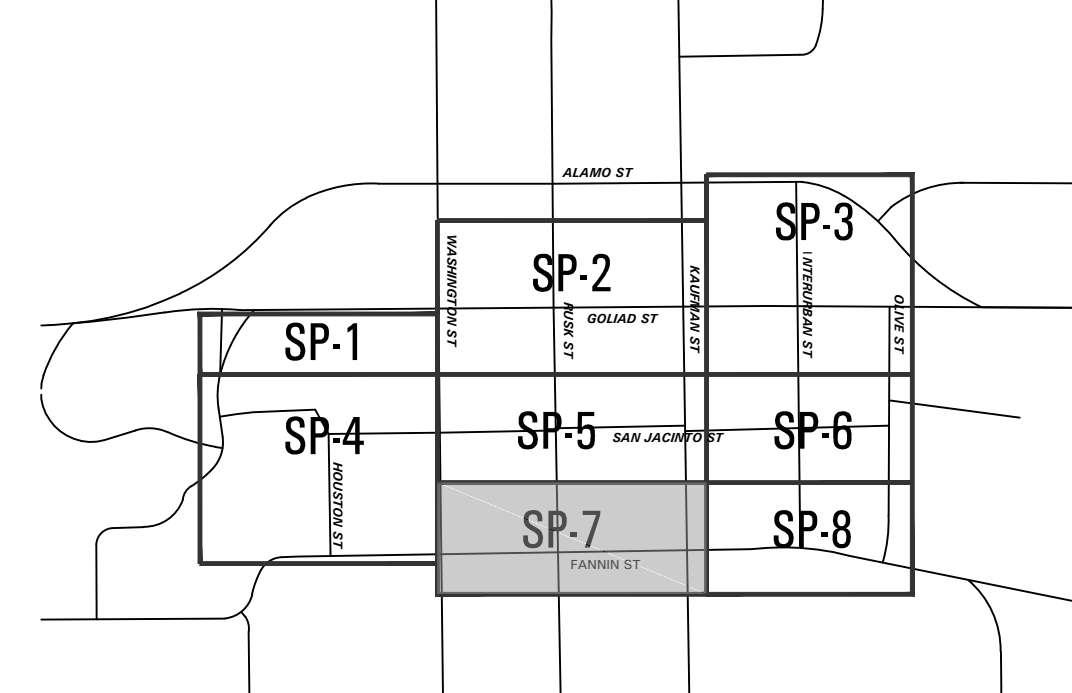

1 NO PARKING SIGN
SCALE: 3/4" = 1'-0"

Downtown Rockwall
la terra studio Project #12024
streetscape improvements
PHASE 2
rockwall, texas




submittals / revisions

| no. | date | detail |
|-----|----------|-------------------|
| △ | 05/08/14 | RFI #20, #42, #43 |
| △ | 05/16/14 | RFI #37 |
| △ | 05/27/14 | RFI #71 |
| △ | 07/18/14 | RFI #108 |
| △ | 09/30/14 | RFI #123 |

la terra studio, inc.

12024
Its project number
02.26.2014
date
rac; bhm
drawn by
mtb
checked by

registration

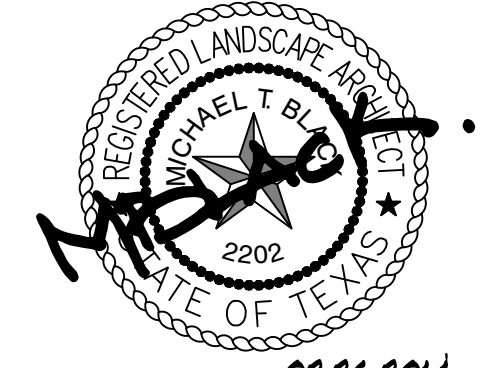

02.26.2014 sheet title

Site Plan
sheet number
SP-7