


REGISTRATION

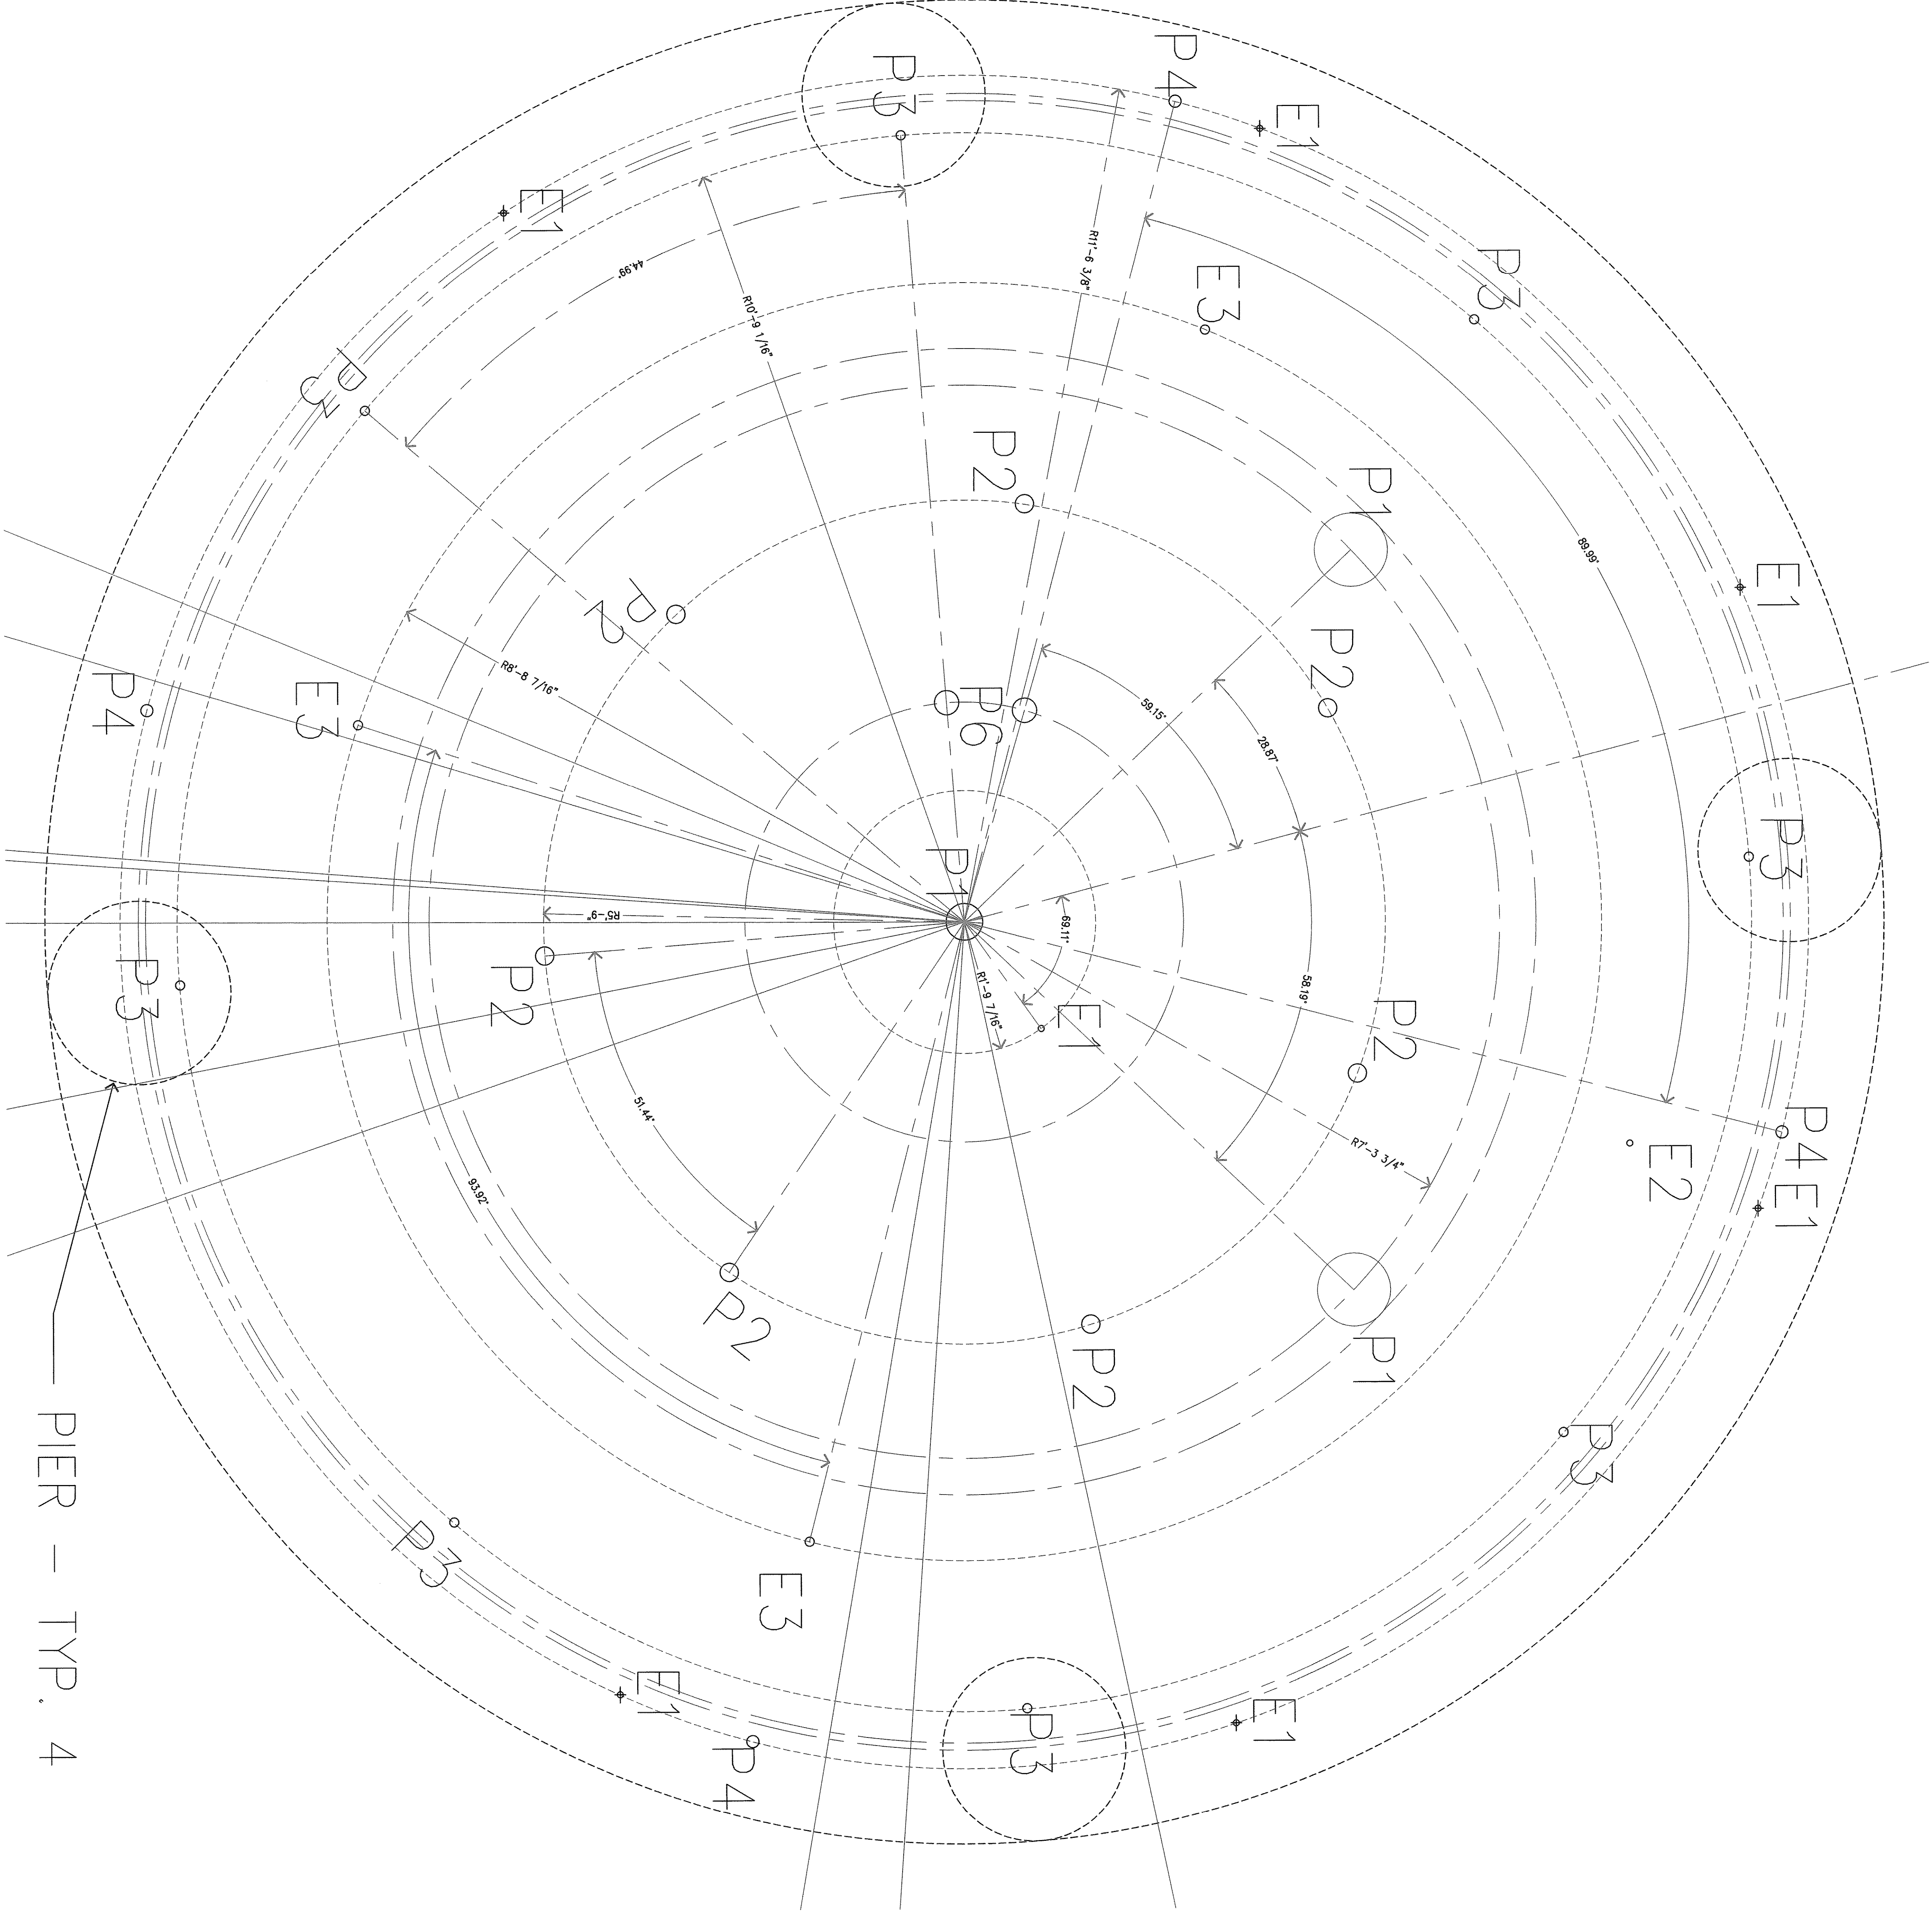

C ENLARGED LAKE SIDE FEATURE BOWL PENETRATION PLAN
PLAN
SCALE: 1" = 1'-0"

SCALE: 1" = 1'-0"