

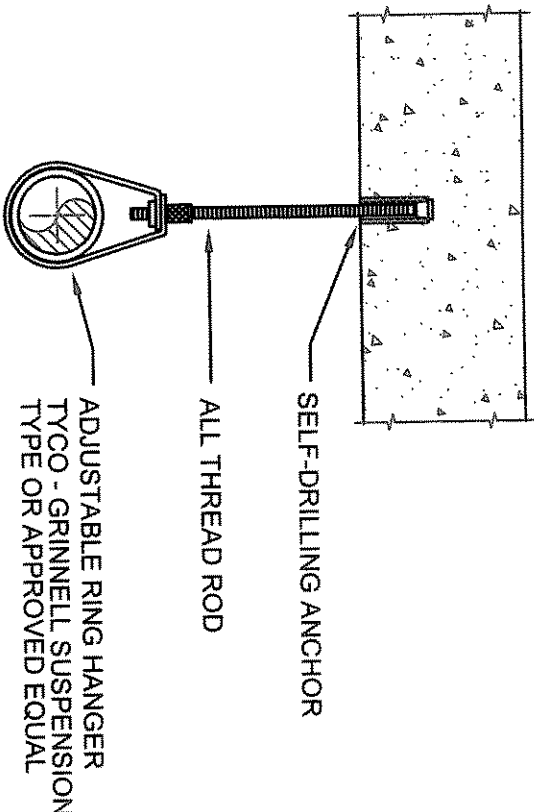
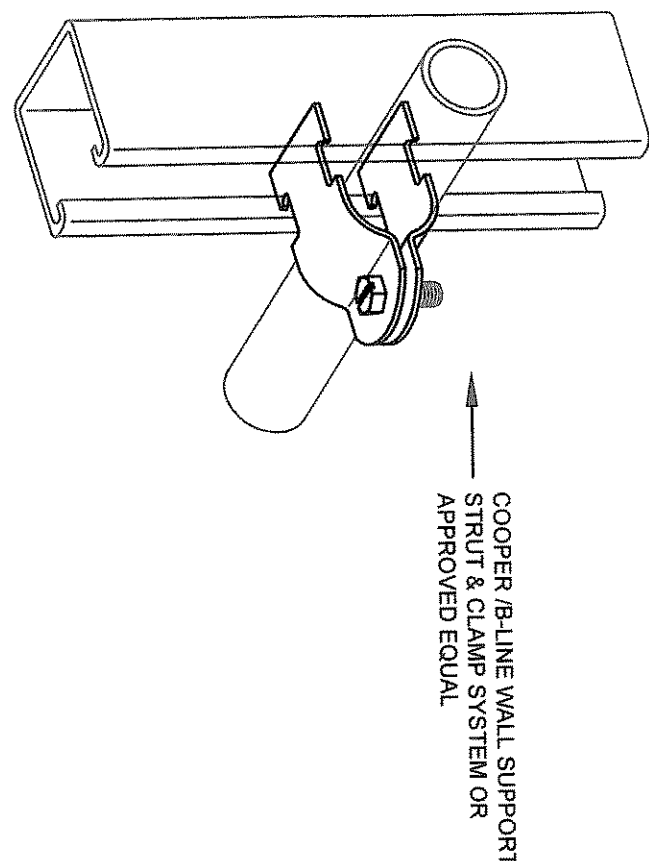



PIPE SUPPORTS
SCALE: N.T.S.

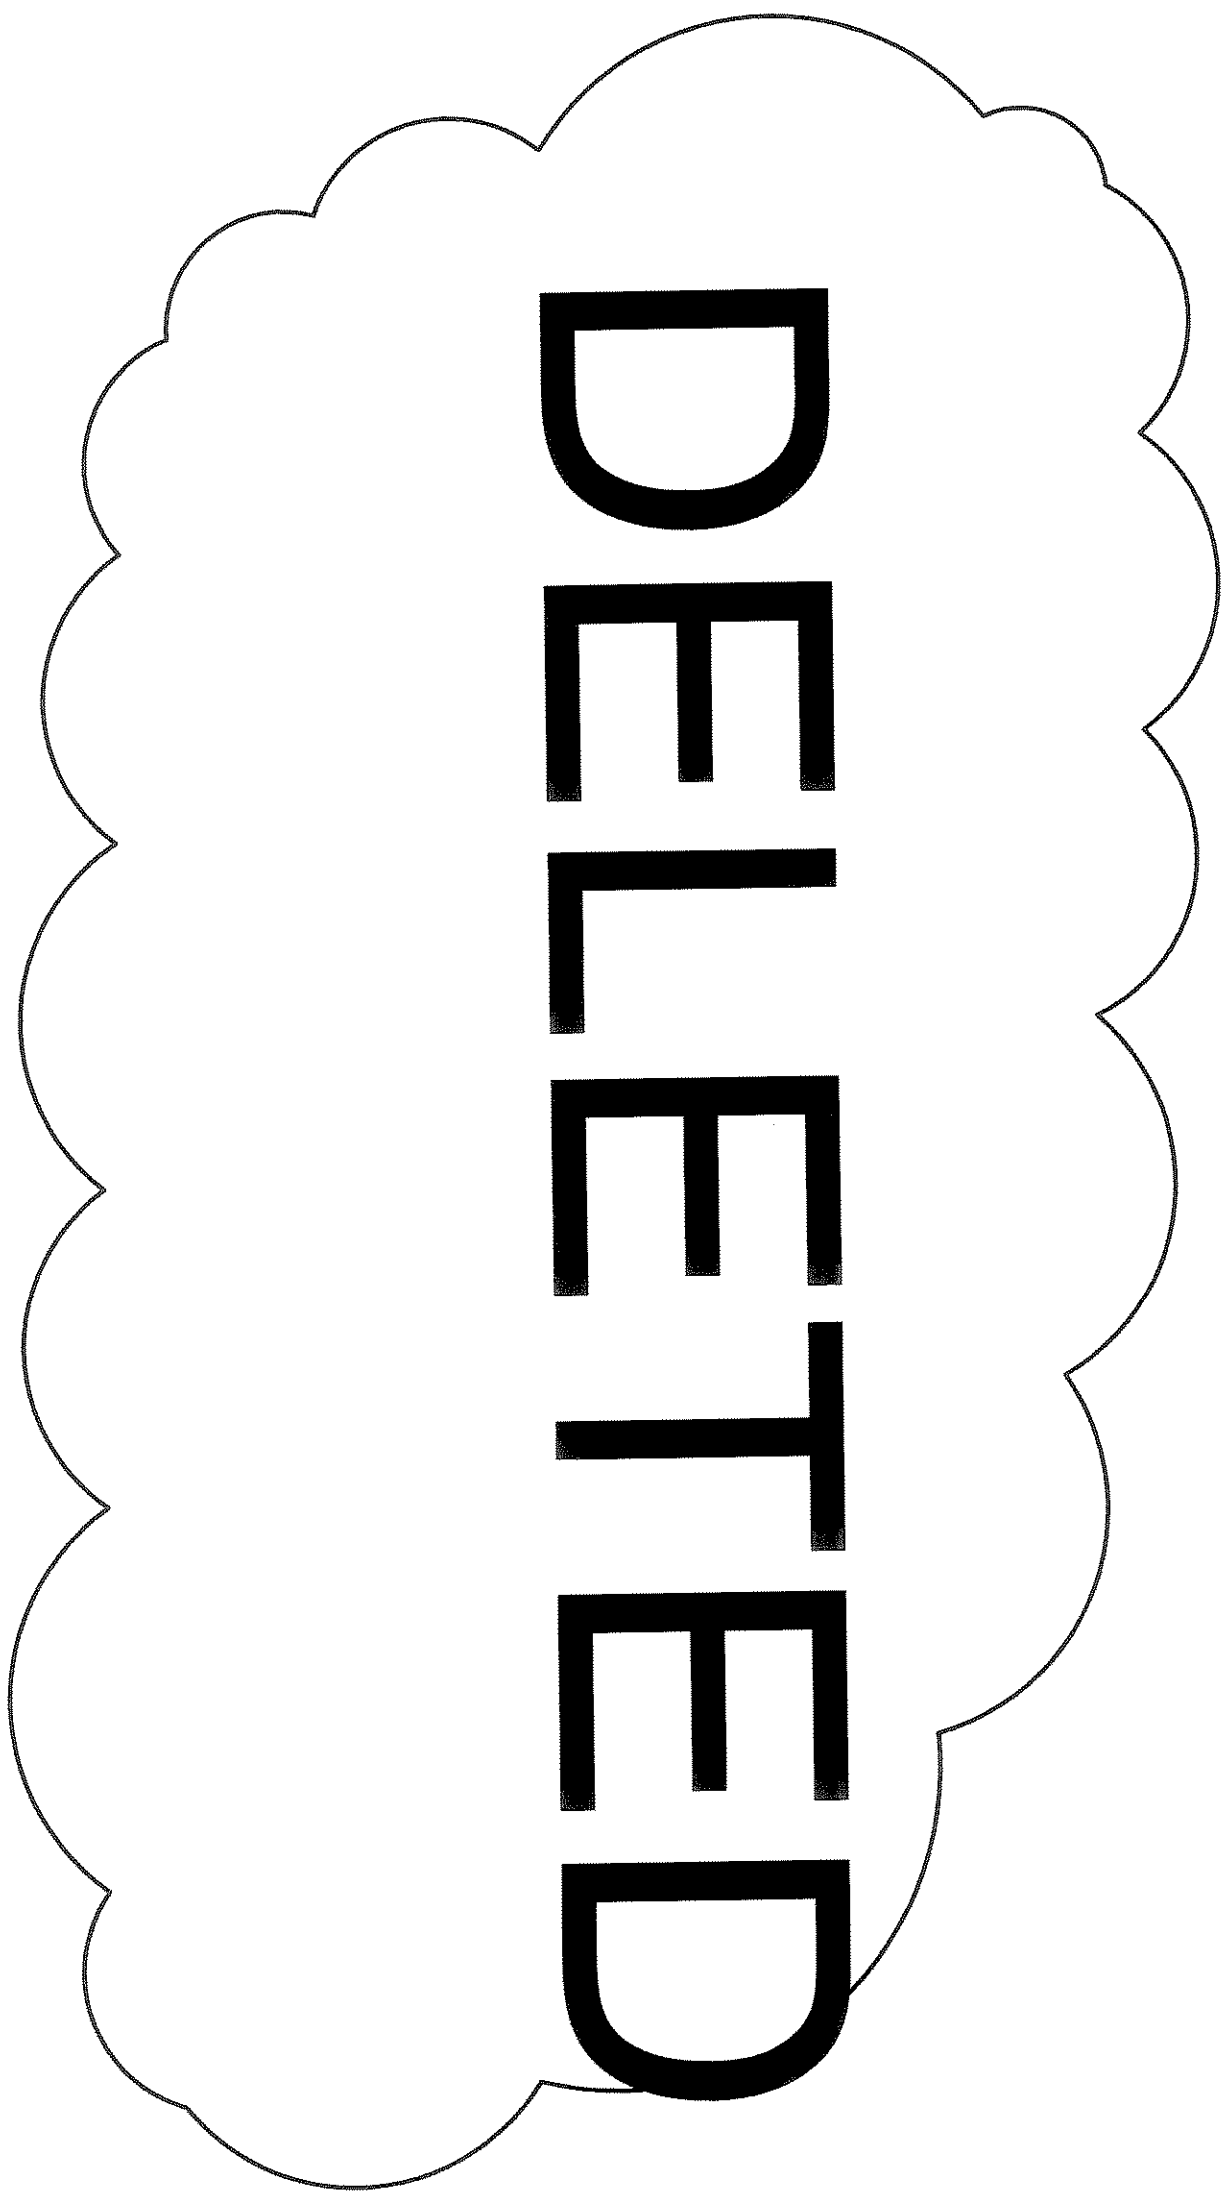


F HVAC / CO2 MOUNTING PAD
SCALE: N.T.S.

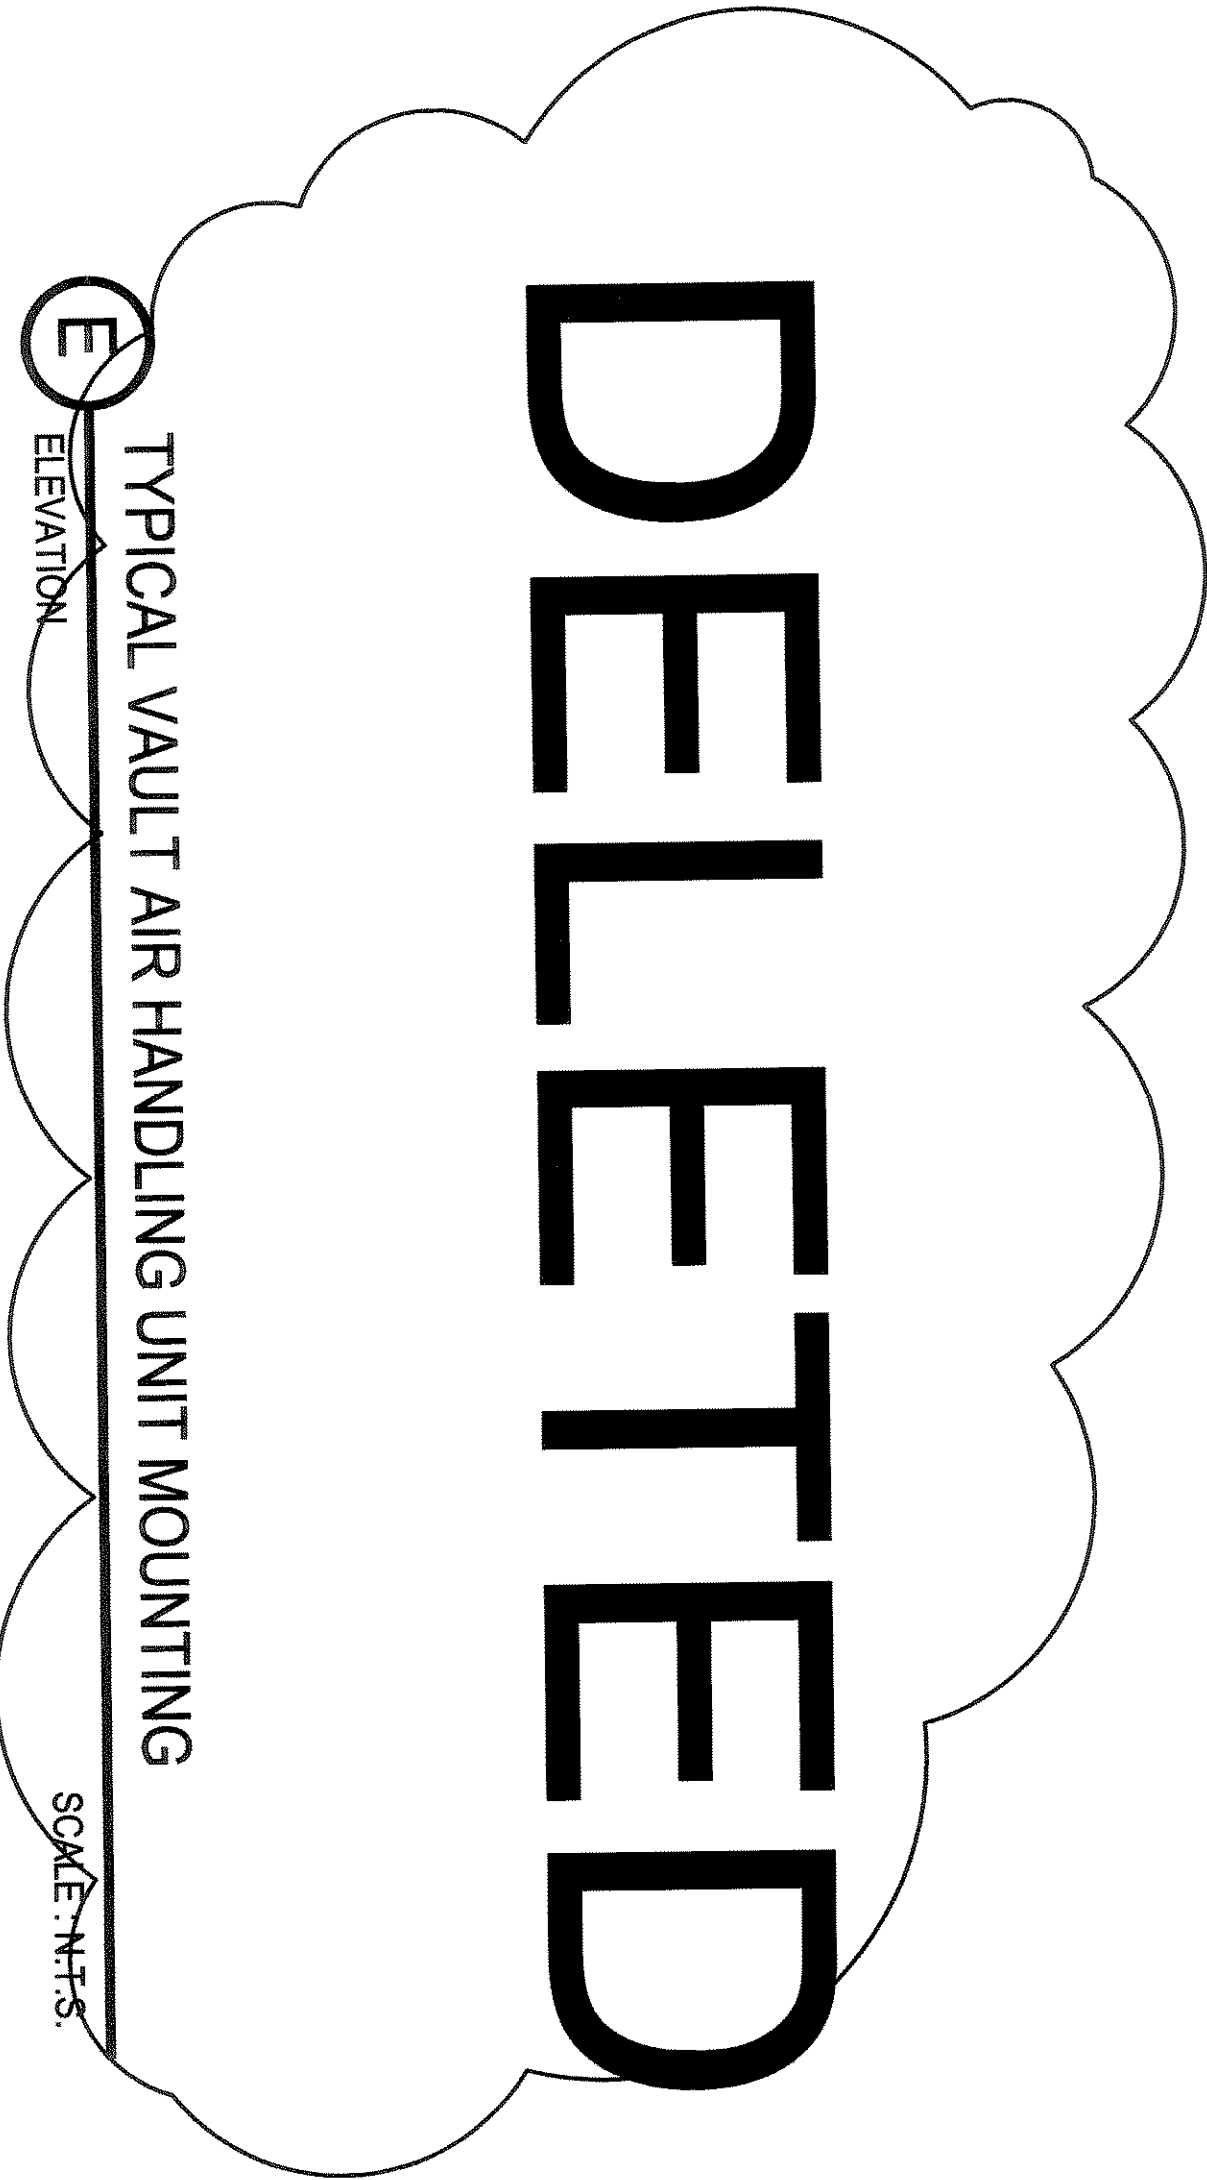


E TYPICAL VAULT AIR HANDLING UNIT MOUNTING
SCALE: N.T.S.

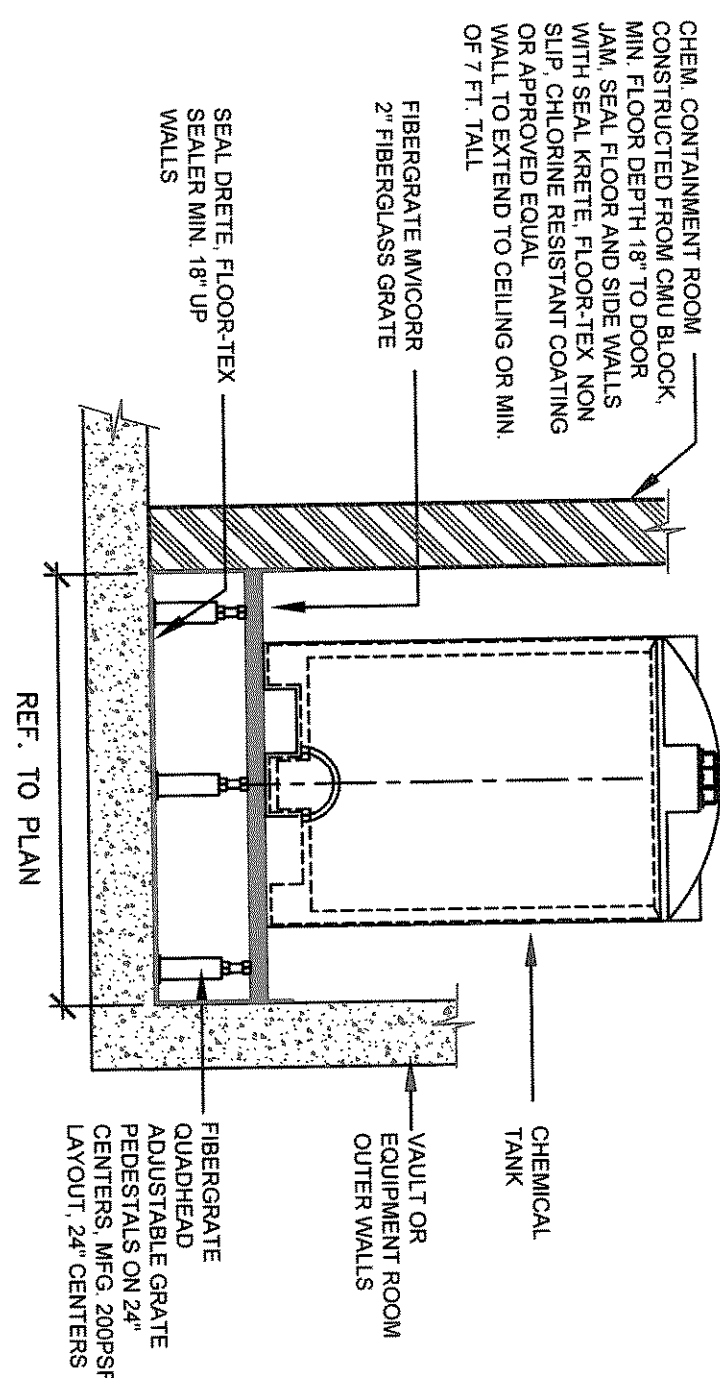

D TYPICAL CHLORINE TANK CATCH BASIN DETAIL
SCALE: 1/2" = 1'-0"

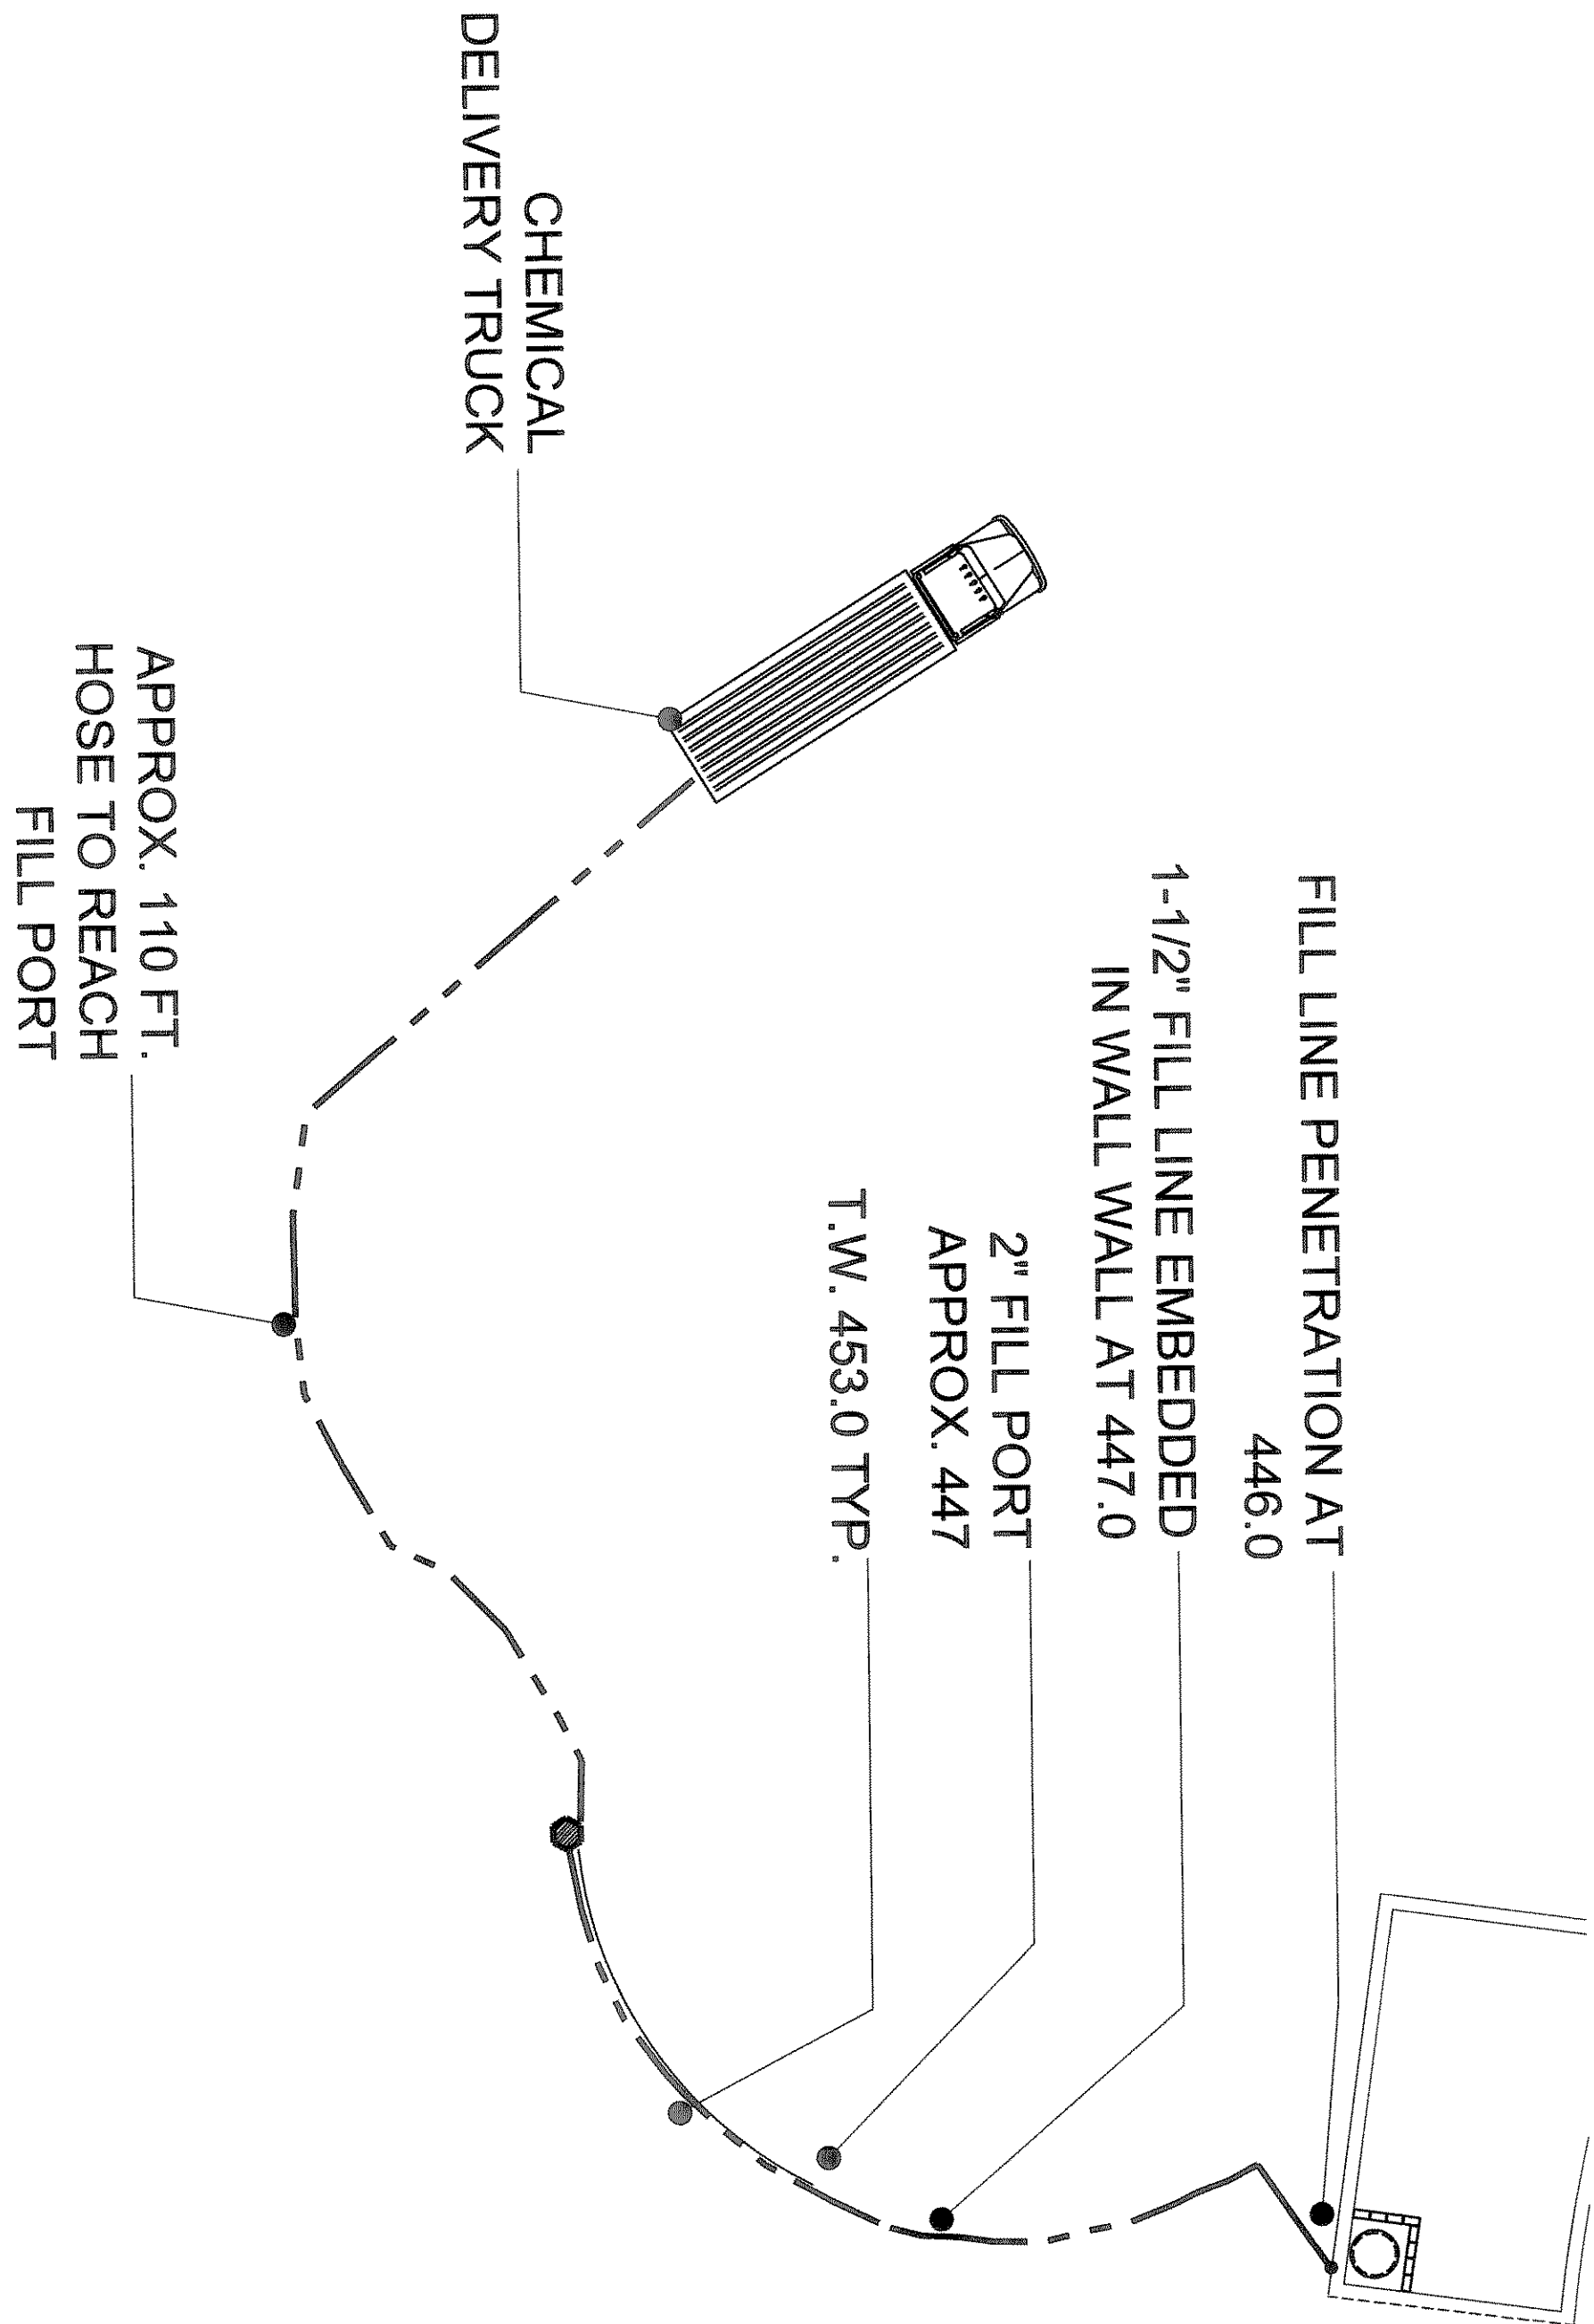

B LAKE SIDE CHEMICAL FILL PLAN
SCALE: NONE

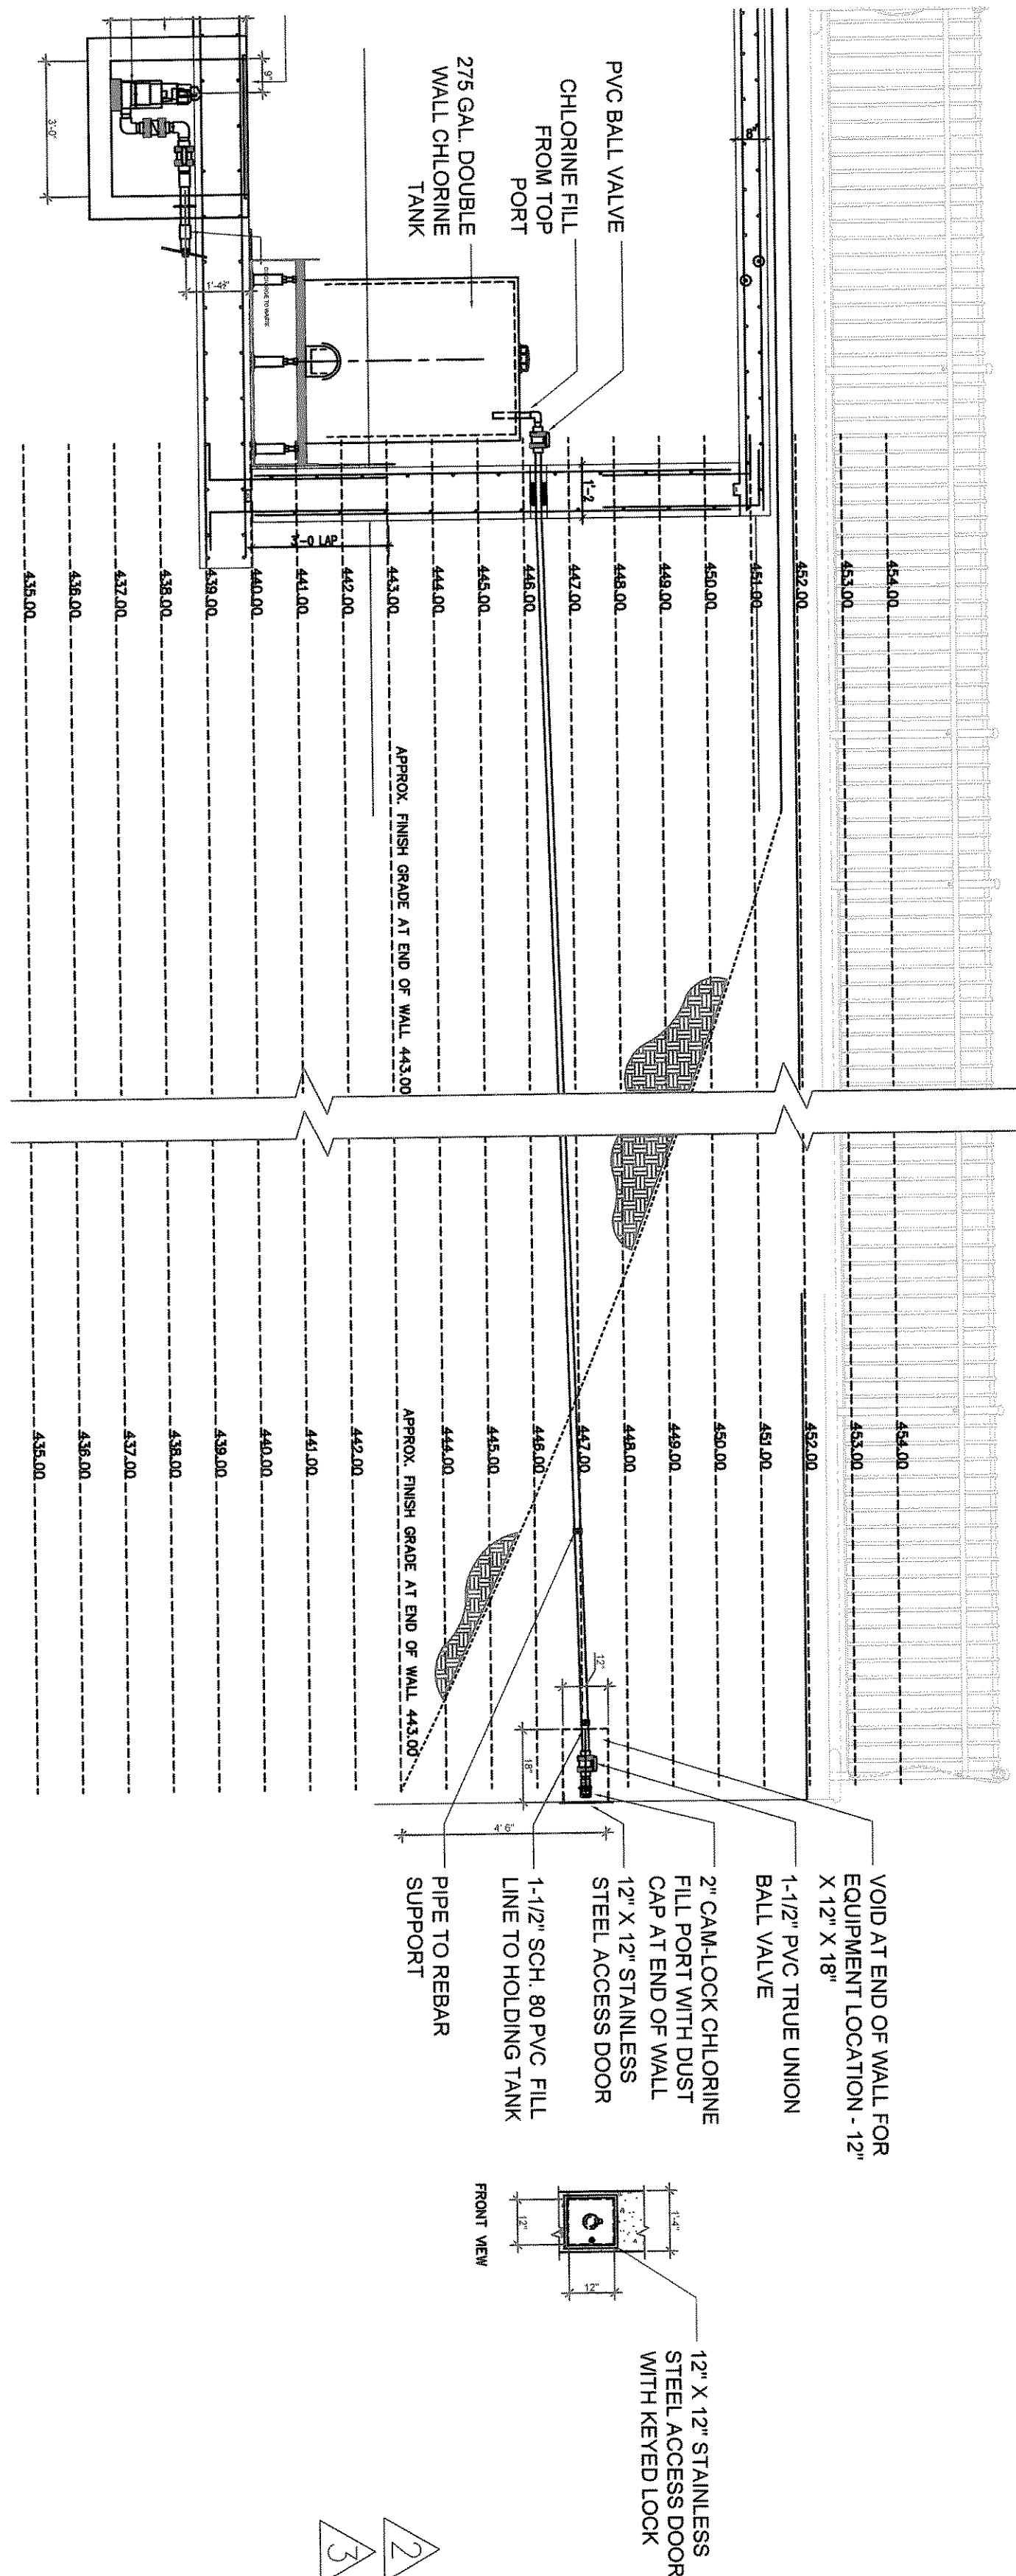

A LAKE SIDE CHEMICAL FILL SYSTEM ELEVATION
SCALE: NONE

T B G

PARTNERS
Landscape Architects • Planners
302 North Market, Suite 450
Dallas, Texas 75202
214/714-0757 Fax: 214/714-6785
Austin • Dallas • Houston • McAllen

Greenridge
Pump Services, Inc.
• DESIGN • CONSULTING • CONTRACTING •
• SALES • SERVICE •
Headquarters
1425 Winkler, Suite 108
Carrollton, Texas 75006
Ph: 972-460-0377 Fax: 972-460-0313

© 2006 GREENRIDGE PUMP SERVICES, INC.

THE HARBOR
ROCKWALL, TEXAS

REGISTRATION

NO.	REVISIONS	DATE
1	POST-BID ADDENDUM	01/17/06
2	POST-BID ADDENDUM	01/17/06
3	POST-BID ADDENDUM	01/17/06
4	AS BUILT	11/10/06

SHEET TITLE

LAKE SIDE
CHEMICAL SYSTEM
PLAN

JOB NO. 4890
DATE: JUL 12, 2005
DRAWN BY: JLS
CHECKED BY: JLS
FILE: 4890 THE HARBOR AS-BUILT 11/07/06
SHEET NUMBER

LW.06B