


NOTES

- ALL WATER LINES ARE TO BE CLASS 200 PVC C900
- GREEN EMS DISKS SHALL BE INSTALLED ON THE SANITARY SEWER LINE AT EVERY CHANGE IN DIRECTION, MANHOLE, CLEANOUT, AND SERVICE.
- BLUE EMS DISKS SHALL BE INSTALLED ON THE WATER LINE AT EVERY CHANGE IN DIRECTION, TEE, VALVE, AND SERVICE.
- FIRE HYDRANTS SHALL HAVE 5' CLEARANCE AROUND.
- SEE MEP PLANS FOR UTILITIES STARTING 5' FROM BUILDING AND GOING TOWARD THE BUILDING

SCALE 1" = 20'

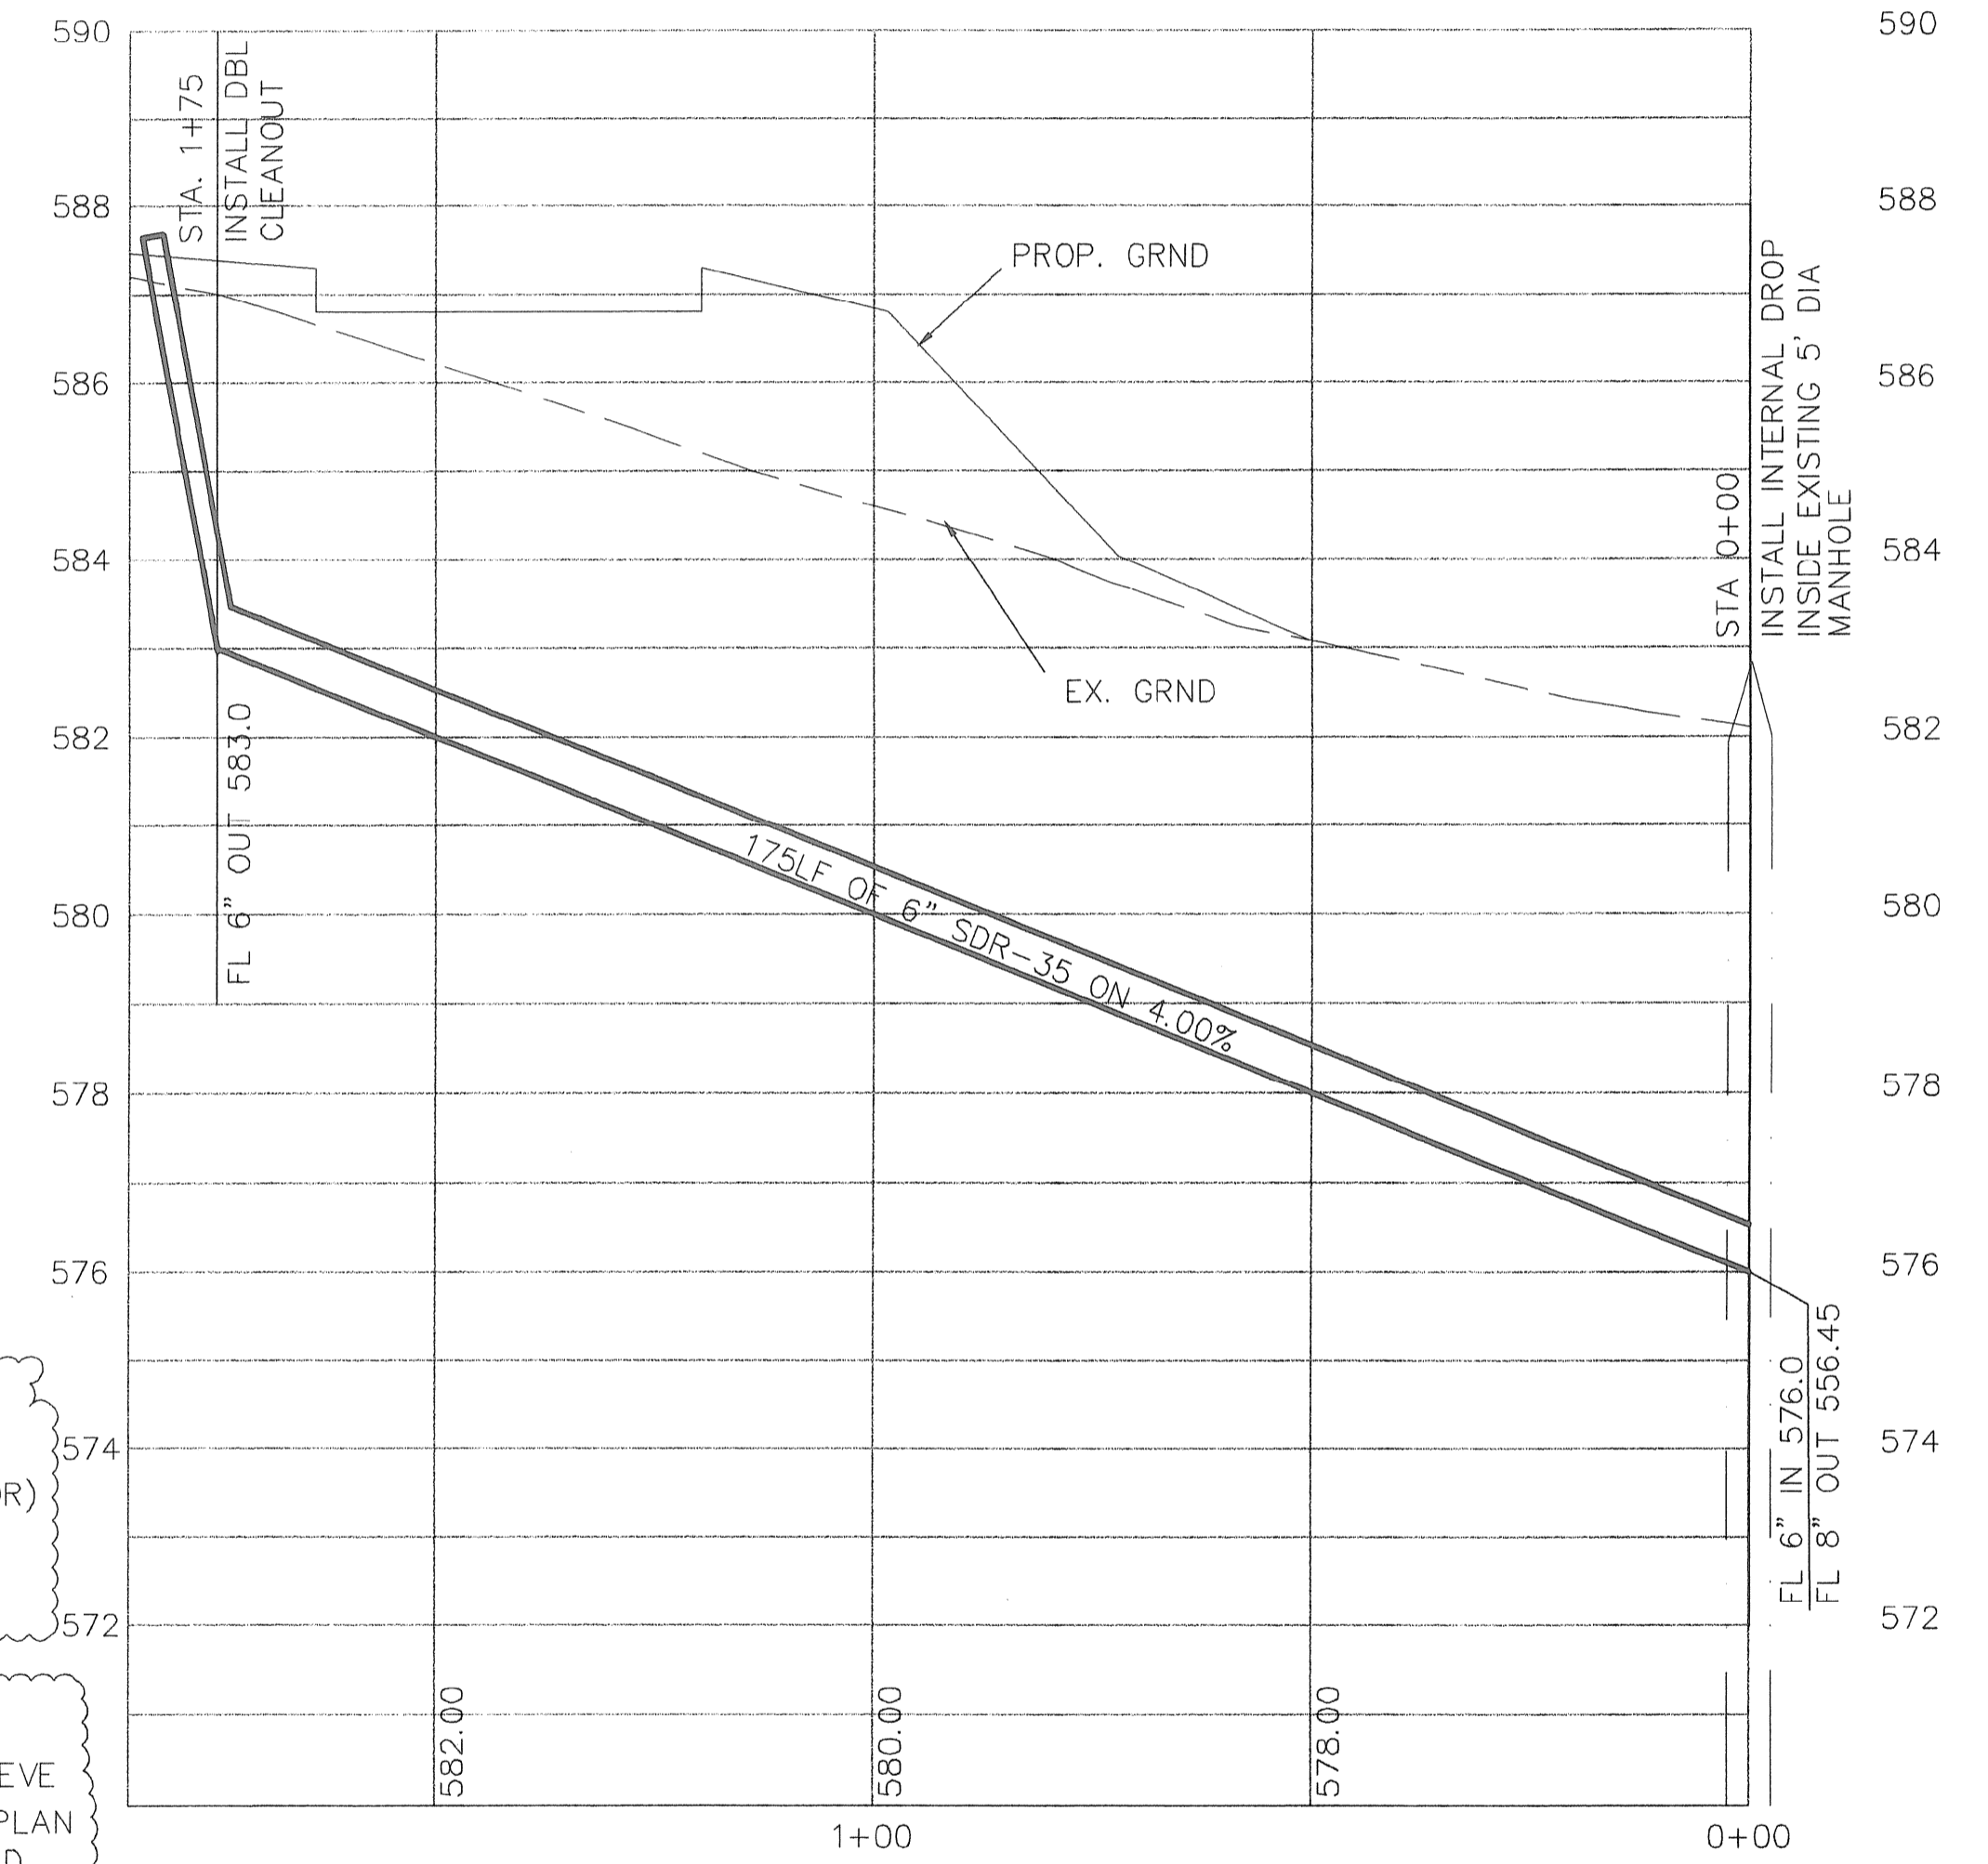

WATER AND SANITARY SEWER
ROCKWALL ANIMAL ADOPTION CENTER
ROCKWALL, TEXAS
CITY OF ROCKWALL
"THE NEW HORIZON"

REVISION NO.	REMARKS	DATE

DESIGNED: A.J.W.	THE SEAL APPEARING ON THIS DOCUMENT WAS AUTHORIZED BY CHARLES A. TODD TEXAS P.E. NO. 55647 ON
DRAWN: LD2006	
JOB NO. WTR/SS.DWG	DATE: 03/2007 C3

