
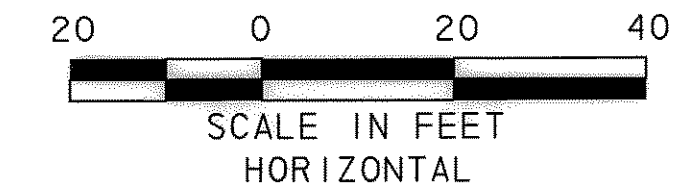


P:\4328\60004153-205Bypass\CADD\Sheets\Section1\140-00-To-FM552\Record Drawing 10.7.09\0320demo-05.dgn  
11/17/2009

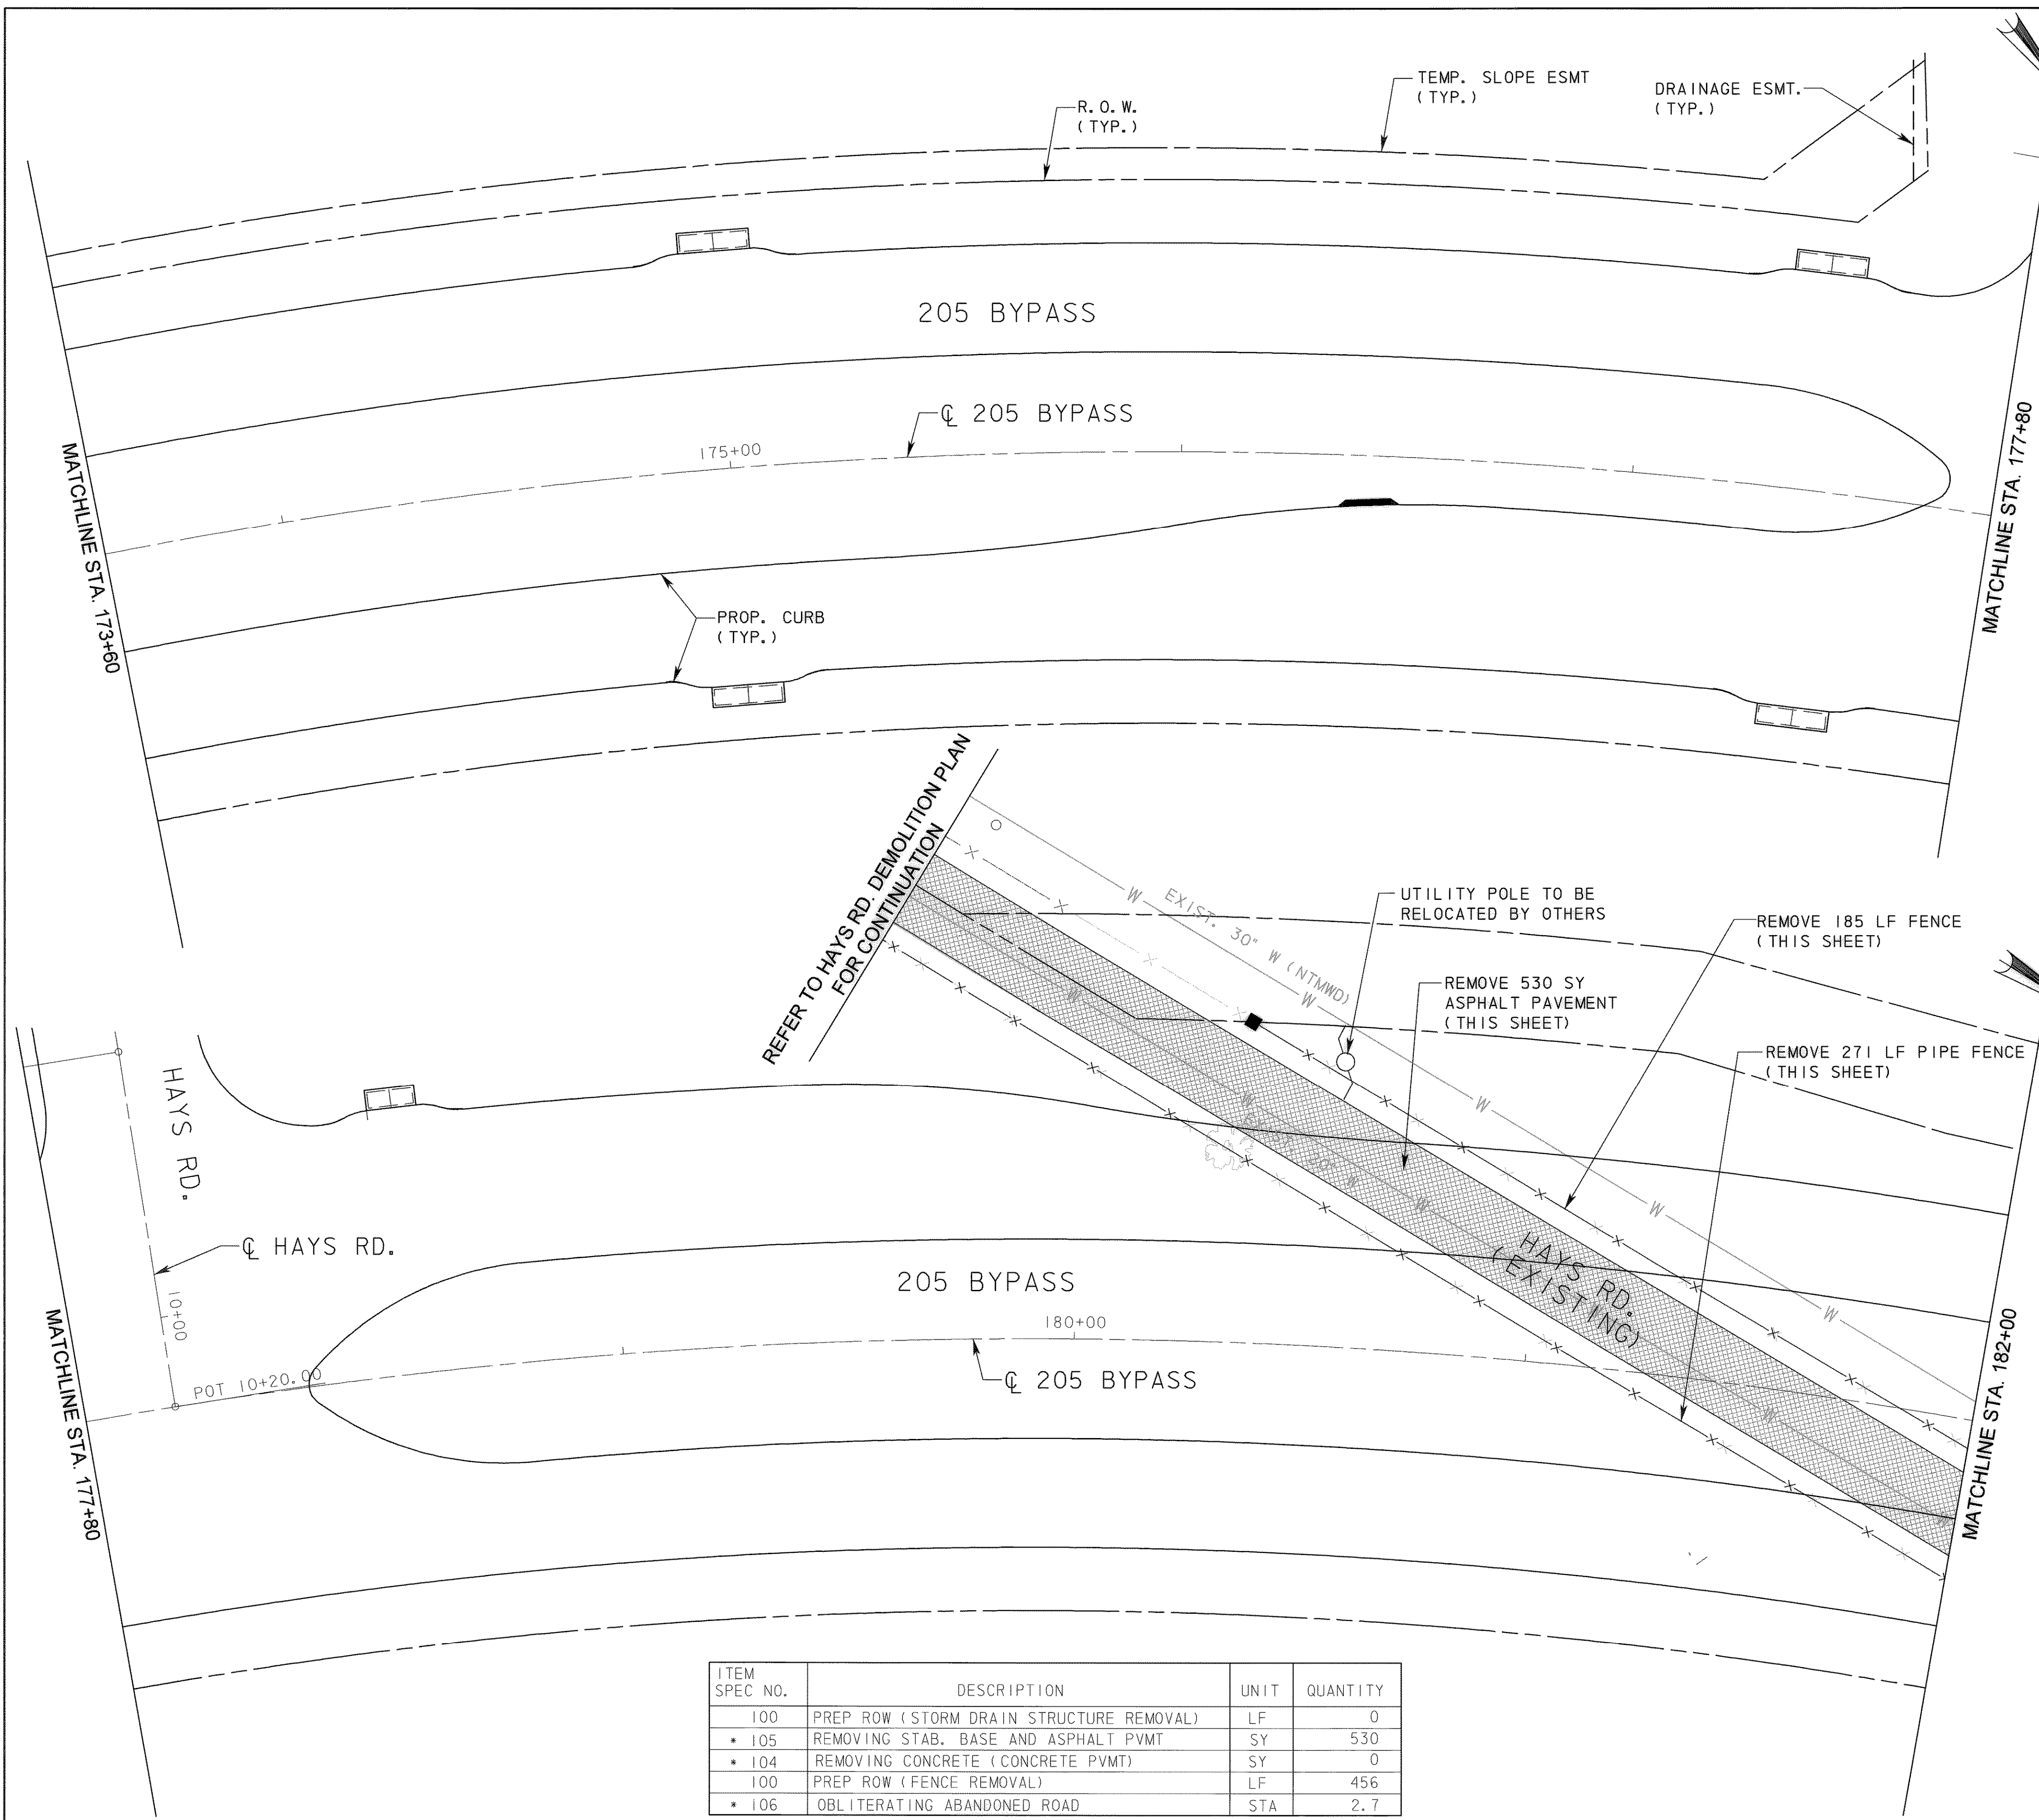

- LEGEND**
- EXIST. TREE TO REMAIN
  - EXIST. TREE TO BE REMOVED
  - EXIST. FENCE TO REMAIN
  - EXIST. FENCE TO BE REMOVED
  - EXIST. BRUSH & SMALL DIAMETER TREES TO BE REMOVED

- NOTES:**
- CONTRACTOR SHALL PAY FOR REMOVALS IN ACCORDANCE WITH PREPARING ROW, ITEM NO. 100.
  - QUANTITIES SHOWN ARE FOR CONTRACTOR'S INFORMATION ONLY.
  - FOR UTILITY ADJUSTMENTS, SEE THE UTILITY

**RECORD DRAWING**  
This drawing is a compilation of the original sealed engineering drawing and modifications by addenda, change orders and information furnished by the contractor. Information shown that was provided by the contractor and others not associated with the design engineer cannot be verified for accuracy or completeness. Original sealed drawing is on file at the office of AECOM USA Group, Inc., TBPE REG. NO. F-3082

ORIGINAL DRAWING SEALED & SIGNED BY  
Matthew L. Abbe, P.E.  
TX NO. 92715

ITEM SPEC NO.	DESCRIPTION	UNIT	QUANTITY
100	PREP ROW (STORM DRAIN STRUCTURE REMOVAL)	LF	0
* 105	REMOVING STAB. BASE AND ASPHALT PVMT	SY	530
* 104	REMOVING CONCRETE (CONCRETE PVMT)	SY	0
100	PREP ROW (FENCE REMOVAL)	LF	456
* 106	OBLITERATING ABANDONED ROAD	STA	2.7

\* THESE ITEMS ARE SUBSIDIARY TO ITEM 100.  
NOTE: ALL QUANTITIES SHOWN ARE FOR CONTRACTORS INFORMATION ONLY.

ADDENDUM NO. 3 - DELETED NOTE		TCB	8/7/07
NO.	REVISION	BY	DATE
<b>205 BYPASS</b> SECTION 1			
<b>DEMOLITION PLAN</b> STA. 173+60 TO STA. 182+00			
5 OF 9			
TCB   AECOM		TCB INC. WWW.TCB.AECOM.COM 17300 DALLAS PARKWAY, SUITE 1010 DALLAS, TEXAS 75248	
Unit	PW-DAL-FW	Scale: Horiz AS SHOWN Vert AS SHOWN	Date 11/11/2009
Designed	SKW/MLA	Checked TCB	Project No. 60004153
Drawn	TCB	Approved TCB	Sheet 32 of 217