
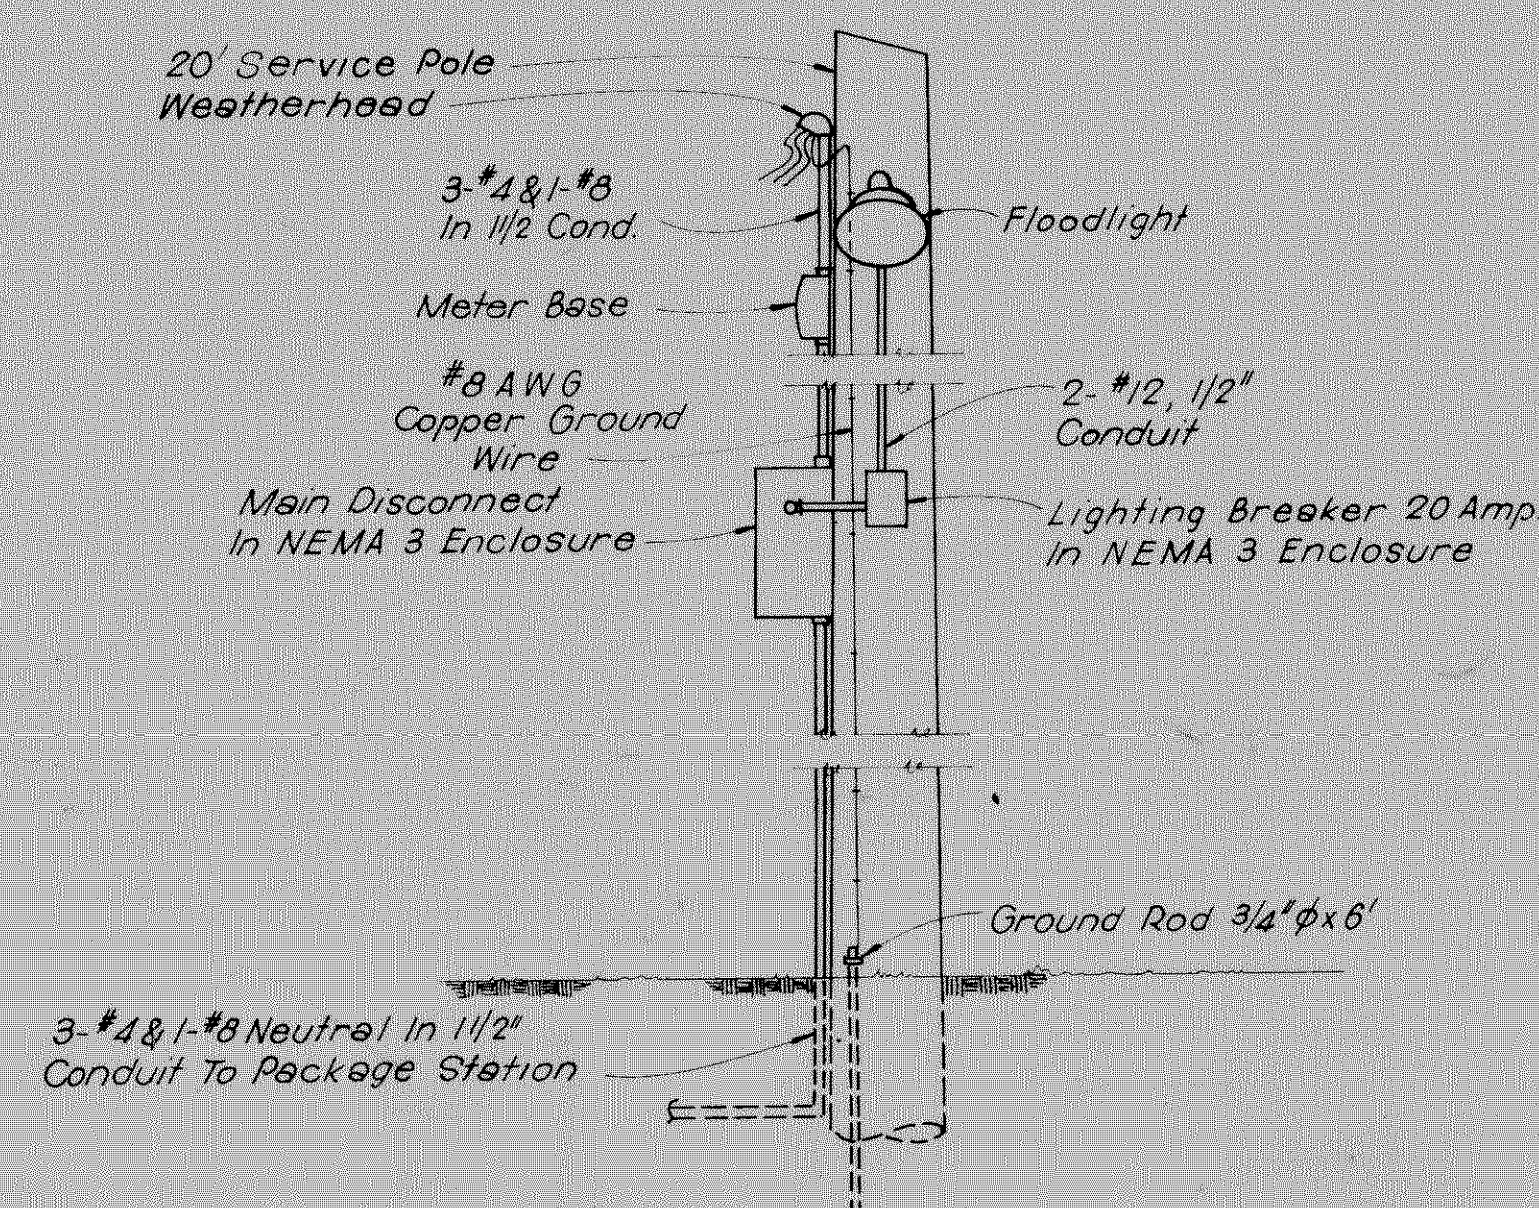
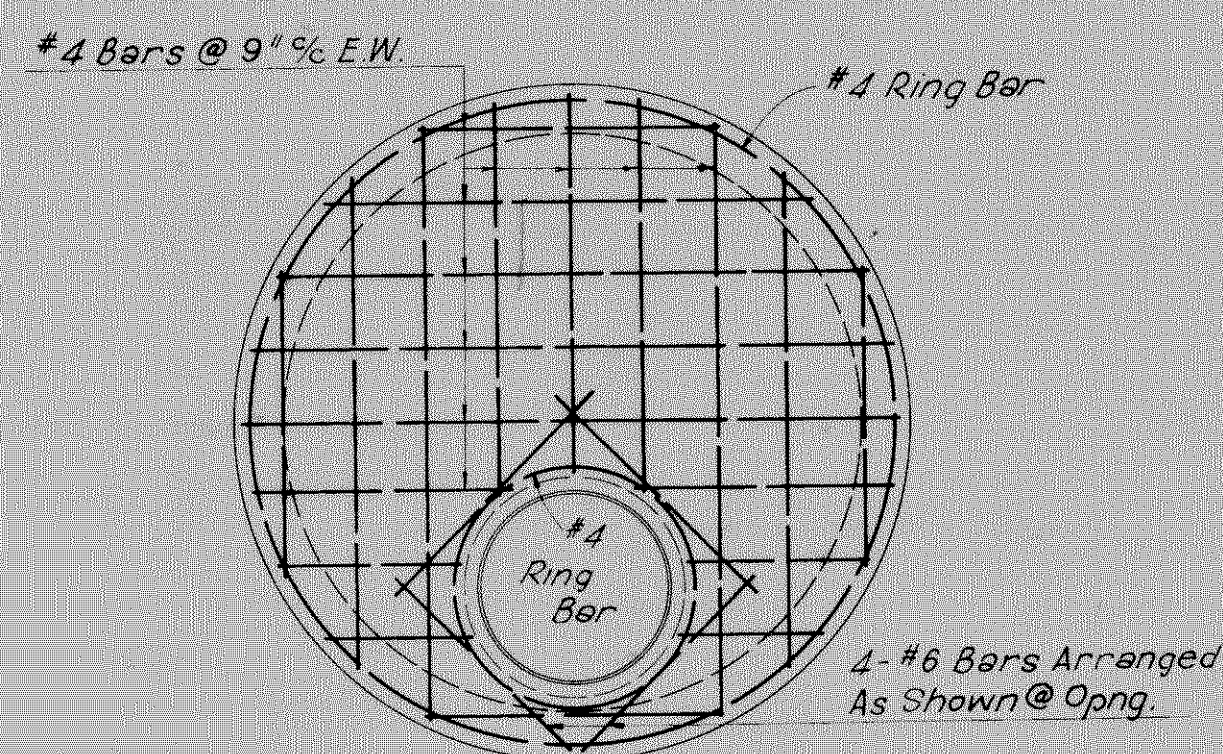
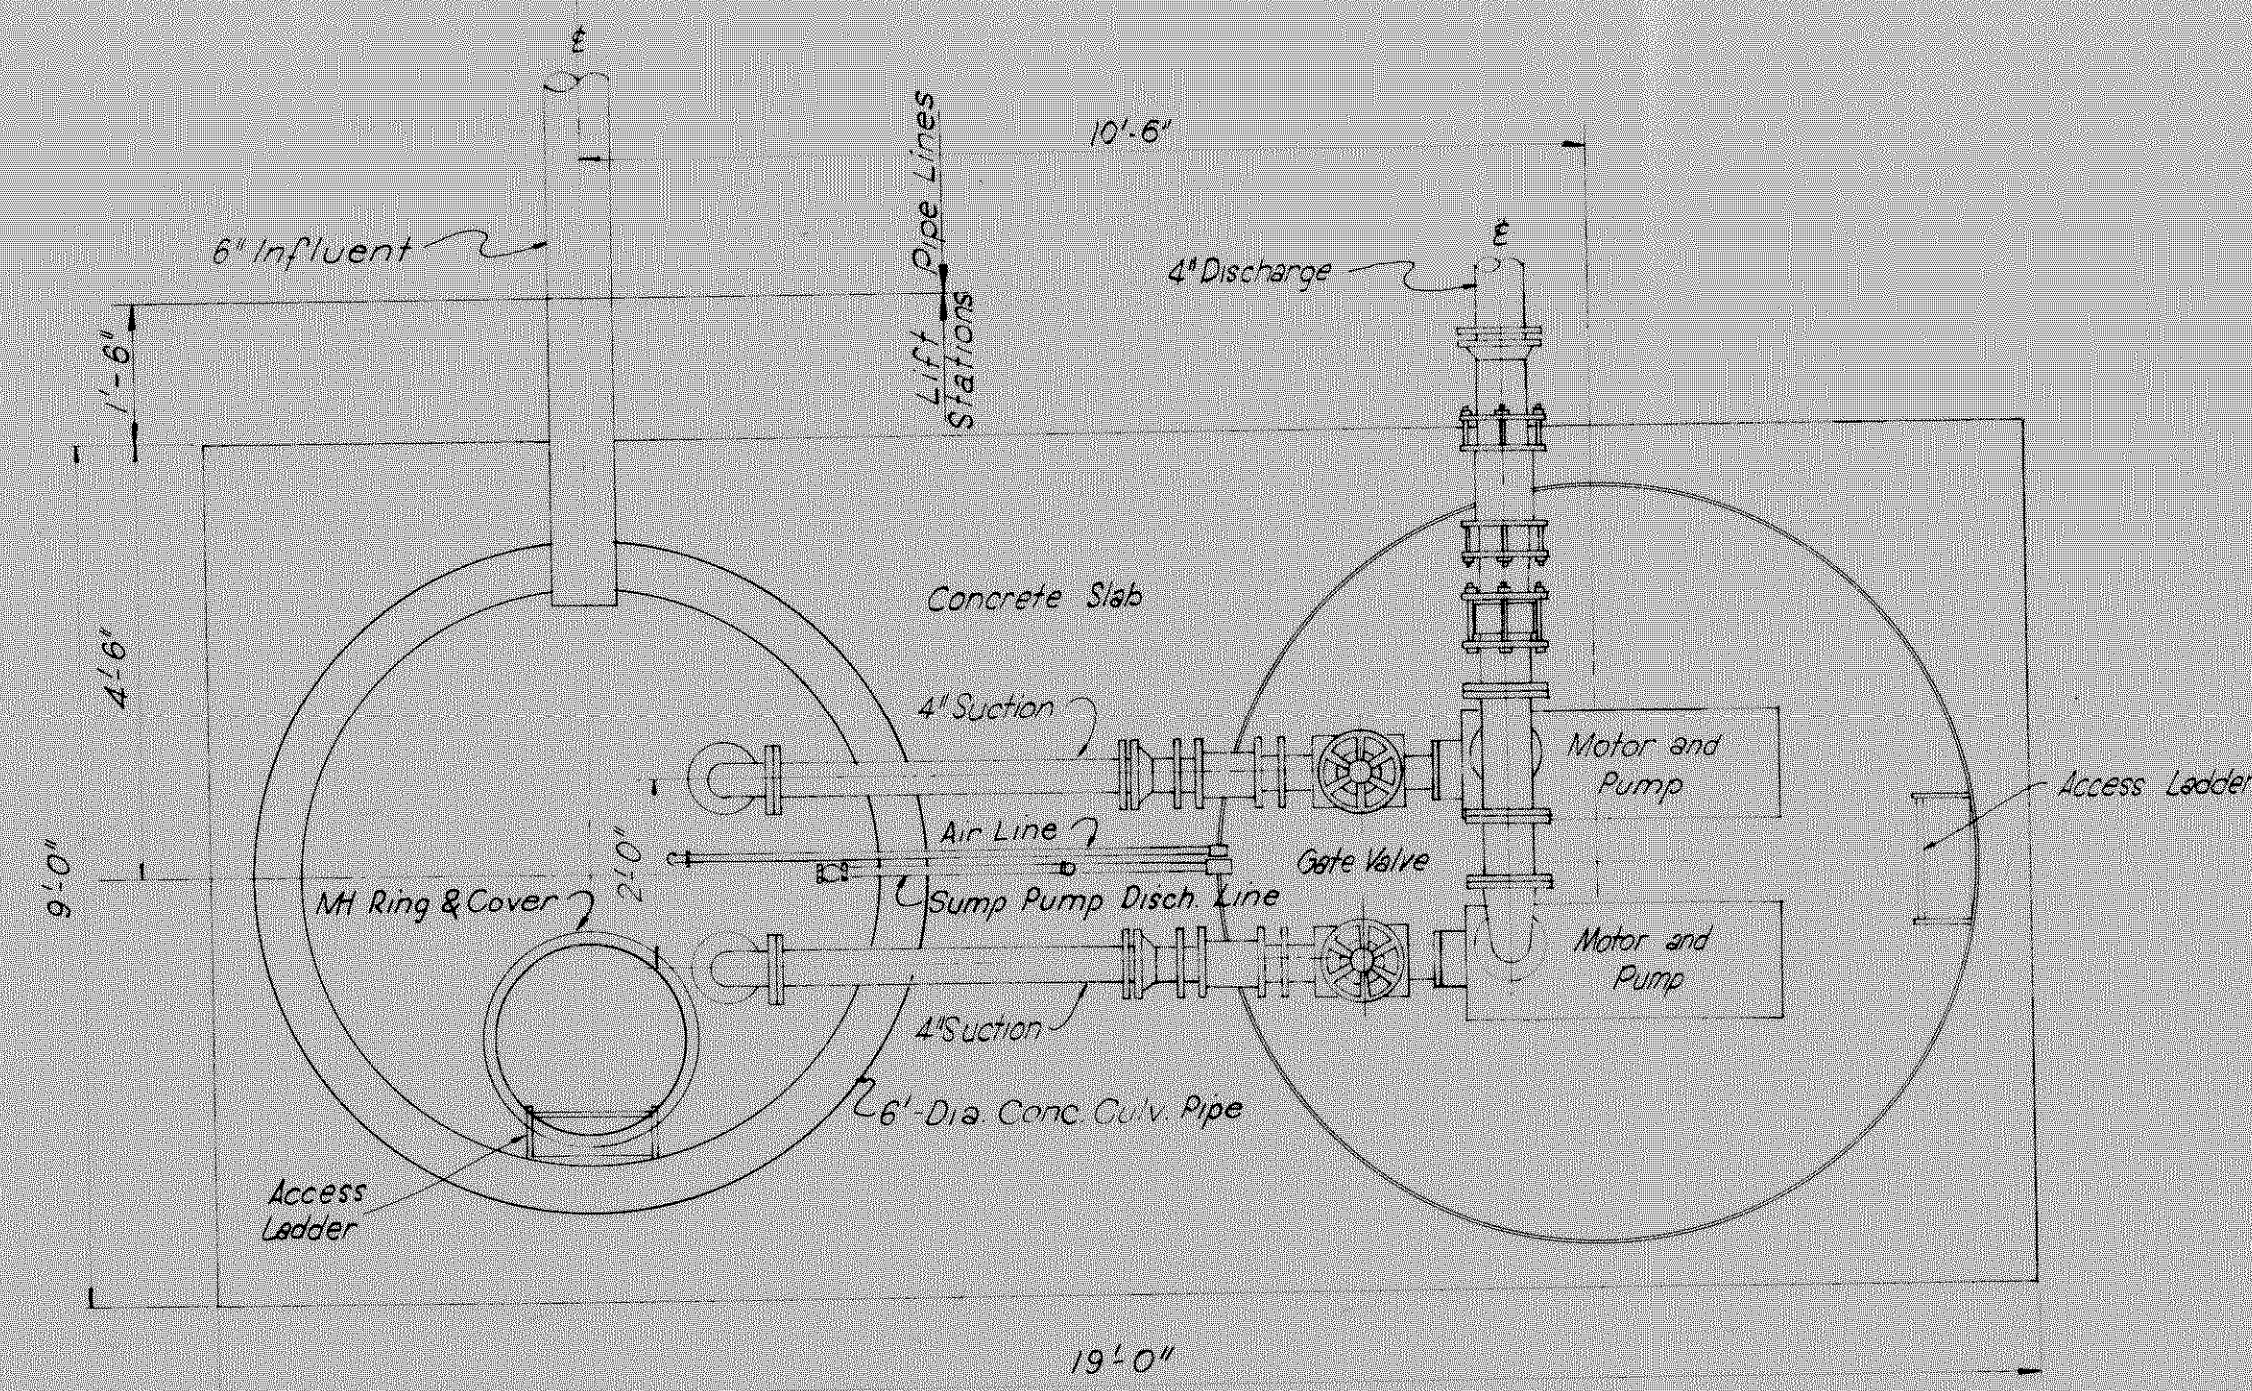


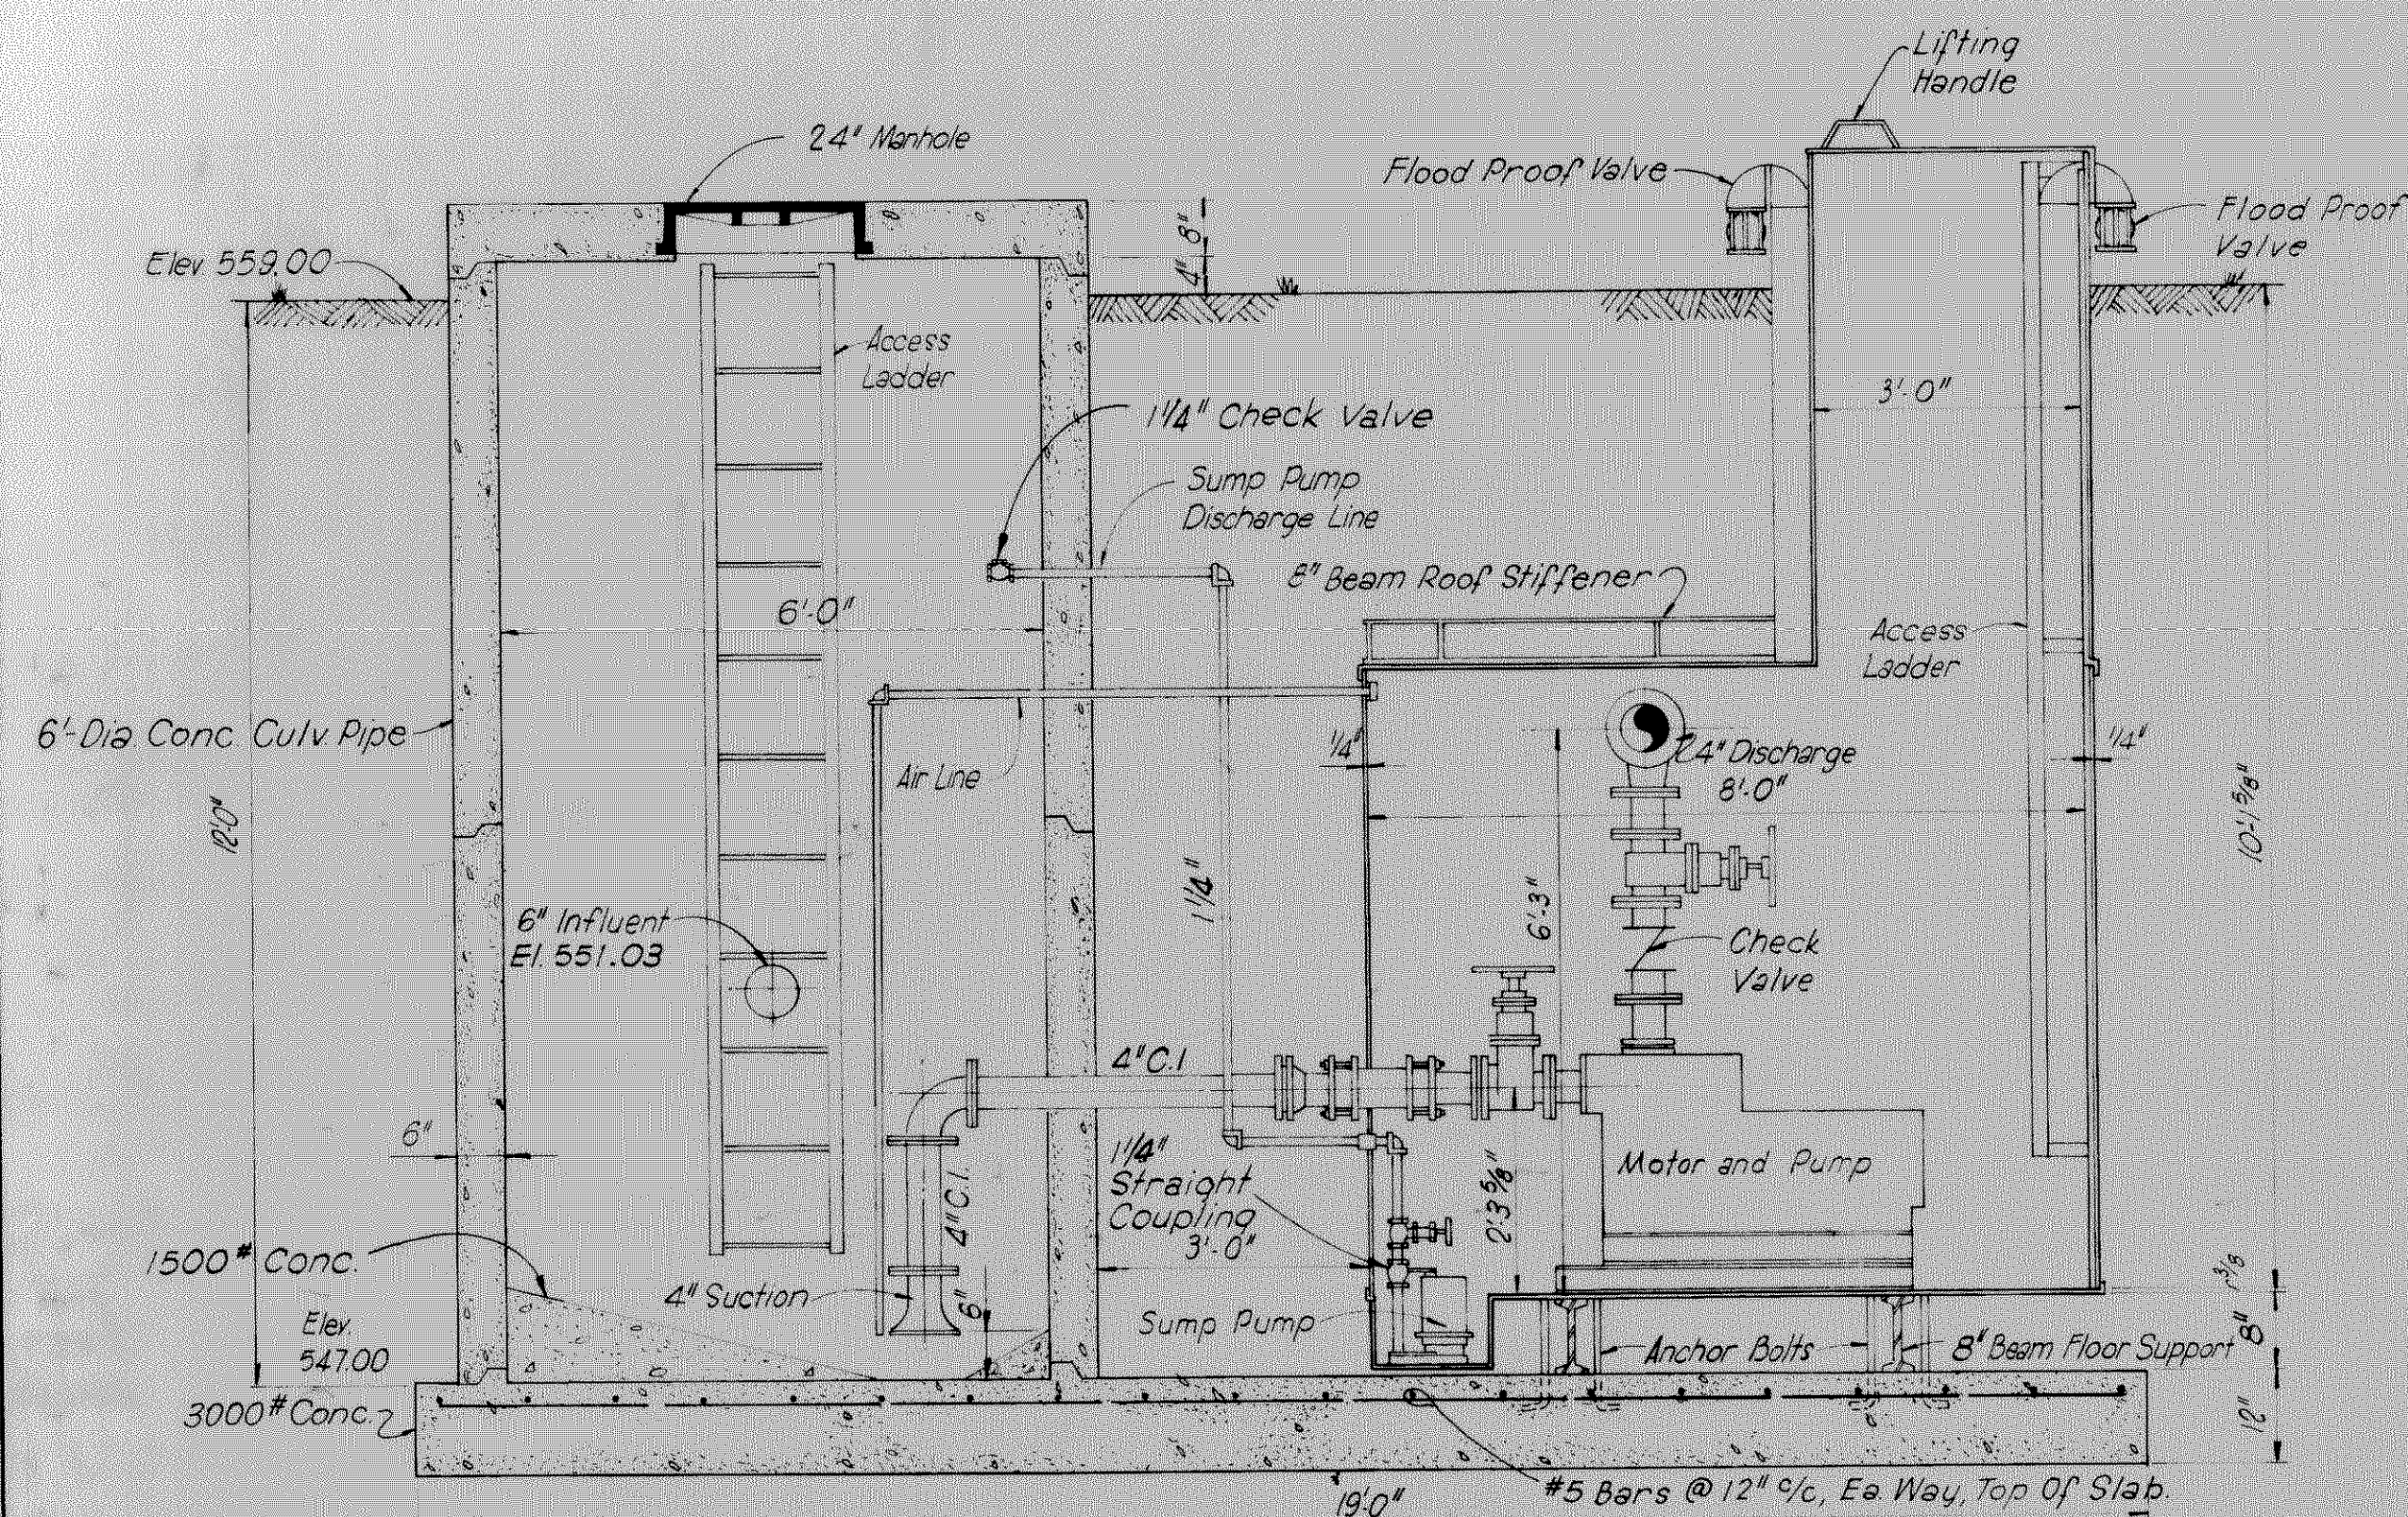

REVISED-AS BUILT
DATE Sept. 1969

CITY OF ROCKWALL, TEXAS
SEWER SYSTEM IMPROVEMENT

SOUTH LIFT STATION DETAILS

DESIGNED	D.L.D.	FREESE, NICHOLS & ENDRESS CONSULTING ENGINEERS FORT WORTH, TEXAS	DATE: OCT. 1967
DRAWN	W.G.R.		SCALE AS SHOWN
TRACED	R.C.		SHEET 7
CHECKED	R.L.N.		OF 7

DESIGNED	D.L.D.	FREESE, NICHOLS & ENDRESS CONSULTING ENGINEERS FORT WORTH, TEXAS	DATE: OCT. 1967
DRAWN	W.G.R.		SCALE AS SHOWN
TRACED	R.C.		SHEET 7
CHECKED	R.L.N.		OF 7

FREESE, NICHOLS & ENDRESS
CONSULTING ENGINEERS
FORT WORTH, TEXAS

DATE: OCT. 1967
SCALE: AS SHOWN
SHEET 7
OF 7

FREESE, NICHOLS & ENDRESS
CONSULTING ENGINEERS
FORT WORTH, TEXAS

DATE: OCT. 1967
SCALE: AS SHOWN
SHEET 7
OF 7

FREESE, NICHOLS & ENDRESS
CONSULTING ENGINEERS
FORT WORTH, TEXAS

DATE: OCT. 1967
SCALE: AS SHOWN
SHEET 7
OF 7

