


THE LOCATION OF EXISTING UTILITIES SHOWN ON THESE PLANS ARE APPROXIMATE AND BASED ON DATA FURNISHED BY UTILITY COMPANIES. IT IS THE RESPONSIBILITY OF THE CONTRACTOR TO LOCATE AND VERIFY ON-SITE THE UTILITIES THAT MAY CONFLICT WITH THE CONSTRUCTION.


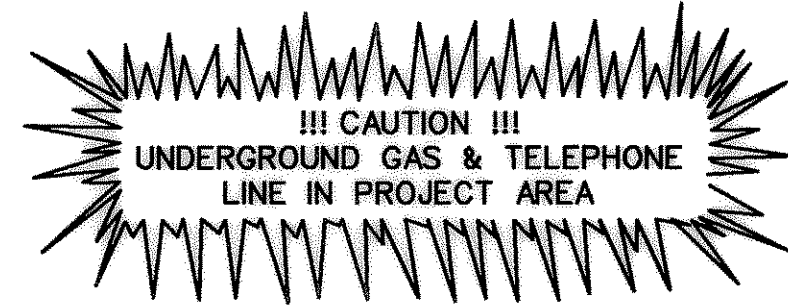



PROPOSED CONCRETE  
CONSTRUCTION

	FUTURE CONSTRUCTION
--	---------------------

----- FUTURE CURB

CAMBRIDGE COMPANIES  
VOLUME 105, PAGE 505  
D. R. R. C. T.

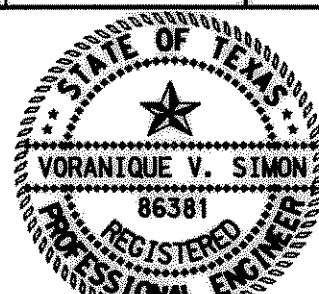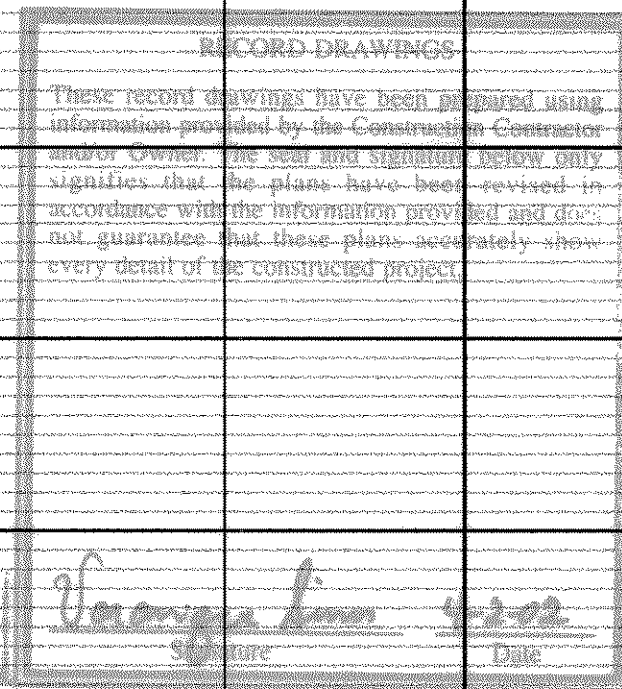

26	00						
4							
3							
2							
1	2/26	RECORD DRAWING					
NO.	DATE	REVISION				APPROV.	
		<b>CITY OF ROCKWALL</b> "THE NEW HORIZON"					
TOWNSEND DRIVE							
10" WATER LINE LOWERING							
<b>Turner Collie &amp; Braden Inc.</b> ENGINEERS • PLANNERS • PROJECT MANAGERS							
Unit	A123	Scale:	Vert.	1" = 20'	Date	FEBRUARY, 2001	
Designed	VVS	Checked	TBS		Job No.	15-00925-200	
Drawn	GBA	Approved	RCR		Sheet	44A of 72	