

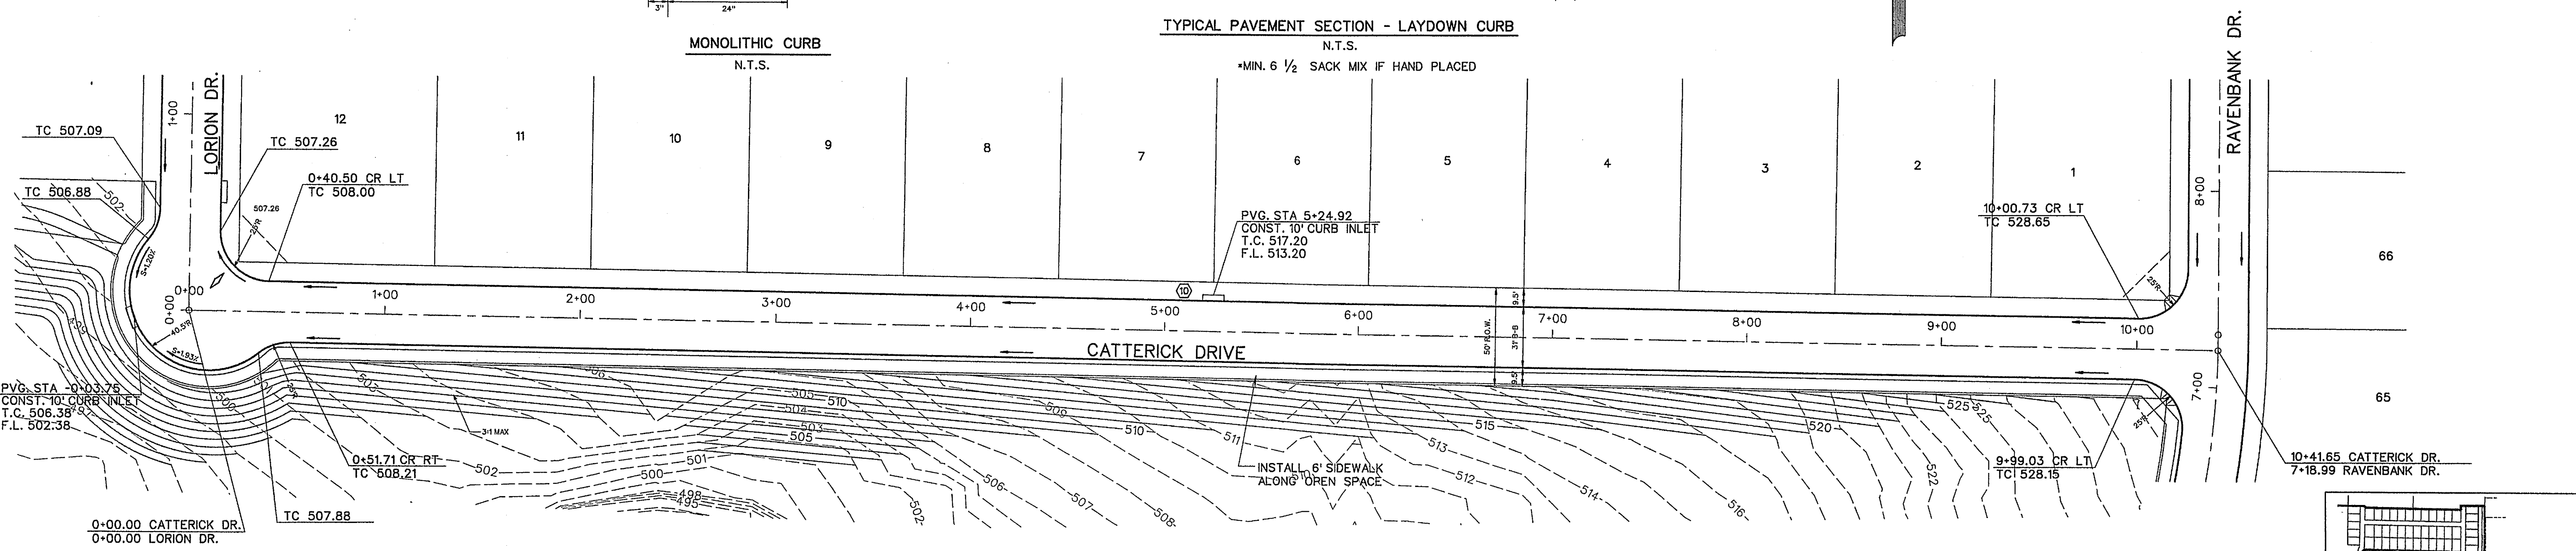



SCALE: 1" = 40'

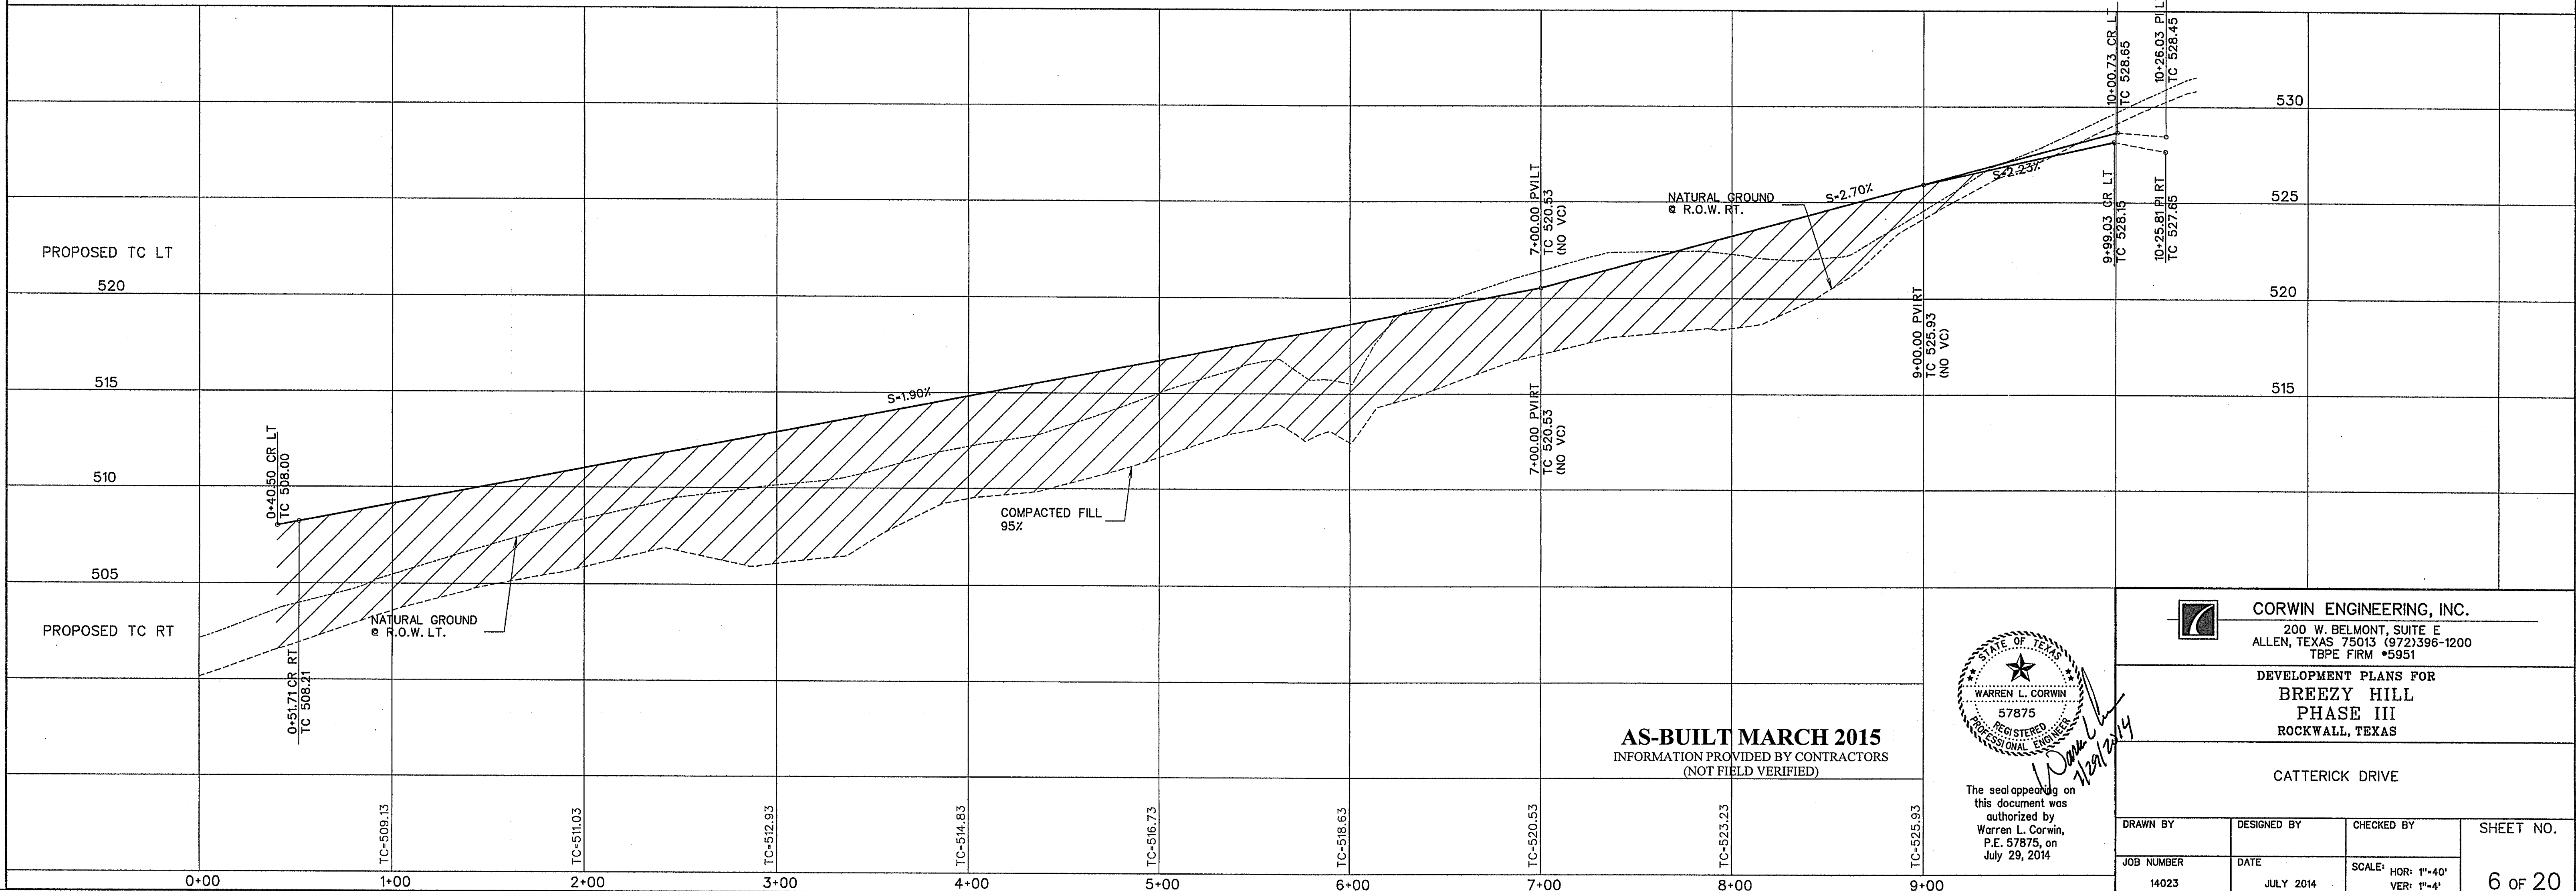

◆ - STREET NAME CHANGE
 ◇ - BARRIER FREE RAMP

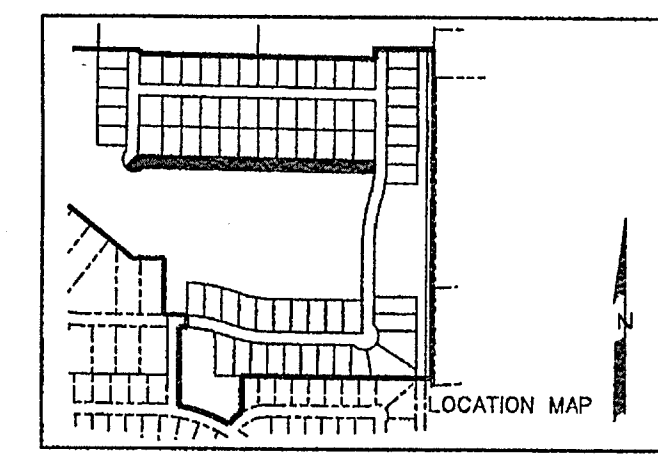

AS-BUILT MARCH 2015
 INFORMATION PROVIDED BY CONTRACTORS
 (NOT FIELD VERIFIED)

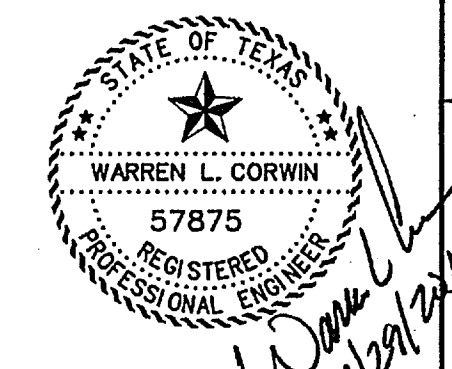

The seal appearing on this document was authorized by Warren L. Corwin, P.E. 57875, on July 29, 2014

CORWIN ENGINEERING, INC.
 200 W. BELMONT, SUITE E
 ALLEN, TEXAS 75013 (972)396-1200
 TBPE FIRM #5951

DEVELOPMENT PLANS FOR
BREEZY HILL
 PHASE III
 ROCKWALL, TEXAS

CATTERICK DRIVE

DRAWN BY	DESIGNED BY	CHECKED BY	SHEET NO.
14023	JULY 2014	SCALE: HOR: 1"=40' VER: 1"=4'	6 OF 20