
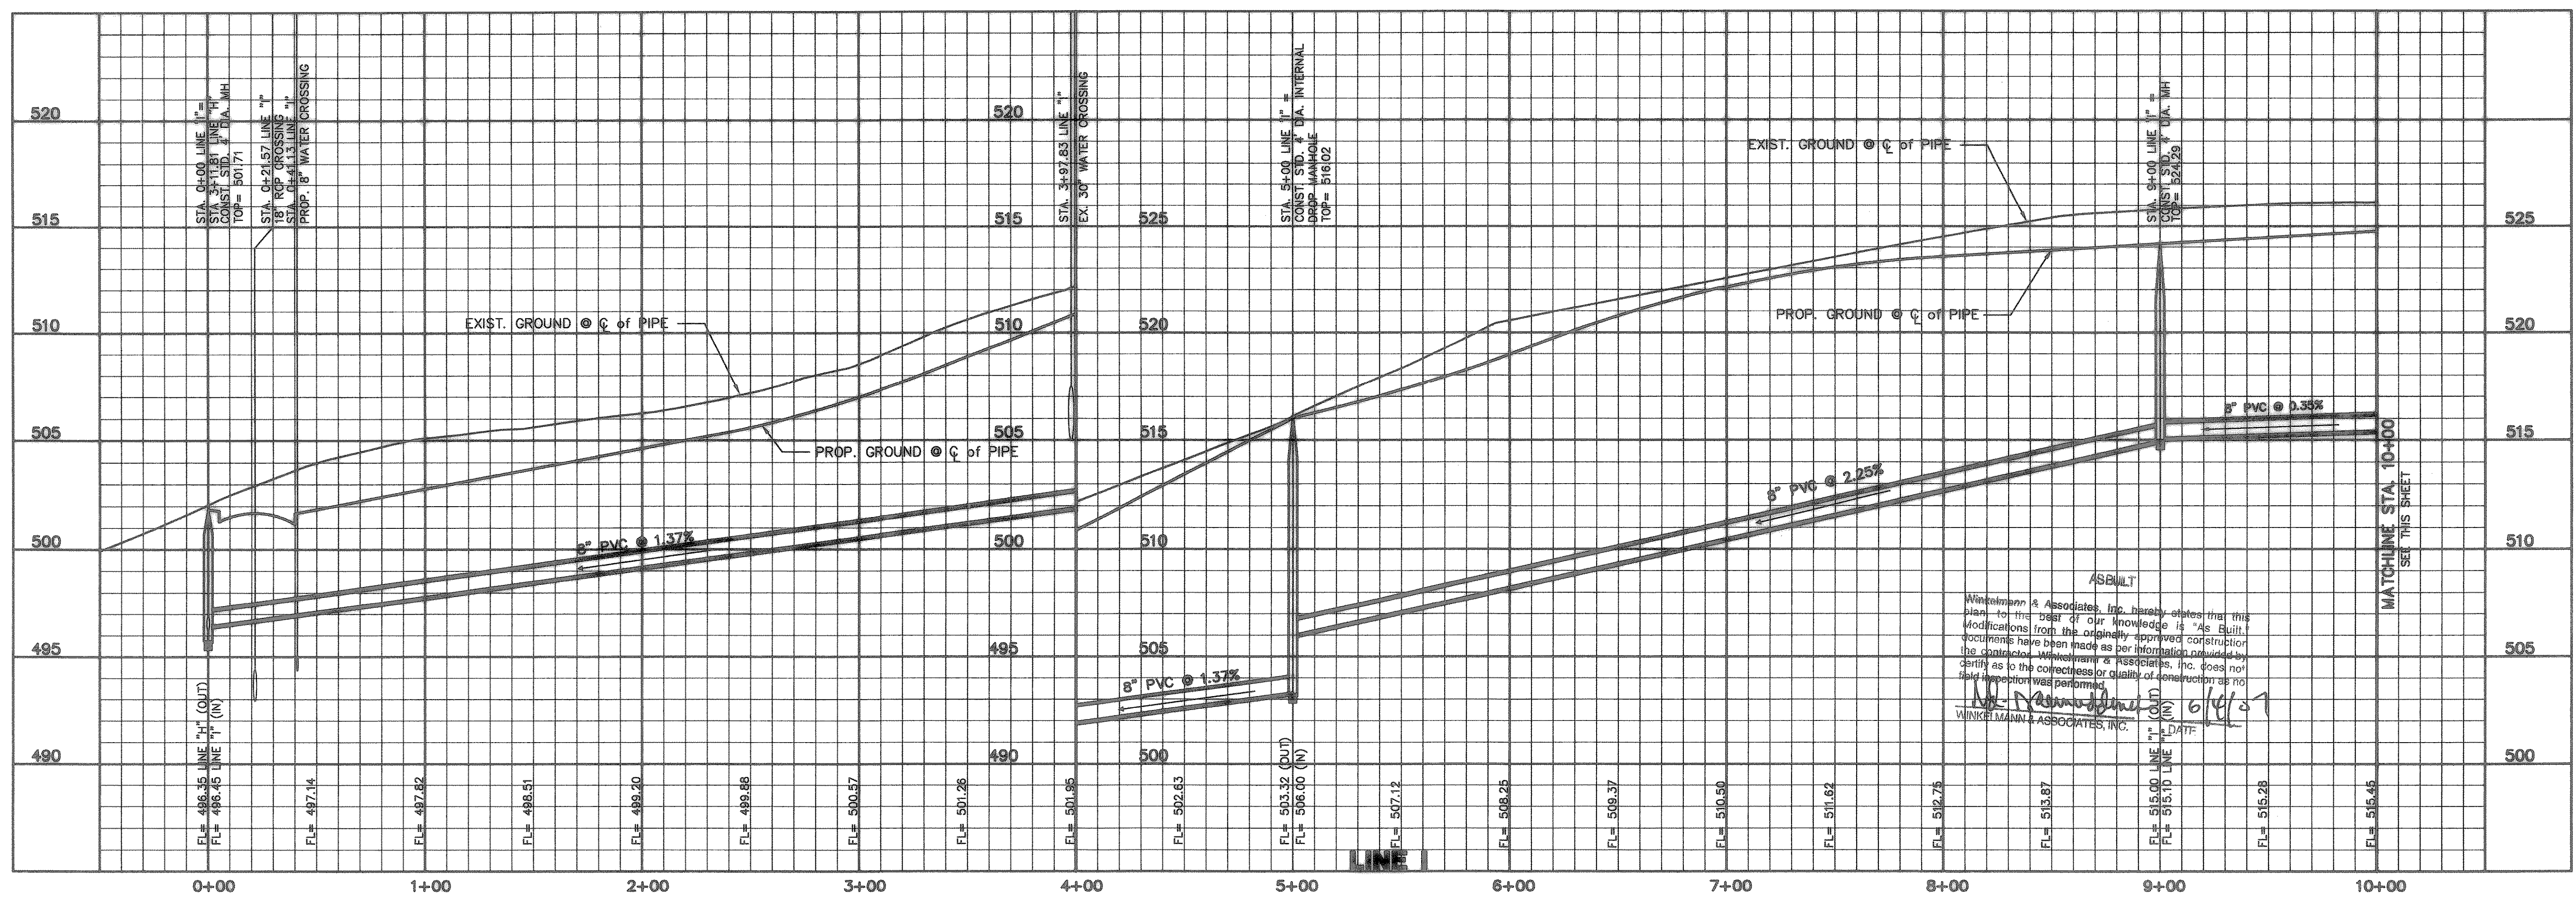


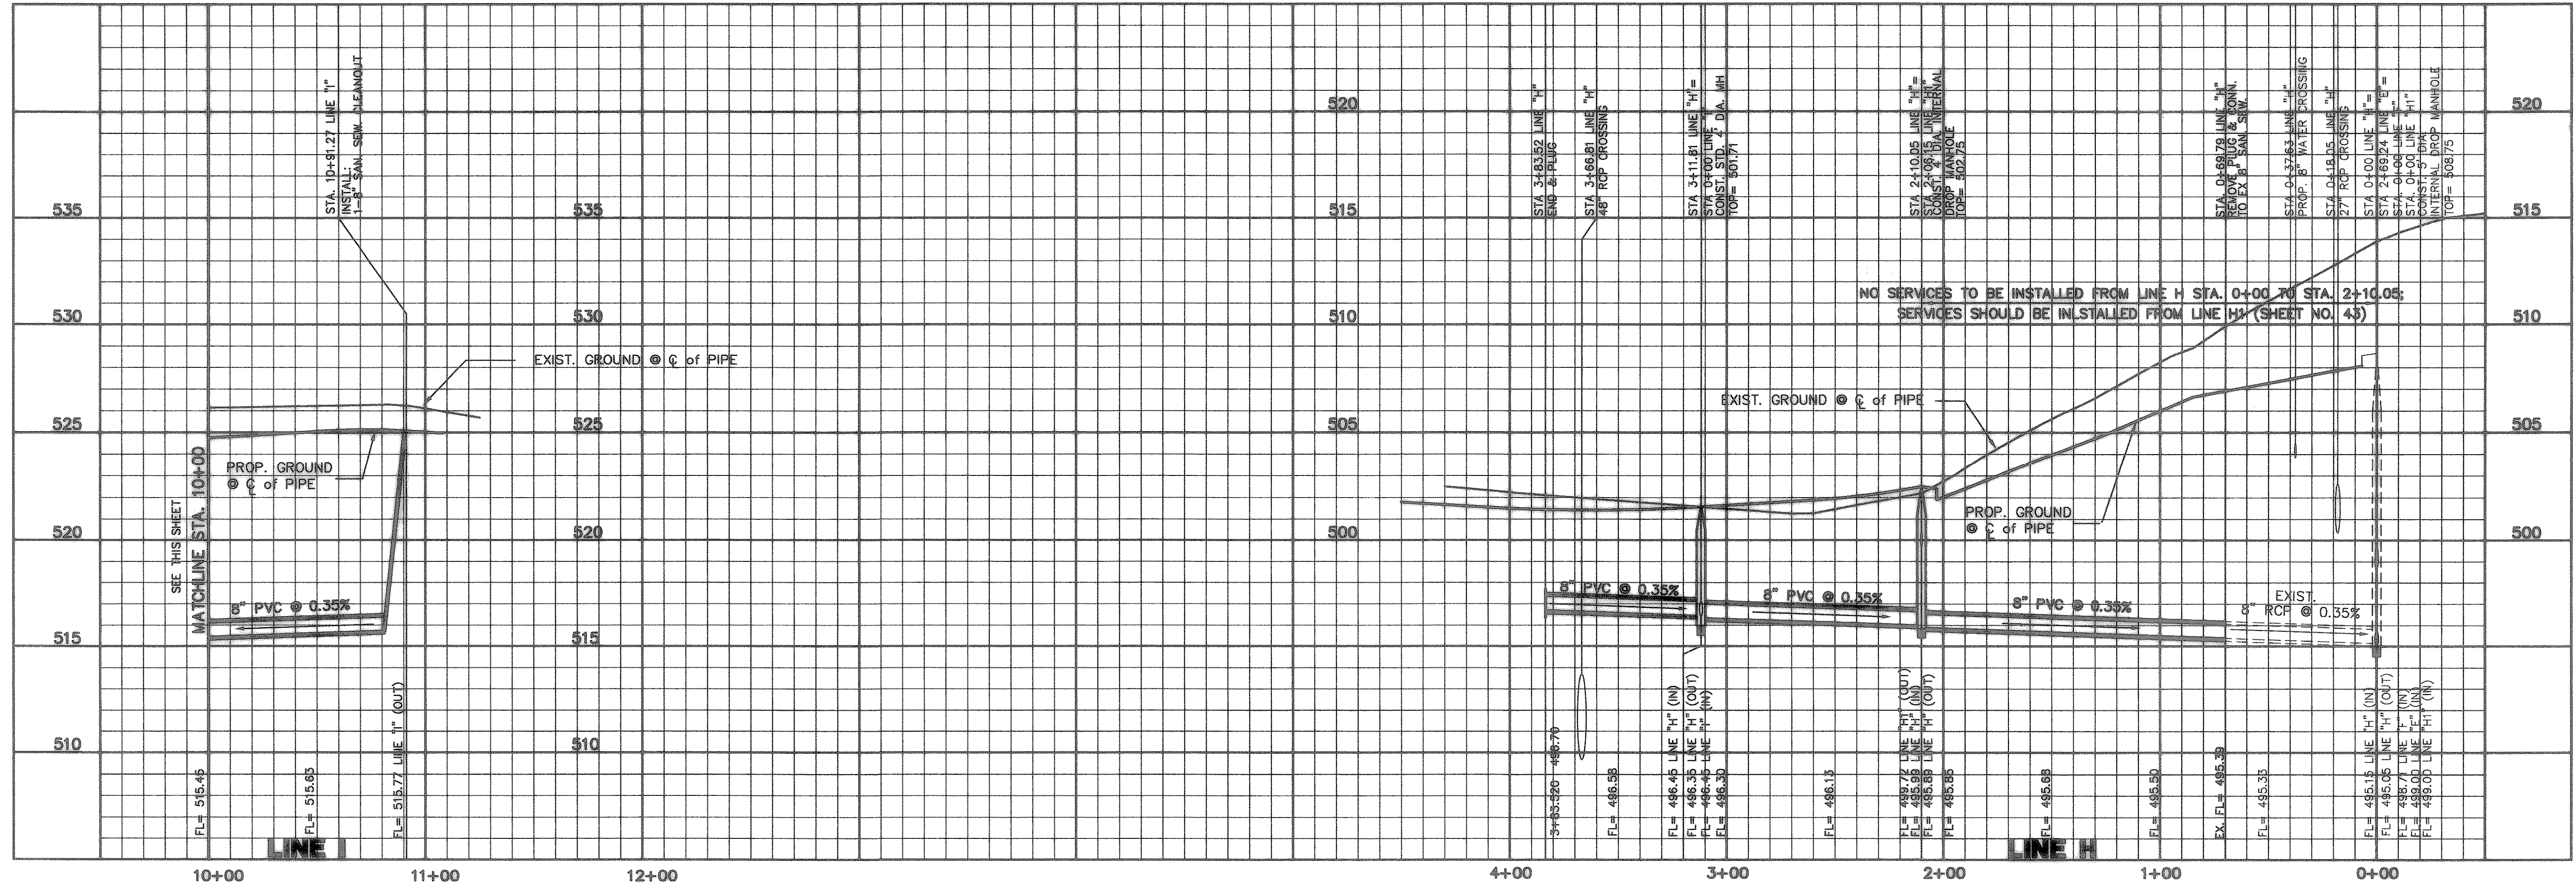

Winkelman & Associates, Inc. hereby states that this plan to the best of our knowledge is "As Built". Modifications from the originally approved construction documents have been made as per information provided by the contractor. Winkelman & Associates, Inc. does not certify as to the correctness or quality of construction as no field inspection was performed.

Not Recommended 3/6/12

WINKELMAN & ASSOCIATES, INC. S. & DATE:

BENCHMARK: "C" CHISELED EAST OF MORNINGSTAR DRIVE AND LOT NORTH OF MIDNIGHT PASS. ELEV. 513.26	BENCHMARK: PK NAIL IN S. OF CARUTH LANE & ALLEY INTERSECTION 150' E. EAST OF MORNINGSTAR DRIVE. ELEV. 961.66
---	---

THESE CONSTRUCTION PLANS WERE PREPARED
UNDER THE RESPONSIBLE SUPERVISION OF
MD. NAIM UDDIN KHAN, REGISTERED PROFESSIONAL
ENGINEER NO. 87776

MD. Naimuddin Khan 8/15/06

THE SEAL APPEARING ON THIS
DOCUMENT WAS AUTHORIZED BY
MD. NAIM UDDIN KHAN, # 87776

NO.	DATE	REVISION	APPROV.	

SANITARY SEWER PROFILE
LINE I - STA. 0+00 STA. 1+07.93
LINE H - STA. 0+69.79 STA. 3+63.52
(PHASE 0B)

Scale : 1"=40'	Date : 08/15/06
Designed By : RB	
Drawn By : MS	
Checked By : NK	
File : 146546ANSP.DWG	
Project No. : 14654.01	

M.B. JONES SURVEY, ABSTRACT NO. 122
CITY OF ROCKWALL
ROCKWALL COUNTY, TEXAS

LUMBERMEN'S INVESTMENT CORPORATION
5495 BELTLINE ROAD #225
DALLAS, TEXAS 75240

**Winkelmann
& Associates, Inc.**

CONSULTING CIVIL ENGINEERS ■ SURVEYORS

5750 Wilford Plaza Drive, Suite 100
Dallas, Texas 75249
(972) 480-7000
(972) 480-7055 FAX
www.winkelmann.com

