




TYPICAL PLACEMENT DETAIL
AT CORNER WITH B.F.R.

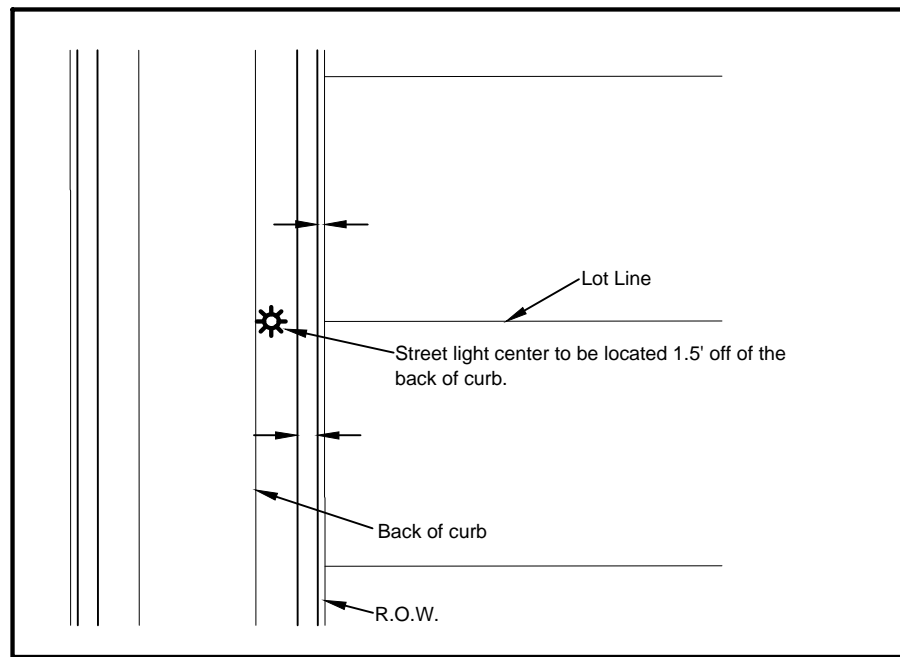

TYPICAL PLACEMENT DETAIL
AT NON-INTERSECTION

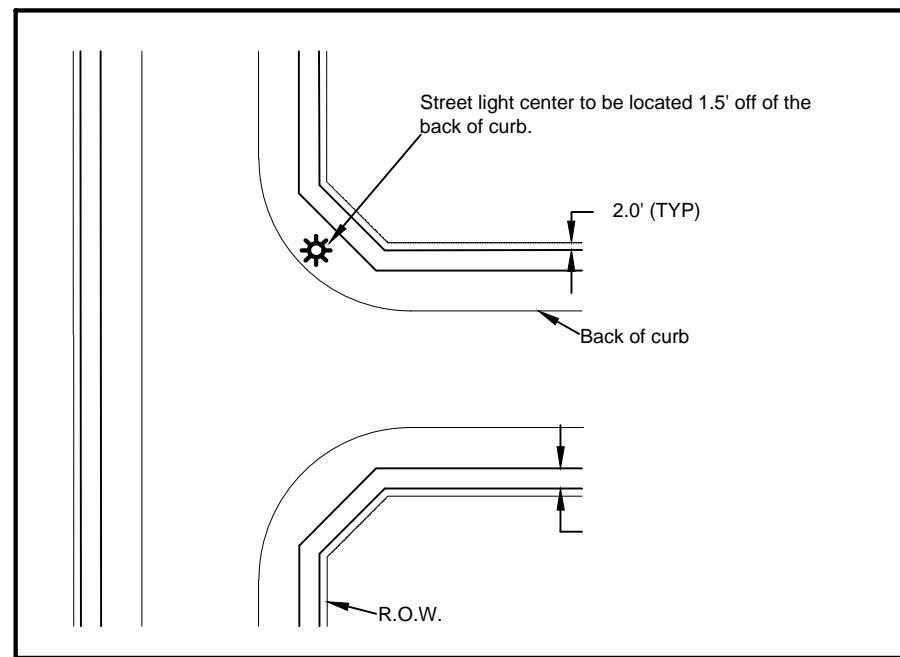



TYPICAL PLACEMENT DETAIL
AT CORNER WITHOUT B.F.R.

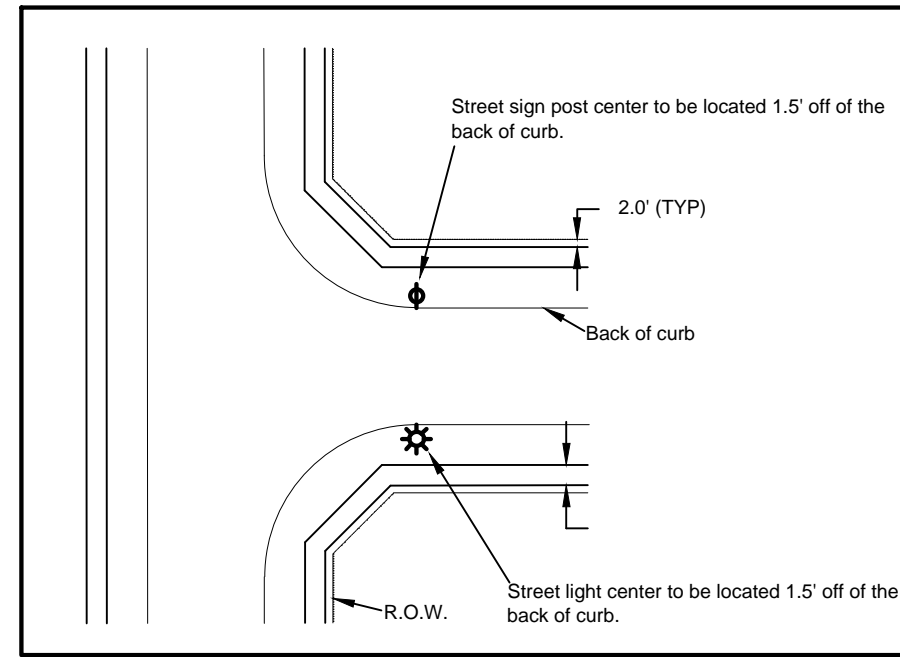

TYPICAL PLACEMENT DETAIL
AT INTERSECTION WITH LIGHT &
SERVICE ON OPPOSITE CORNERS

- LEGEND:**
- ☼ STAND ALONE STREET LIGHT
 - ⊕ SIGN AND POST LOCATION
(TRAFFIC SIGN AND/OR STREET NAME SIGN)
 - ⊕ EX. TRAFFIC SIGN AND/OR STREET NAME SIGN
 - ☼ EX. STREET LIGHT-RESIDENTIAL

- NOTES**
1. BLOCK NUMBERS ARE REQUIRED ON ALL STREET NAME BLADES
 2. ALL SIGNAGE INSTALLED SHALL COMPLY WITH THE CURRENT TEXAS MANUAL ON UNIFORM TRAFFIC CONTROL DEVICES.
 3. STREET NAME BLADES SHALL BE NINE INCH TALL EXTRUDED ALUMINUM. THE BLADES SHALL BE 0.080 INCHES THICK.
 4. HIGH INTENSITY RETROREFLECTIVE SHEETING FOR STREET AND REGULATORY AND WARNING SIGN SHALL BE DIAMOND GRADE PRISMATIC TYPE III HIGH INTENSITY.
 5. THE LETTERING FOR STREET NAME BLADES SHALL BE HIROAD B-FONT HIGHWAY GOTHIC-8" UPPERCASE 6" TALL LETTERS. LETTERS OF ABBREVIATED STREET DESIGNATIONS SHALL BE 3" TALL AND ALL UPPERCASE (I.E., LN, PKWY, CT, ETC.). BLOCK NUMBERS SHALL BE 3" TALL.
 6. THE STREET BACKGROUND SHALL BE GREEN AND THE LEGEND SHALL BE WHITE.
 7. STREET BLADE MUST INCORPORATE THE CURRENT CITY OF ROCKWALL LOGO.
 8. FOR A STREET WITH ONLY ON CUL-DE-SAC END, A STANDARD W 14-2A SHALL BE MOUNTED OVER THE STREET NAME BLADE. IN THE CASE WHERE TWO CUL-DE-SAC ENDS, TWO STANDARD W 14-2A SIGNS SHALL BE MOUNTED OVER THE STREET NAME BLADE IN THE APPROPRIATE DIRECTIONS.

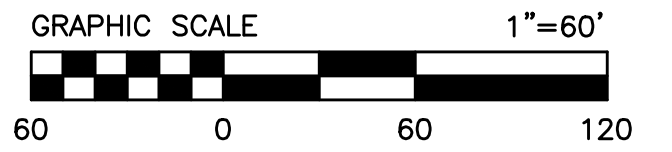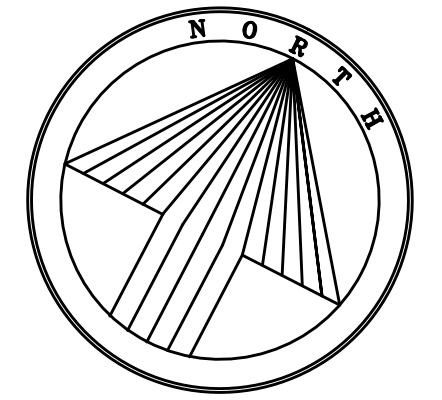

ALL RESPONSIBILITY FOR ADEQUACY OF DESIGN REMAINS WITH THE DESIGN ENGINEER. THE CITY OF ROCKWALL, IN REVIEWING AND RELEASING PLANS FOR CONSTRUCTION, ASSUMES NO RESPONSIBILITY FOR ADEQUACY OR ACCURACY OF DESIGN.


BENCHMARKS

1. X-chiseled in CL of Alley East of Morningstar Drive within the third lot north of Midnight Pass. Elevation = 513.26
2. PK Nail in CL of Caruth Lane & Alley intersection 150 feet +/- east of Morningstar Drive. Elevation = 491.68

NO.	REVISIONS DURING CONSTRUCTION	BY	DATE

AS-BUILT DRAWING
TO THE BEST OF JBI PARTNERS, INC. KNOWLEDGE HEREBY STATES THIS PLAN IS AS-BUILT. THE INFORMATION PROVIDED IS BASED ON CONSTRUCTION STAKING AND PAD VERIFICATION AT THE SITE AND INFORMATION PROVIDED BY THE CONTRACTOR.

NAME *Daniel Dewey* DATE *04-13-2015*

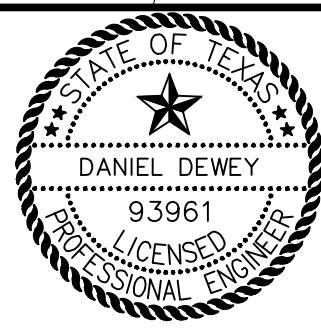

The seal appearing on this document was authorized by DANIEL DEWEY, P.E. 93961. Alteration of a sealed document without proper notification to the responsible engineer is an offense under the Texas Engineering Practice Act.



Texas Registered Engineering Firm F-438

16301 Quorum Drive
Suite 200 B
Addison, Texas 75001
Main 972.248.7676
Fax 972.248.1414
www.jbipartners.com

SIGNAGE AND LIGHTING PLAN

Caruth Lakes Phase 7D
City of Rockwall, Texas

PROJECT NO.
HOE132
SHEET NO.
19