




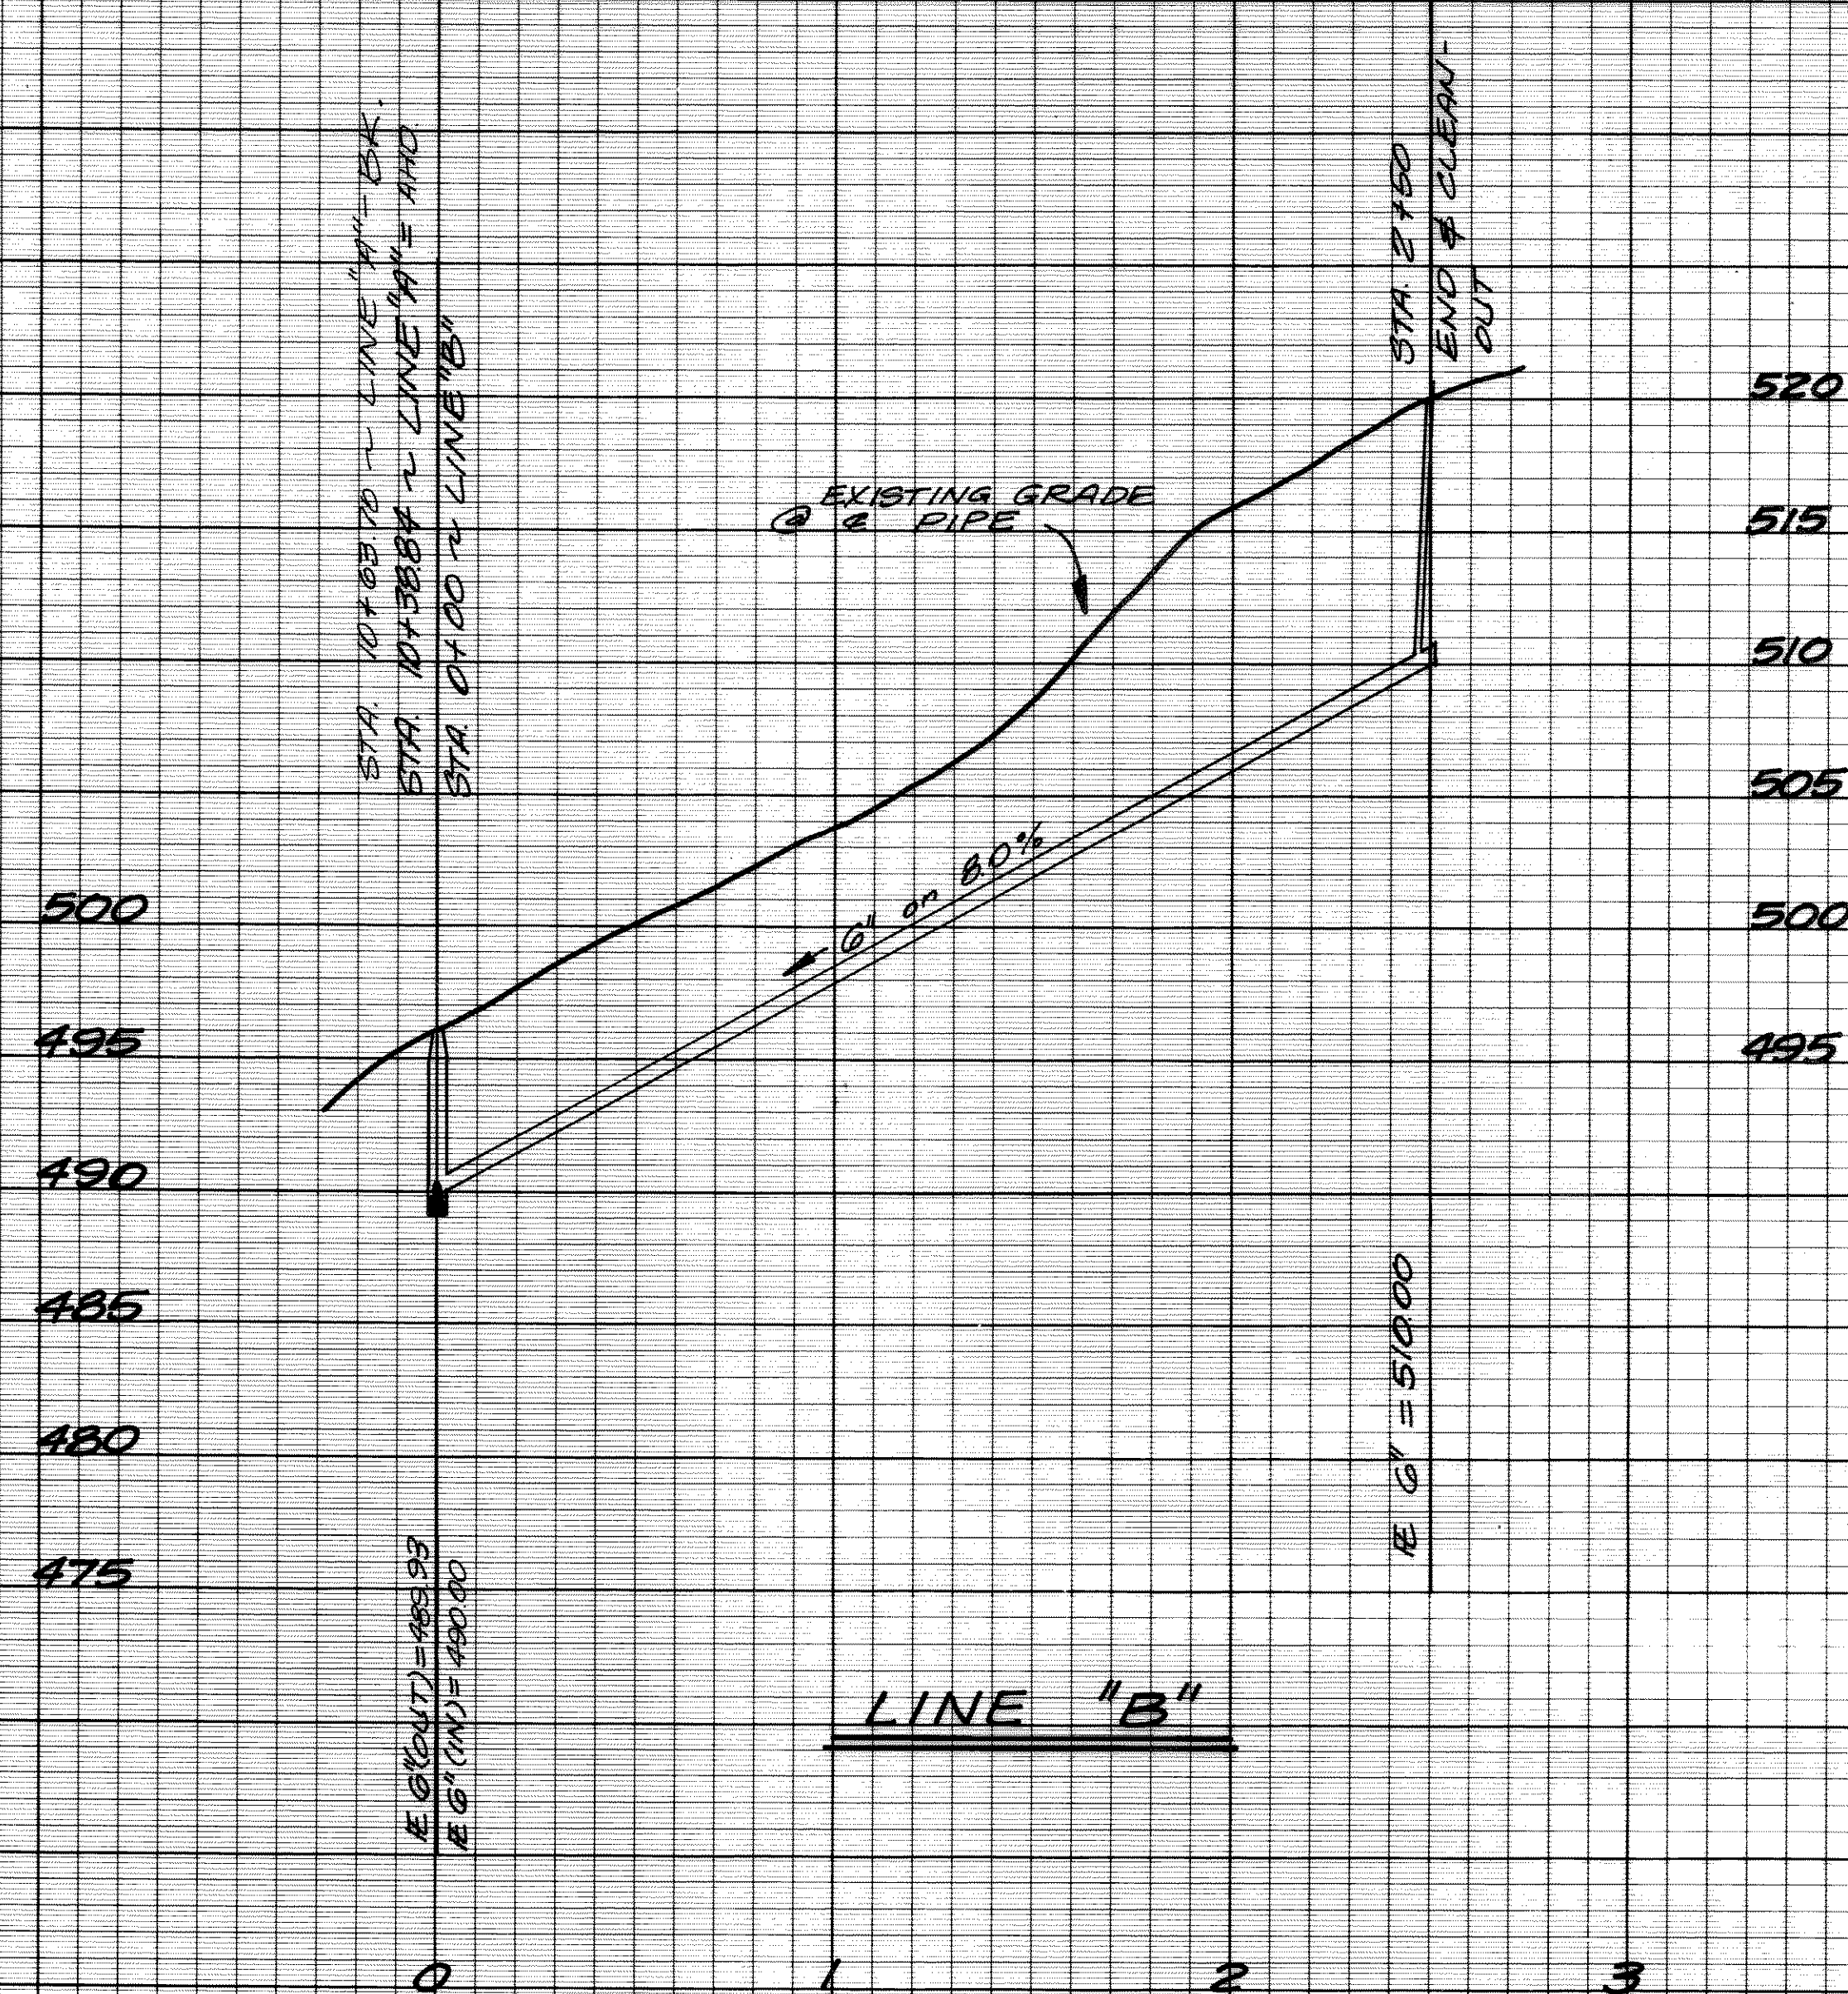

520
515
510
505
500
495
510
505
500
495
490
485

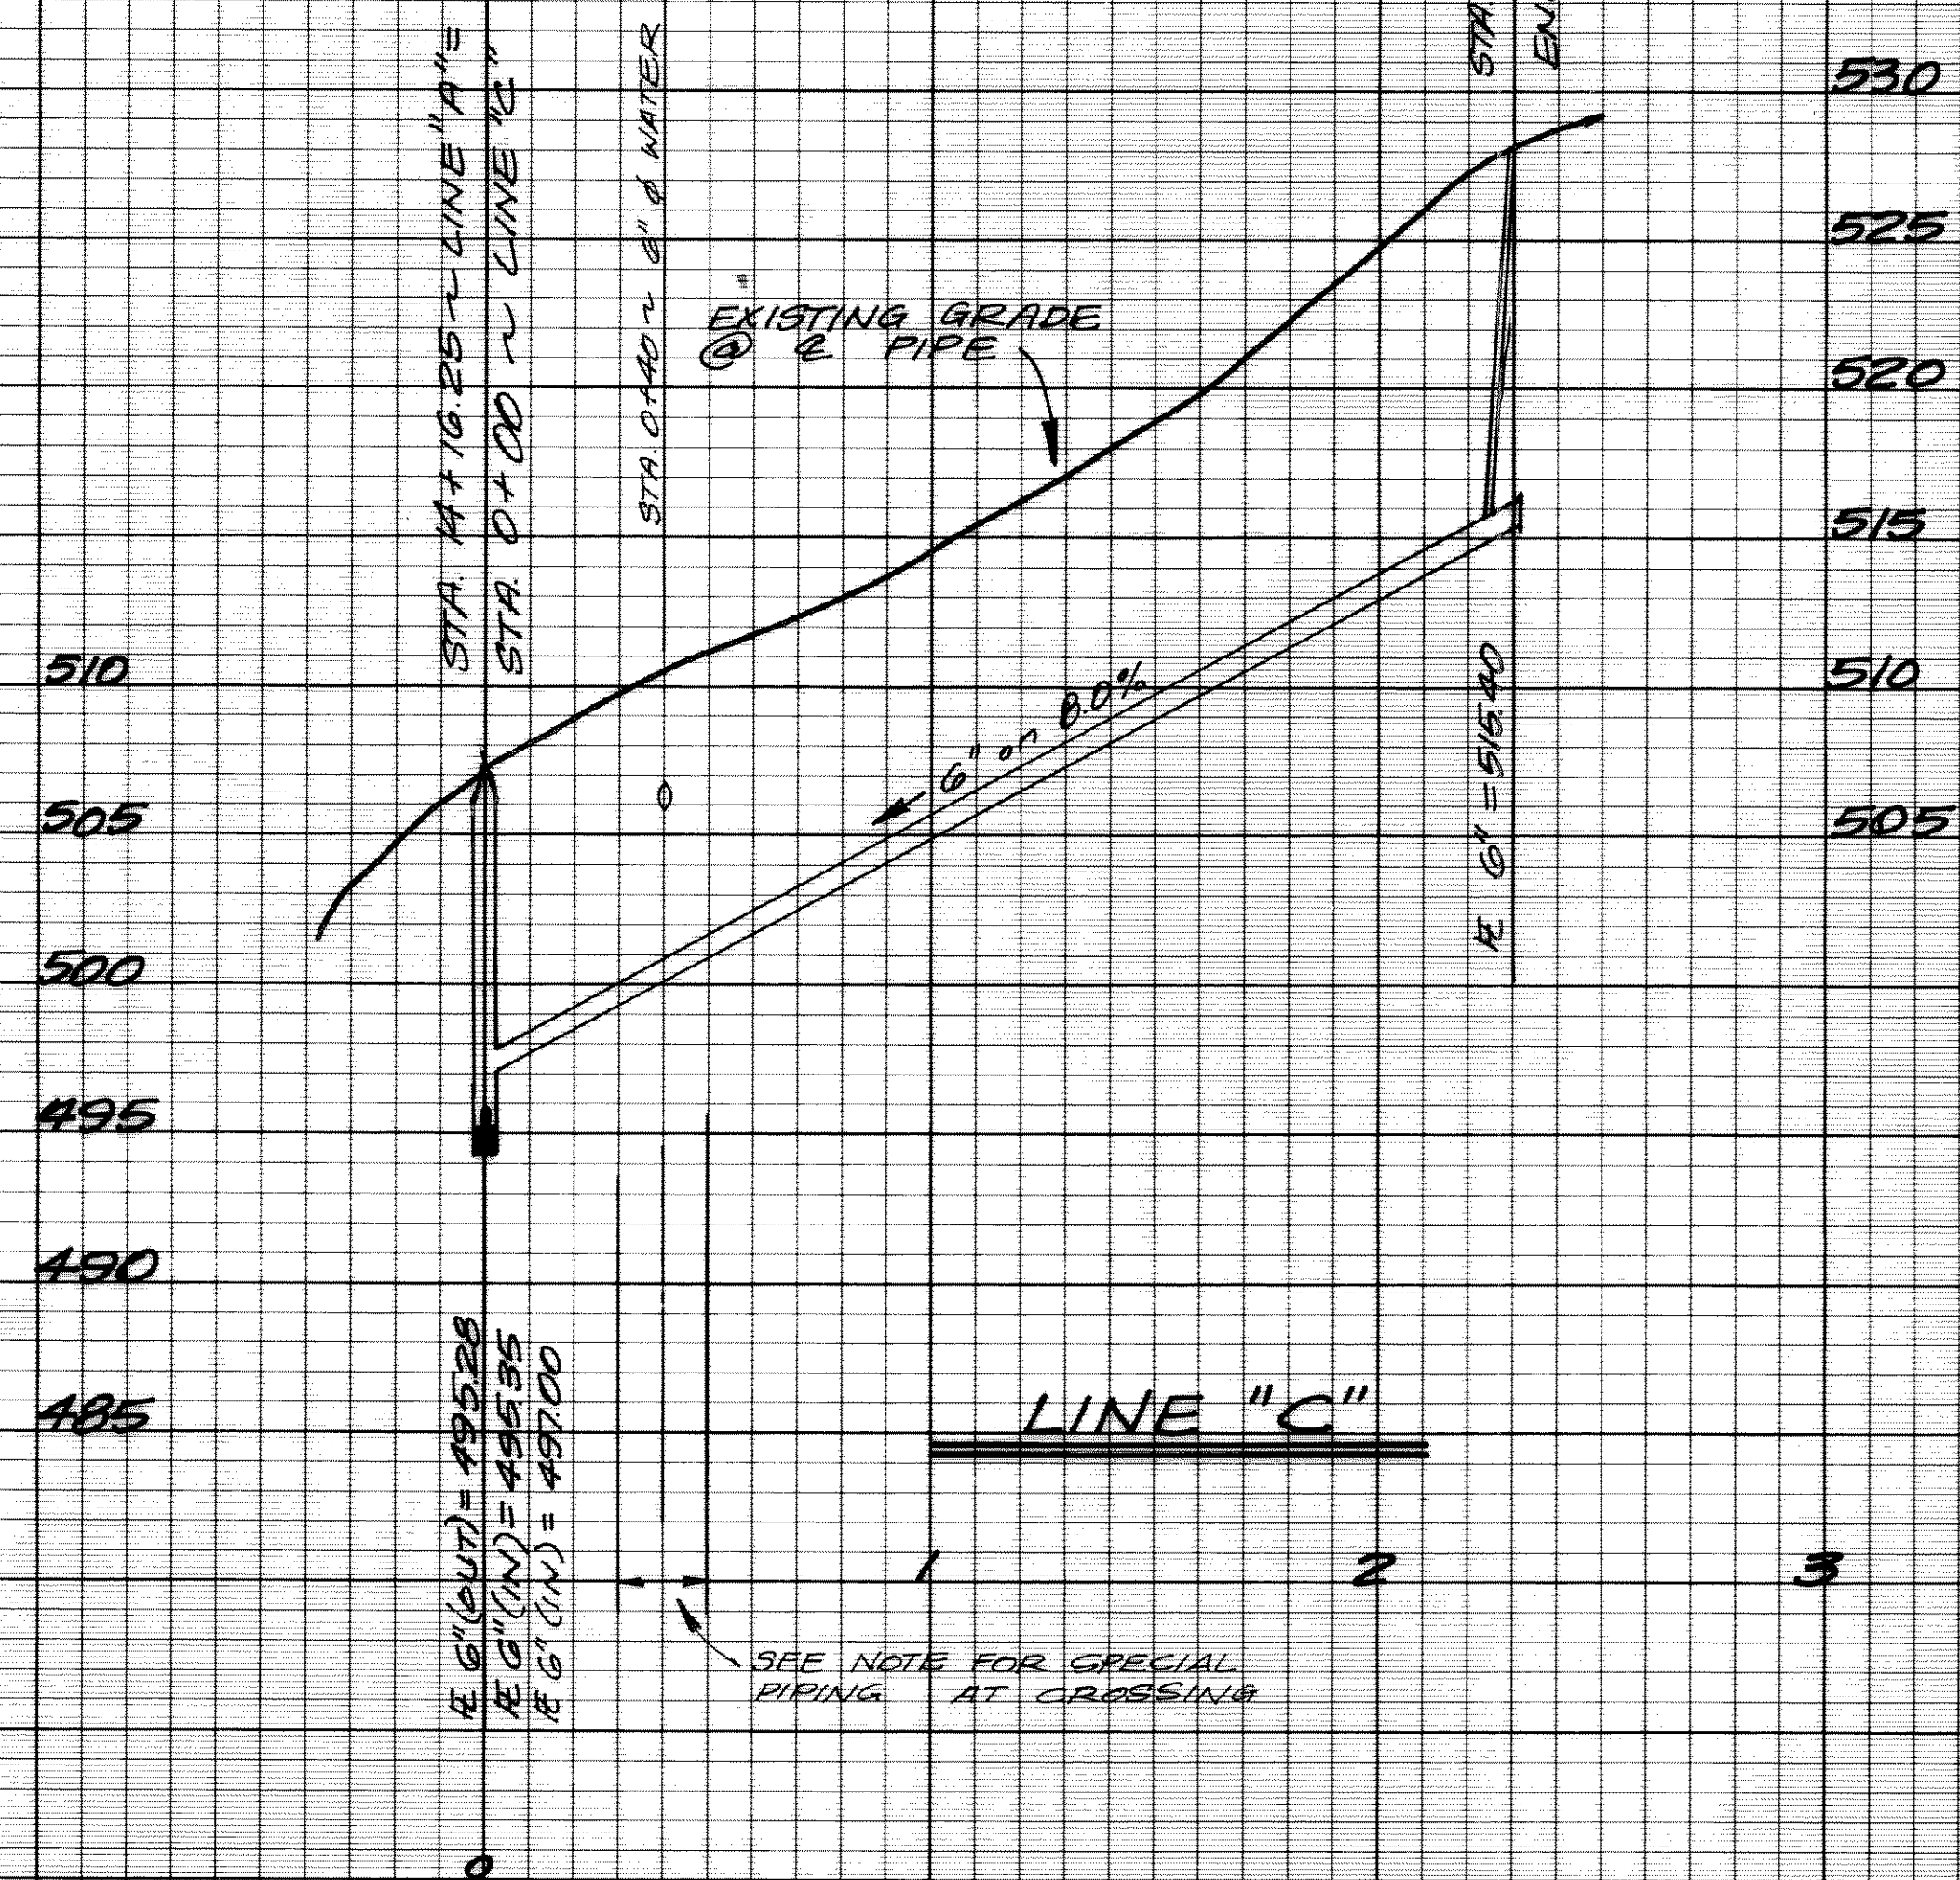

530
525
520
515
510
505

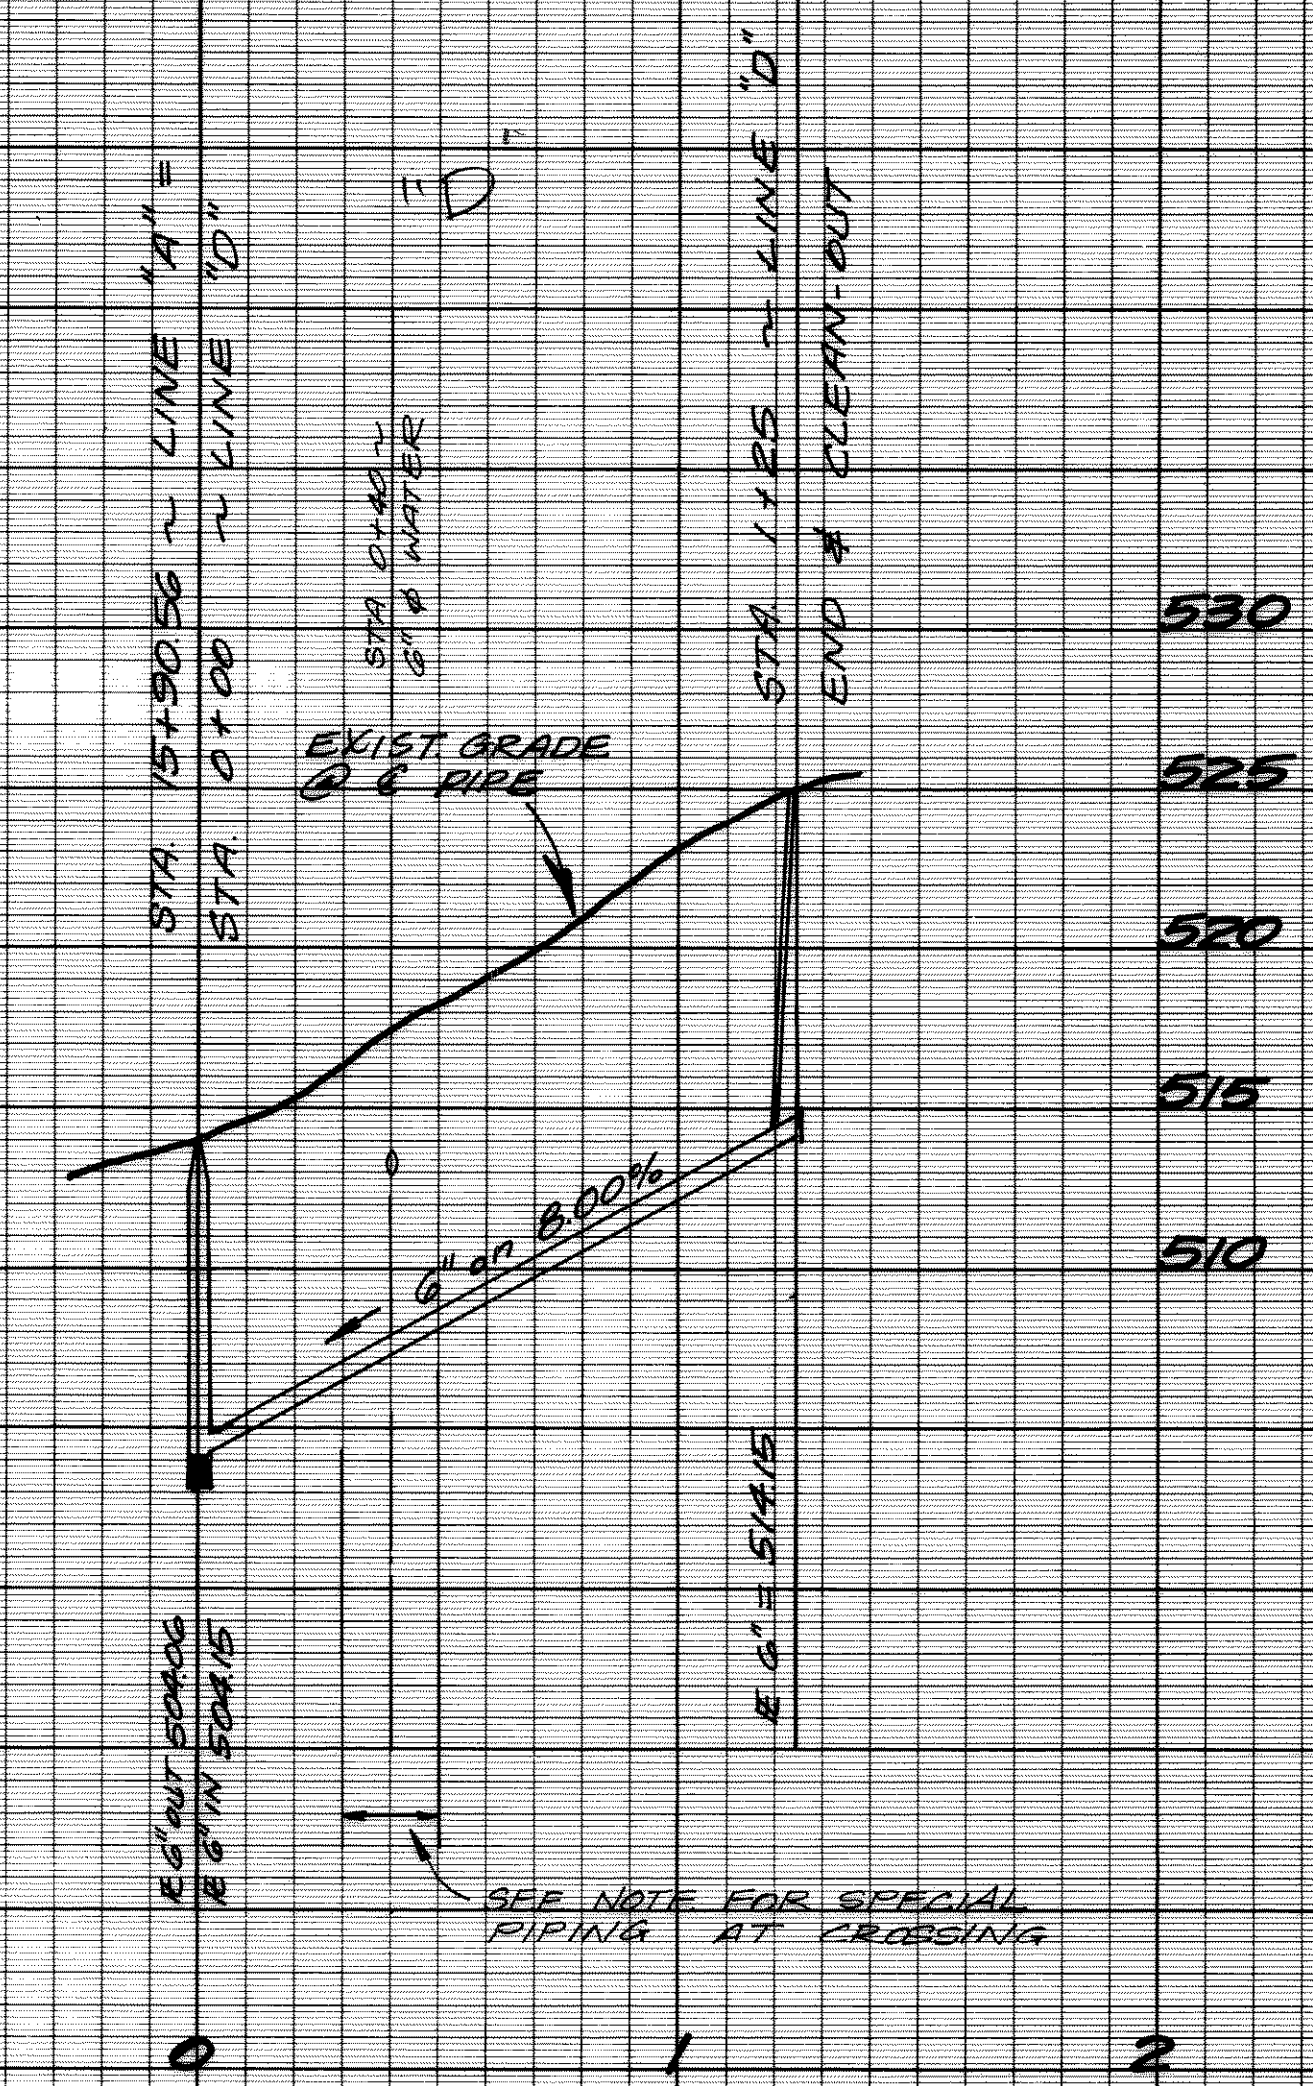

530
525
520
515
510