



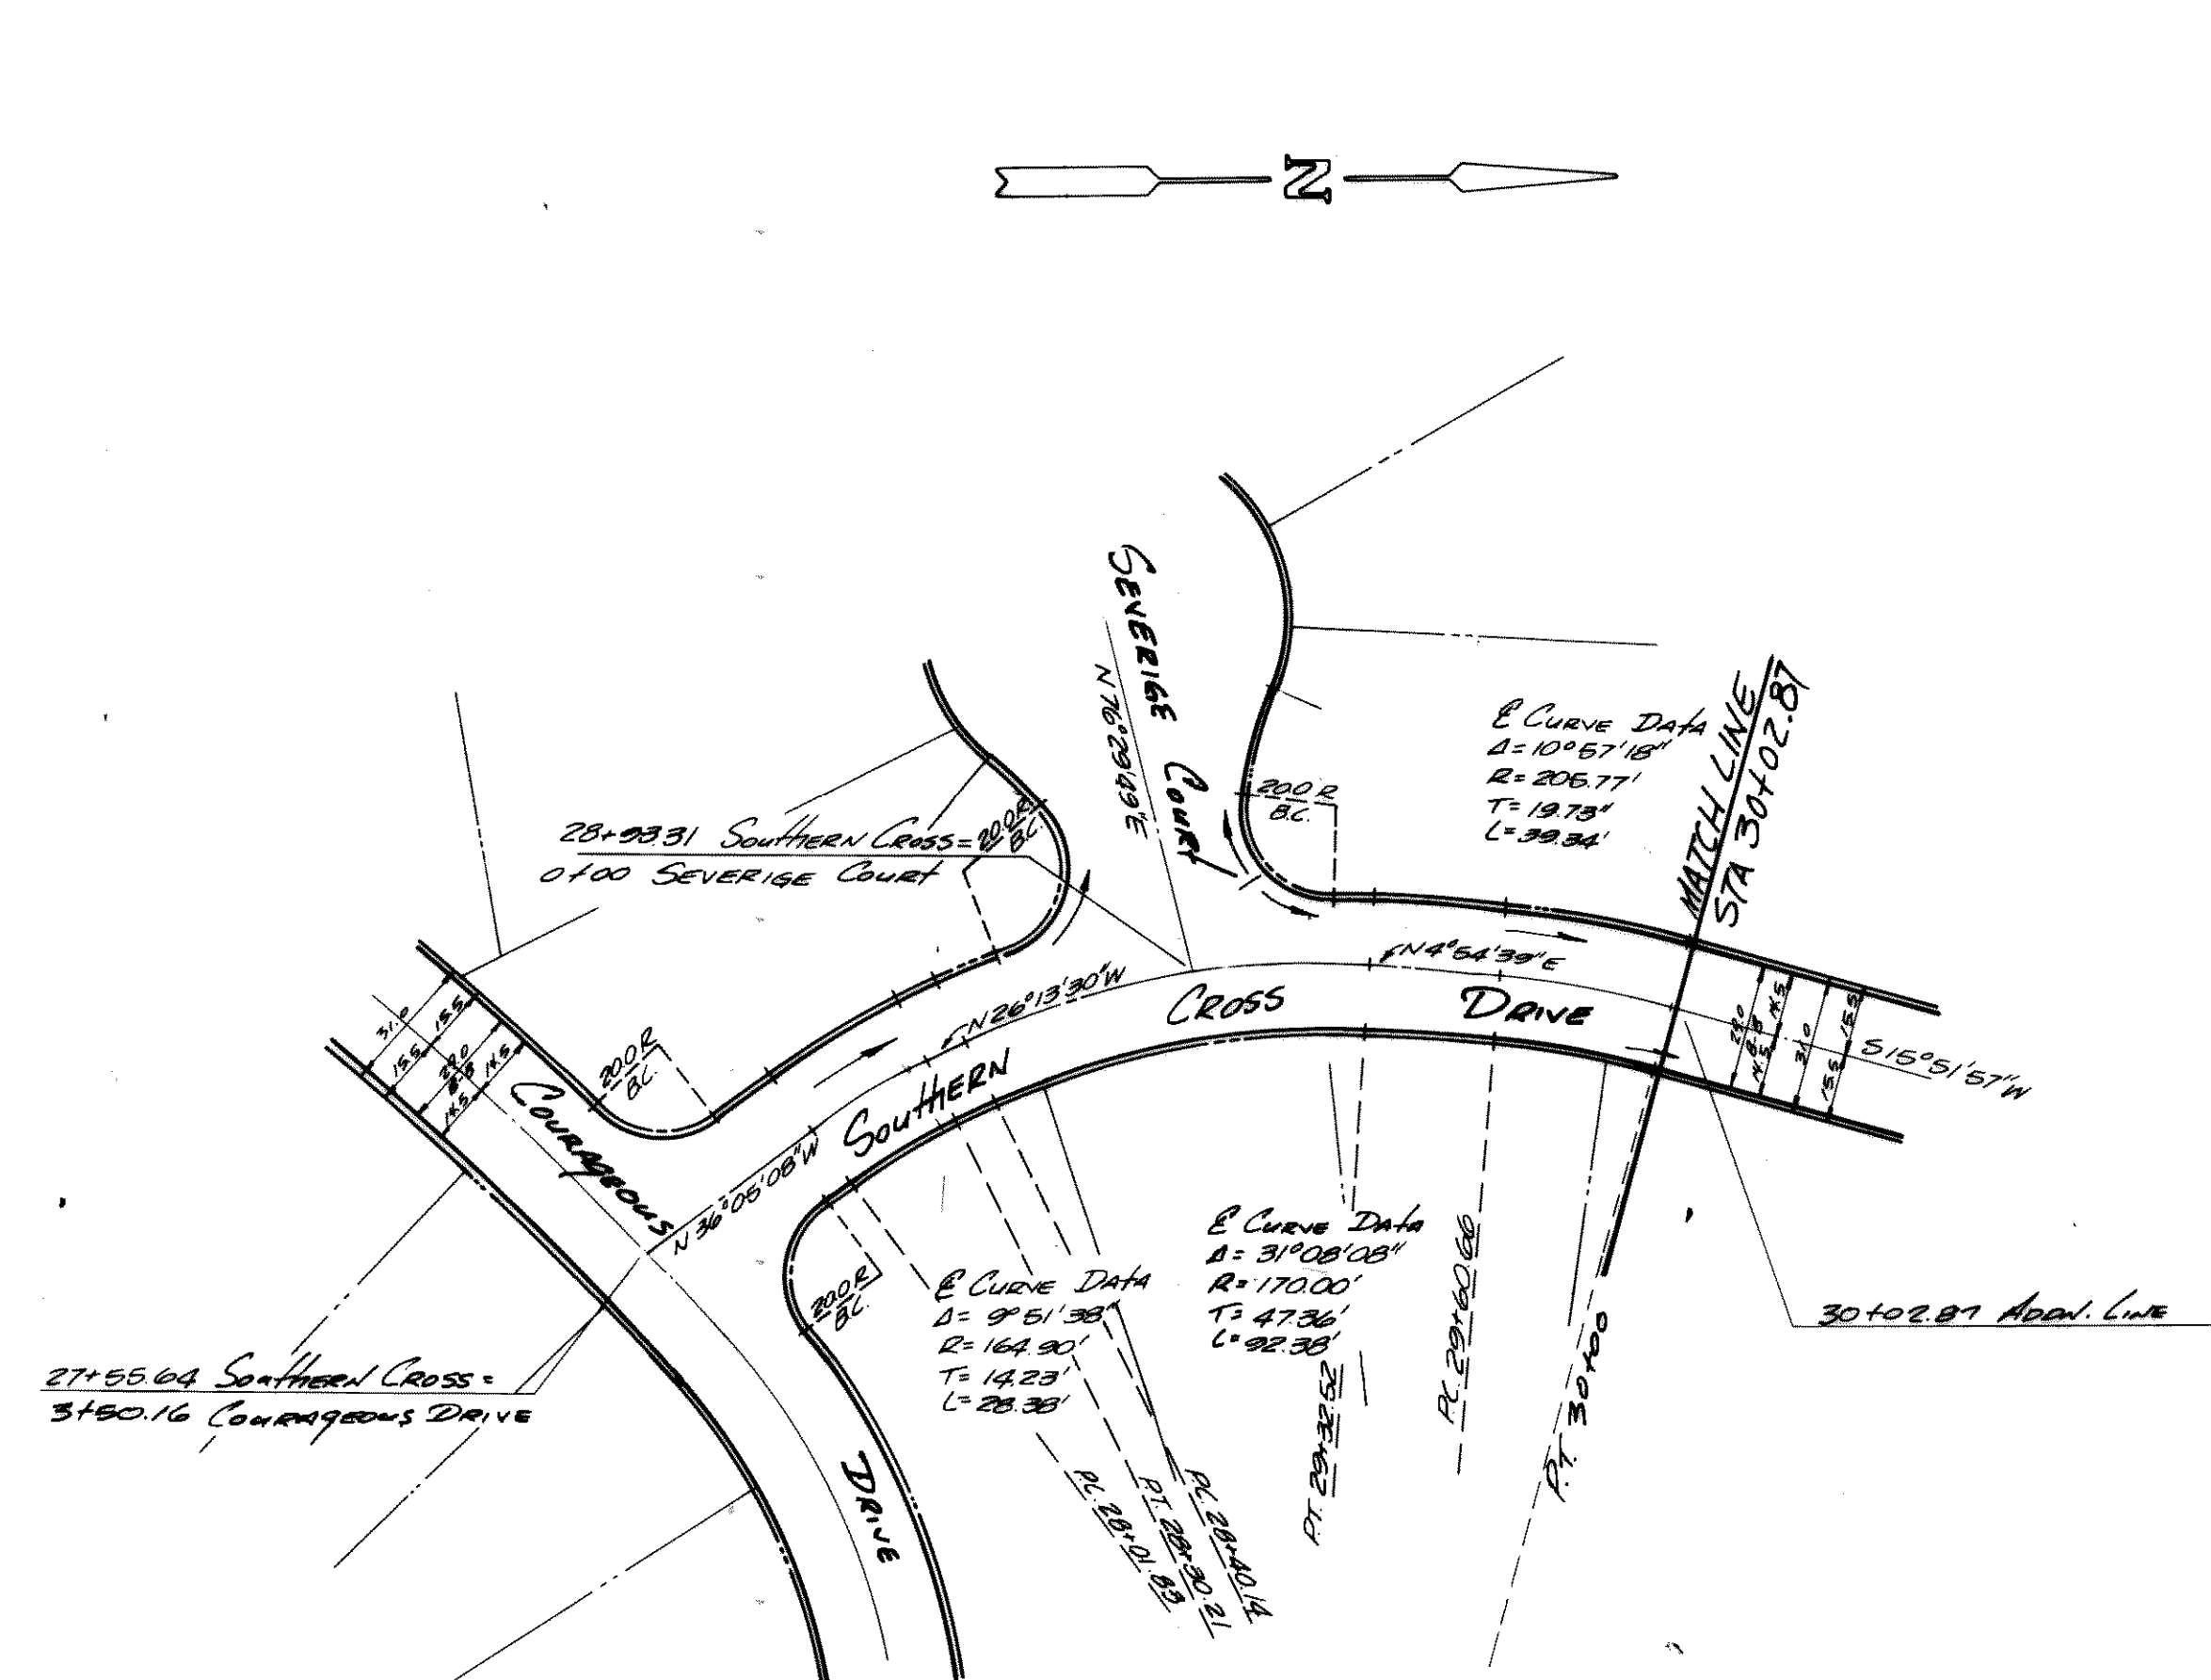

EXISTING PAVEMENT
NOT IN CONTRACT

SOUTHERN CROSS
DRIVE

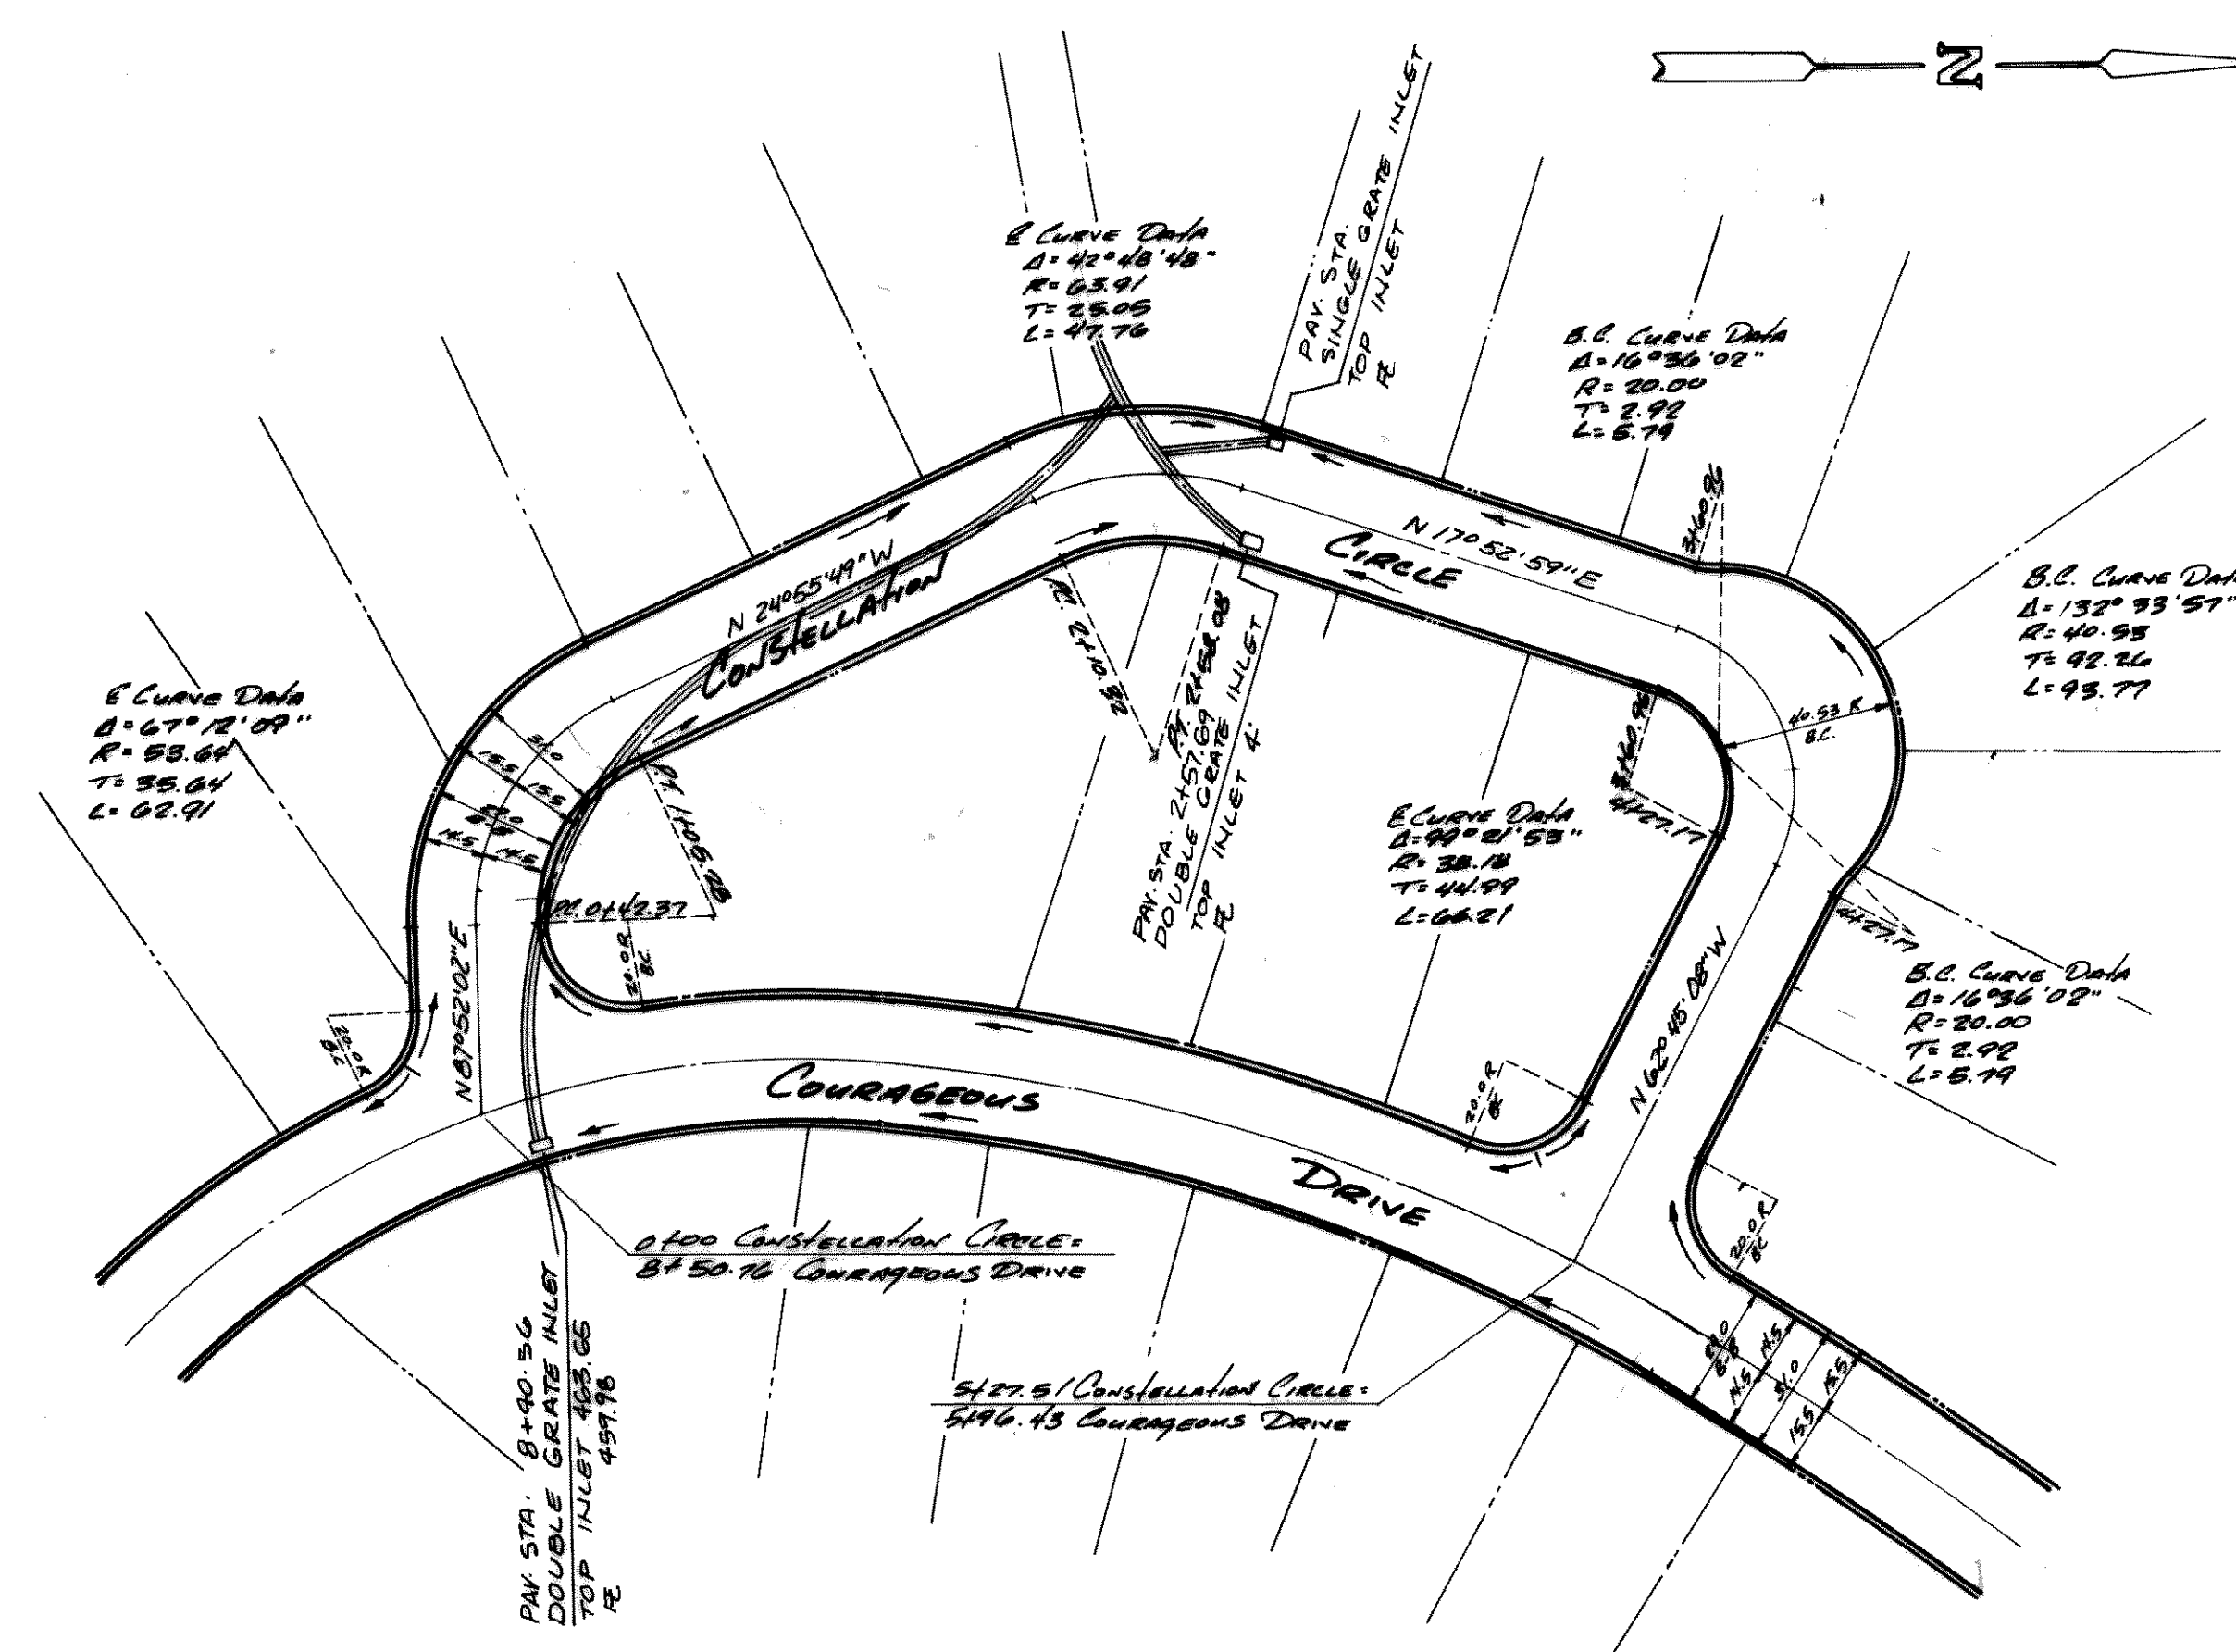


AS-BUILT

CONSTELLATION CIRCLE

"X" cut at centerline intersection of Yacht
Club Drive and Entrapido Circle
Elev. 502.53

"Square" cut on top of grate inlet halfway between
Chandlers Landing Yacht Club and back-of-curb
of island
Elev. 459.57

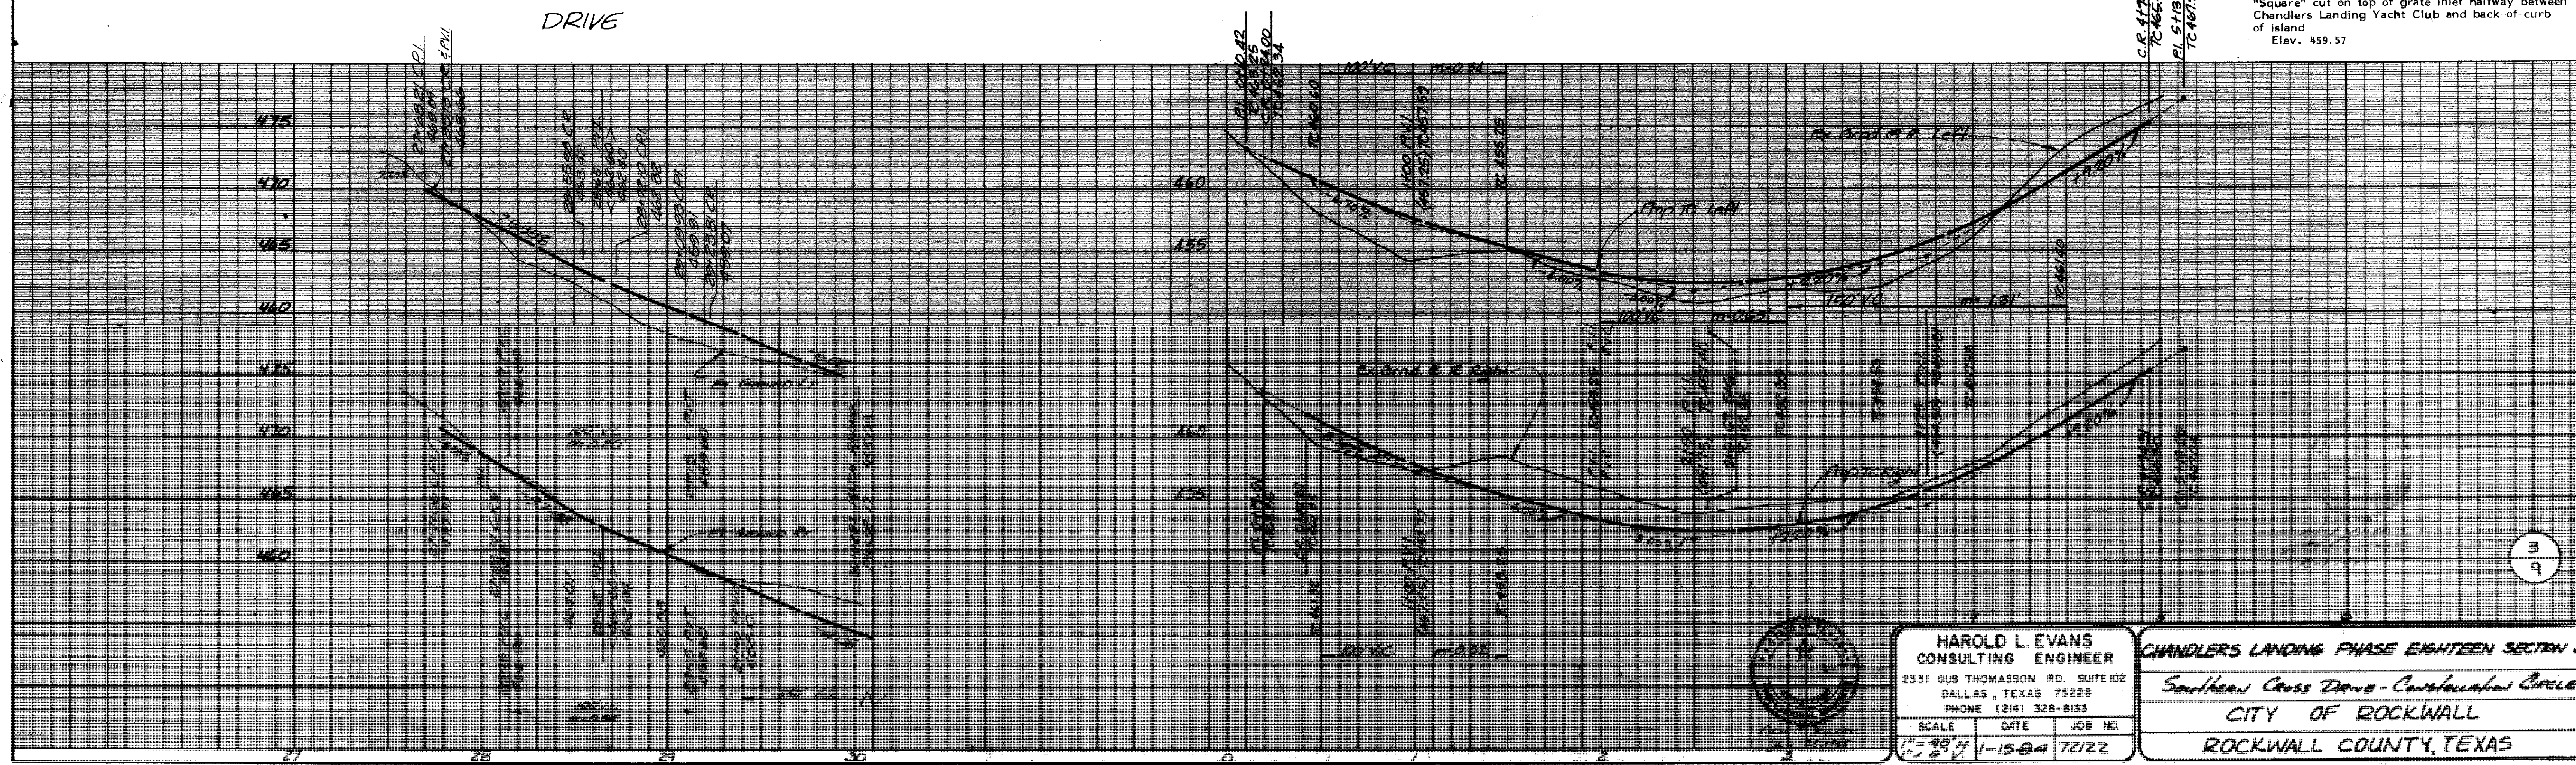

HAROLD L. EVANS
CONSULTING ENGINEER
2331 GUS THOMASSON RD. SUITE 102
DALLAS, TEXAS 75228
PHONE (214) 328-8133
SCALE 1"=40' 1-15-84 72/22

CHANDLERS LANDING PHASE EIGHTEEN SECTION 2
Southern Cross Drive - Constellation Circle
CITY OF ROCKWALL
ROCKWALL COUNTY, TEXAS

REV. 6-19-85, 10-16-87, 9-25-91, 1-24-92