

"C-T" PIPE ADAPTER

502.10

DATE STANDARD DRAWING P

CITY OF ROCKWALL


EXIST. MAIN -

THIS DETAIL FOR USE ONLY WHEN NEW MAIN WILL NOT MATE WITH EXISTING MAIN JOINT DUE TO DIFFERENT DIMENSIONS OR MATERIALS AND A

WASTEWATER MAIN TIE-IN

AT CLEANOUT OR M.H. STUBOL

MANHOLE IS NOT REQUIRED.

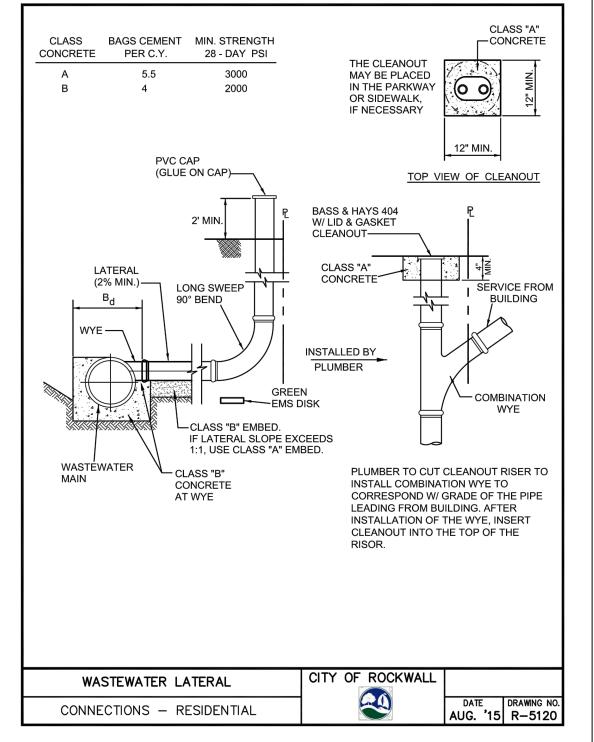



CITY OF ROCKWALL


AUG '19 R-5020

WASTEWATER MANHOLE

PRECAST

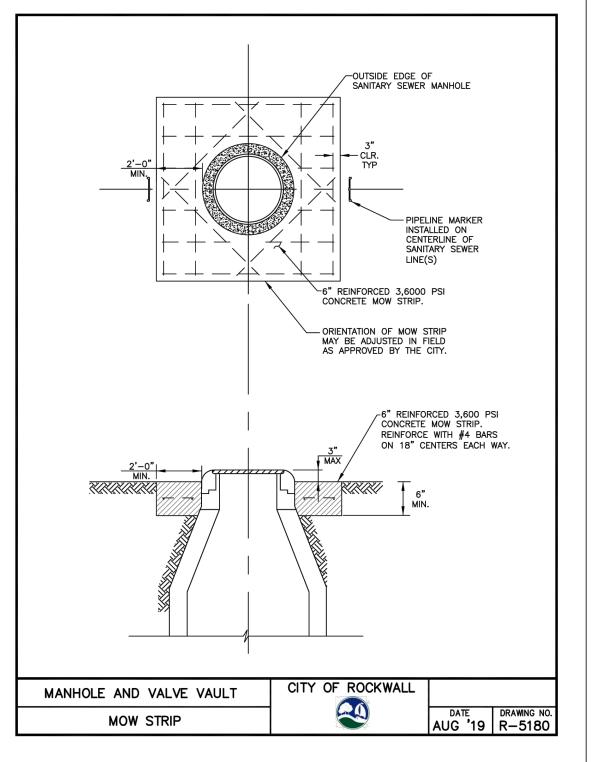

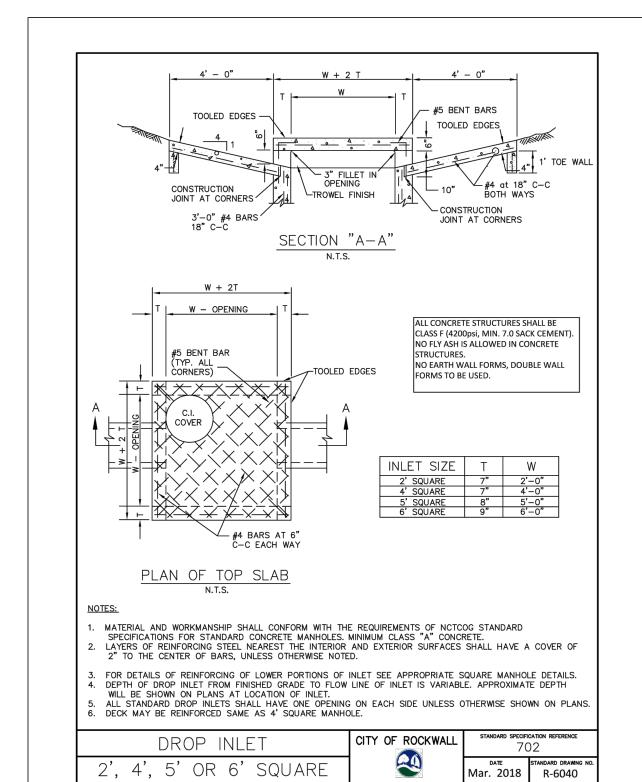

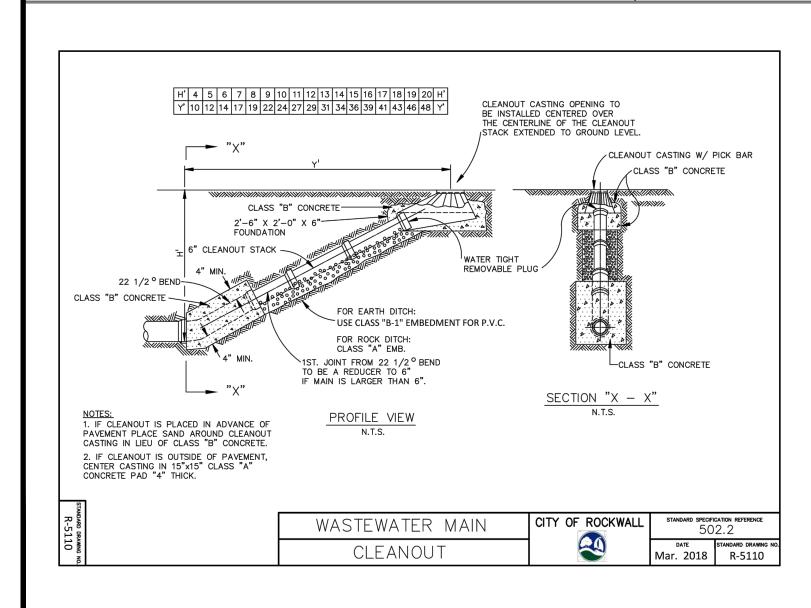



TO THE BEST OF OUR KNOWLEDGE, KSA, HEREBY STATES THAT THIS PLAN IS AS-BUILT. THIS INFORMATION PROVIDED IS BASED ON SURVEYING AT THE SITE AND INFORMATION PROVIDED BY THE CONTRACTOR.

U m 50 COURTIN E ROCKWALI

CK RO 0

S

* 02/22/2022

C9.3

TBPE Firm Registration No. F-1356