




RECORD DRAWINGS  
 Received from Engineer  
 8/15/08

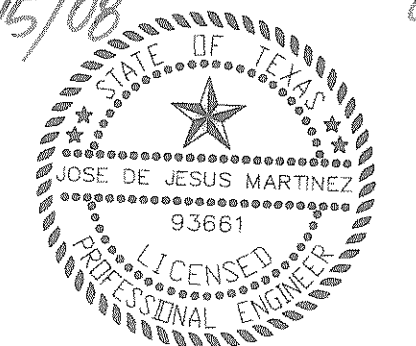

FOR THIS AREA  
 SEE HARBOR HILTON  
 PLAN SHT. 3/5

REVISION DESCRIPTION		DATE		SCALES		DESIGN		DRAWN		SHEET NO.			
0186284		12/21/08		1" = 60'		H.L.E.				11			
SOLID STRUCTURAL SOLUTIONS, INC. P.O. BOX 051880 MESQUITE, TX 75185-1880 PHONE: 972.415.0200 FAX: 972.288.5714										GRADING AND PAVING PLAN KEY MAP THE HARBOR - ROCKWALL CITY OF ROCKWALL		26	
										JOB NO.		0196	