



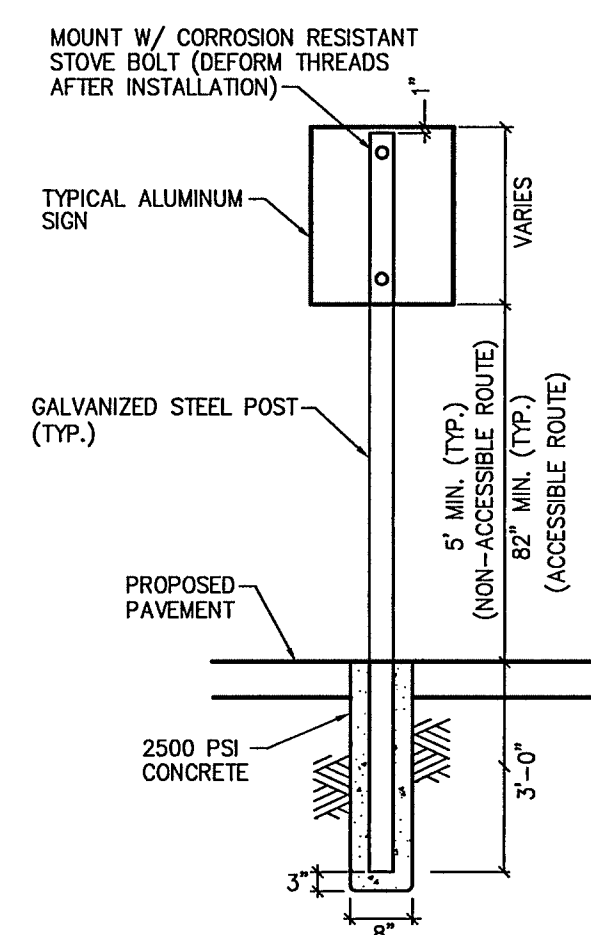

TYPICAL SIGNAGE MOUNTING DETAIL

N.T.S.

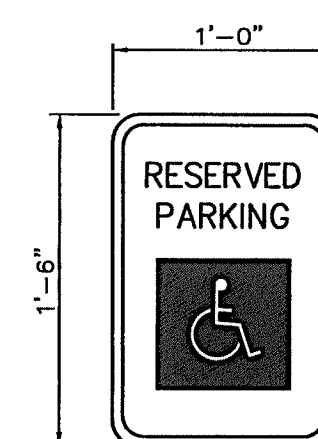

COLORS:
LETTERS AND BORDER — GREEN
SYMBOL ON BLUE BACKGROUND
SIGN BACKGROUND — WHITE


NOTES:

1. SPACING BETWEEN LETTERS, COLORS, AND PROCESSES SHALL CONFORM STANDARD HIGHWAY AND SIGN DESIGNS FOR TEXAS.
2. INSTALL WHERE INDICATED ON PLANS.
3. VAN-ACCESSIBLE SIGNAGE ON VAN SPACES ONLY.

TYPICAL SIGNAGE DETAIL

TYPE I

NTS

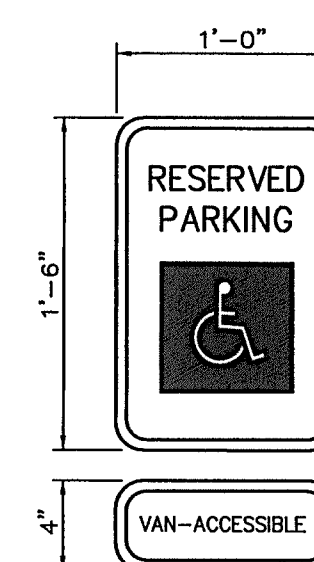

COLORS:
LETTERS AND BORDER – GREEN
SYMBOL ON BLUE BACKGROUND
SIGN BACKGROUND – WHITE


NOTES:

1. SPACING BETWEEN LETTERS, COLORS, AND PROCESSES SHALL CONFORM STANDARD HIGHWAY AND SIGN DESIGNS FOR TEXAS.
2. INSTALL WHERE INDICATED ON PLANS.
3. VAN-ACCESSIBLE SIGNAGE ON VAN SPACES ONLY.

TYPICAL SIGNAGE DETAIL


TYPE II

NTS

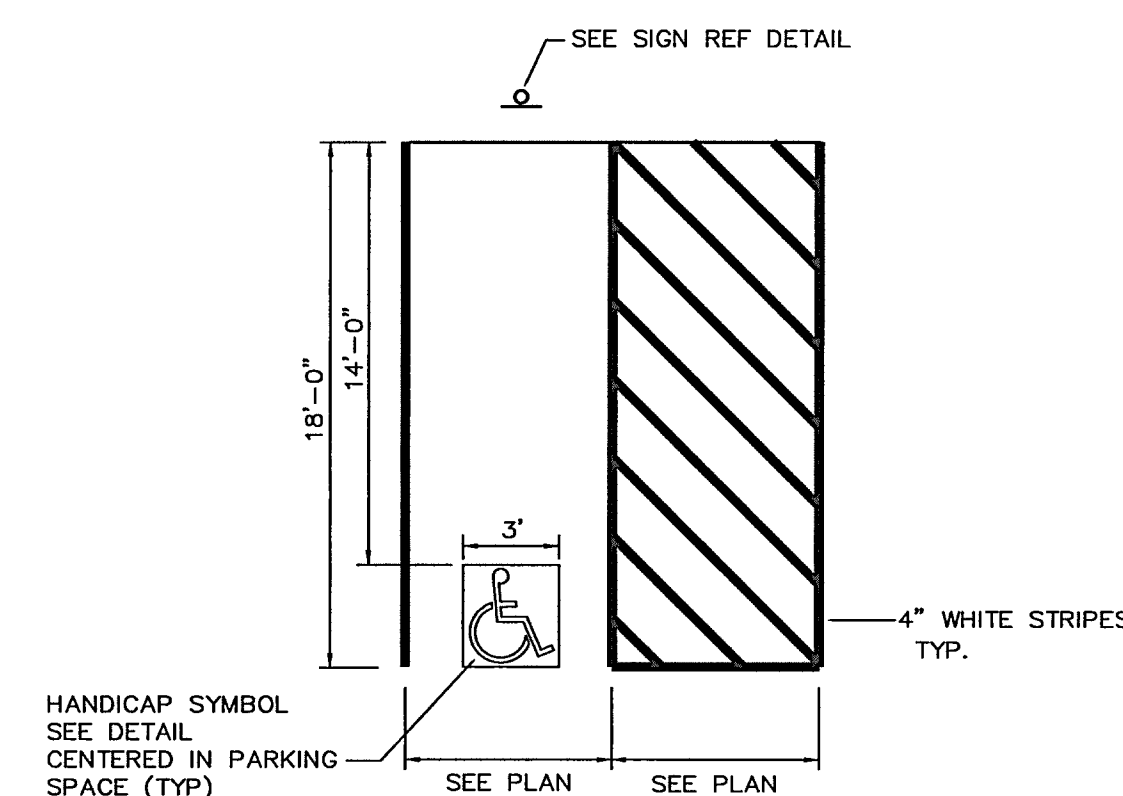


HANDICAP STRIPING DETAIL

N.T.S.

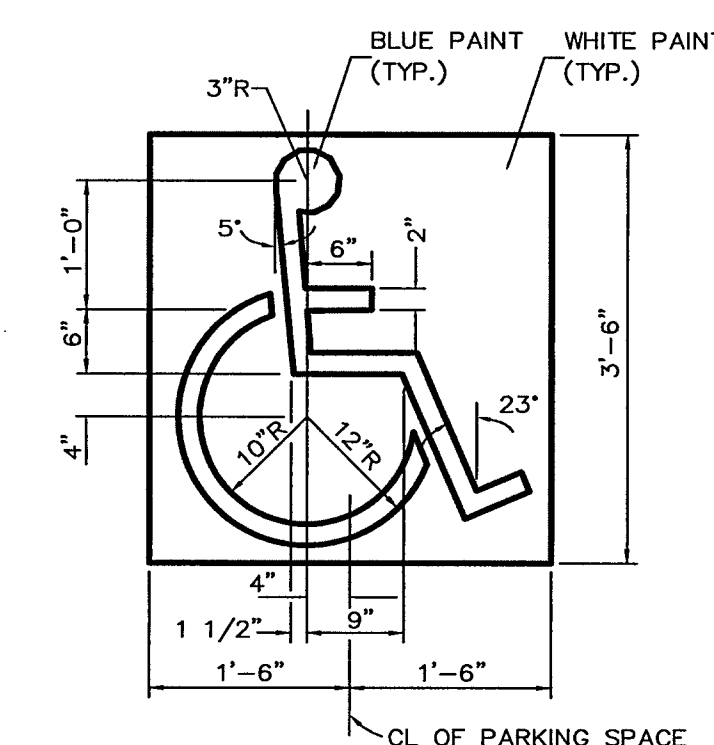


HANDICAP SYMBOL DETAIL

NTS

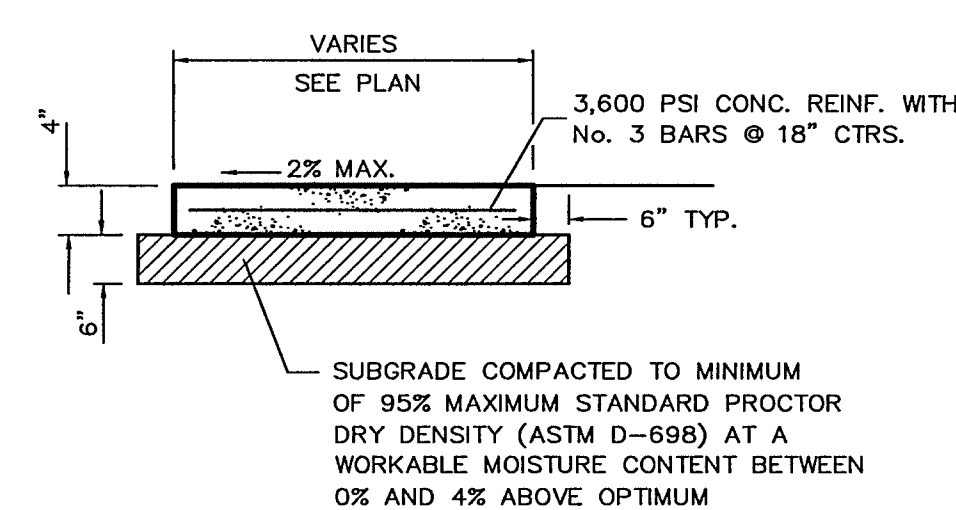

SITE SIDEWALK DETAIL

NTS

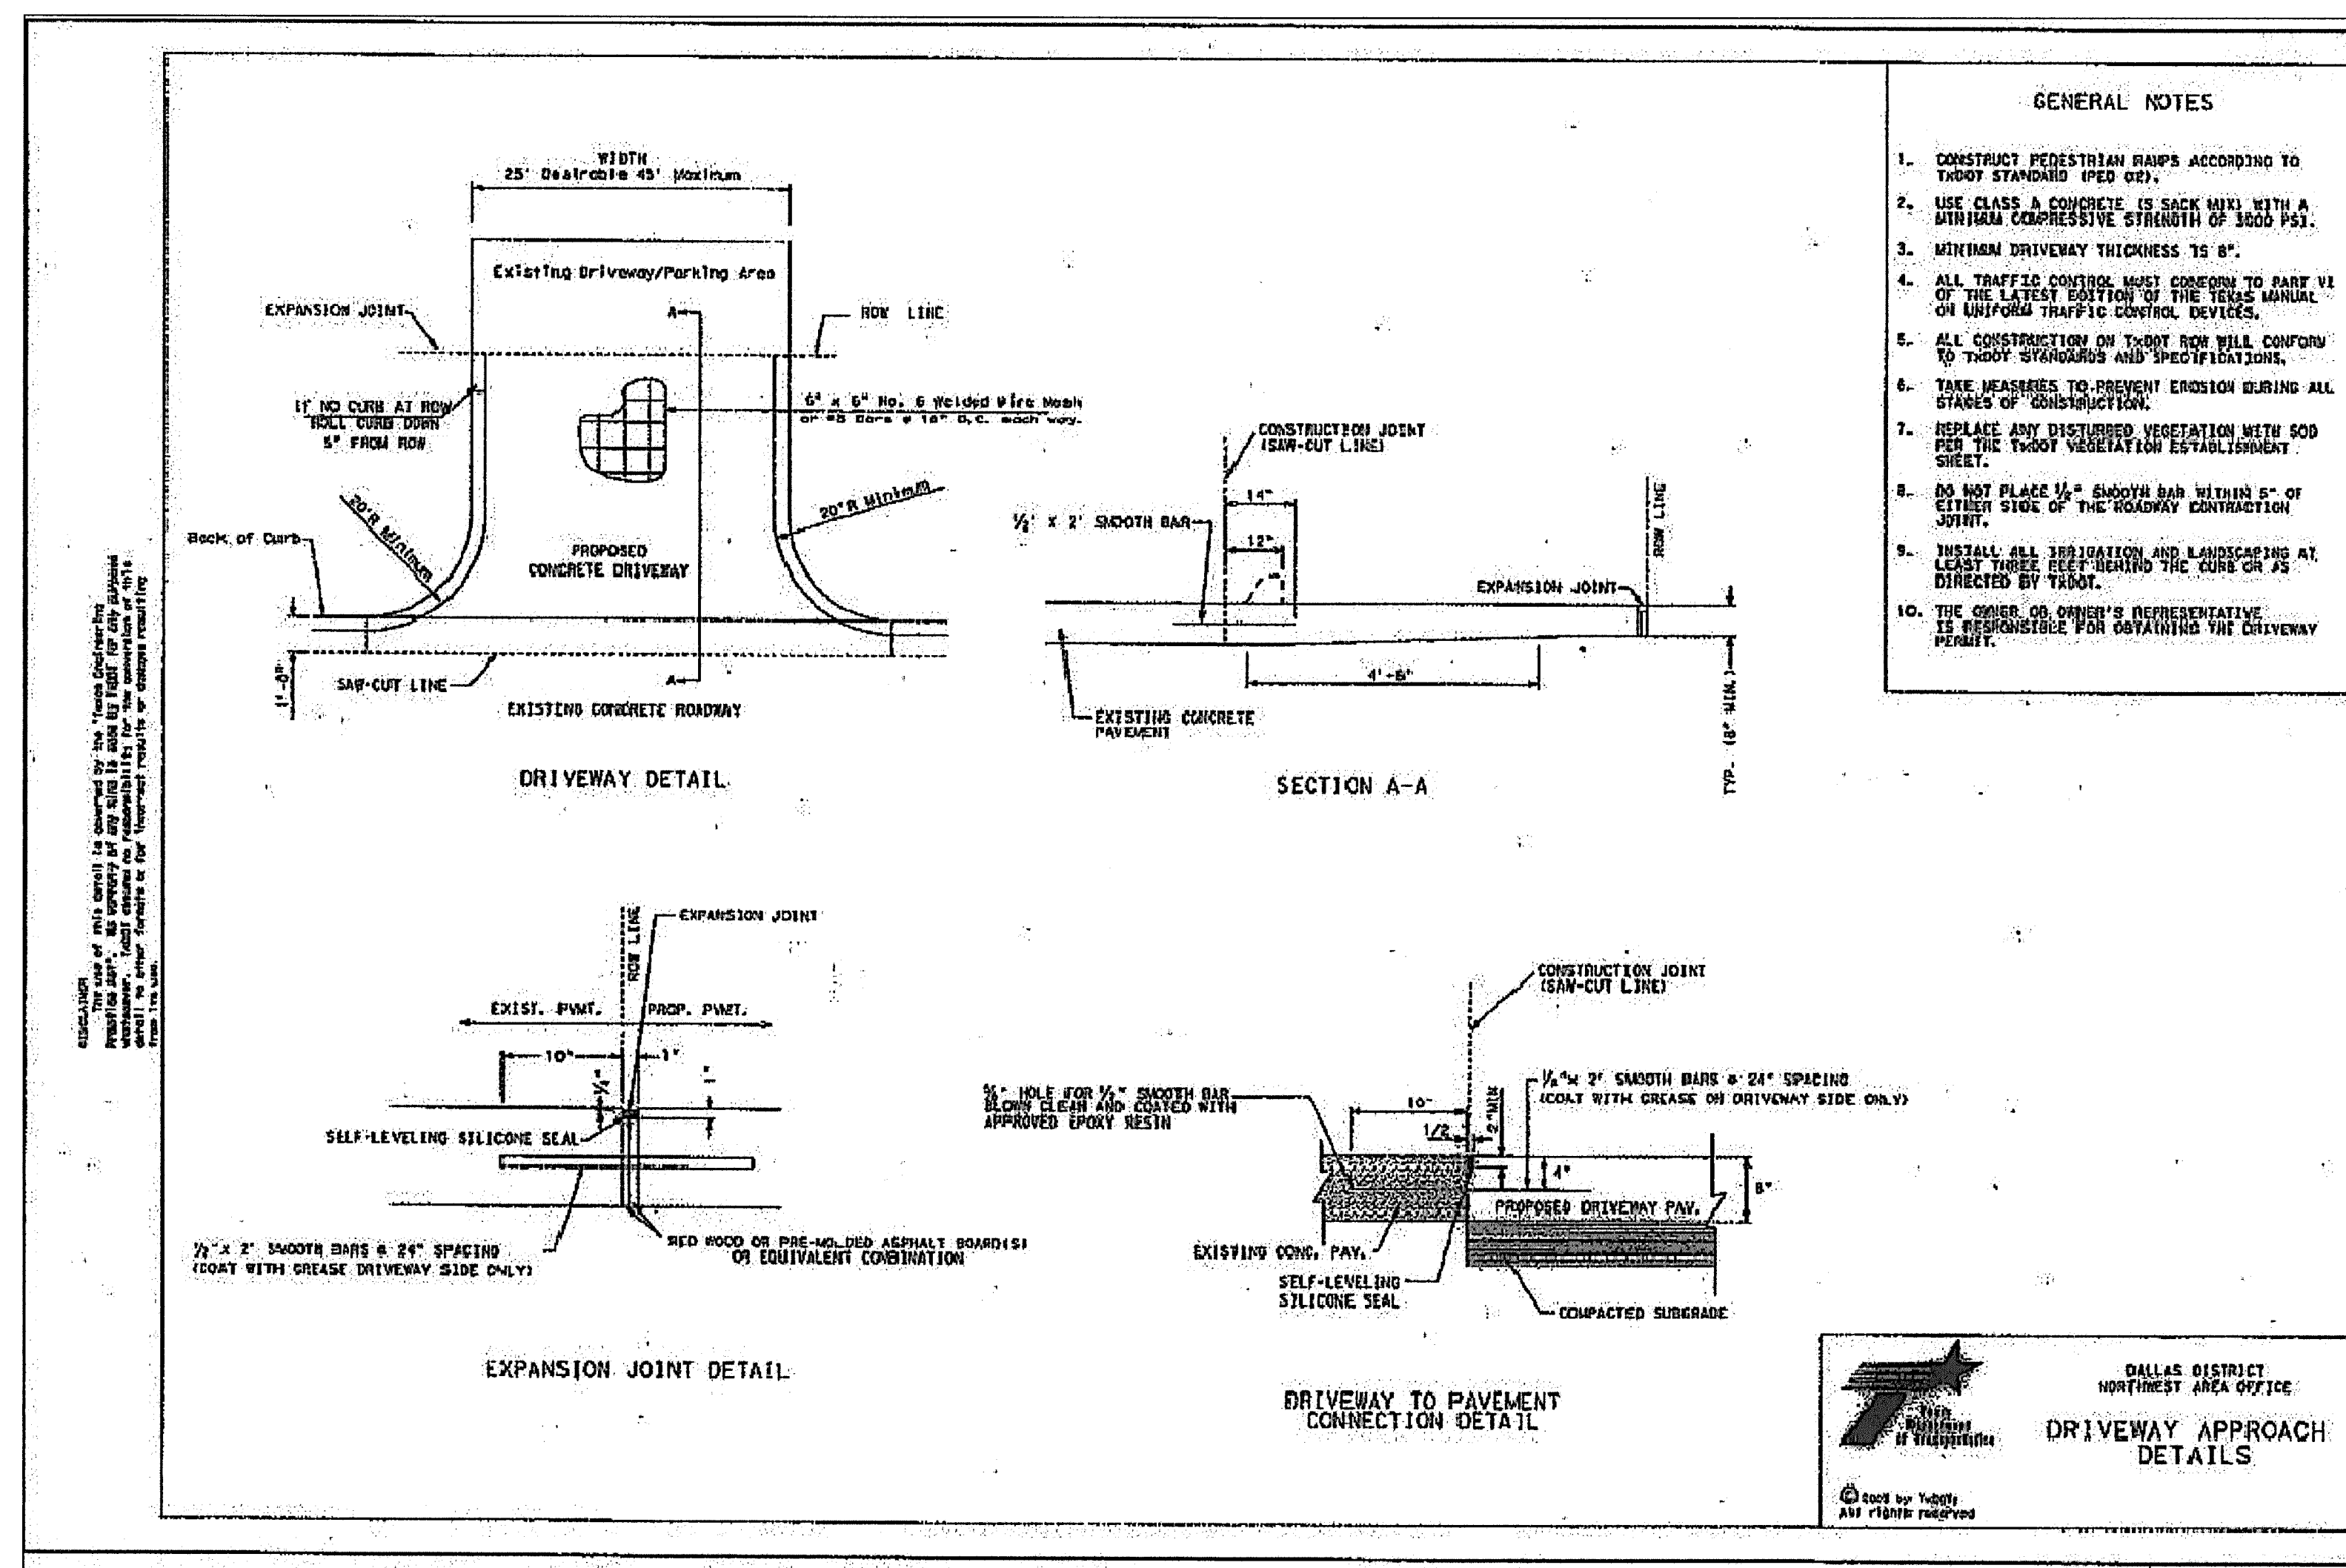

GENERAL NOTES

1. CONSTRUCT PEDESTRIAN RAMPS ACCORDING TO TxDOT STANDARD (FD 601).
2. USE CLASS A CONCRETE (IS SACK MIX) WITH A MINIMUM COMPRESSIVE STRENGTH OF 3000 PSI.
3. MINIMUM DRIVEWAY THICKNESS IS 6".
4. ALL TRAFFIC CONTROL MUST CONFORM TO PART 6 OF THE LATEST EDITION OF THE TEXAS MANUAL ON UNIFORM TRAFFIC CONTROL DEVICES.
5. ALL CONSTRUCTION ON TxDOT ROW WILL CONFORM TO TxDOT STANDARD SPECIFICATIONS FOR CONSTRUCTION.
6. TAKE MEASURES TO PREVENT EROSION DURING ALL STAGES OF CONSTRUCTION.
7. REPLACE ANY DISTURBED VEGETATION WITH SOO PER THE TxDOT VEGETATION RESTORATION SHEET.
8. DO NOT PLACE A 6" SMOOTH RAMP WITHIN 6' OF THE SIDE OF THE DRIVEWAY CONTRACTION JOINT.
9. INSTALL ALL EROSION CONTROL AND LANDSCAPING AS NOTED ON THESE REE! BEHIND THE CURB OR AS DIRECTED BY THE ENGINEER.
10. THE OWNER OR OWNER'S REPRESENTATIVE IS RESPONSIBLE FOR OBTAINING THE DRIVEWAY

RECORD DRAWINGS

NOTE:
To the best of our knowledge Spiars Engineering, Inc. hereby states that this plan is a Record Drawing. The information provided is based on field surveying at the site and information provided by the contractor.

Note:
All materials and construction shall conform to the City of
Rockwall Standard Construction Details and Specifications
and NCTCOG 3rd Edition.



CKWALL, TEX. SITE DETAILS

SITE DETAILS

Revisions	Date
1	
2	
3	
4	
5	
6	
7	
8	
9	

Issue Dates:

Scale: N.T.S.

Drawn By: AO

Checked by: KSW

Sheet
C of 12

SEI No. 11-112
11-112-Det