


CURVE TABLE

CURVE	RADIUS	DELTA	TANGENT	LENGTH	CHORD	BEARING
C-1	45.00'	90°00'00"	45.00'	70.68'	63.64'	N 46°00'39" W
C-2	45.00'	90°00'00"	45.00'	70.68'	63.64'	S 46°00'39" E
C-3	405.00'	21°22'28"	75.82'	149.91'	149.06'	N 76°46'52" E
C-4	250.00'	22°48'43"	50.44'	99.53'	98.89'	N 77°34'59" E
C-5	250.00'	05°52'10"	12.82'	25.61'	25.60'	N 01°55'26" E
C-6	405.00'	04°35'06"	16.21'	32.41'	32.40'	S 01°16'54" W


STA. 2+51.99 (20.50' LT.)
LOFLAND FARMS DRIVE =
STA. 19+04.93 LINE "5"
CONST. 1-5' MODIFIED TYPE "Y"
INLET (TOP ONLY) OVER 5' STD.
THROAT 595.86
FL 592.08

Winkelmann & Associates, Inc.
CONSULTING CIVIL ENGINEERS • SURVEYORS
621 WEST COLLEGE STREET
GRAPEVINE, TEXAS 76035
(972) 482-7900
(972) 482-7999 FAX
www.winkelmann.com

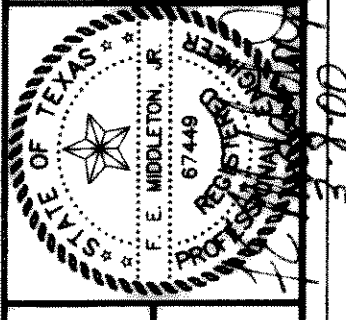

W.H. BAIRD SURVEY, ABSTRACT NO. 25
CITY OF ROCKWALL
ROCKWALL COUNTY, TEXAS
CONTINENTAL HOMES
621 WEST COLLEGE STREET
GRAPEVINE, TEXAS 76031

- LEGEND
- HWL Headwall
 - FL Flow Line
 - TC Top of Curb
 - P.T. Point of Tangent
 - P.C. Point of Curve
 - Street Station
 - Storm Station
 - Prop. Contour
 - Exist. Contour

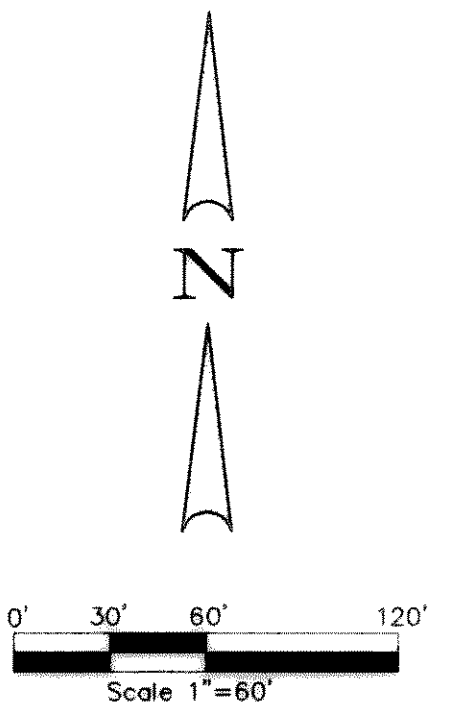

DESIGNED BY: MK/DA
DRAWN BY: DA
CHECKED BY: FEM
FILE: 3200STI.DWG
VIEW:
PROJECT NO.: 32001.01
DATE: 10-2-00

BENCHMARK: ELEV. = 600.69
CITY OF ROCKWALL R-19
BRASS MONUMENT AT THE N/W CORNER OF
SILVERVIEW & DIAMOND WAY. 500' ± SOUTH OF
S.H. 276.
BENCHMARK: ELEV. = 583.56
R.R. SPIKE SET IN THE CENTERLINE OF S.H. 276
3600± WEST OF F.M. 549

SHEET
15
OF
32