

MATCHLINE STA. 15+00

THESE CONSTRUCTION PLANS WERE PREPARED UNDER THE RESPONSIBLE SUPERVISION OF F.E. MIDDLETON, JR., REGISTERED PROFESSIONAL ENGINEER NO. 67449

THE SEAL APPEARING ON THIS DOCUMENT WAS AUTHORIZED BY F.E. MIDDLETON, JR., P.E. #67449


W.H. BARD SURVEY, ABSTRACT NO. 25
CITY OF ROCKWALL,
ROCKWALL COUNTY, TEXAS
CONTINENTAL HOMES
621 WEST COLLEGE STREET
GRAPEVINE, TEXAS 76051

PAVING PROFILE
ALLEY '4' & ALLEY '6'
LOFLAND FARMS, PHASE 2

Scale: 1" = 1'-0"
Date: 02/14/01
Designed By: RB
Drawn By: DA
Checked By: FEM
File: 3200\A2.DWG View:
Project No.: 3200\01

SHEET
10
OF
20

DATE: 12-10-01
WINKELMANN & ASSOCIATES, INC.

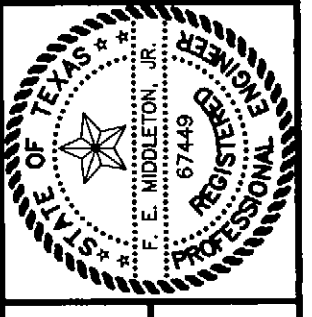

Winkelmann & Associates, Inc.
CONSULTING CIVIL ENGINEERS • SURVEYORS
2505 Hillcrest Drive, Suite 100
Dallas, Texas 75229
(972) 292-2797 FAX
www.winkelmann.com

NO.	DATE	REVISION	APPROV.