


DRIVEWAY
DETAILS
Not To Scale

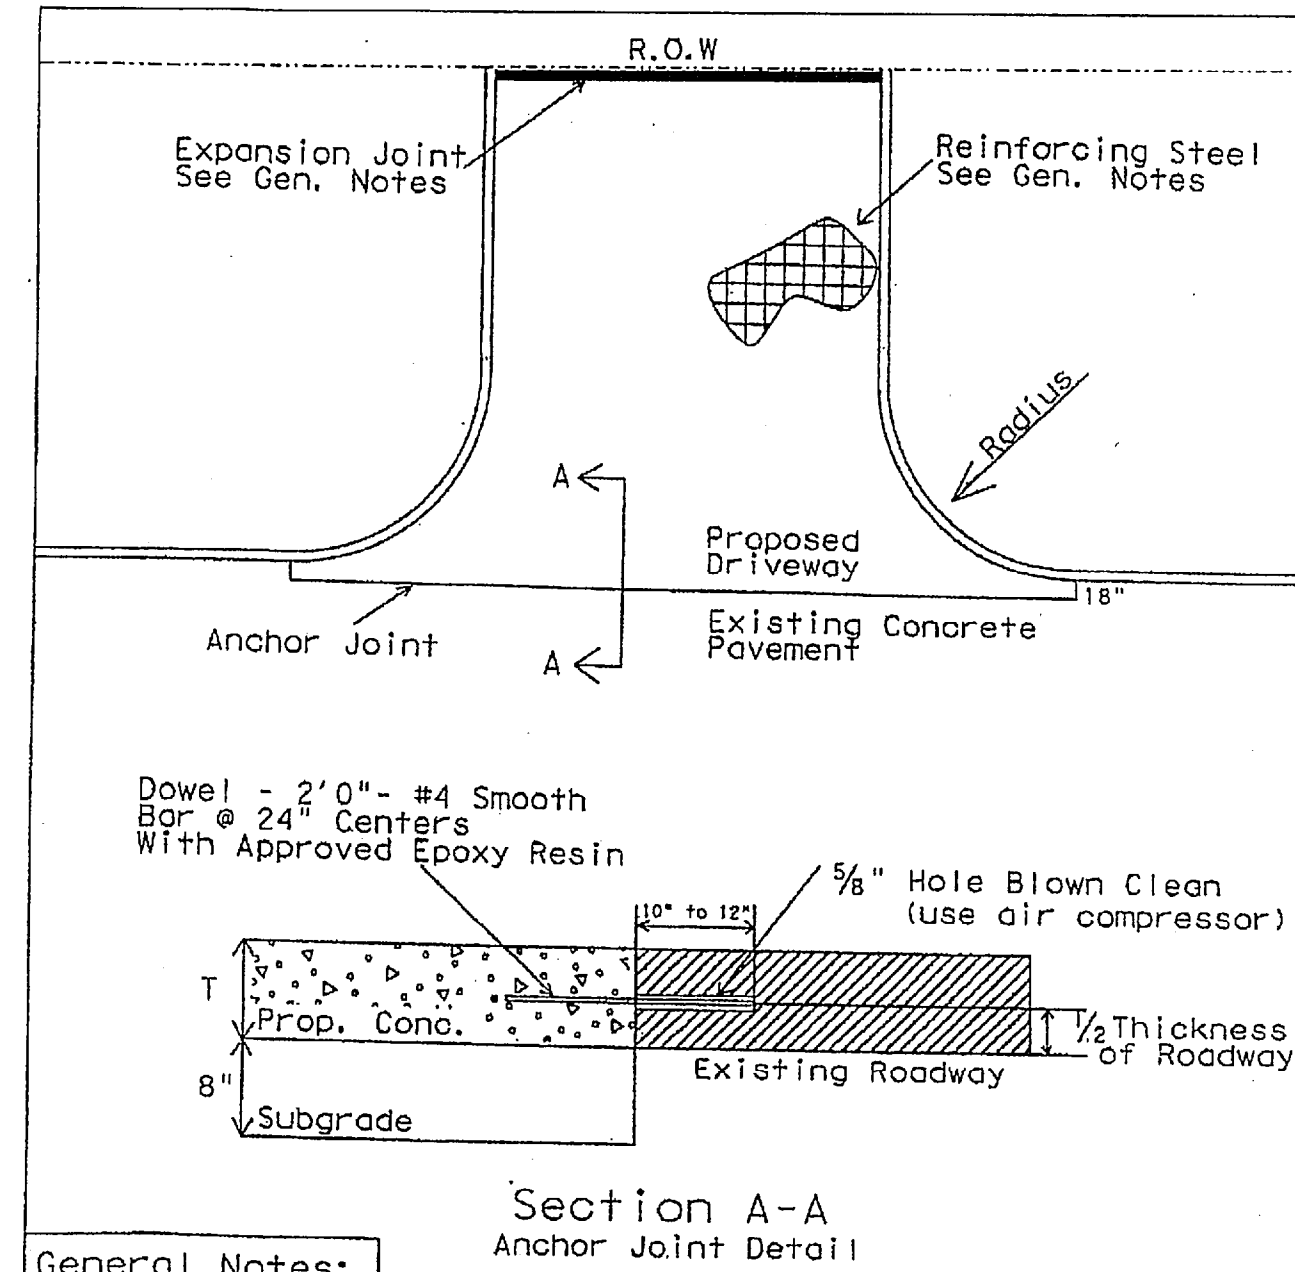

Section A-A
Anchor Joint Detail

General Notes:

1. Conc. Thickness (T) - Residential-6" Commercial-8" and Industrial-9"
2. Use concrete CLASS A (Item 421.4, 2004 SSB)
3. Steel Reinforcement Residential and Commercial-#4@18" Industrial-#4@12" or #5@18"
4. Radius (R) as Appr. by the Engineer
5. Redwood Expansion Joint @ ROW line
6. Subgrade to TxDOT Standards and Engineer Approval
7. Conform to TxDOT 2004 Standard Spec. Book Items 421, 530, 531, and 536

Texas Department of Transportation
© 2005

Standard Detail
Concrete Driveways

| DESIGN | DATE | STATE | PROJECT NO. | SCALE |
|--------|-------|-------|-------------|--------|
| EB | 12/03 | TEXAS | DALLAS | DALLAS |
| DR | | | | |
| CH | | | | |
| TRK | | | | |


FOR ADDITIONAL DETAILS REFER TO NCTCOG STANDARD DRAWINGS OF THE STANDARD SPECIFICATIONS FOR PUBLIC WORKS CONSTRUCTION THIRD EDITION AND THE CITY OF ROCKWALL SPECIAL PROVISIONS (AVAILABLE FROM THE CITY'S WEBSITE)

DRIVEWAY
DETAIL

CITY OF ROCKWALL
"THE NEW HORIZON"

Replaces NCTCOG Std. Drawing No. 2150A and 2150B

DATE: AUG. '03
DRAWING NAME: DRIVEWAY

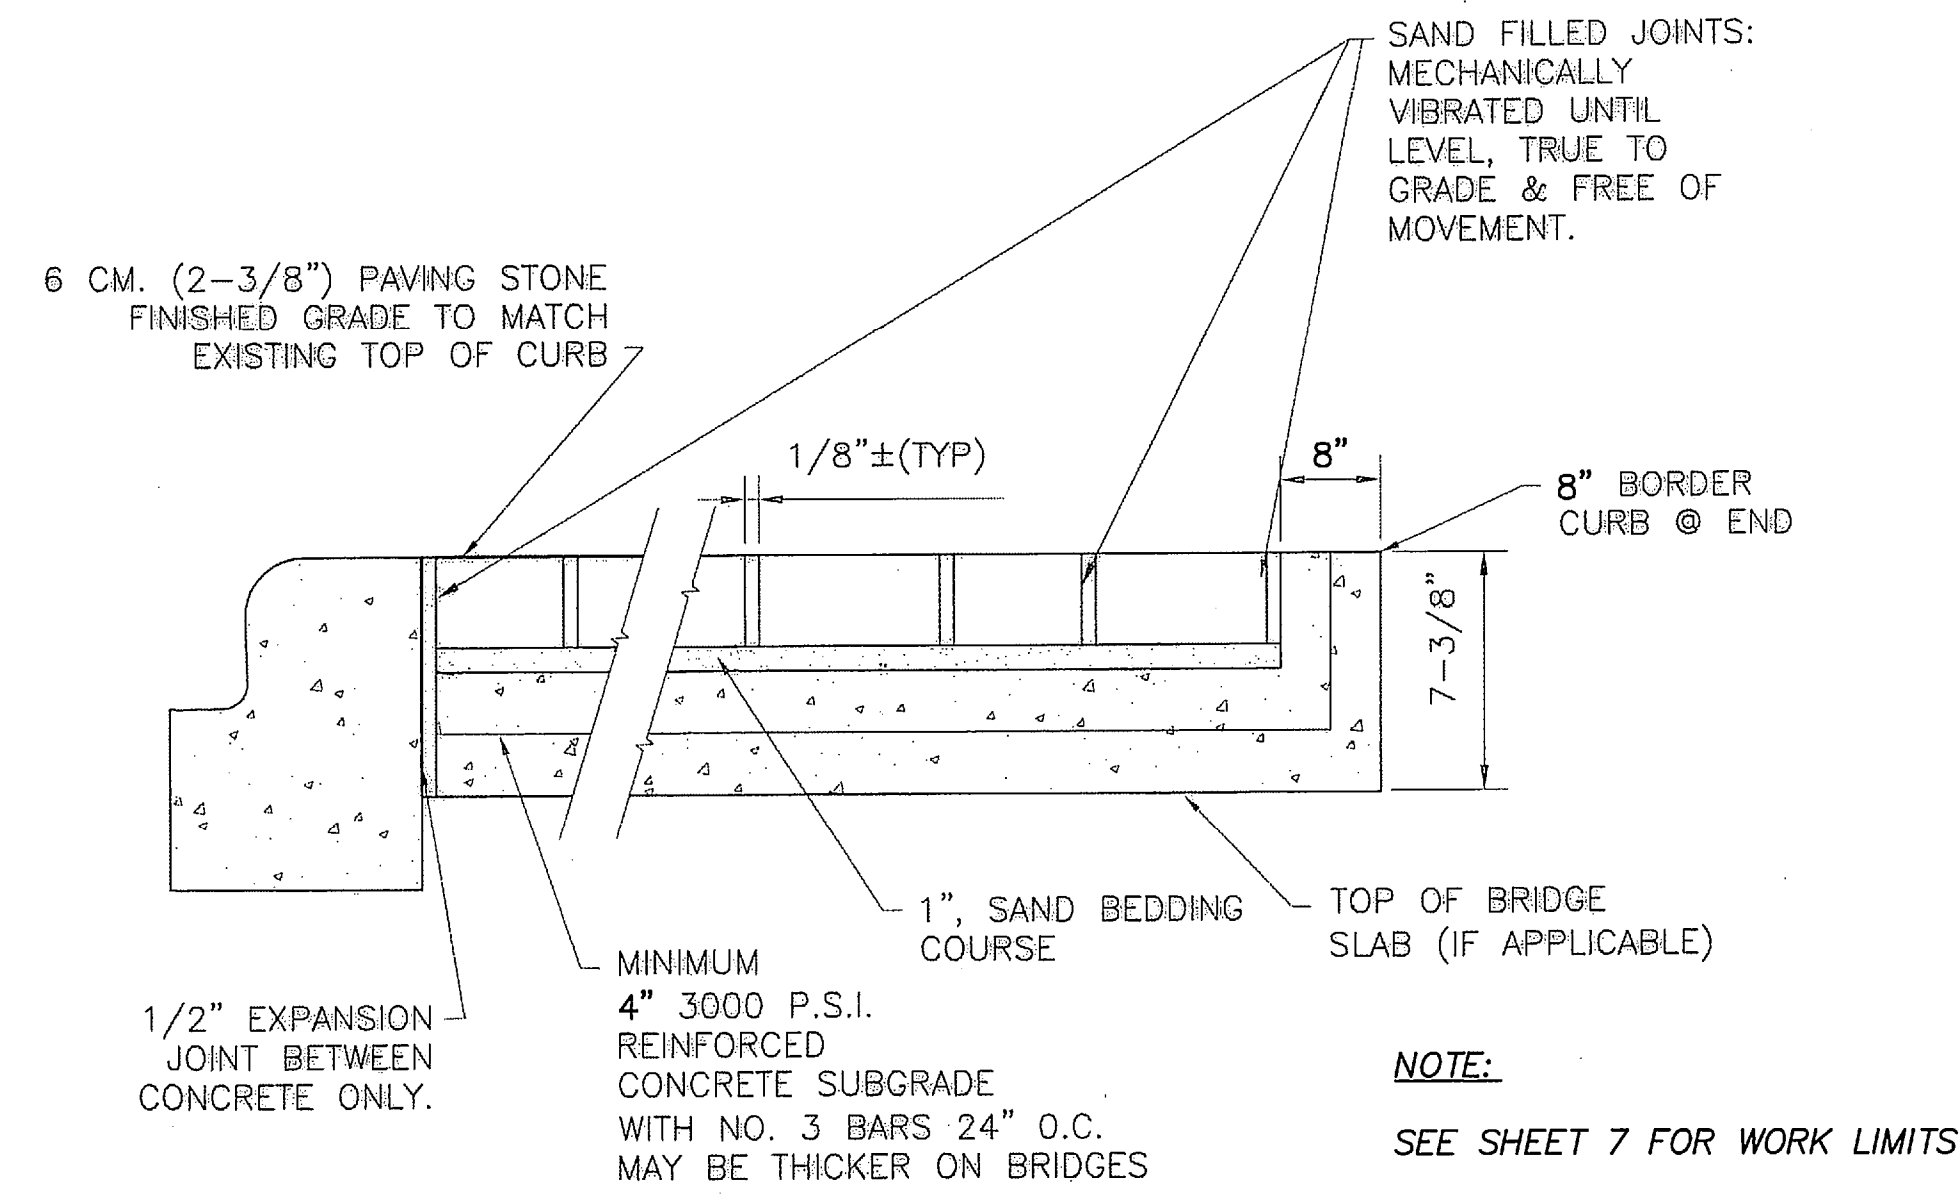

SIDEWALK PAVER DETAIL
NOT TO SCALE

OAC SENIOR LIVING, LLC.
ROCKWALL BY-PASS ADDITION
DETAILS
PAVING DETAILS

PROJECT TITLE:
OAC SENIOR LIVING, LLC.
ROCKWALL BY-PASS ADDN.

m|ma
mycoskie+mcinnis+associates
civil engineering surveying landscape architecture planning
type registration number: 1 - 2759
200 east abram
arlington, texas 76010
817-489-1671
fax: 817-274-8757
www.mmotexas.com

RECORD DRAWINGS

PROJECT NUMBER: 2651-00-01
PROJECT MANAGER: J. SUMPTER
DRAWN BY: S. BELL
CHECKED BY: A. CASCO
ISSUE DATE: 04/30/2013

TO THE BEST OF OUR KNOWLEDGE MYCOSKIE MCINNIS ASSOCIATES, INC. HEREBY STATES THAT THIS PLAN IS AS-BUILT. THIS IS BASED ON SURVEY DATA, VISUAL POST-CONSTRUCTION FIELD OBSERVATIONS AND INFORMATION PROVIDED BY THE CONTRACTOR.

02.12.15 RECORD DRAWINGS AEC

REV. DATE DESCRIP. BY

SHEET CONTENT:
PAVING
DETAILS