


DRAINAGE DATA										
AREA	ACRES	C _c	C	I _s	Q _s	Q _s ACCUM	I ₂₅	Q ₂₅	Q ₂₅ ACCUM	
1	3.61	10	0.70	62	15.67	—	83	20.97	—	
2	0.44	10	0.70	62	1.91	17.58	83	2.56	23.53	
3	1.24	10	0.70	62	5.38	—	83	7.21	—	
4	0.33	10	0.70	62	1.43	6.81	83	1.92	9.13	
5	0.23	10	0.70	620	1.00	7.81	830	1.34	10.47	
6	0.41	10	0.70	620	1.78	9.59	830	2.38	12.85	
7	8.71	10	0.70	620	37.80	47.39	830	50.60	63.45	

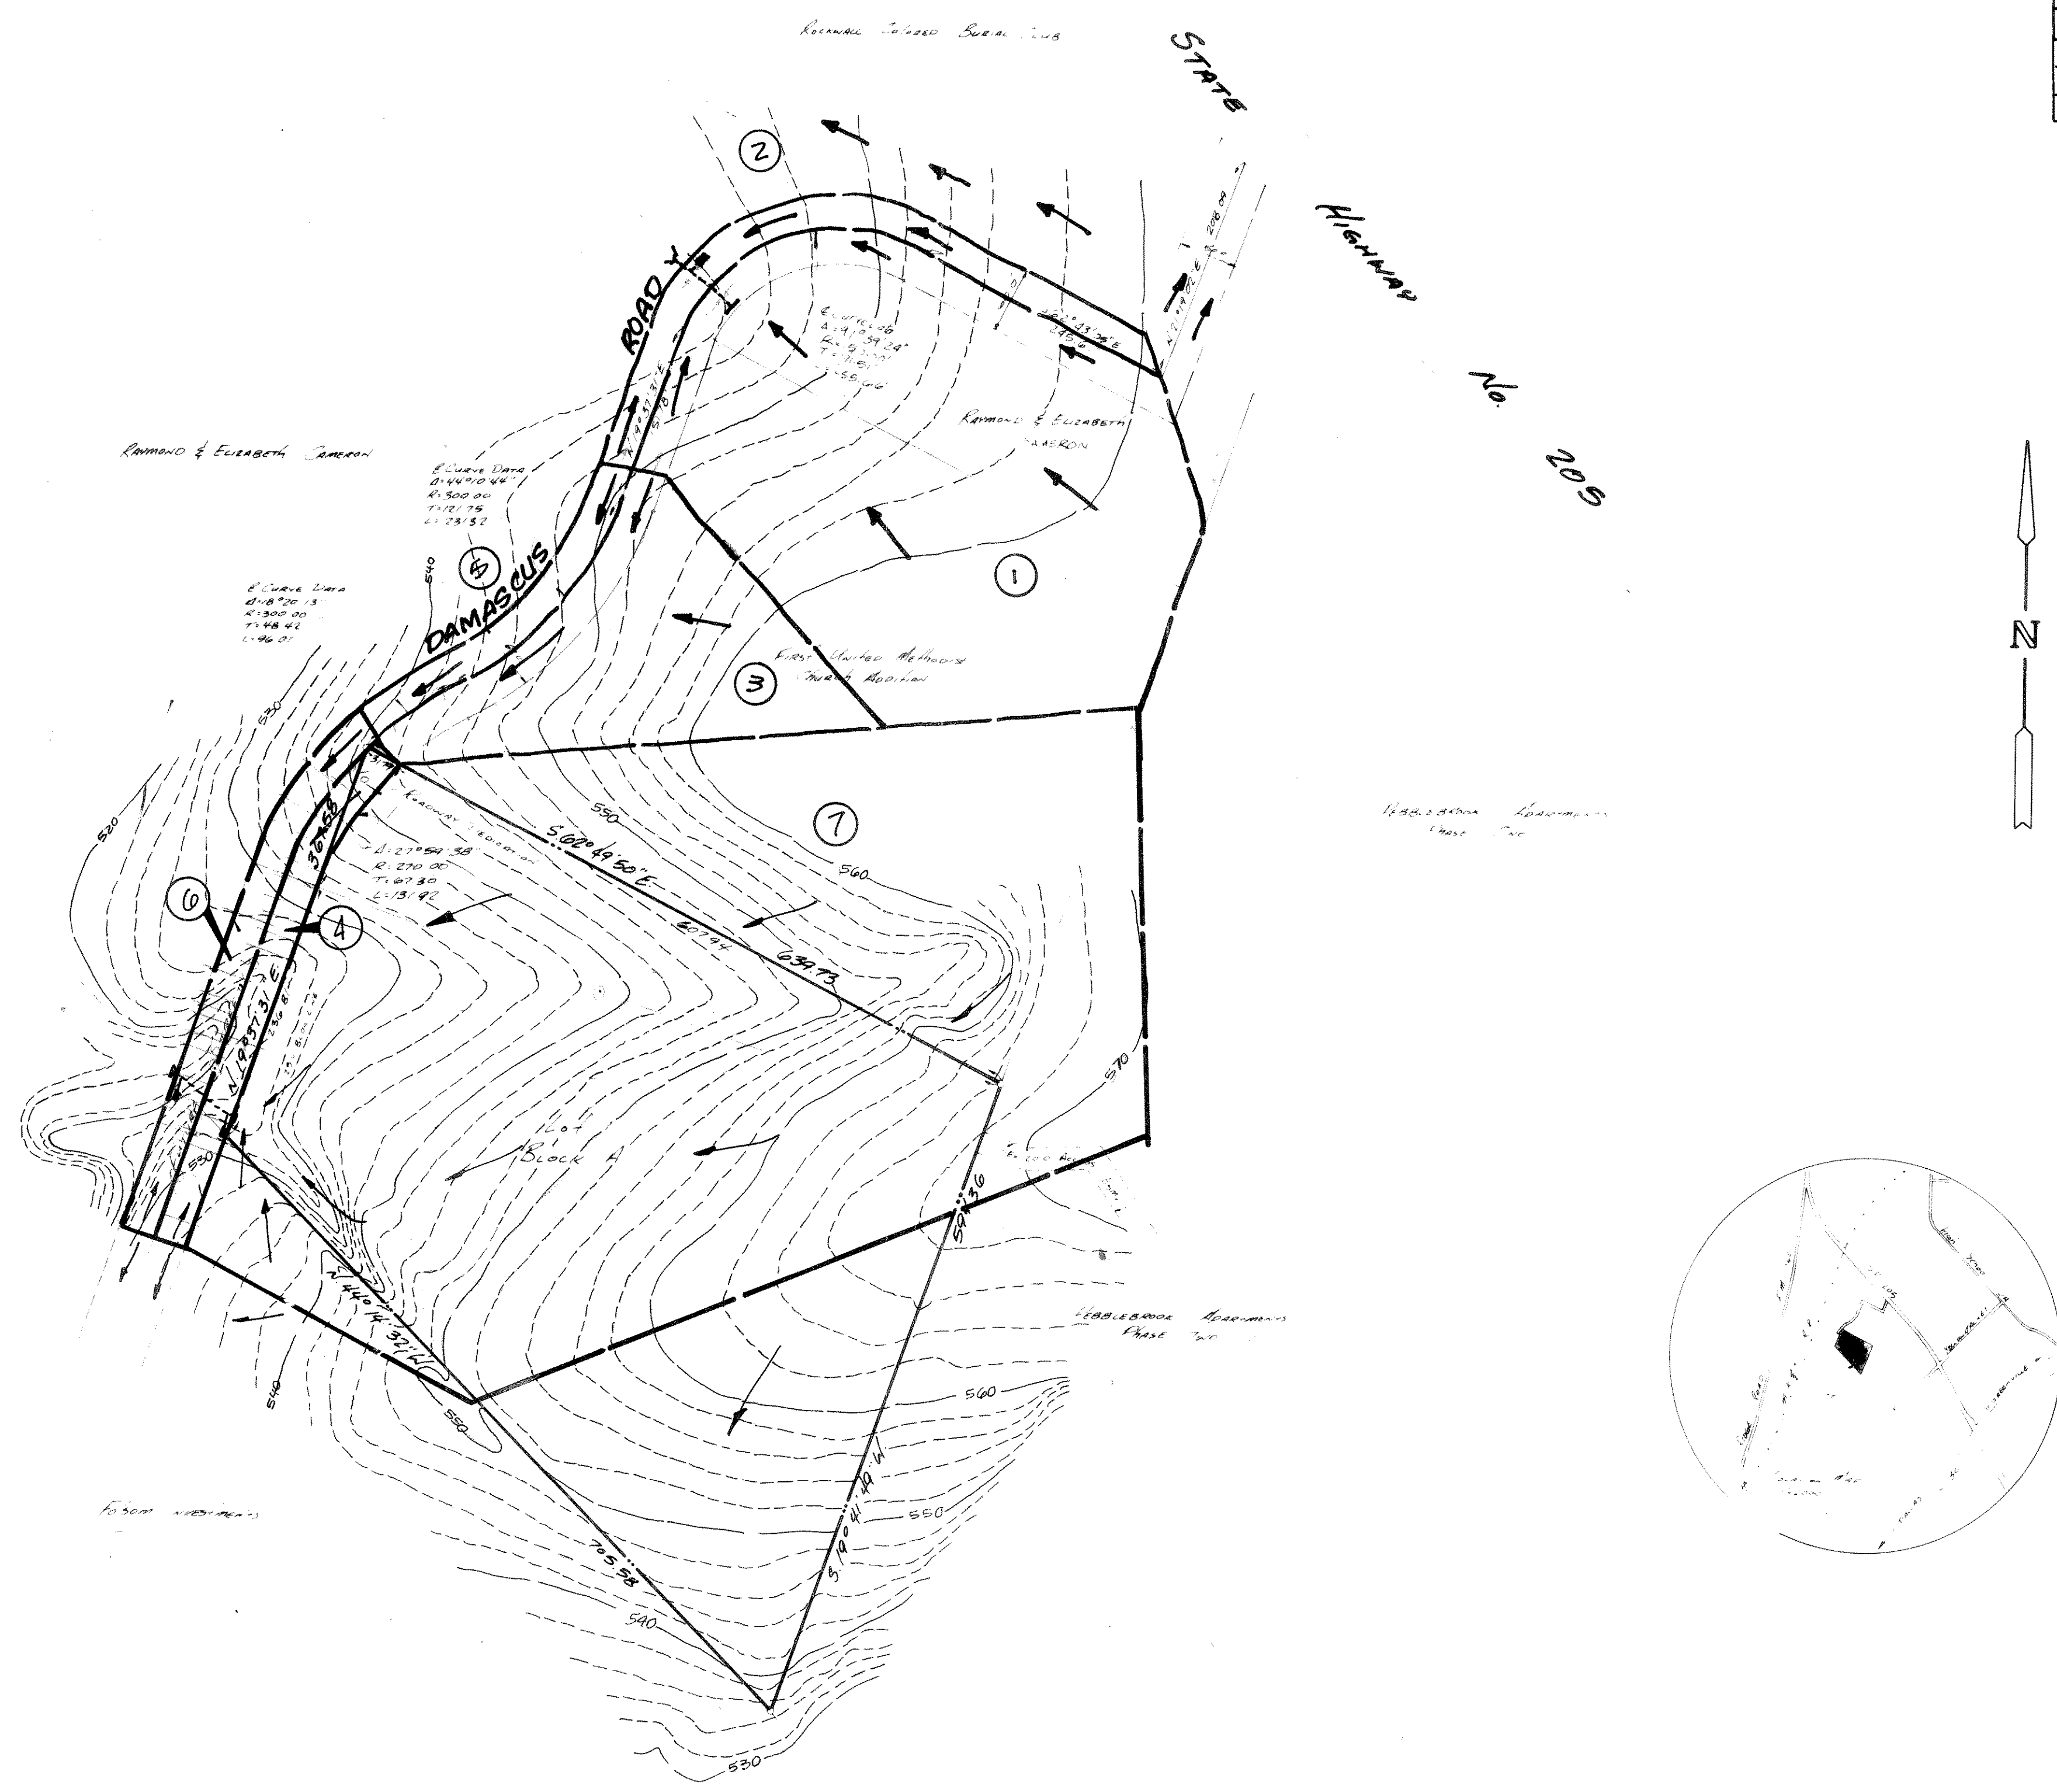

AS BUILT 5
6

HAROLD L. EVANS CONSULTING ENGINEER 2331 GUS THOMASSON RD. SUITE 102 DALLAS, TEXAS 75228 PHONE (214) 328-8133			DRAINAGE AREA MAP OUR LADY OF THE LAKE CATHOLIC CHURCH CITY OF ROCKWALL ROCKWALL COUNTY, TEXAS		
SCALE	DATE	JOB NO.			
1"=100'	11-7-84	83276			