



VICINITY MAP  
N.T.S.

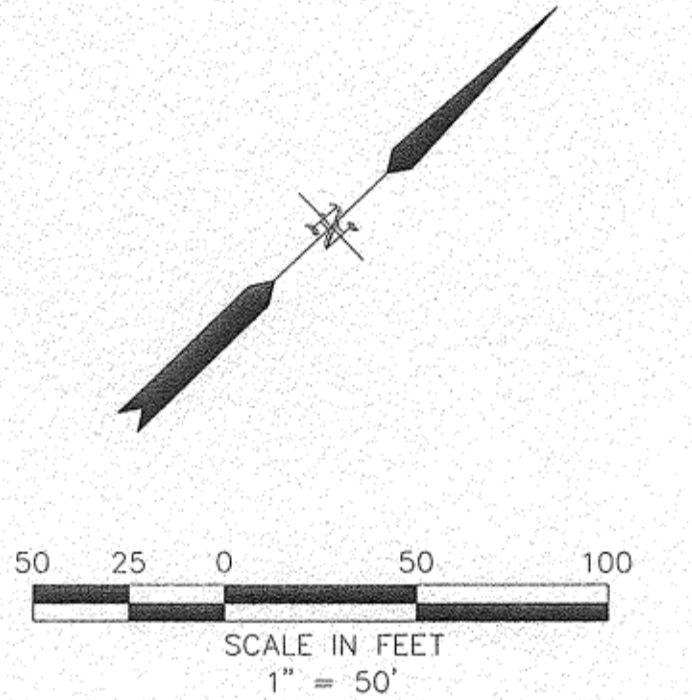

LEGEND:

- SILT FENCE
- STONE SILTATION STRUCTURE
- CONSTRUCTION ENTRANCE
- INLET PROTECTION


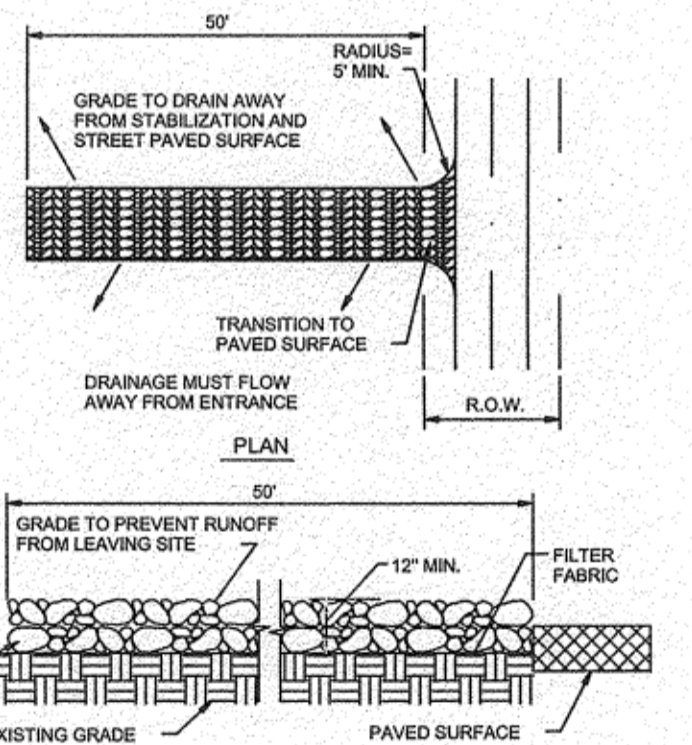


PROFILE  
STABILIZED CONSTRUCTION  
ENTRANCE / EXIT  
N.T.S.

NCTCOG 02270.G  
STORM WATER QUALITY  
BEST MANAGEMENT PRACTICES  
FOR CONSTRUCTION ACTIVITIES

RELEASED FOR CONSTRUCTION  
ALL RESPONSIBILITY FOR ADEQUACY OF DESIGN  
OF ROCKWALL IN REVIEWING AND RELEASING  
PLANS FOR CONSTRUCTION, ASSUMES NO  
RESPONSIBILITY FOR ADEQUACY OR ACCURACY  
OF DESIGN.

CITY \_\_\_\_\_ DATE \_\_\_\_\_

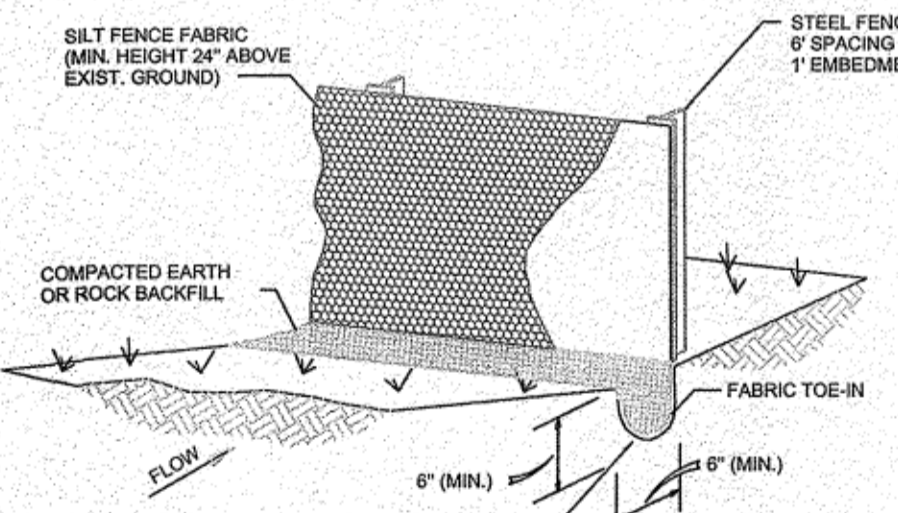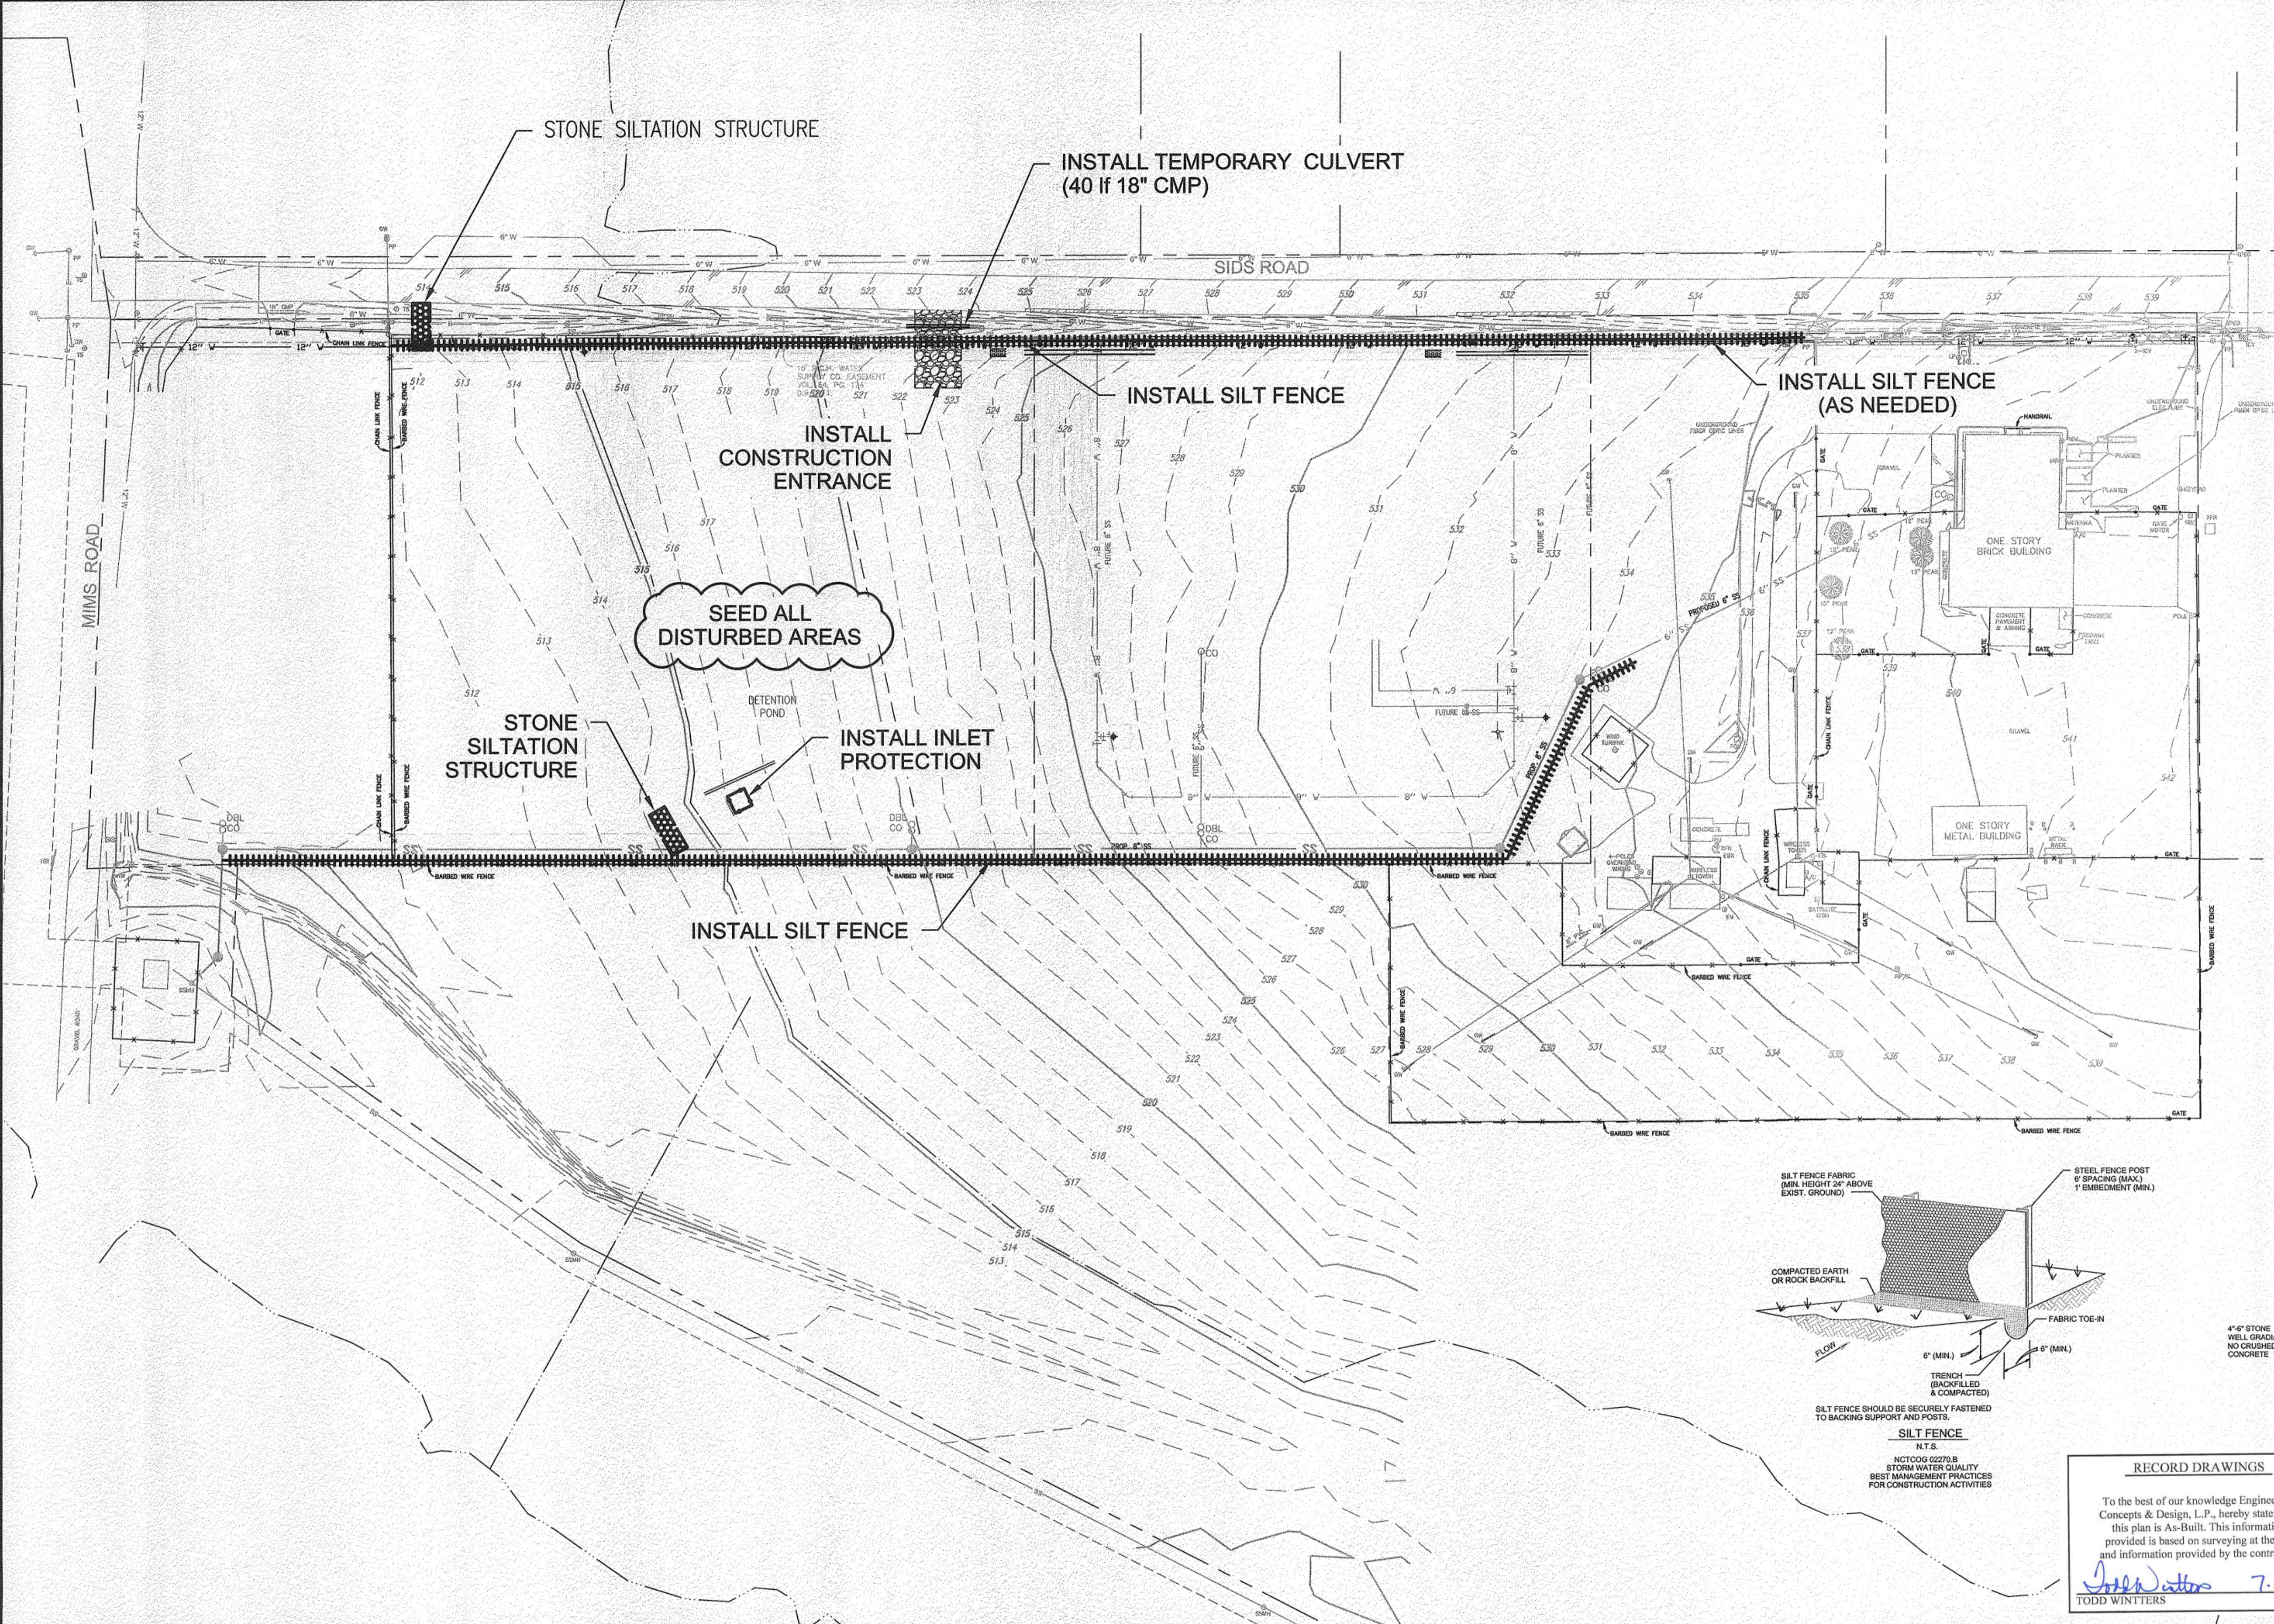

SILT FENCE  
N.T.S.  
NCTCOG 02270.B  
STORM WATER QUALITY  
BEST MANAGEMENT PRACTICES  
FOR CONSTRUCTION ACTIVITIES

RECORD DRAWINGS  
To the best of our knowledge Engineering  
Concepts & Design, L.P., hereby states that  
this plan is As-Built. This information  
provided is based on surveying at the site  
and information provided by the contractor.  
*Todd Winters* 7.14.14  
TODD WINTERS DATE

BENCHMARK:  
"X" CUT IN CURB 23± SOUTH OF EAST DRIVE APPROACH  
OF EXISTING RAYBURN COUNTRY ELECTRIC BUILDING.

**ENGINEERINGCONCEPTS**  
& DESIGN, L.P.  
ENGINEERING / PROJECT MANAGEMENT /  
CONSTRUCTION SERVICES - FIRM REG. #F-001145  
201 WINDCO CIR, STE 200, WYLIE, TX 75098  
972-941-8400 FAX: 972-941-8401 WWW.ECDLP.COM

REVISIONS:	
DRAWN: JIM	DATE: April 10, 2014
CHECKED: TW	DATE:
PROJECT NO.: 3551	
DWG FILE NAME:	

THIS DOCUMENT IS RELEASED FOR THE  
PURPOSE OF CONSTRUCTION.



**EROSION CONTROL PLAN & DETAILS**  
RCEC OFFICE BUILDING  
LOT 2, BLOCK 1, RAYBURN COUNTRY ADDITION  
CITY OF ROCKWALL, ROCKWALL COUNTY, TEXAS

SHEET  
6  
OF  
8