


IRRIGATION SLEEVING PLAN NOTES
CONTRACTOR SHALL VERIFY CONDUIT SIZES AND LOCATIONS SHOWN ON THIS SHEET WITH THE LANDSCAPE IRRIGATION PLANS, AND MEP DRAWINGS FOR ELECTRICAL AND TELEPHONE.

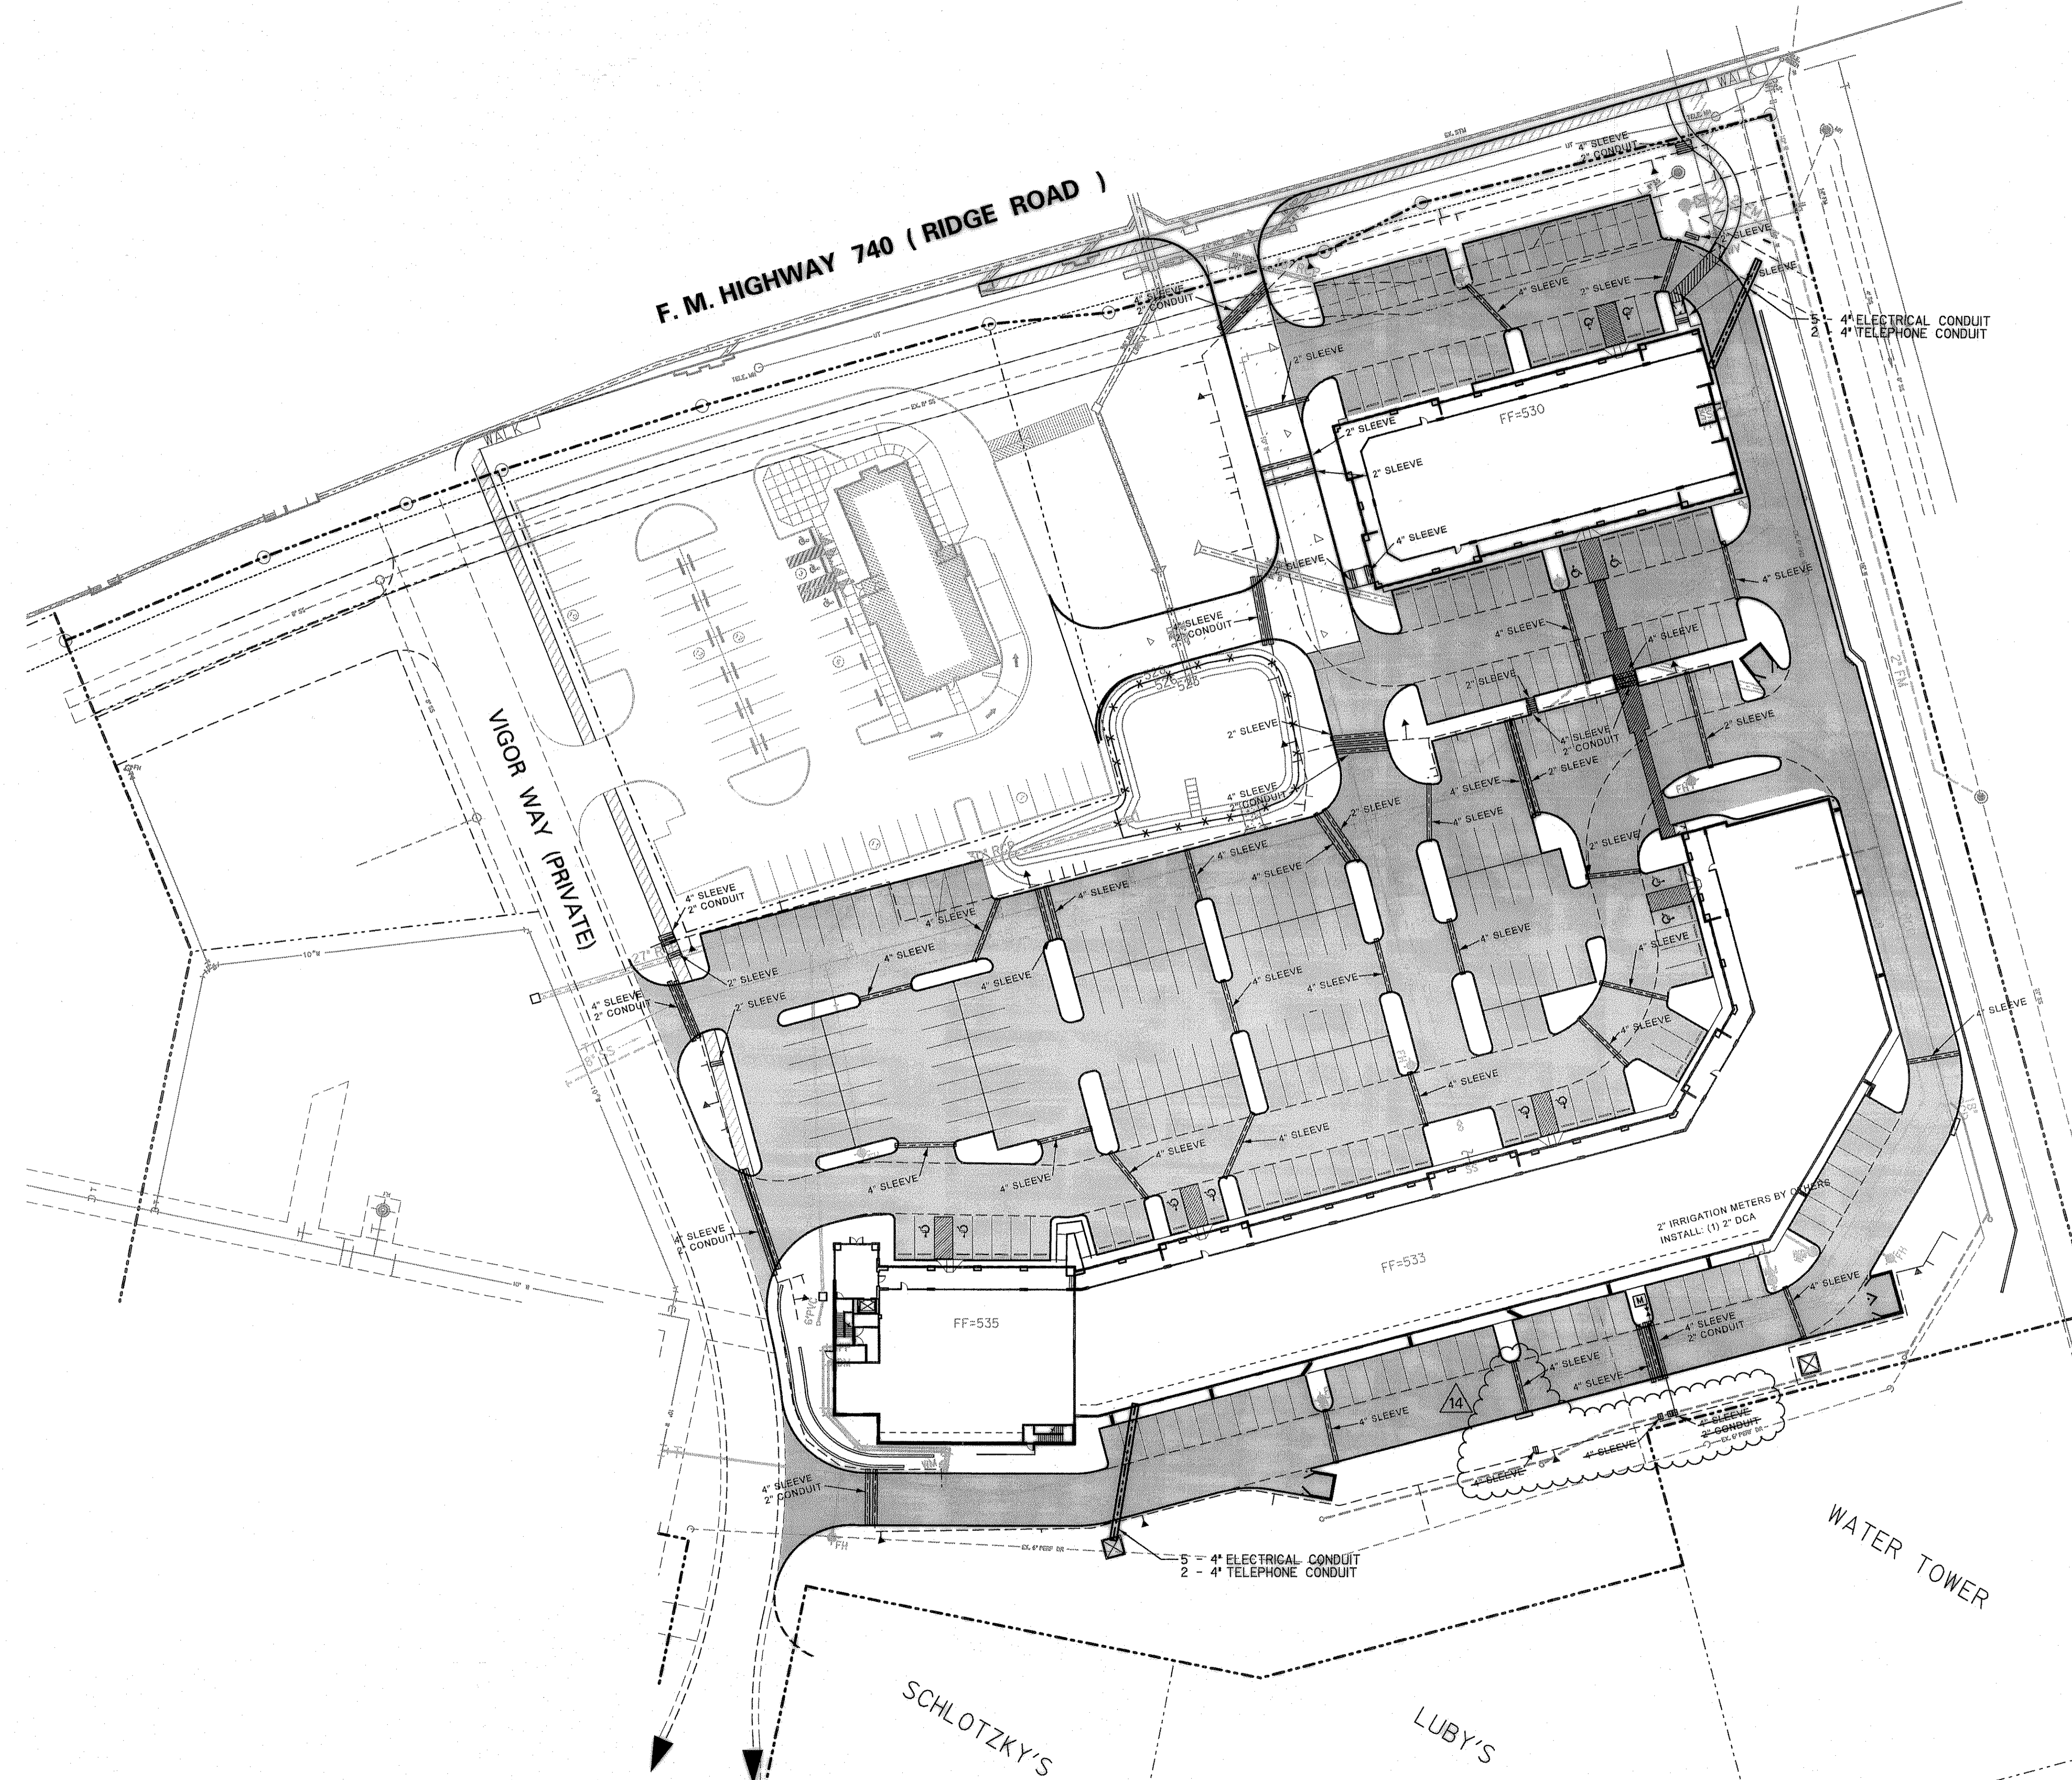

RECORD DRAWINGS BASED ON
FIELD SURVEY (12/05) AND
CONTRACTOR INFORMATION ONLY.
Mark W. McGraw 2-8-06

Project No: AVO # 20817
Revised:

No.	Date	Description
1	11/04/02	FIRST SUBMITTAL
2	4/08/03	SECOND SUBMITTAL
3	5/09/03	THIRD SUBMITTAL
4	6/09/03	FOURTH SUBMITTAL
5	7/03/04	FIFTH SUBMITTAL
7	10/26/04	SEVENTH SUBMITTAL

Drawn by:
Checked by:
Sheet Title

SLEEVING PLAN

C4.2

02-08-06 RECORD DRAWINGS
92905 ELIMINATED 28 PARKING SPACES