


Elevation-Area-Storage Volume

Elev.	Vol yd3	Cum yd3	Volume ft3	Storm Year	Acre-ft
553.40	0.00	0.00	0.00		0
553.50	0.01	0.01	0.27		0
553.60	0.04	0.05	1.35		0
553.70	0.10	0.15	4.05		0
553.80	0.19	0.34	9.18		0
553.90	0.33	0.67	18.09		0
554.00	0.51	1.18	31.86		0
554.10	0.72	1.90	51.30		0.001
554.20	1.15	3.05	82.35		0.001
554.30	2.41	5.46	147.42		0.003
554.40	4.34	9.80	264.60		0.006
554.50	5.87	15.67	423.09		0.009
554.60	7.34	23.01	621.27		0.014
554.70	9.37	32.38	874.26		0.02
554.80	11.24	43.62	1177.74		0.027
554.90	12.39	56.01	1512.27		0.034
555.00	13.01	69.02	1863.54		0.042
555.10	13.43	82.45	2226.15		0.051
555.20	13.85	96.30	2600.10		0.059
555.30	14.26	110.56	2985.12		0.068
555.40	14.67	125.23	3381.21		0.077
555.50	15.10	140.33	3788.91		0.086
555.60	15.52	155.85	4207.95		0.096
555.70	15.94	171.79	4638.33		0.106
555.80	16.38	188.17	5080.59		0.116
555.90	16.81	204.98	5534.46		0.127
556.00	17.25	222.23	6000.21		0.137
556.10	17.70	239.93	6478.11		0.148
556.20	18.13	258.06	6967.62		0.159
556.30	18.59	276.65	7469.55		0.171
556.40	19.04	295.69	7983.63		0.183
556.50	19.49	315.18	8509.86	5-yr (8,709=556.54)	0.195
556.60	19.96	335.14	9048.78	10-yr (9,236=556.63)	0.207
556.70	20.42	355.56	9600.12		0.22
556.80	20.89	376.45	10164.15		0.233
556.90	21.35	397.80	10740.60		0.246
557.00	21.84	419.64	11330.28		0.26
557.10	22.32	441.96	11932.92	25-yr (11,969=557.11)	0.273
557.20	22.90	464.76	12548.52		0.288
557.30	23.30	488.06	13177.62	50-yr (13,277=557.32)	0.302
557.40	23.80	511.86	13820.22	100-yr (14,317=557.48)	0.317
557.50	24.30	536.16	14476.32		0.332


OUTLET STRUCTURE #1

(N.T.S. - DIMENSIONS SHOWN REFLECT AS-BUILT CONDITION)

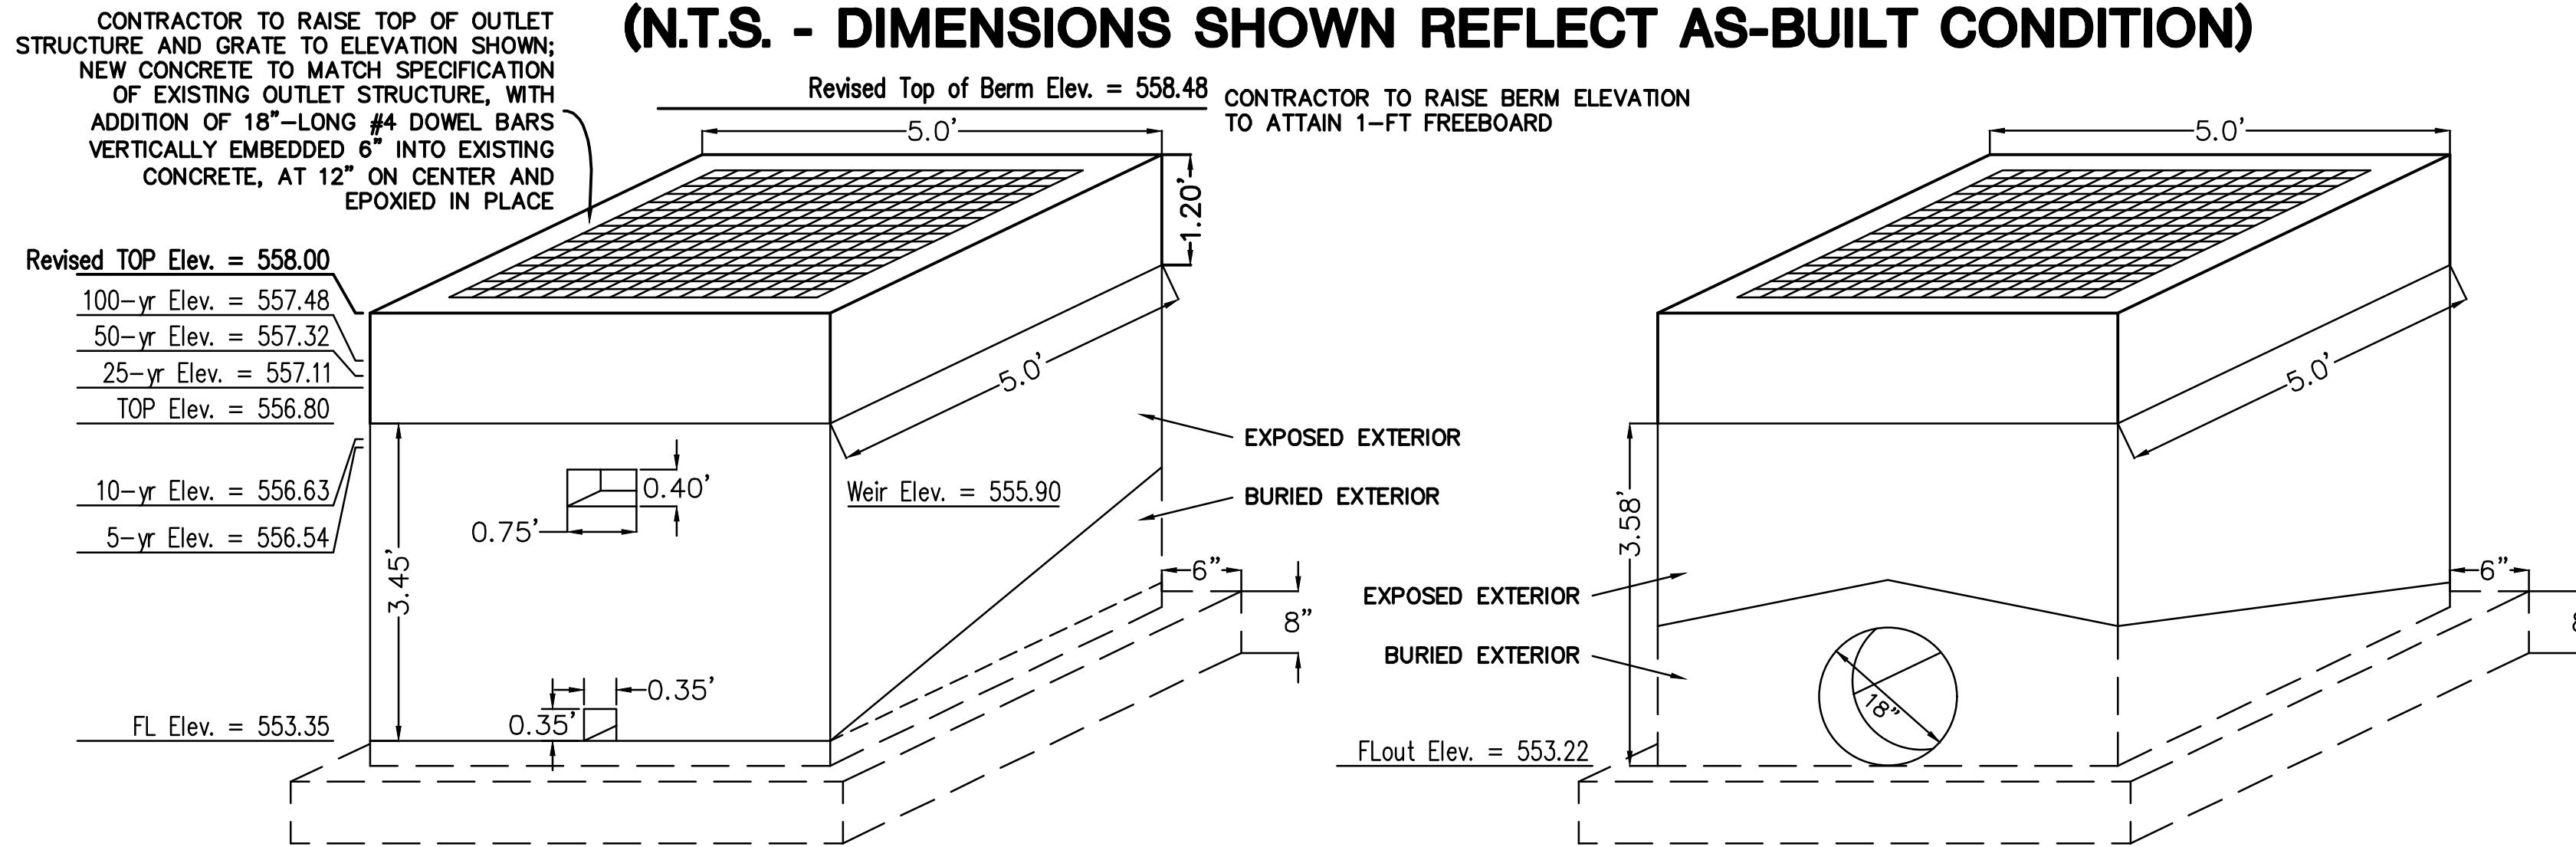

FRONT

BACK

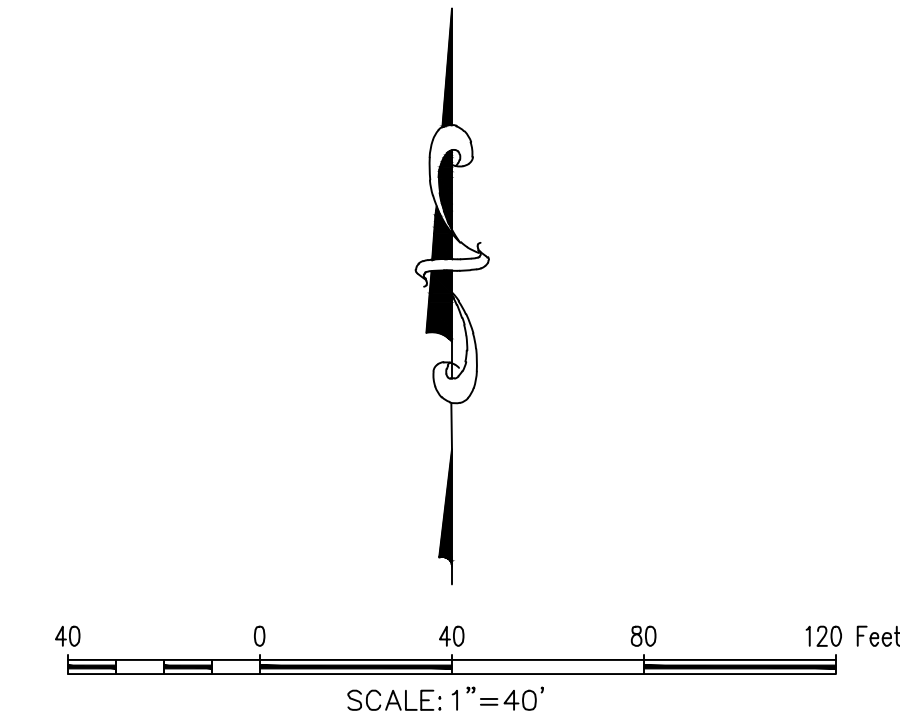

THE "X" CUT ON CURB INLET ALONG NORTHSIDE OF DISCOVERY BLVD. APPROXIMATELY 85' WEST OF THE SOUTHWEST CORNER OF SUBJECT PROPERTY LINE. ELEV.= 564.92

BM: CITY OF ROCKWALL CONTROL MONUMENT "N1495", CALLED ELEV.= 566.71. MEASURED ELEV. = 566.83

NOTE: Detention Outlet Structure to be 6" thick, 3600 psi concrete with #4 bars @ 12" O.C.E.W. for all faces.

Top of structure to be fitted with grate.

Bottom to be 8" thick.

Contractor to grout the bottom of the Outlet Structure, from the Flow Line into box from the Detention Pond to the Flow Line out of the box into the connected RCP

GRADING NOTE: Fill for raising the top of berm elevation shall not be taken from within the Detention Pond limits

SWBC ROCKWALL PHASE II POND A-1 OUTLET STRUCTURE - AS-BUILT VERIFICATION

Year	Ex. Q (cfs)	Ult. Q (cfs)	Pond Elev. (ft.)	Outlet Elev. (ft.)	Height (ft.)	Storage (c.f.)	Outlet allow (cfs)	Outlet actual (c.f.)
5	3.80	8.00	556.54	553.35	3.19	8,709	2.20	1.94
10	4.60	9.30	556.63	553.35	3.28	9,236	2.70	2.05
25	5.20	10.90	557.11	553.35	3.76	11,969	2.90	2.52
50	5.90	11.80	557.32	553.35	3.97	13,277	3.40	2.70
100	6.50	12.90	557.48	553.35	4.13	14,317	3.80	2.82

C = Orifice Coefficient
A = Area
r = Orifice Radius
hu = Upstream Head
hd = Downstream Head
hc = Centroid Head
ha = Upstream Head over Centroid
hz = Downstream Head over Centroid
hn = Net Head over Centroid
Cw = Weir Coefficient
L = Crest Length
H = Weir Head

C = 0.61
A = L * H
r, low = 0.175 ft r, hi = 0.2
A, low = 0.123 ft² A, hi = 0.3
Qorif = C * A * (2gh)^{0.5}

Cw = 3.33
L = 0.75
Qweir = Cw * L * H^{1.5}

5-YR Storm
low hu = 3.19 hi = 0.64
hd = 0.60 hc = 0.20
ha = 3.01 ha = 0.44
hz = 0.43 hz = 0.00
hn = 2.59 hn = 0.44
H = 0.64

Qorif, low = 0.965
Qorif, hi = 0.974
Qtotal = 1.939 ≤ 2.20

10-YR Storm
low hu = 3.28 hi = 0.73
hd = 0.62 hc = 0.20
ha = 3.10 ha = 0.53
hz = 0.45 hz = 0.00
hn = 2.66 hn = 0.53
H = 0.73

Qorif, low = 0.978
Qorif, hi = 1.069
Qtotal = 2.047 ≤ 2.70

25-YR Storm
low hu = 3.76 hi = 1.21
hd = 0.71 hc = 0.20
ha = 3.58 ha = 1.01
hz = 0.53 hz = 0.00
hn = 3.05 hn = 1.01
H = 1.21


Qorif, low = 1.047
Qorif, hi = 1.476
Qtotal = 2.523 ≤ 2.90

50-YR Storm
low hu = 3.97 hi = 1.42
hd = 0.75 hc = 0.20
ha = 3.80 ha = 1.22
hz = 0.58 hz = 0.00
hn = 3.22 hn = 1.22
H = 1.42


Qorif, low = 1.076
Qorif, hi = 1.622
Qtotal = 2.698 ≤ 3.40

100-YR Storm
low hu = 4.13 hi = 1.58
hd = 0.77 hc = 0.20
ha = 3.96 ha = 1.38
hz = 0.59 hz = 0.00
hn = 3.36 hn = 1.38
H = 1.58

Qorif, low = 1.099
Qorif, hi = 1.725
Qtotal = 2.824 ≤ 3.80

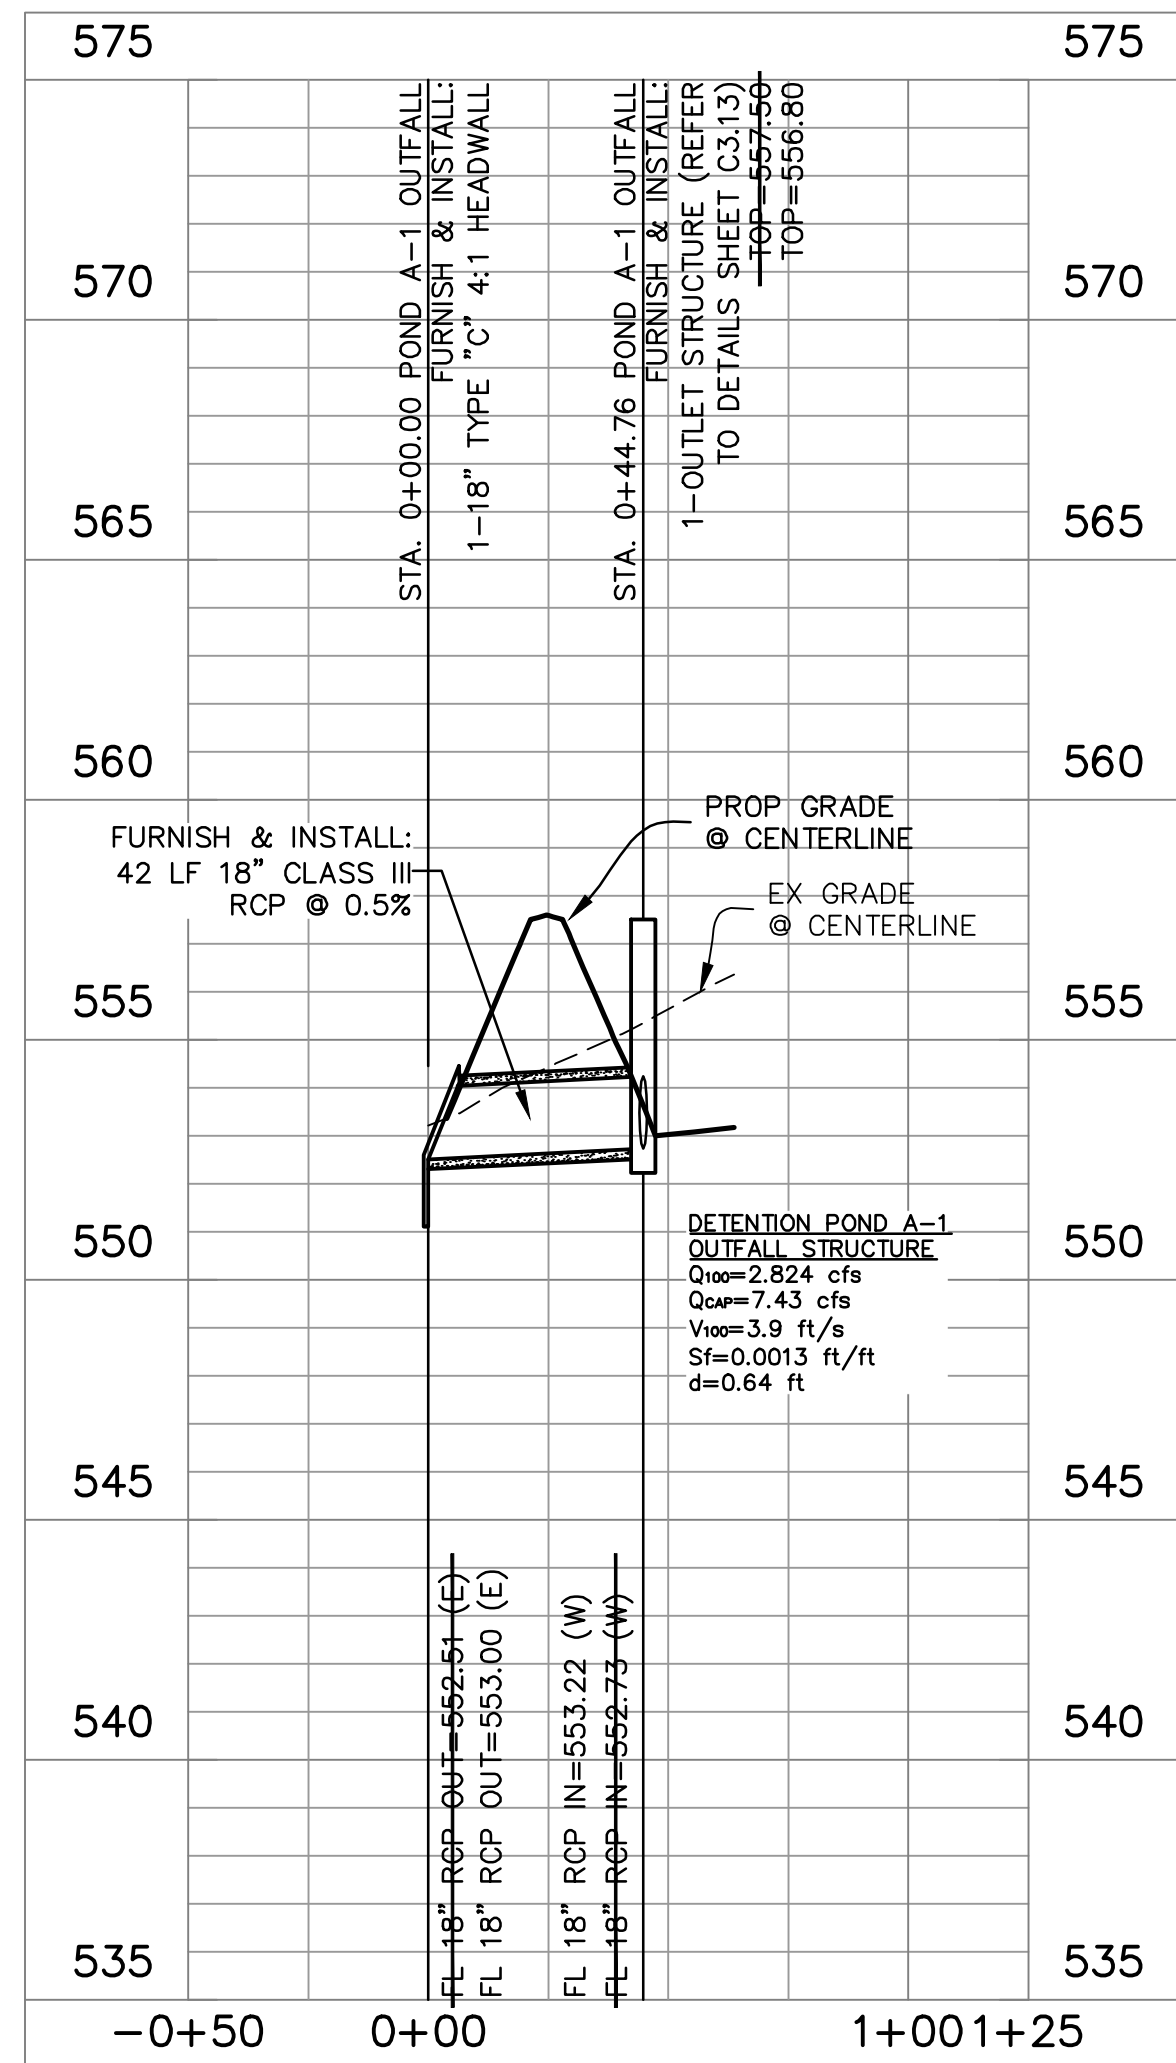

STORM SEWER POND A-1 OUTFALL

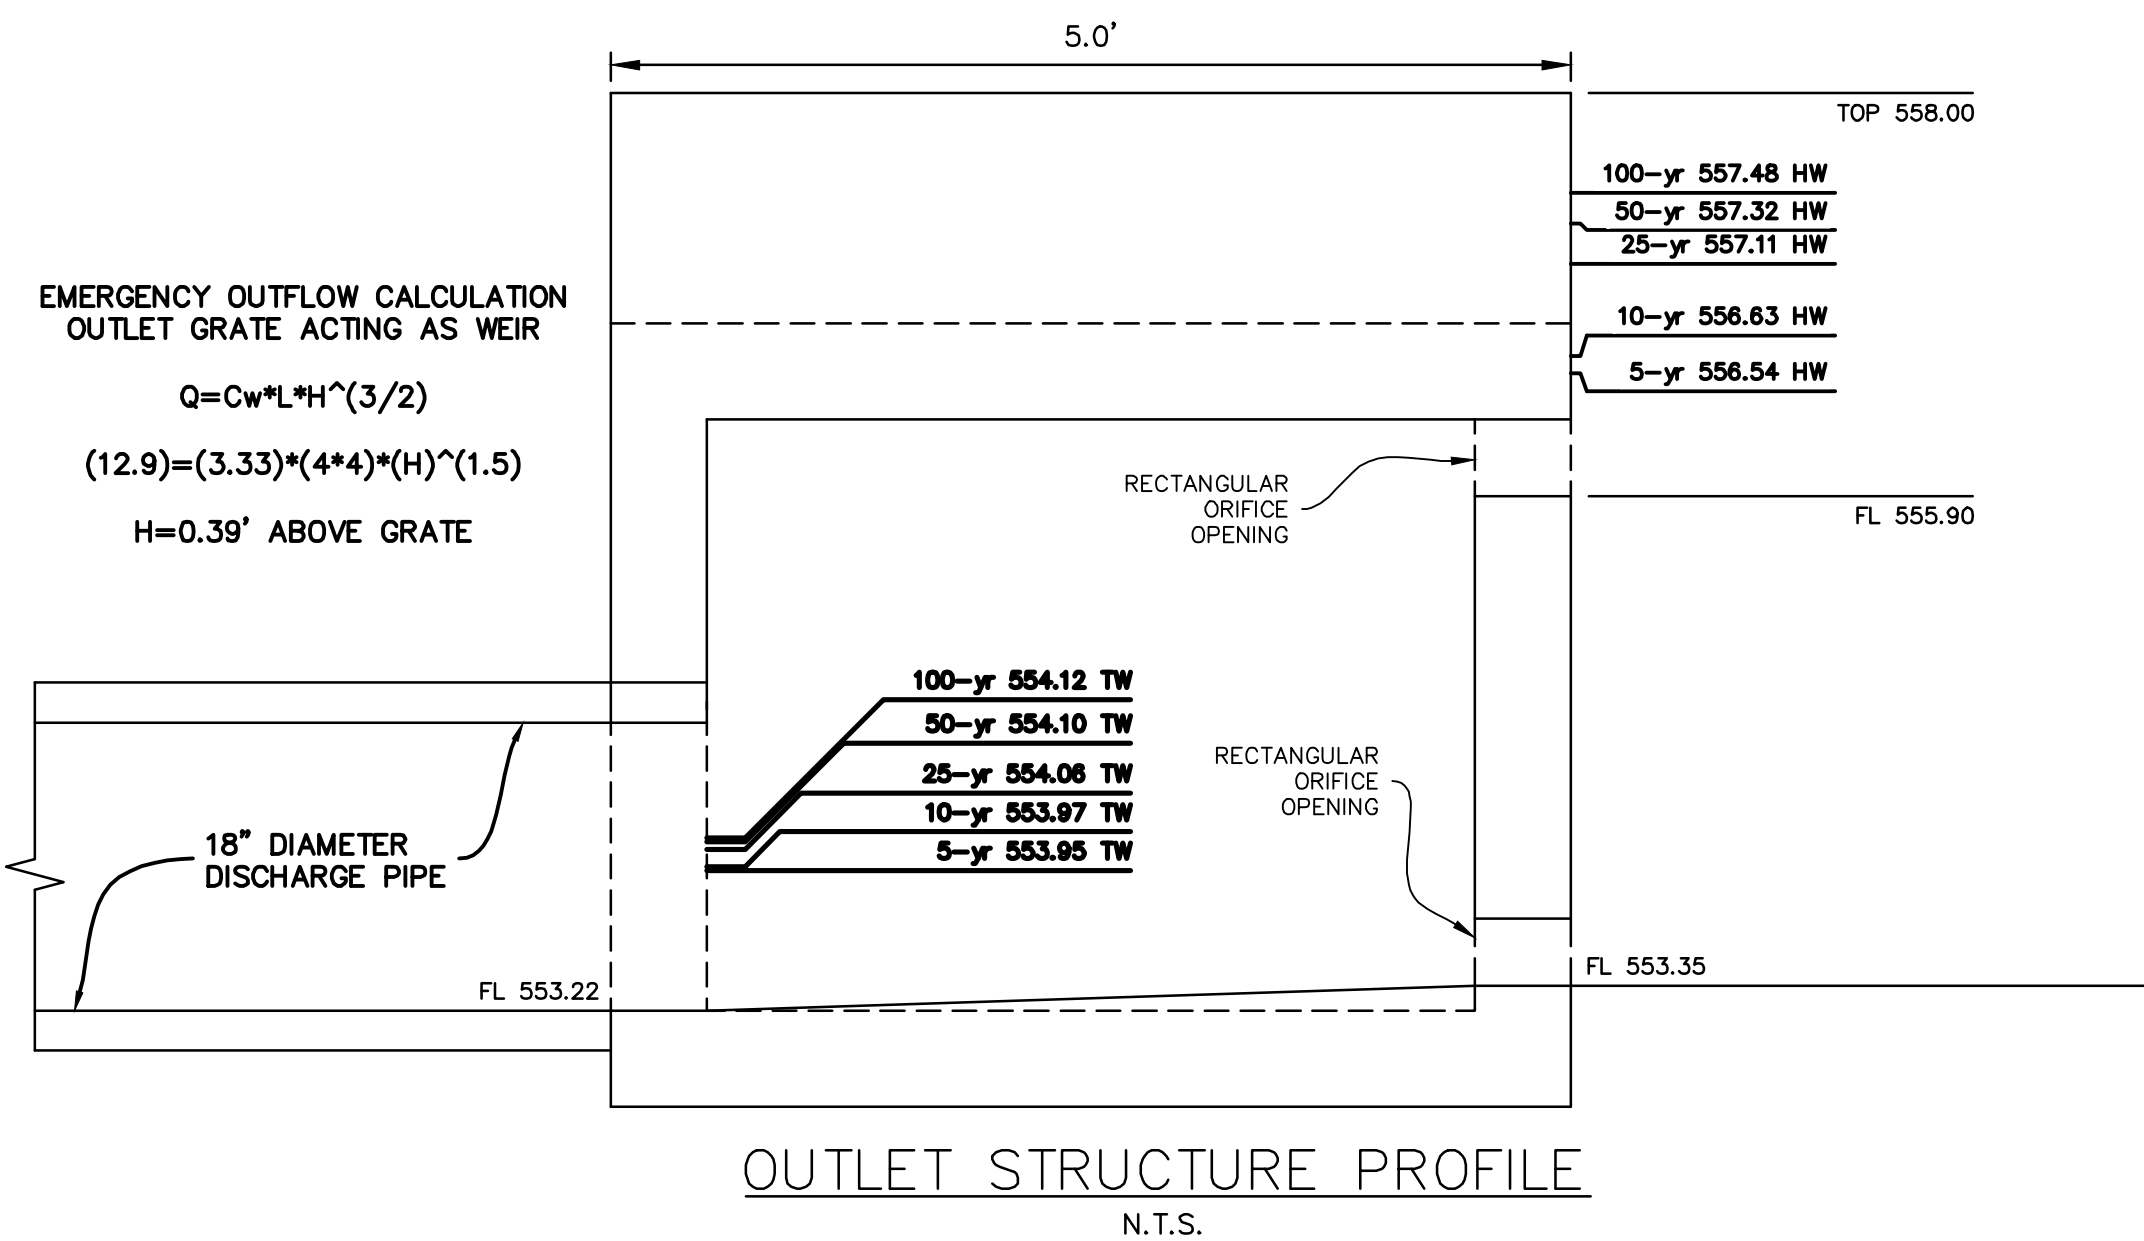

OUTLET STRUCTURE PROFILE
N.T.S.

EMERGENCY OUTFLOW CALCULATION
OUTLET GRATE ACTING AS WEIR

$$Q = C_w * L * H^{1.5} / (3/2)$$


$$(12.9) = (3.33) * (4.4) * (1.5)$$

$$H = 0.39' \text{ ABOVE GRATE}$$

AS-BUILT RECORD DRAWING

THE INFORMATION ON THESE PLANS HAS BEEN REVISED TO REFLECT CHANGES TO PUBLIC IMPROVEMENTS MADE DURING CONSTRUCTION. UNLESS OTHERWISE NOTED, THE CONSTRUCTION OF THE PUBLIC IMPROVEMENTS IS IN GENERAL CONFORMANCE WITH THESE PLANS, BASED UPON INFORMATION PROVIDED BY THE CONTRACTOR AND FIELD VERIFICATIONS. THE RESPONSIBILITY FOR ACCURACY AND COMPLETENESS BELONGS TO THE CONTRACTOR.

Matthew G. St. Marie
THE JOHN R. MCADAMS COMPANY, INC.
Date: 09/25/2023

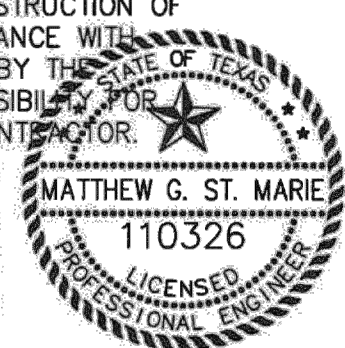

MCADAMS
TBPE 19762

Drawn By: CMK
Date: 12/30/2020
Scale: H 1" = 40'; V 1" = 4'
Revisions:
02/11/2021
03/11/2021
05/07/2021
07/12/2021

09/25/2023 - AS-BUILT

WBC20000

C3.13

OWNER/DEVELOPER
SWBC ROCKWALL LP
6949 SHERRY LANE, SUITE 750
DALLAS, TEXAS 75225
Ph. (214) 987-0700
Contact: Spencer Byington

SWBC ROCKWALL PHASE II
Lot 1, Block A

SWBC ROCKWALL ADDITION, PHASE II
21.275 Acres
in the
J.M. ALLEN SURVEY ABSTRACT NO. NO. 2
CITY OF ROCKWALL,
ROCKWALL COUNTY, TEXAS

DETENTION POND A-1
OUTFALL CALCULATIONS

The John R. McAdams Company, Inc.
111 Hillside Drive
Lewisville, Texas 75057
972.435.9712
201 Country View Drive
Rockwall, Texas 75087
940.240.1012
TBPE: 19762 TBPLS: 10194440
www.mcadams.com



SWBC ROCKWALL PHASE II