



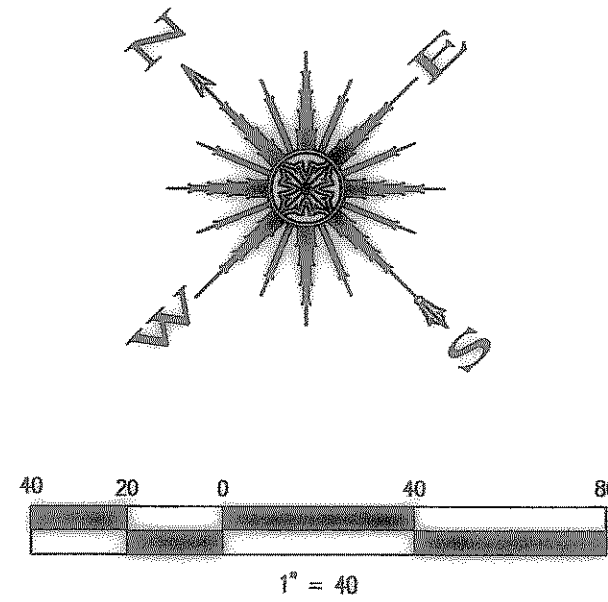


LEGEND	
SYM.	DESCRIPTION
---	R.O.W. LINE
---	EXISTING SS LINE
---	SS LINE
---	EASEMENT

Revision	Date	Description
7-23-07		Sanitary Revisions

SANITARY SEWER PROFILE
Rockwall Library

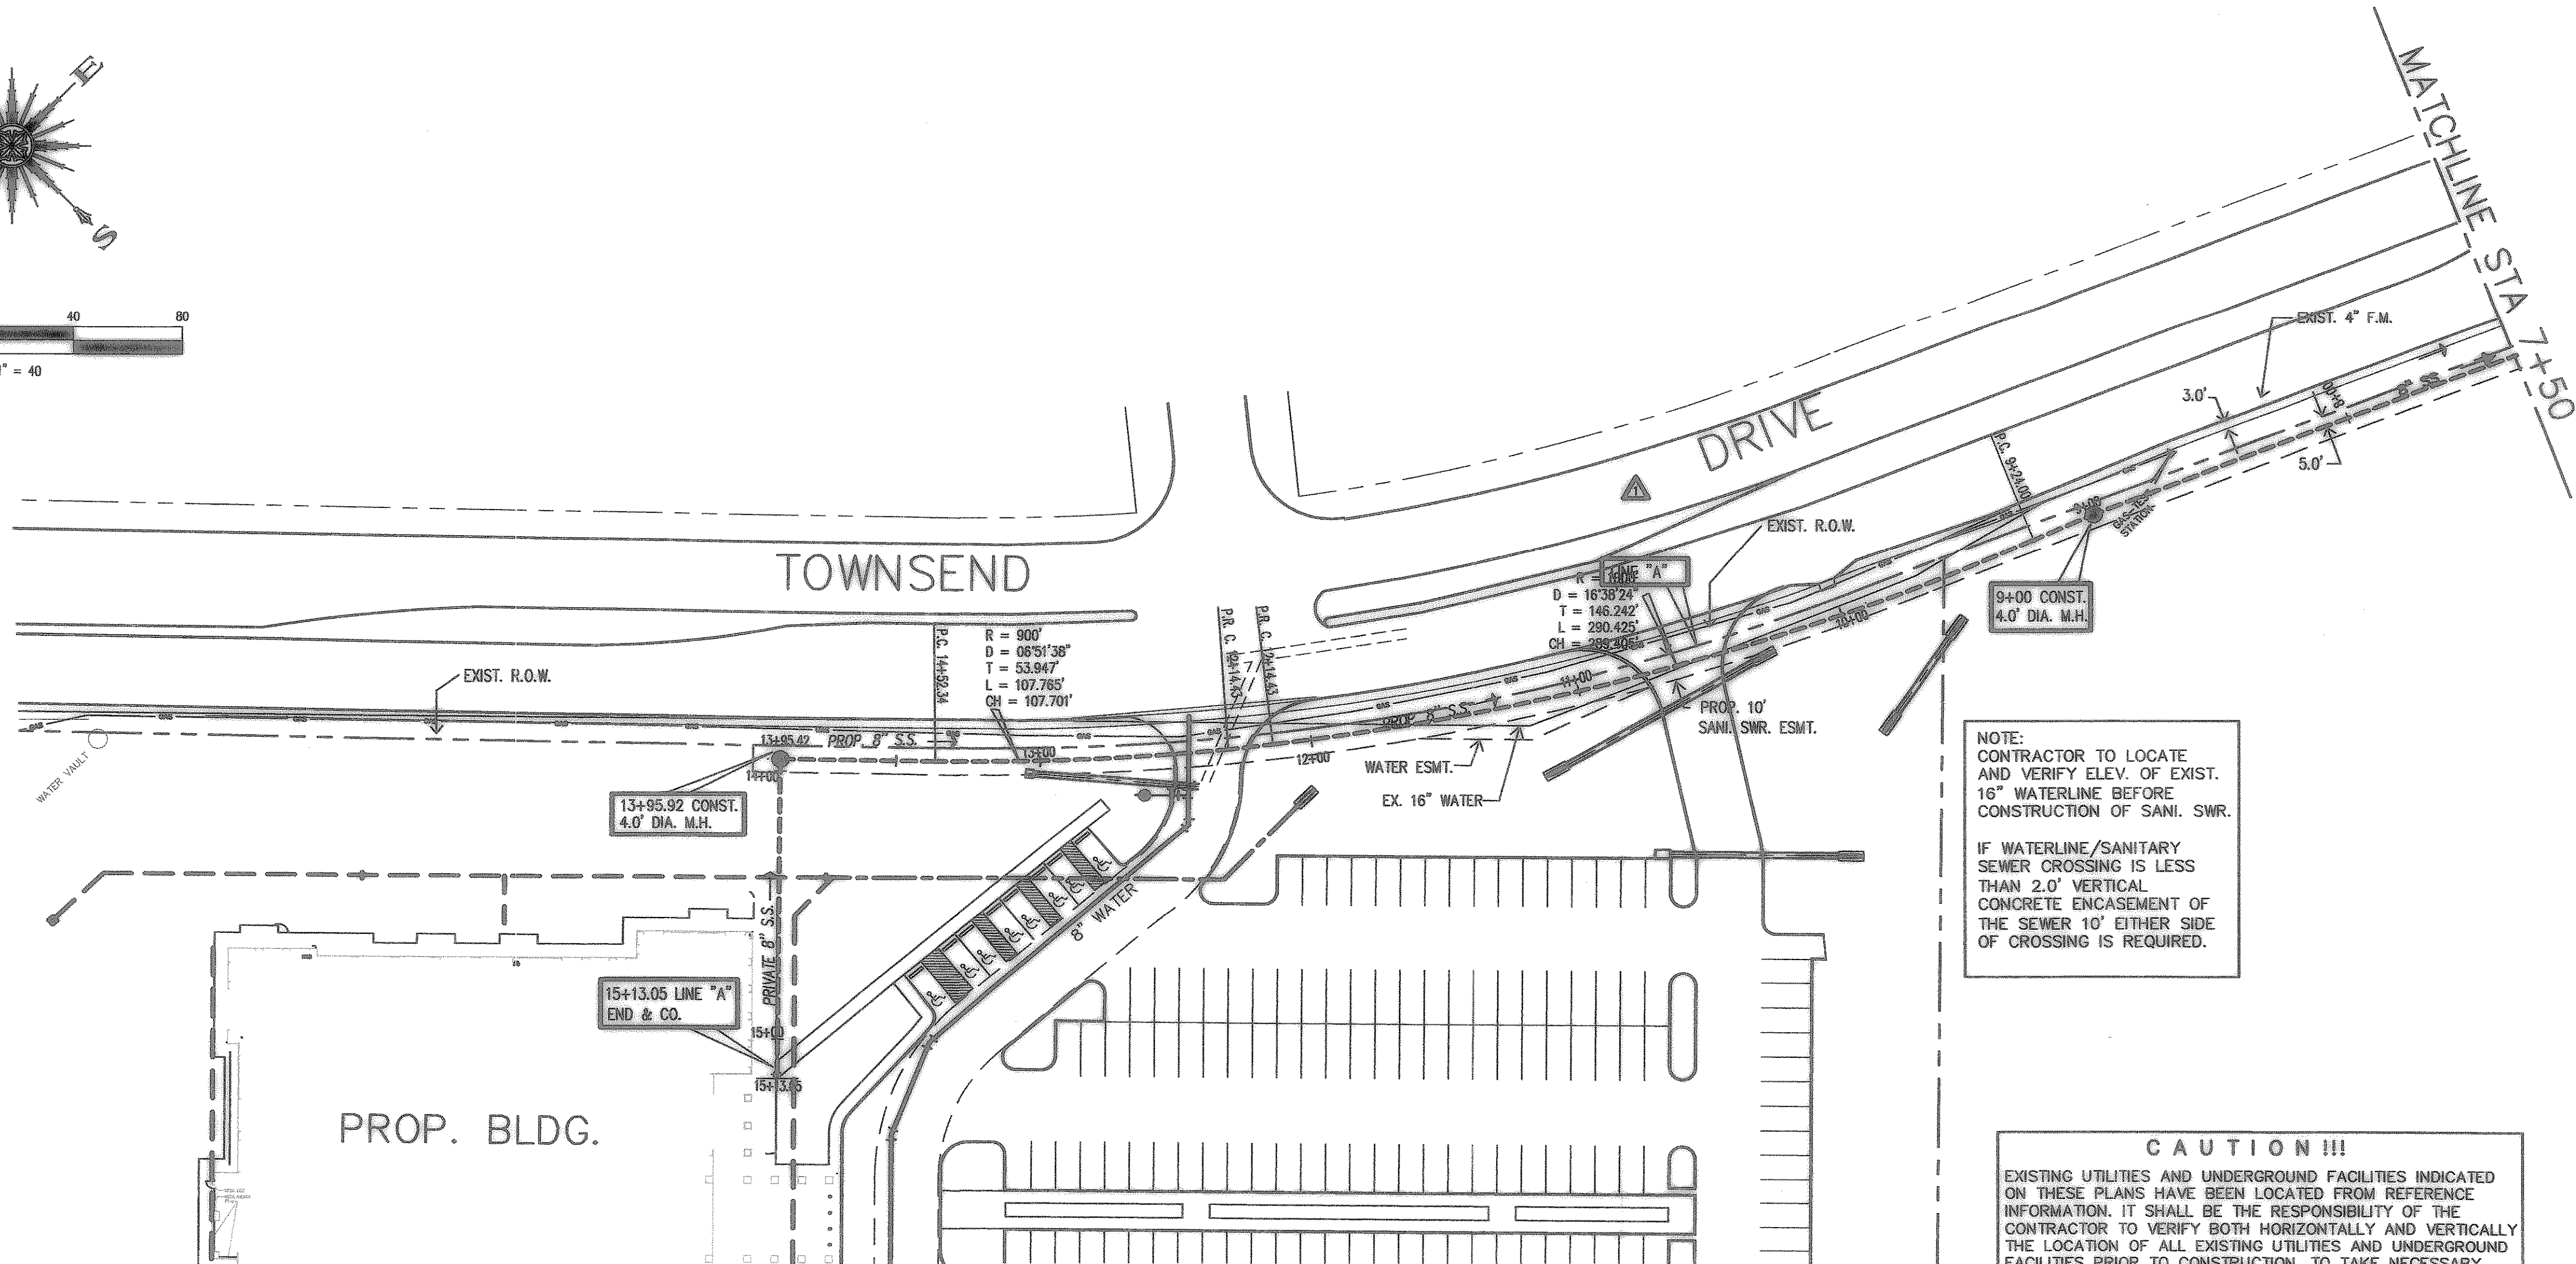


LINE "A"

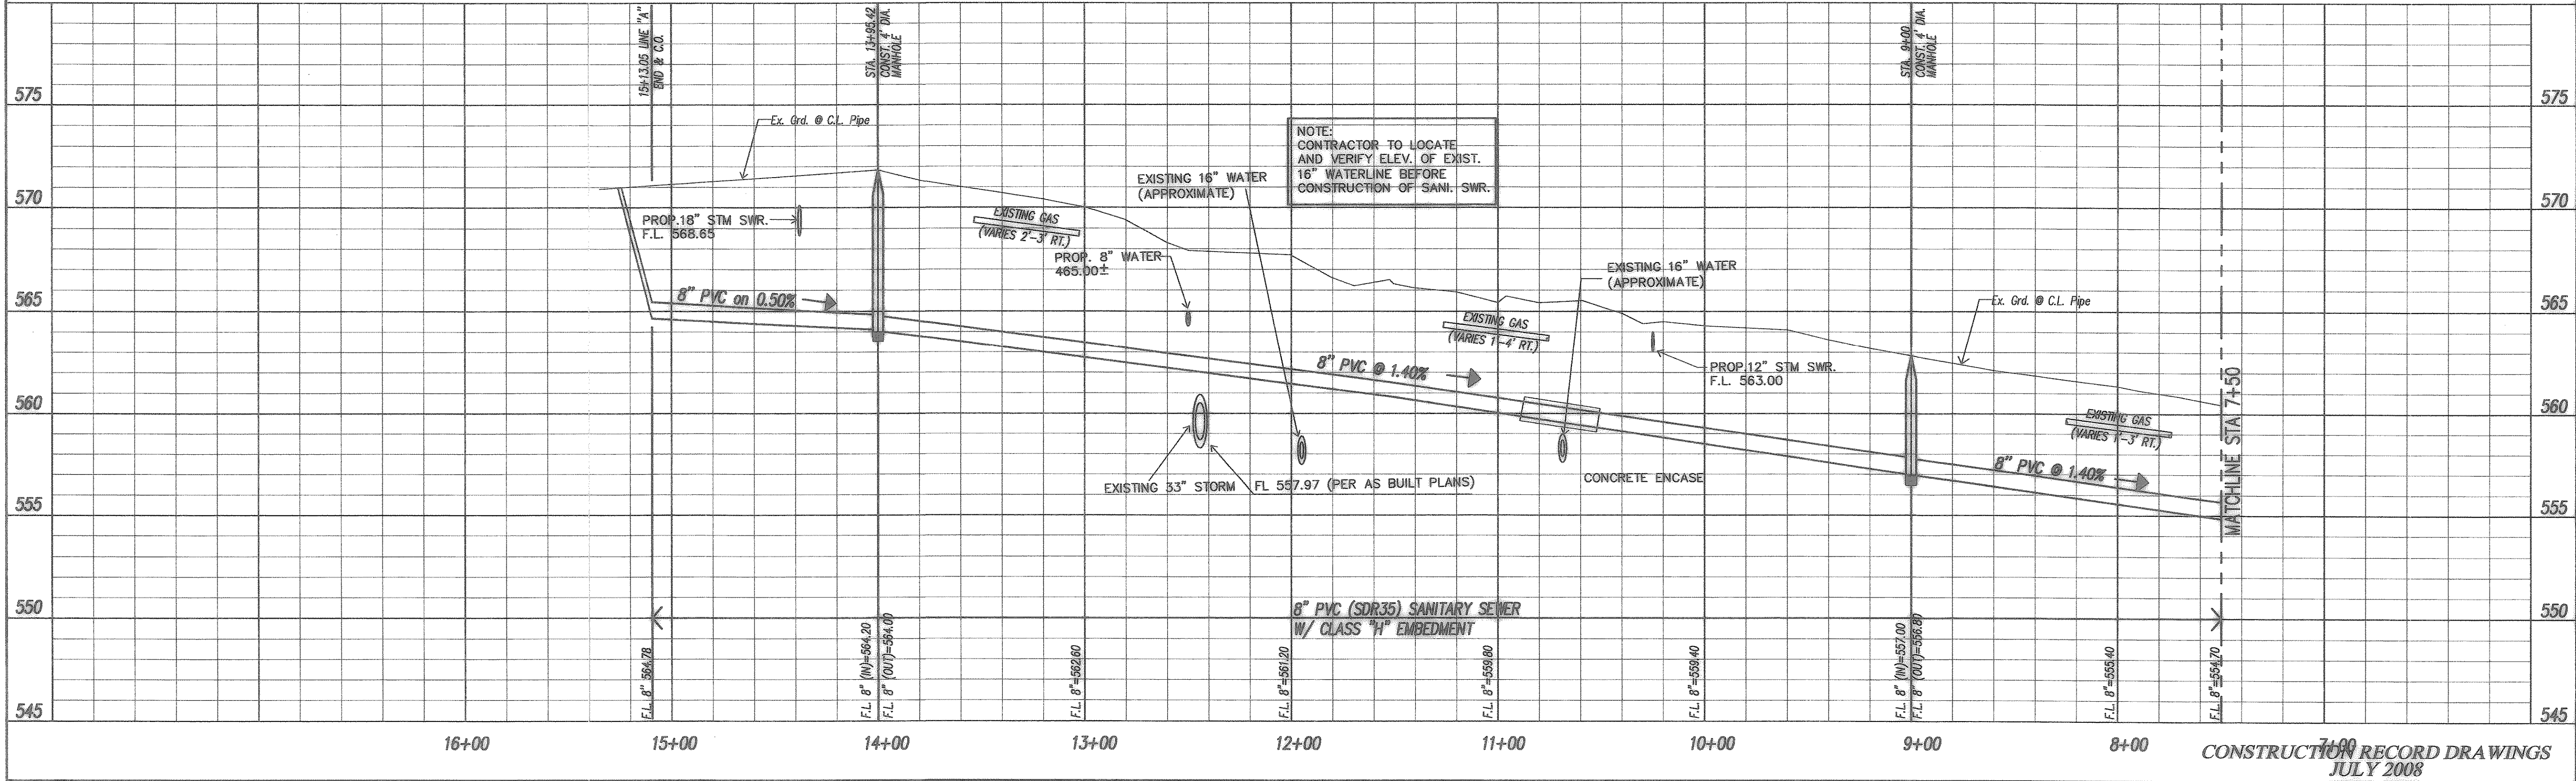

F.C. CUNY CORPORATION

#2 Horizon Court
Heath, Texas 75032
Phone: 469-402-7700
Fax: 469-402-0700

THE SEAL APPEARING ON THIS DOCUMENT WAS AUTHORIZED BY CHRISTOPHER R. CUNY, P.E. 65642

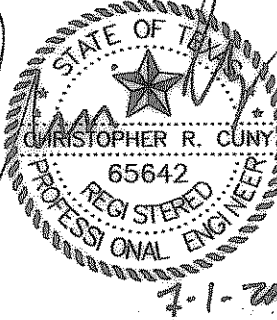

Drawn By: WSC	Checked By: DJW
Date: 6-22-07	Project No.: 05-017
Sheet Title: Sanitary Sewer Profile	
Scale: 1"=40' H. 1"=4' V.	Sheet No.: 5 of 11

Z:\Projects\16-Commercial\Rockwall\Library\Construction\rockwall-ssprofiled2.dwg Tue Jul 01 15:07:06 2008