


**BENCH MARK:**  
 Top operating nut of fire hydrant at the intersection of Yellowjacket Lane and Kyle Drive.  
 Elev: 529.26  
 Centerline of a 15 Foot inlet on the Southwest side of Greencrest Blvd. at the intersection of Greencrest Blvd. and Suncrest Drive.  
 Elev: 524.80

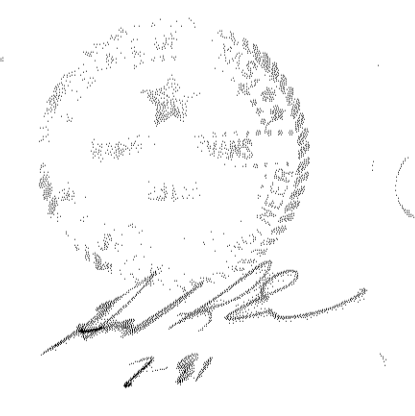

|  |         |         |  |  |  |
|--|---------|---------|--|--|--|
| <b>HAROLD L. EVANS</b><br>CONSULTING ENGINEER<br>2331 GUS THOMASSON RD. SUITE 102<br>DALLAS, TEXAS 75228<br>PHONE (214) 328-8133 |         |         | <b>WATER, SANITARY &amp; STORM SEWER PLANS</b><br><b>ROCKWALL HIGH SCHOOL ADDITION</b><br>CITY OF ROCKWALL, ROCKWALL COUNTY, TEXAS |  |  |
| SCALE  | DATE    | JOB NO. |  |  |  |
| 1" = 40'   | 7-11-91 | 90134   |  |  |  |
| Rev. 7-29-91<br>Rev. 8-07-91   |         |         |  |  |  |