



CASE COVER SHEET

City of Rockwall
Planning and Zoning Department
385 S. Goliad Street
Rockwall, Texas 75087

PLANNING & ZONING CASE NO.

PLANNING & ZONING FEE

PLATTING APPLICATION

MASTER PLAT
PRELIMINARY PLAT
FINAL PLAT
REPLAT
AMENDING OR MINOR PLAT
PLAT REINSTATEMENT REQUEST

SITE PLAN APPLICATION

SITE PLAN
AMENDED SITE PLAN/ELEVATIONS/LANDSCAPING

ZONING APPLICATION

ZONING CHANGE
SPECIFIC USE PERMIT
PD DEVELOPMENT PLAN

OTHER APPLICATION

TREE REMOVAL
VARIANCE REQUEST/SPECIAL EXCEPTIONS

RECORD OF RECOMMENDATIONS, VOTING RECORDS, AND CONDITIONS OF APPROVAL

ARCHITECTURE REVIEW BOARD

PLANNING AND ZONING COMMISSION

CITY COUNCIL READING #1

CITY COUNCIL READING #2

CONDITIONS OF APPROVAL

NOTES



DEVELOPMENT APPLICATION

City of Rockwall
Planning and Zoning Department
385 S. Goliad Street
Rockwall, Texas 75087

STAFF USE ONLY

PLANNING & ZONING CASE NO. B022-056

NOTE: THE APPLICATION IS NOT CONSIDERED ACCEPTED BY THE CITY UNTIL THE PLANNING DIRECTOR AND CITY ENGINEER HAVE SIGNED BELOW.

DIRECTOR OF PLANNING:

CITY ENGINEER:

PLEASE CHECK THE APPROPRIATE BOX BELOW TO INDICATE THE TYPE OF DEVELOPMENT REQUEST (SELECT ONLY ONE BOX):

PLATTING APPLICATION FEES:

- ☐ MASTER PLAT (\$100.00 + \$15.00 ACRE) ¹
- ☐ PRELIMINARY PLAT (\$200.00 + \$15.00 ACRE) ¹
- ☒ FINAL PLAT (\$300.00 + \$20.00 ACRE) ¹
- ☐ REPLAT (\$300.00 + \$20.00 ACRE) ¹
- ☐ AMENDING OR MINOR PLAT (\$150.00)
- ☐ PLAT REINSTATEMENT REQUEST (\$100.00)

SITE PLAN APPLICATION FEES:

- ☐ SITE PLAN (\$250.00 + \$20.00 ACRE) ¹
- ☐ AMENDED SITE PLAN/ELEVATIONS/LANDSCAPING PLAN (\$100.00)

ZONING APPLICATION FEES:

- ☐ ZONING CHANGE (\$200.00 + \$15.00 ACRE) ¹
- ☐ SPECIFIC USE PERMIT (\$200.00 + \$15.00 ACRE) ^{1 & 2}
- ☐ PD DEVELOPMENT PLANS (\$200.00 + \$15.00 ACRE) ¹

OTHER APPLICATION FEES:

- ☐ TREE REMOVAL (\$75.00)
- ☐ VARIANCE REQUEST/SPECIAL EXCEPTIONS (\$100.00) ²

NOTES:

¹: IN DETERMINING THE FEE, PLEASE USE THE EXACT ACREAGE WHEN MULTIPLYING BY THE PER ACRE AMOUNT. FOR REQUESTS ON LESS THAN ONE ACRE, ROUND UP TO ONE (1) ACRE.

²: A \$1,000.00 FEE WILL BE ADDED TO THE APPLICATION FEE FOR ANY REQUEST THAT INVOLVES CONSTRUCTION WITHOUT OR NOT IN COMPLIANCE TO AN APPROVED BUILDING PERMIT.

PROPERTY INFORMATION [PLEASE PRINT]

ADDRESS A0207 E Teal, Tract 134-12, Acres 2.564 Prop ID# 30591; Spyglass Hill #4, Block A, Lot 4, Acres 4.316 Prop ID# 29883

SUBDIVISION Marina Village

LOT

BLOCK

GENERAL LOCATION Henry M Chandler Dr, Behind Marina

ZONING, SITE PLAN AND PLATTING INFORMATION [PLEASE PRINT]

CURRENT ZONING PD-8, Ord No. 21-38

CURRENT USE

PROPOSED ZONING PD-8, Ord No. 21-38

PROPOSED USE Multi-Family Residential

ACREAGE 6.889

LOTS [CURRENT] 1

LOTS [PROPOSED] 36

- ☐ **SITE PLANS AND PLATS:** BY CHECKING THIS BOX YOU ACKNOWLEDGE THAT DUE TO THE PASSAGE OF HB3167 THE CITY NO LONGER HAS FLEXIBILITY WITH REGARD TO ITS APPROVAL PROCESS, AND FAILURE TO ADDRESS ANY OF STAFF'S COMMENTS BY THE DATE PROVIDED ON THE DEVELOPMENT CALENDAR WILL RESULT IN THE DENIAL OF YOUR CASE.

OWNER/APPLICANT/AGENT INFORMATION [PLEASE PRINT/CHECK THE PRIMARY CONTACT/ORIGINAL SIGNATURES ARE REQUIRED]

☐ OWNER LTL Family Holdings, LLC

☐ APPLICANT Michael Joyce Properties

CONTACT PERSON William Johnson

CONTACT PERSON Ryan Joyce

ADDRESS 14918 Mystic Terrace Lane

ADDRESS 767 Justin Road

CITY, STATE & ZIP Cypress, TX 77429

CITY, STATE & ZIP Rockwall, TX 75087

PHONE

PHONE

512-965-6280

E-MAIL

E-MAIL

ryan@michaeljoyceproperties.com

NOTARY VERIFICATION [REQUIRED]

BEFORE ME, THE UNDERSIGNED AUTHORITY, ON THIS DAY PERSONALLY APPEARED William Johnson [OWNER] THE UNDERSIGNED, WHO STATED THE INFORMATION ON THIS APPLICATION TO BE TRUE AND CERTIFIED THE FOLLOWING:

I HEREBY CERTIFY THAT I AM THE OWNER FOR THE PURPOSE OF THIS APPLICATION; ALL INFORMATION SUBMITTED HEREIN IS TRUE AND CORRECT; AND THE APPLICATION FEE OF \$ 437.78 TO COVER THE COST OF THIS APPLICATION, HAS BEEN PAID TO THE CITY OF ROCKWALL ON THIS THE 14 DAY OF October, 2022. BY SIGNING THIS APPLICATION, I AGREE THAT THE CITY OF ROCKWALL (I.E. "CITY") IS AUTHORIZED AND PERMITTED TO PROVIDE INFORMATION CONTAINED WITHIN THIS APPLICATION TO THE PUBLIC. THE CITY IS ALSO AUTHORIZED AND PERMITTED TO REPRODUCE ANY COPYRIGHTED INFORMATION SUBMITTED IN CONJUNCTION WITH THIS APPLICATION, IF SUCH REPRODUCTION IS ASSOCIATED OR IN RESPONSE TO A REQUEST FOR PUBLIC INFORMATION.


GIVEN UNDER MY HAND AND SEAL OF OFFICE ON THIS THE 14 DAY OF October, 2022.

OWNER'S SIGNATURE


[Signature]

NOTARY PUBLIC IN AND FOR THE STATE OF TEXAS

[Signature]

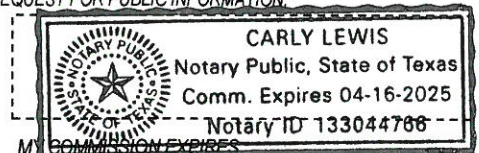

4-16-25

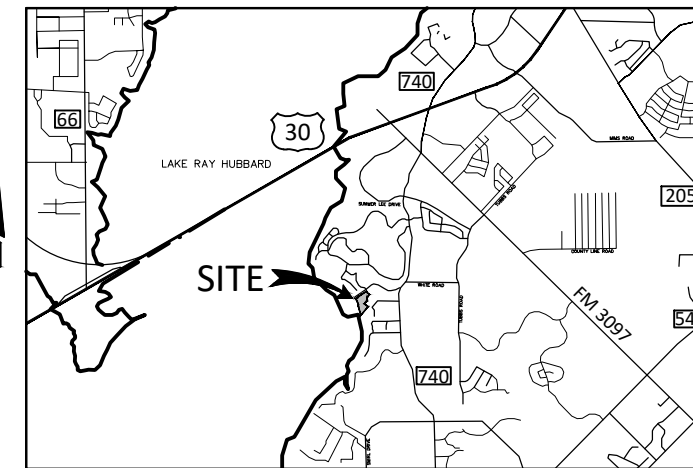

VICINITY MAP
N.T.S.


LEGEND

- Point of Curvature or Tangency on Center Line
- 1/2" Iron rod set with a yellow plastic cap stamped "JVC" (unless otherwise noted)
- 1/2" IRF (unless otherwise noted)

AC	Acre
BL	Building Line
C1	Curve No.
<CM>	Control Monument
DE	Drainage Easement
WLE	Water Line Easement
SSE	Sanitary Sewer Easement
Esmt	Easement
L1	Line No.
SF	Square Feet
UE	Utility Easement
PE	Pedestrian Easement
PUDE	Pedestrian, Utility & Drainage Easement
VAM	Visibility Easement

D.R.R.C.T.= Deed Records of Rockwall County, Texas
P.R.R.C.T.= Plat Records of Rockwall County, Texas
M.R.R.C.T.= Map Records of Rockwall County, Texas
O.R.R.C.T.= Official Records of Rockwall County, Texas

Easement Abandonment

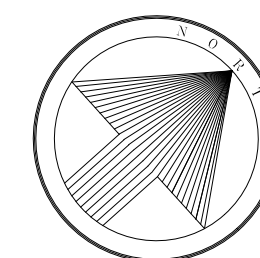

SCALE 1" = 60'

FINAL PLAT MARINA VILLAGE

LOTS 1X, 2-29, 30X, 31X, 32-39 BLOCK A
6.889 ACRES

36 TOWNHOME LOTS AND
4 COMMON AREAS

SITUATED WITHIN THE
EDWARD TEAL SURVEY, ABSTRACT NO. 207

CITY OF ROCKWALL
ROCKWALL COUNTY, TEXAS

P2022-008

October 14, 2022

SHEET 1 OF 2



JBPELS: Engineering Firm No. 11962 / Land Surveying Firm No. 10194033
704 Central Parkway East | Suite 1200 | Plano, TX 75074 | 972.201.3100

Owner/Applicant:
LTL Family Holdings, LLC
William Johnson
14918 Mystic Terrace Lane
Cyprus, Texas 77429
Phone: 713-325-4294

Engineer/Surveyor:
Johnson Volk Consulting, Inc.
704 Central Parkway East, Suite. 1200
Plano, Texas 75074
Phone: 682-225-7189
Contact: Tom Dayton, PE

TRACT ONE
RAY HUBBARD
DOCUMENT NO. 2016-22170
D.R.R.C.T.

HARBOR LANDING PHASE TWO
CABINET C, PAGE 110
M.R.R.C.T.

HARBOR LANDING PHASE ONE
CABINET B, PAGE 362
M.R.R.C.T.

EX. 15' UTILITY
EASEMENT

HARBOR LANDING DR.
EXISTING 30' W.
RIGHT-OF-WAY

HENRY M. CHANDLER DRIVE

POINT OF
BEGINNING

N: 7007539.35
E: 2588822.58

278 HENRY M CHANDLER DR

RYAN S. HUDDIN AND
JADA HUDDIN
DOCUMENT NO. 20190000001989
D.R.R.C.T.

LOT 3, BLOCK A
SPYGLASS HILL CONDOMINIUMS, PHASE 3
CABINET B, PAGE 175
M.R.R.C.T.

6,646 S.F. PORTION
OF 15' UTILITY ESMT.
TO BE ABANDONED
BY THIS PLAT
CABINET B, PG. 146-147
P.R.R.C.T.

CITY OF ROCKWALL
CITY OF HEATH

GENERAL NOTES:

- ALL LOT CORNERS MONUMENTED WITH A 1/2" IRON ROD WITH A YELLOW PLASTIC CAP STAMPED "JVC" UNLESS OTHERWISE NOTED.
- ALL UTILITY EASEMENTS AND DRAINAGE EASEMENTS WITHIN THIS PLATTED PROPERTY ARE CREATED BY THIS PLAT, UNLESS OTHERWISE NOTED.
- BASIS OF BEARING AND COORDINATES SHOWN HEREON REFER TO "TEXAS STATE PLANE COORDINATE SYSTEM, NORTH CENTRAL ZONE (+4202), NORTH AMERICAN DATUM OF 1983 ON GRID COORDINATE VALUES.
- LOCATION OF 1% ANNUAL FLOOD CHANCE ESTIMATED FROM FEMA FIRM PANEL 48139C0325F DATED JUNE 3, 2013.
- LOTS ADJACENT TO FLOODPLAIN SHALL HAVE A MINIMUM FINISHED FLOOR ELEVATION 2' ABOVE THE 100-YR WSEL.
- IT SHALL BE THE POLICY OF THE CITY OF ROCKWALL TO WITHHOLD ISSUING BUILDING PERMITS UNTIL ALL STREETS, WATER, SEWER AND STORM DRAINAGE SYSTEMS HAVE BEEN ACCEPTED BY THE CITY. THE APPROVAL OF A PLAT BY THE CITY DOES NOT CONSTITUTE ANY REPRESENTATION, ASSURANCE OR GUARANTEE THAT ANY BUILDING WITHIN SUCH PLAT SHALL BE APPROVED, AUTHORIZED OR PERMIT THEREFORE ISSUED, NOR SHALL SUCH APPROVAL CONSTITUTE ANY REPRESENTATION, ASSURANCE OR GUARANTEE BY THE CITY OF THE ADEQUACY AND AVAILABILITY FOR WATER FOR PERSONAL USE AND FIRE PROTECTION WITHIN SUCH PLAT, AS REQUIRED UNDER ORDINANCE 83-54.
- PROPERTY OWNER SHALL BE RESPONSIBLE FOR MAINTAINING, REPAIRING, AND REPLACING ALL SYSTEMS WITHIN THE DRAINAGE AND DETENTION EASEMENTS.
- ALL ROW, PAVING AND DRAINAGE SHALL BE PRIVATE AND MAINTAINED, REPLACED AND REPAIRED BY HOA/PROPERTY OWNER.

BENCHMARKS

CITY OF ROCKWALL MONUMENT NO. COR-5:
STANDARD CITY OF ROCKWALL CONTROL MONUMENT LOCATED AT THE NORTHEAST CORNER OF THE INTERSECTION OF HENRY W. CHANDLER DRIVE AND COMMODORE PLAZA APPROXIMATELY 400' WEST OF THE INTERSECTION OF HENRY W. CHANDLER DRIVE AND RIDGE ROAD.
ELEVATION = PLAN 560.58' FIELD 561.09'

CITY OF ROCKWALL MONUMENT NO. COR-7:
STANDARD CITY OF ROCKWALL CONTROL MONUMENT LOCATED ON THE SOUTH SIDE OF SUMMER LEE DRIVE APPROXIMATELY 250' WEST OF THE INTERSECTION OF SUMMER LEE DRIVE AND RIDGE ROAD.
ELEVATION = PLAN 567.52' FIELD 567.78'

CITY OF ROCKWALL MONUMENT NO. COR-10:
BRASS DISK STAMPED "CITY OF ROCKWALL SURVEY MONUMENT" ON THE SOUTHEAST SIDE OF LAGUNA DRIVE AT THE SOUTHEAST CORNER OF A CURB INLET APPROXIMATELY 325' NORTHEAST OF THE INTERSECTION OF VILLAGE LANE AND LAGUNA DRIVE.
ELEVATION = PLAN 521.61' FIELD 521.57'

CITY OF ROCKWALL MONUMENT NO. COR-11:
BRASS DISK STAMPED "CITY OF ROCKWALL SURVEY MONUMENT" ON THE NORTHEAST SIDE OF MIMS ROAD AT THE SOUTHERLY END OF A CONCRETE HEADWALL AT THE INTERSECTION OF THE NORTHEAST LINE OF MIMS ROAD WITH THE SOUTHEAST LINE OF I-30.
ELEVATION = PLAN 565.98' FIELD 566.02'

17,241 S.F. PORTION
OF 15' UTILITY ESMT.
TO BE ABANDONED
BY THIS PLAT
CABINET B, PG. 146-147
P.R.R.C.T.

BLOCK A
1X
88642 SF
2.03 AC
OPEN
SPACE

975 S.F. PORTION
OF 15' UTILITY ESMT.
TO BE ABANDONED
BY THIS PLAT
CABINET B, PG. 146-147
P.R.R.C.T.

15' WLE
(BY THIS PLAT)
WINDWARD SLOPE
CABINET A, PAGE 368
M.R.R.C.T.

EX. 15' UTILITY
EASEMENT

VARIABLE WIDTH
UTILITY EASEMENT

STATE OF TEXAS §
COUNTY OF ROCKWALL §

WHEREAS L.T.L. Family Holdings, LLC, BEING THE OWNER OF A TRACT OF land in the County of Rockwall, State of Texas, said tract being described as follows:

BEING a tract of land situated in the E. TEAL SURVEY, ABSTRACT NO. 207, City of Rockwall, Rockwall County, Texas and being all of Lot 4, Block A of SPYGLASS HILL CONDOMINIUMS PHASE FOUR, an Addition to the City of Rockwall, Rockwall County, Texas according to the Plat thereof recorded in Cabinet B, Page 146, Map Records, Rockwall County, Texas and being all of that tract of land described in Deed to L.T.L. Family Holdings, LLC, as recorded in Document No. 20210000034919, Deed Records, Rockwall County, Texas and being more particularly described as follows:

BEGINNING at a 1/2 inch iron rod with a yellow plastic cap stamped "BISON CREEK" found in the southeast line of Henry Chandler Drive, an 80 foot right-of-way, for the common northeast corner of said L.T.L. Family Holdings, LLC tract, northeast corner of said Lot 4 and northwest corner of Lot 3, Block A of SPYGLASS HILL CONDOMINIUMS, PHASE 3, an Addition to the City of Rockwall, Rockwall County, Texas according to the Plat thereof recorded in Cabinet B, Page 175, Map Records, Rockwall County, Texas;

THENCE Southerly, with the common east line of said Lot 4, east line of said L.T.L. Family Holdings, LLC tract and west line of said Lot 3, the following seven (7) courses and distances:

South 04 degrees 01 minutes 18 seconds East, leaving said southeast line, a distance of 39.64 feet to a 1/2 inch iron rod found for corner;

South 49 degrees 01 minutes 18 seconds East, a distance of 160.16 feet to a 1/2 inch iron rod found for corner;

South 36 degrees 41 minutes 52 seconds West, a distance of 180.50 feet to a 1/2 inch iron rod with a yellow plastic cap stamped "BISON CREEK" found for corner;

South 04 degrees 01 minutes 18 seconds East, a distance of 142.73 feet to a 1/2 inch iron rod with a yellow plastic cap stamped "BISON CREEK" found for corner;

South 47 degrees 49 minutes 42 seconds West, a distance of 95.59 feet to a 1/2 inch iron rod found for corner;

South 40 degrees 58 minutes 42 seconds West, a distance of 56.00 feet to a 1/2 inch iron rod with a yellow plastic cap stamped "BISON CREEK" found for corner;

South 49 degrees 01 minutes 18 seconds East, a distance of 203.00 feet to a 1/2 inch iron rod found in the northwest line of WINDWARD SLOPE, an Addition to the City of Rockwall, Rockwall County, Texas according to the Plat thereof recorded in Cabinet A, page 368, Map Records, Rockwall County, Texas for the common south corner of said Lot 3 and an exterior ell corner of said Lot 4 and said L.T.L. Family Holdings, LLC tract;

THENCE South 40 degrees 58 minutes 42 seconds West, with the common southeast line of said Lot 4 and said L.T.L. Family Holdings, LLC tract and said northwest line, a distance of 480.10 feet to a 1/2 inch iron rod with a yellow plastic cap stamped "JVC" set for the common south corner of said Lot 4 and said L.T.L. Family Holdings, LLC tract;

THENCE Northerly, with the west line of said L.T.L. Family Holdings, LLC tract, the following four (4) courses and distances:

North 15 degrees 09 minutes 39 seconds West, a distance of 407.29 feet to a 1/2 inch iron rod with a yellow plastic cap stamped "JVC" set for corner;

North 02 degrees 08 minutes 12 seconds West, a distance of 70.75 feet to a 1/2 inch iron rod with a yellow plastic cap stamped "BISON CREEK" found for corner;

North 21 degrees 26 minutes 12 seconds West, a distance of 156.54 feet to a 1/2 inch iron rod with a yellow plastic cap stamped "BISON CREEK" found for corner;

North 32 degrees 04 minutes 21 seconds West, a distance of 109.80 feet to a 1/2 inch iron rod with a yellow plastic cap stamped "JVC" set in the southeast line of the above mentioned Henry Chandler Drive for the northwest corner of said L.T.L. Family Holdings, LLC tract;

THENCE Northeasterly, with said southeast line, the following four (4) courses and distances:

North 57 degrees 55 minutes 37 seconds East, a distance of 90.00 feet to a 1/2 inch iron rod found for corner;

North 44 degrees 54 minutes 57 seconds East, a distance of 54.37 feet to a 1/2 inch iron rod found for corner at the beginning of a curve to the right having a central angle of 18 degrees 36 minutes 42 seconds, a radius of 471.19 feet and a chord bearing and distance of North 54 degrees 13 minutes 19 seconds East, 152.39 feet;

Northeasterly, with said curve to the right, an arc distance of 153.06 feet to a 1/2 inch iron rod with a yellow plastic cap stamped "JVC" set for corner at the beginning of a reverse curve to the left having a central angle of 15 degrees 20 minutes 06 seconds, a radius of 1,040.00 feet and a chord bearing and distance of North 55 degrees 51 minutes 37 seconds East, 277.52 feet;

Northeasterly, with said curve to the left, an arc distance of 278.35 feet to the POINT OF BEGINNING and containing 6.889 acres of land, more or less.

Line Table		
Line	Length	Direction
L1	39.64	S4° 01' 18"E
L2	56.00	S40° 58' 42"W
L3	70.75	N2° 08' 12"W
L4	48.71	N44° 54' 57"E
L5	7.87	N37° 31' 07"E
L6	75.93	N35° 35' 51"W
L7	10.11	N54° 16' 59"W
L8	34.22	S76° 43' 41"W
L9	44.06	S48° 17' 23"W
L10	51.06	S32° 31' 55"E
L11	26.01	S85° 01' 36"E
L12	21.71	N10° 45' 15"E
L13	8.92	N35° 35' 51"W
L14	28.27	S58° 28' 11"E
L15	28.28	N31° 30' 26"E
L16	28.64	S76° 19' 54"E
L17	28.68	S11° 22' 41"W

Curve Table					
Curve #	Length	Radius	Delta	Chord Length	Chord Bearing
C1	153.06	471.19	018°36'42"	152.39	N54° 13' 19"E
C2	278.35	1040.00	015°20'06"	277.52	N55° 51' 37"E
C3	96.53	250.00	022°07'23"	95.93	N24° 32' 09"W
C4	35.61	50.00	040°48'31"	34.86	S33° 52' 43"E
C5	99.27	200.00	028°26'17"	98.25	N62° 30' 32"E
C6	47.35	50.00	054°15'21"	45.60	N21° 09' 42"E
C7	77.19	250.00	017°41'27"	76.88	N14° 48' 42"W
C8	38.72	250.00	008°52'30"	38.69	N28° 05' 40"W
C9	30.07	189.50	009°05'28"	30.04	N21° 23' 59"W
C10	81.28	210.50	022°07'23"	80.77	N24° 32' 09"W
C11	10.65	20.00	030°29'56"	10.52	N01° 46' 30"E
C12	191.73	54.00	203°26'04"	105.75	N19° 00' 37"E
C13	24.17	20.00	069°13'57"	22.72	S48° 05' 27"E
C14	100.81	225.00	025°40'18"	99.97	N61° 07' 32"E
C15	10.62	225.00	002°42'17"	10.62	S28° 58' 42"E
C16	76.17	175.00	024°56'24"	75.57	N60° 45' 35"E
C17	39.36	96.46	023°22'43"	39.09	S22° 39' 49"W

OWNER'S CERTIFICATION:

NOW THEREFORE, KNOW ALL MEN BY THESE PRESENTS:

STATE OF TEXAS §
COUNTY OF ROCKWALL §

I (we) the undersigned owner(s) of the land shown on this plat, and designated herein as the MARINA VILLAGE subdivision to the City of Rockwall, Texas, and whose name is subscribed hereto, hereby dedicate to the use of the public forever any streets, alleys, parks, water courses, drains, easements and public places thereon shown on the purpose and consideration therein expressed. I (we) further certify that all other parties who have a mortgage or lien interest in the MARINA VILLAGE subdivision have been notified and signed this plat. I (we) understand and do hereby reserve the easement strips shown on this plat for the purposes stated and for the mutual use and accommodation of all utilities desiring to use or using same. I (we) also understand the following:

- No buildings shall be constructed or placed upon, over, or across the utility easements as described herein.
- Any public utility shall have the right to remove and keep removed all or part of any buildings, fences, trees, shrubs, or other growths or improvements which in any way endanger or interfere with construction, maintenance or efficiency of their respective system on any of these easement strips; and any public utility shall at all times have the right of ingress or egress to, from and upon the said easement strips for purpose of construction, reconstruction, inspecting, patrolling, maintaining, and either adding to or removing all or part of there respective system without the necessity of, at any time, procuring the permission of anyone.
- The City of Rockwall will not be responsible for any claims of any nature resulting from or occasioned by the establishment of grade of streets in the subdivision.
- The developer and subdivision engineer shall bear total responsibility for storm drain improvements.
- The developer shall be responsible for the necessary facilities to provide drainage patterns and drainage controls such that properties within the drainage area are not adversely affected by storm drainage from the development.
- No house dwelling unit, or other structure shall be constructed on any lot in this addition by the owner or any other person until the developer and/or owner has complied with all requirements of the Subdivision Regulations of the City of Rockwall regarding improvements with respect to the entire block on the street or streets on which property abuts, including the actual installation of streets with the required base and paving, curb and gutter, water and sewer, drainage structures, storm sewers, and alleys all according to the specifications of the City of Rockwall; or

Until an escrow deposit, sufficient to pay for the cost of such improvements, as determined by the city's engineer and/or city administrator, computed on a private commercial rate basis, has been made with the city secretary, accompanied by an agreement signed by the developer and/or owner, authorizing the city to make such improvements at prevailing private commercial rates, or have the same made by a contractor and pay the same out of the escrow deposit, should the developer and/or owner fail to refuse to install the required improvements within the time stated in such written agreement, but in no case shall the City be obligated to make such improvements itself. Such deposit may be used by the owner and/or developer as progress payments as the work progresses in making such improvements by making certified requisitions to the city secretary, supported by evidence of work done; or

Until the developer and/or owner files a corporate surety bond with the city secretary in a sum equal to the cost of such improvements for the designated area, guaranteeing the installation thereof within the time stated in the bond, which shall be fixed by the city council of the City of Rockwall.

I (we) further acknowledge that the dedications and/or exactions made herein are proportional to the impact of the Subdivision upon the public services required in order that the development will comport with the present and future growth needs of the City; I (we), my (our) successors and assigns hereby waive any claim, damage, or cause of action that I (we) may have as a result of the dedication of exactions made herein.

Property Owner Signature

STATE OF TEXAS §
COUNTY OF ROCKWALL §

BEFORE ME, the undersigned authority, on this day personally appeared L.T.L. Family Holdings, LLC, known to me to be the person whose name is subscribed to the foregoing instrument and acknowledged to me that he executed the same for the purpose and consideration therein stated.

Given under my hand and seal of office, this ____ day of _____, 2022.

Notary public in and for the State of Texas

My Commission Expires

STATE OF TEXAS §
COUNTY OF ROCKWALL §

BEFORE ME, the undersigned authority, on this day personally appeared L.T.L. Family Holdings, LLC, known to me to be the person whose name is subscribed to the foregoing instrument and acknowledged to me that he executed the same for the purpose and consideration therein stated.

Given under my hand and seal of office, this ____ day of _____, 2022.

Notary public in and for the State of Texas

My Commission Expires

SURVEYOR'S CERTIFICATE:

NOW, THEREFORE KNOW ALL MEN BY THESE PRESENTS:

THAT I, Ryan S. Reynolds, do hereby certify that I prepared this plat from an actual and accurate survey of the land, and that the corner monuments shown thereon were properly placed under my personal supervision.

RYAN S. REYNOLDS, R.P.L.S.
Texas Registered Professional Land Surveyor No. 6385.

STATE OF TEXAS §
COUNTY OF COLLIN §

BEFORE ME, the undersigned authority, on this day personally appeared Ryan S. Reynolds, known to me to be the person whose name is subscribed to the above and foregoing instrument, and acknowledged to me that he executed the same for the purposes and consideration expressed and in the capacity therein stated.

Given under my hand and seal of office, this ____ day of _____, 2022.

Notary public for and in the State of Texas

My commission expires: _____

Planning & Zoning Commission, Chairperson

Date

APPROVED:
I hereby certify that the above and foregoing plat of an addition to the City of Rockwall, Texas be approved by the City Council of the City of Rockwall on ____ day of _____, 2022.

This approval shall be invalid unless the approved plat for such addition is recorded in the office of the County Clerk of Rockwall, County, Texas, within one hundred eighty (180) days from said date of approval.

WITNESS OUR HANDS, this ____ day of _____, 2022.

Mayor, City of Rockwall

City Secretary

City Engineer

FINAL PLAT
MARINA VILLAGE

LOTS 1X, 2-29, 30X, 31X, 32-39 BLOCK A
6.889 ACRES

36 TOWNHOME LOTS AND

4 COMMON AREAS

SITUATED WITHIN THE

EDWARD TEAL SURVEY, ABSTRACT NO. 107

CITY OF ROCKWALL

ROCKWALL COUNTY, TEXAS

P2022-008

October 14, 2022

SHEET 2 OF 2



JOHNSON VOLK
CONSULTING

TBPELS: Engineering Firm No. 11962 / Land Surveying Firm No. 10194033
704 Central Parkway East | Suite 1200 | Plano, TX 75074 | 972.201.3100

Owner/Applicant:

LTL Family Holdings, LLC

William Johnson

14918 Mystic Terrace Lane

Cyprus, Texas 77429

Phone: 713-325-4294

Engineer/Surveyor:

Johnson Volk Consulting, Inc.



704 Central Parkway East, Suite. 1200


Plano, Texas 75074

Phone: 682-225-7189

Contact: Tom Dayton, PE

F:\level 3\projects\2209 - marina villages - townhomes - rockwall\landscapes\2209 - treescape plan.dwg

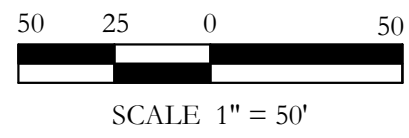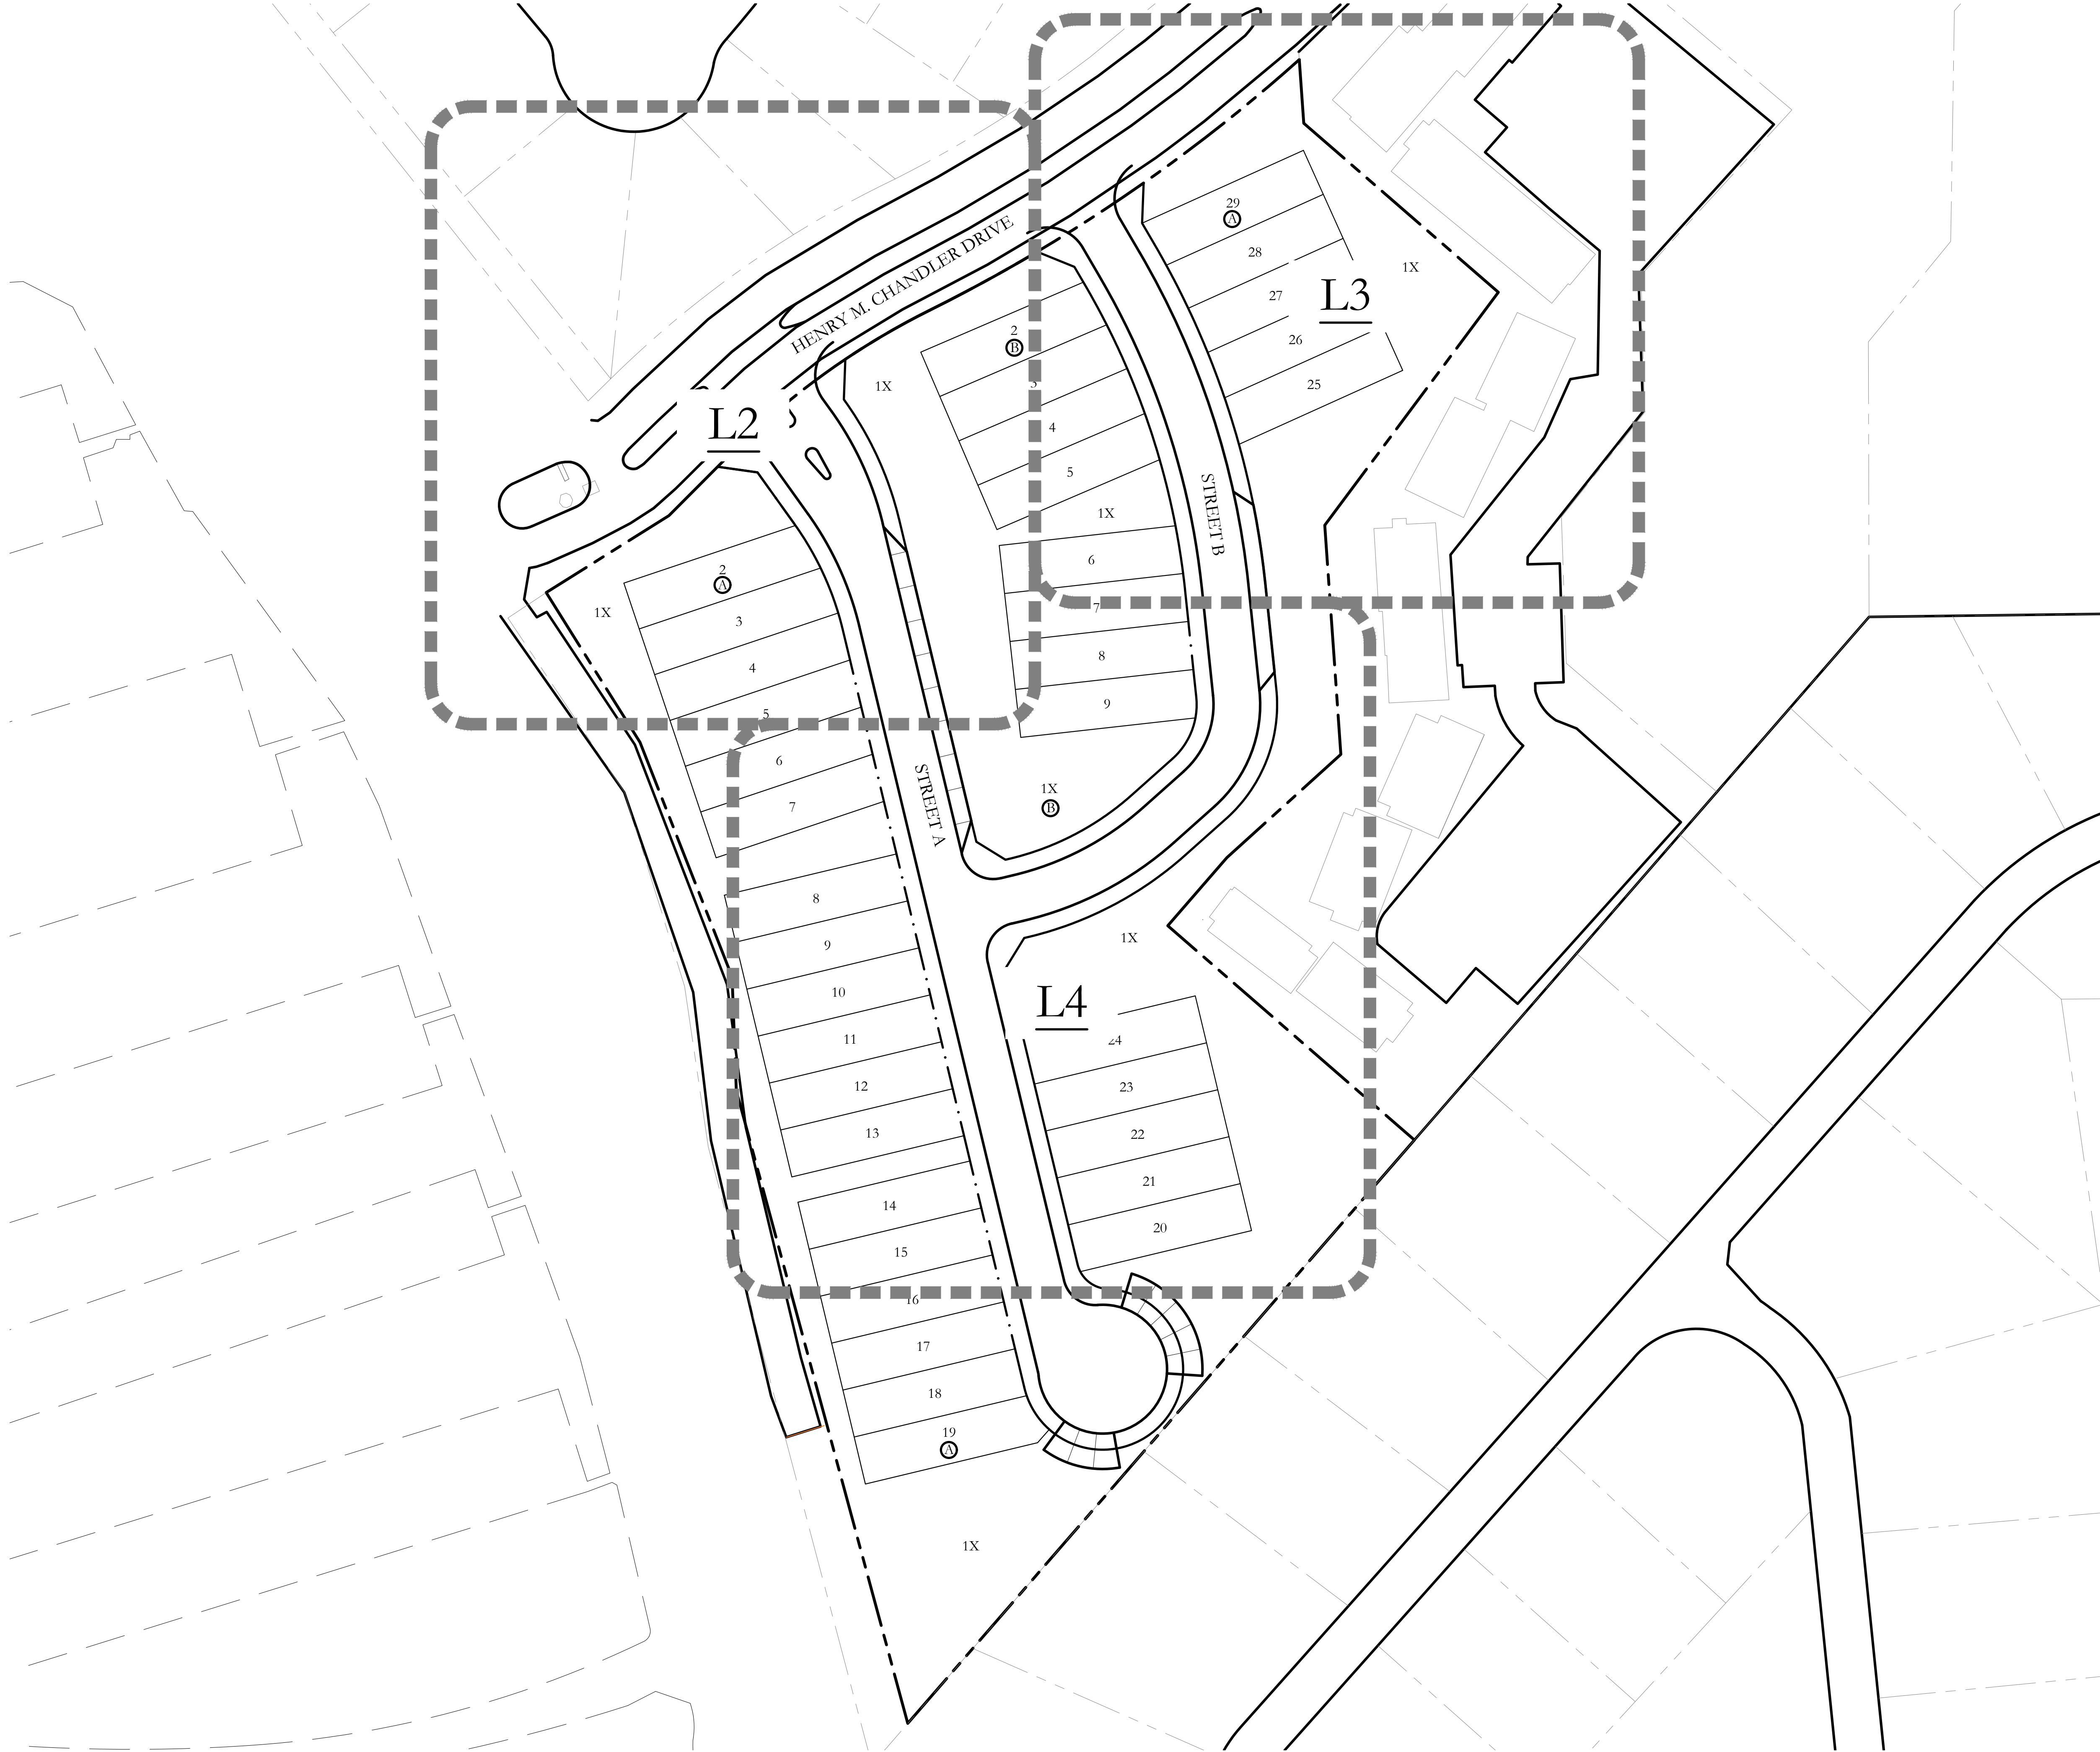

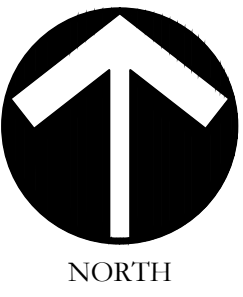


SCALE:
1" = 50'
One Inch
JVC No 2209




TREESCAPE PLAN
OVERALL LAYOUT PLAN


MARINA VILLAGE TOWNHOMES
CITY OF ROCKWALL
ROCKWALL COUNTY, TEXAS

F:\civil 3d projects\2209 - marina villages - townhomes - rockwall\landscaps\2209 - treescape plan.dwg

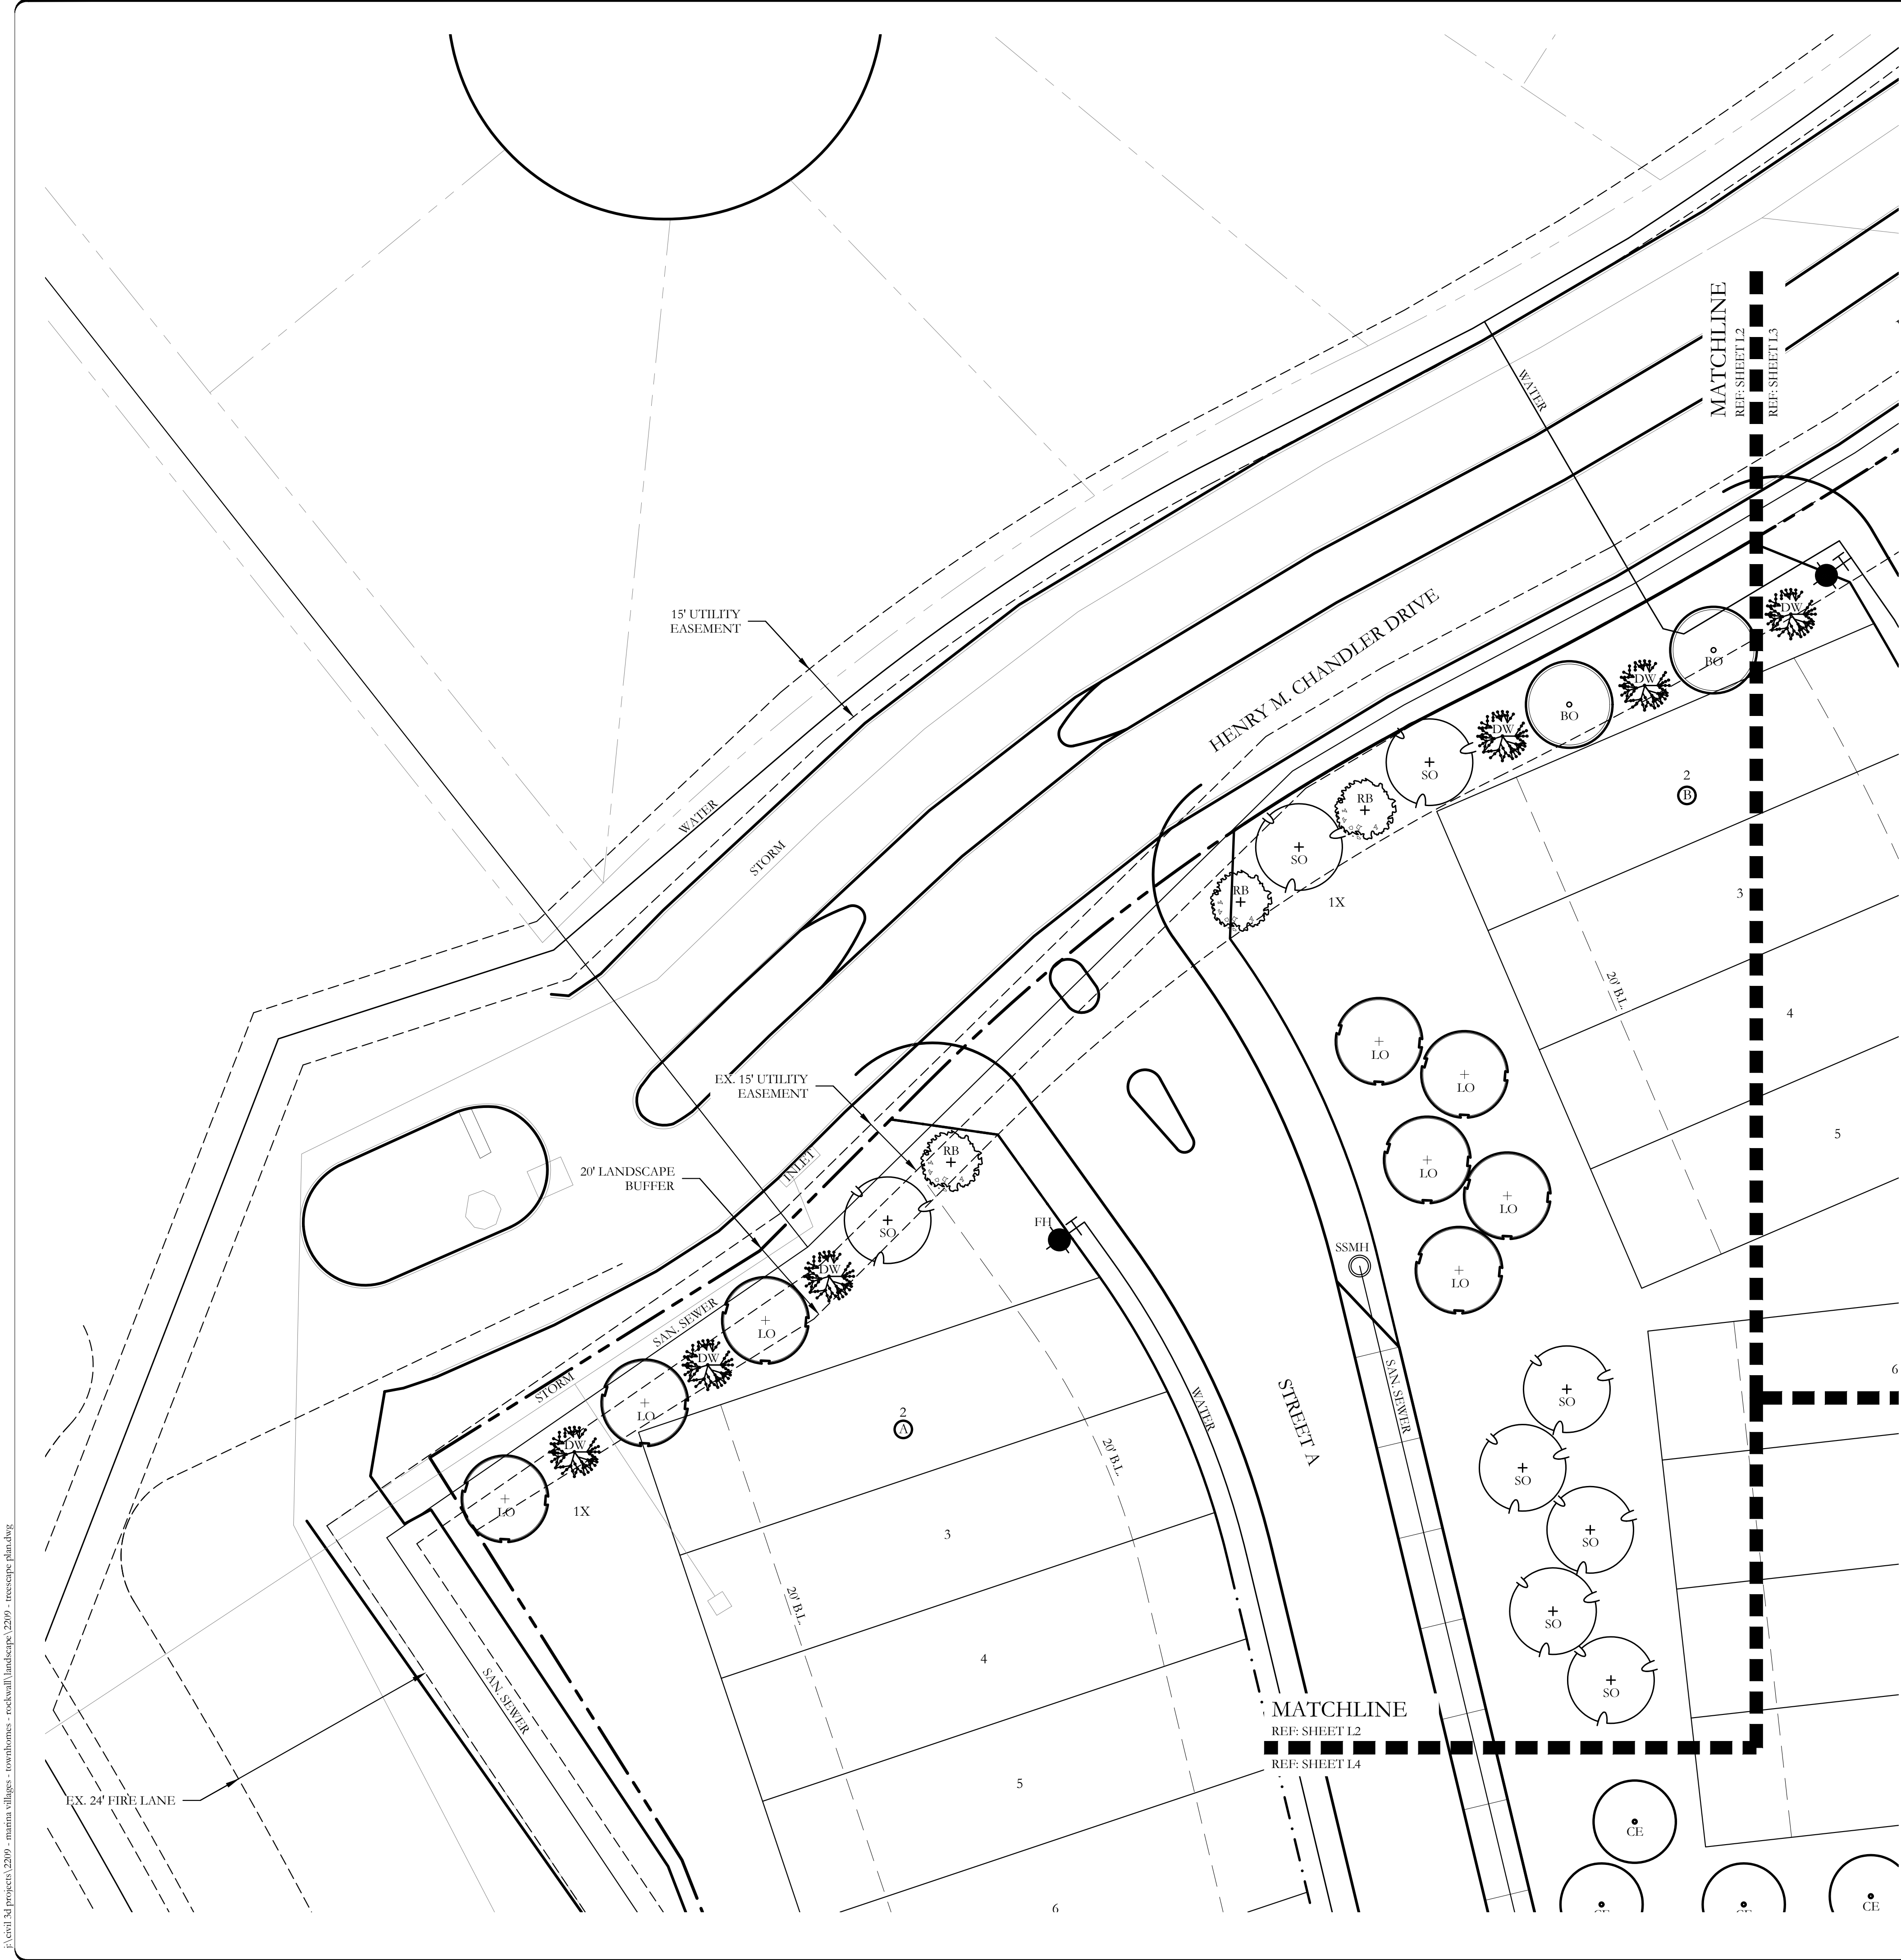


PLANT LEGEND					
SYMBOL	KEY	COMMON NAME	SCIENTIFIC NAME	SIZE	SPACING
	LO	LIVE OAK	QUERCUS VIRGINIANA	4" CALIPER	AS SHOWN
	SO	SHUMARD OAK	QUERCUS SHUMARDII	4" CALIPER	AS SHOWN
	BO	BUR OAK	QUERCUS MACROCARPA	4" CALIPER	AS SHOWN
	CE	CEDAR ELM	ULMUS CRASSIFOLIA	4" CALIPER	AS SHOWN
	DW	DESERT WILLOW	CHILOPSIS LINEARIS	2" CALIPER	AS SHOWN
	RB	TEXAS REDBUD	CERCIS CANADENSIS VAR. TEXENSIS	2" CALIPER	AS SHOWN

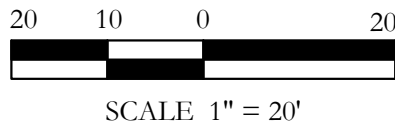


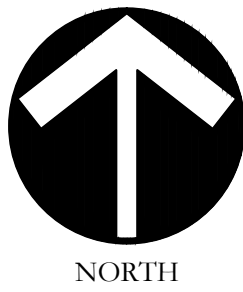

SCALE:
1" = 20'
One Inch
JVC No 2209

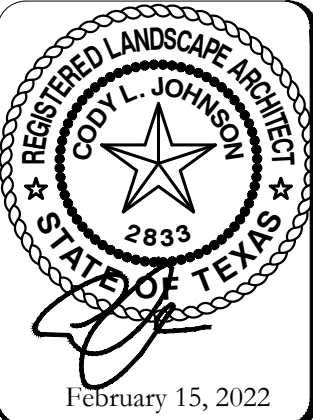



F:\level 3\projects\2209 - marina villages - townhomes - rockwall\landscapes\2209 - treescape plan.dwg

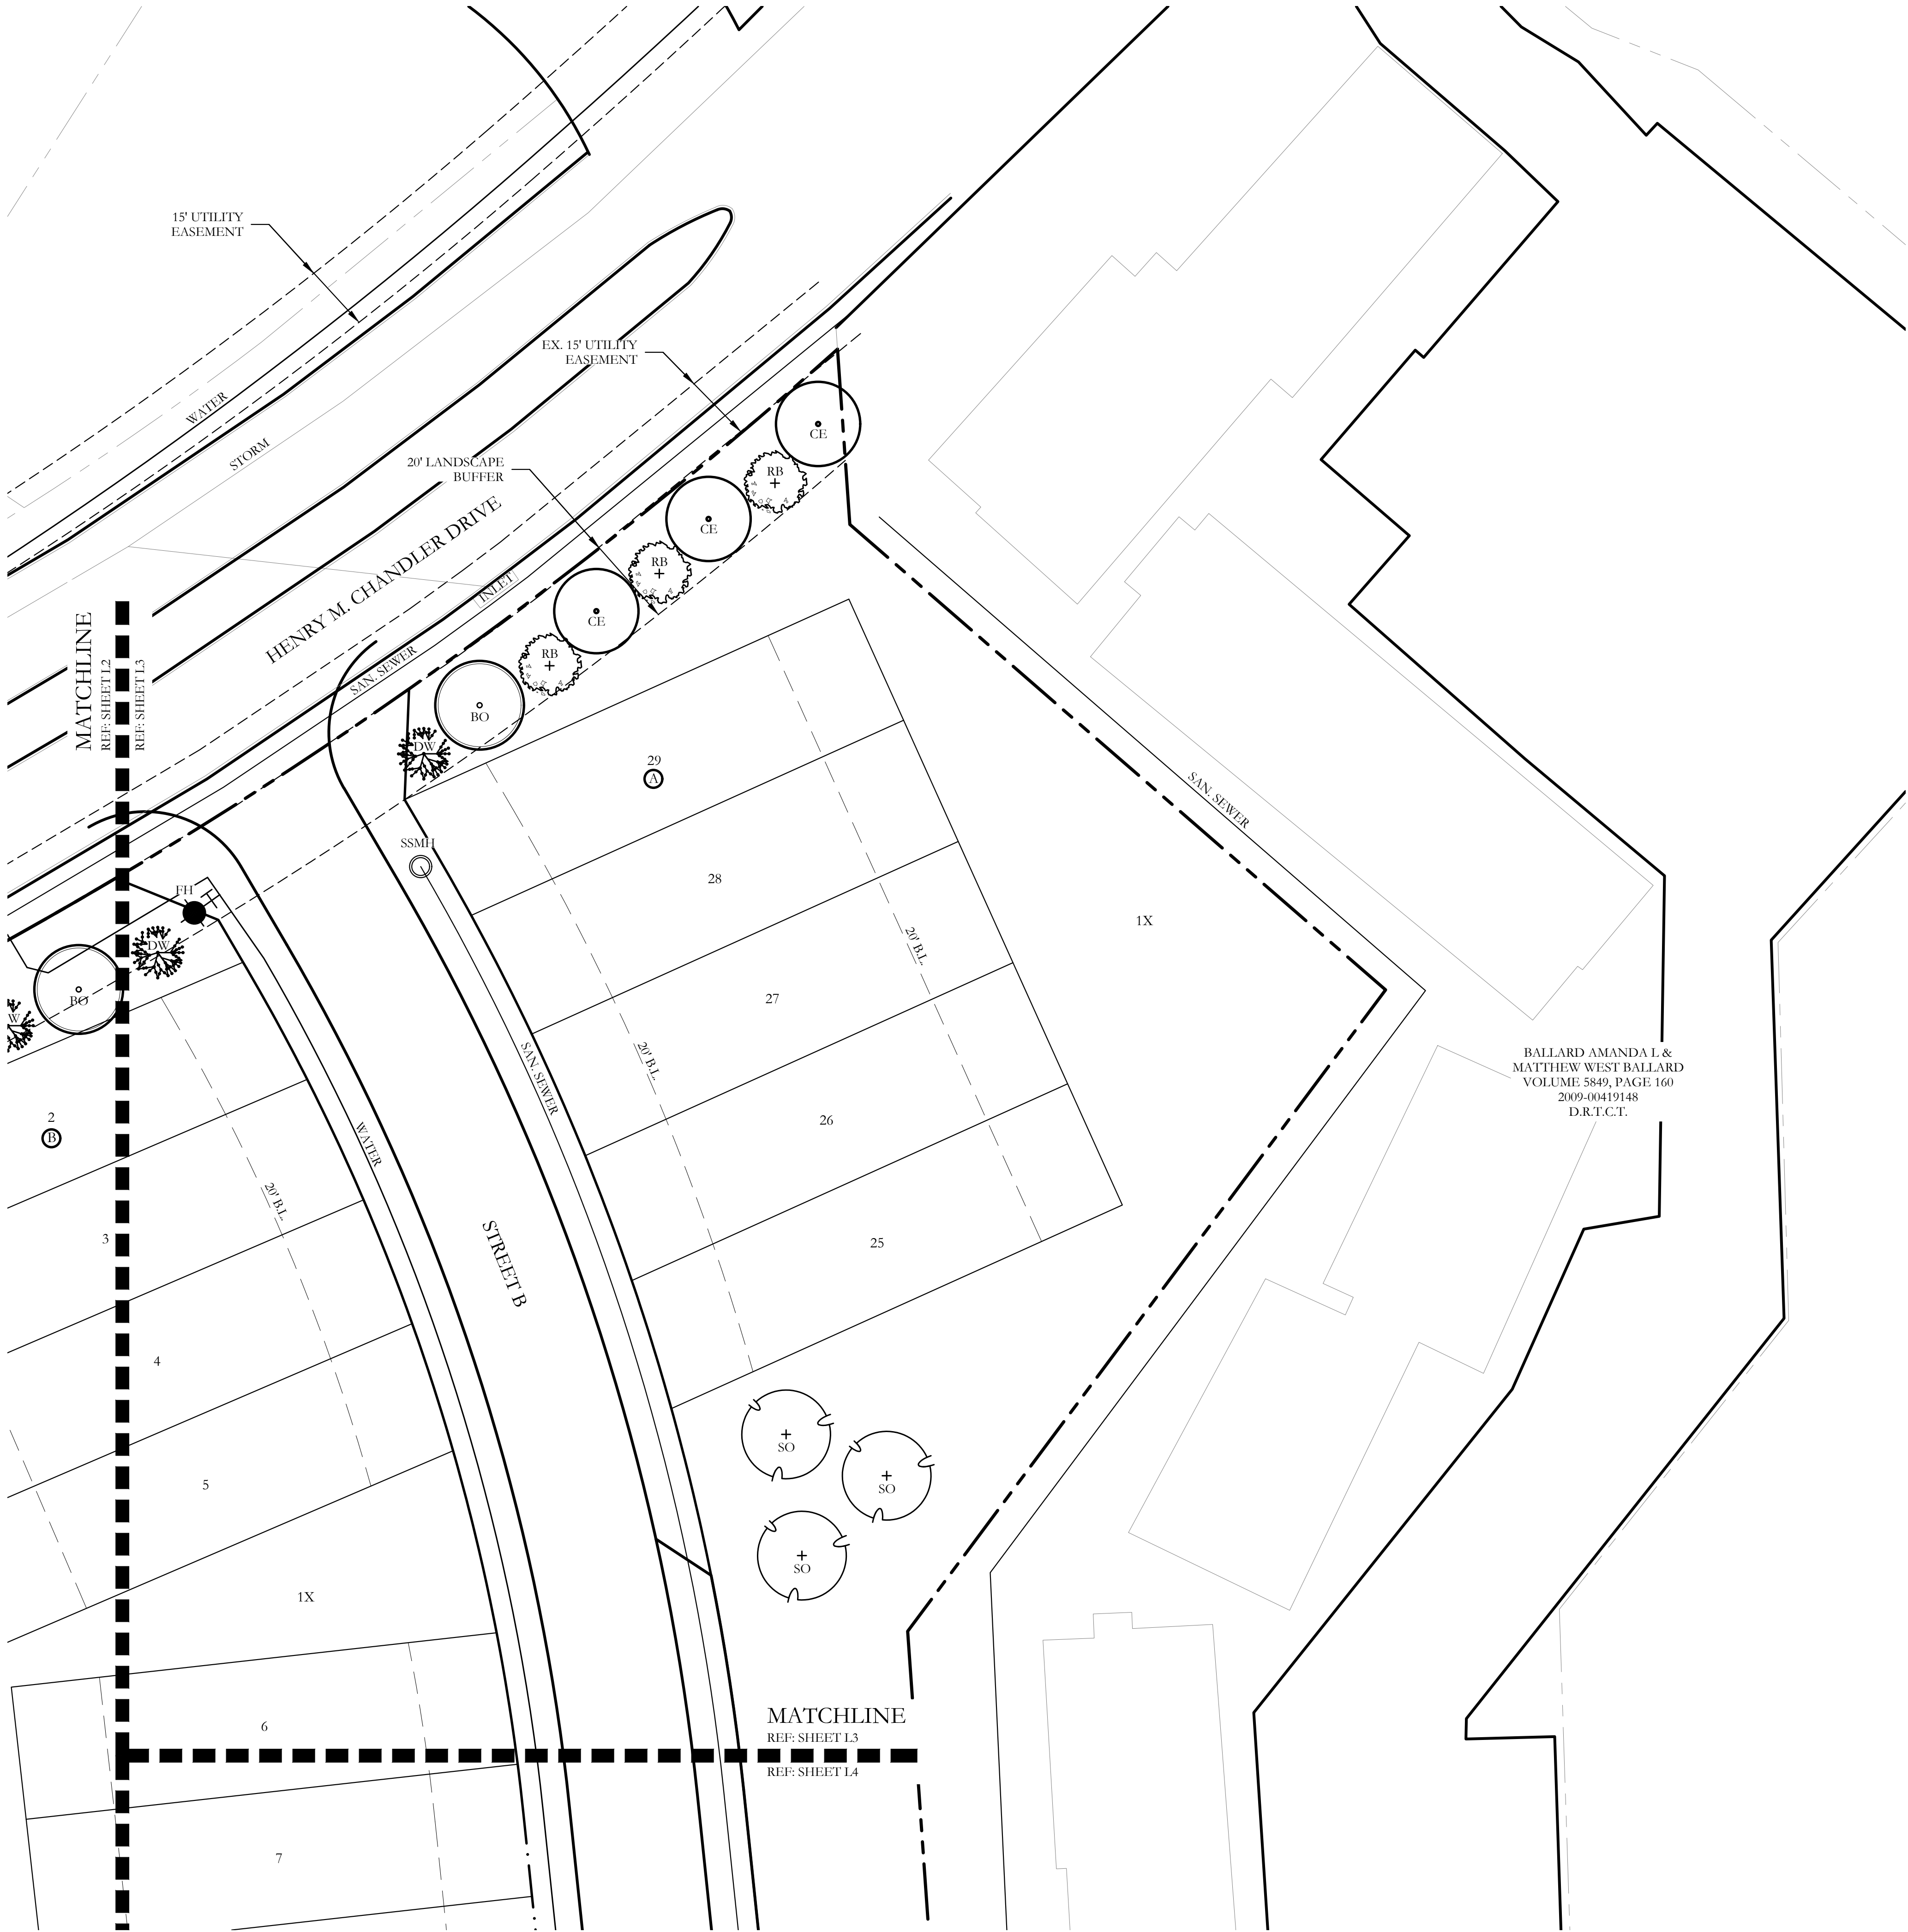


BALLARD AMANDA L &
MATTHEW WEST BALLARD
VOLUME 5849, PAGE 160
2009-00419148
D.R.T.C.T.

PLANT LEGEND					
SYMBOL	KEY	COMMON NAME	SCIENTIFIC NAME	SIZE	SPACING
	LO	LIVE OAK	QUERCUS VIRGINIANA	4" CALIPER	AS SHOWN
	SO	SHUMARD OAK	QUERCUS SHUMARDII	4" CALIPER	AS SHOWN
	BO	BUR OAK	QUERCUS MACROCARPA	4" CALIPER	AS SHOWN
	CE	CEDAR ELM	ULMUS CRASSIFOLIA	4" CALIPER	AS SHOWN
	DW	DESERT WILLOW	CHILOPSIS LINEARIS	2" CALIPER	AS SHOWN
	RB	TEXAS REDBUD	CERCIS CANADENSIS VAR. TEXENSIS	2" CALIPER	AS SHOWN

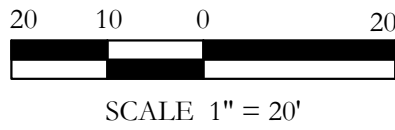

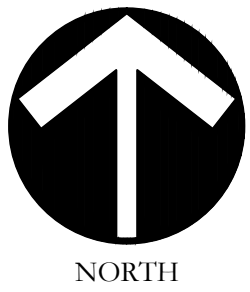

SCALE:
1" = 20'
One Inch
JVC No 2209

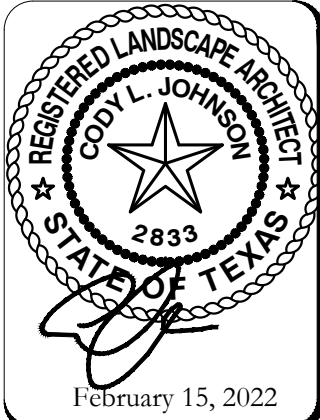

TREESCAPE PLAN
TREESCAPE PLAN

MARINA VILLAGE TOWNHOMES
CITY OF ROCKWALL
ROCKWALL COUNTY, TEXAS

F:\civil 3d projects\2209 - marina villages - townhomes - rockwall\landscape\2209 - treescape planting.dwg

LANDSCAPE PROVIDED

HENRY M. CHANDLER DR.

MINIMUM TEN (10) FOOT LANDSCAPE BUFFER PROVIDED


1 - 4" CAL. CANOPY TREE & 1 ACCENT TREE / 50 LF OF LINEAR FRONTAGE
576 LF OF FRONTAGE / 50 LF = 12 - 4" CAL. TREES & 12 ACCENT TREES REQUIRED.
PROVIDED: 12 - 4" CALIPER CANOPY TREES & 13 ACCENT TREES PROVIDED

TREE MITIGATION

191.5 CAL. INCHES REMOVED

43 - 4" CAL. CANOPY TREES & 13 - 2" CAL. ACCENT TREES = 198 CAL. INCHES REPLACED.

PLANT LIST						
KEY	ESTIMATED QUANTITY	COMMON NAME	SCIENTIFIC NAME	SIZE	SPACING	REMARKS
LO	13	LIVE OAK	QUERCUS VIRGINIANA	4" CALIPER	AS SHOWN	NURSERY GROWN; FULL HEAD; MINIMUM BRANCHING HEIGHT AT 6'-0"; MINIMUM 10'-0" OVERALL HEIGHT.
SO	11	SHUMARD OAK	QUERCUS SHUMARDII	4" CALIPER	AS SHOWN	NURSERY GROWN; FULL HEAD; MINIMUM BRANCHING HEIGHT AT 6'-0"; MINIMUM 10'-0" OVERALL HEIGHT.
BO	8	BUR OAK	QUERCUS MACROCARPA	4" CALIPER	AS SHOWN	NURSERY GROWN; FULL HEAD; MINIMUM BRANCHING HEIGHT AT 6'-0"; MINIMUM 10'-0" OVERALL HEIGHT.
CE	11	CEDAR ELM	ULMUS CRASSIFOLIA	4" CALIPER	AS SHOWN	NURSERY GROWN; FULL HEAD; MINIMUM BRANCHING HEIGHT AT 6'-0"; MINIMUM 10'-0" OVERALL HEIGHT.
DW	7	DESERT WILLOW	CHILOPSIS LINEARIS	2" CALIPER	AS SHOWN	NURSERY GROWN; FULL HEAD; MINIMUM 8'-0" OVERALL HEIGHT.
RB	6	TEXAS REDBUD	CERCIS CANADENSIS VAR. TEXENSIS	2" CALIPER	AS SHOWN	NURSERY GROWN; FULL HEAD; MINIMUM 8'-0" OVERALL HEIGHT.

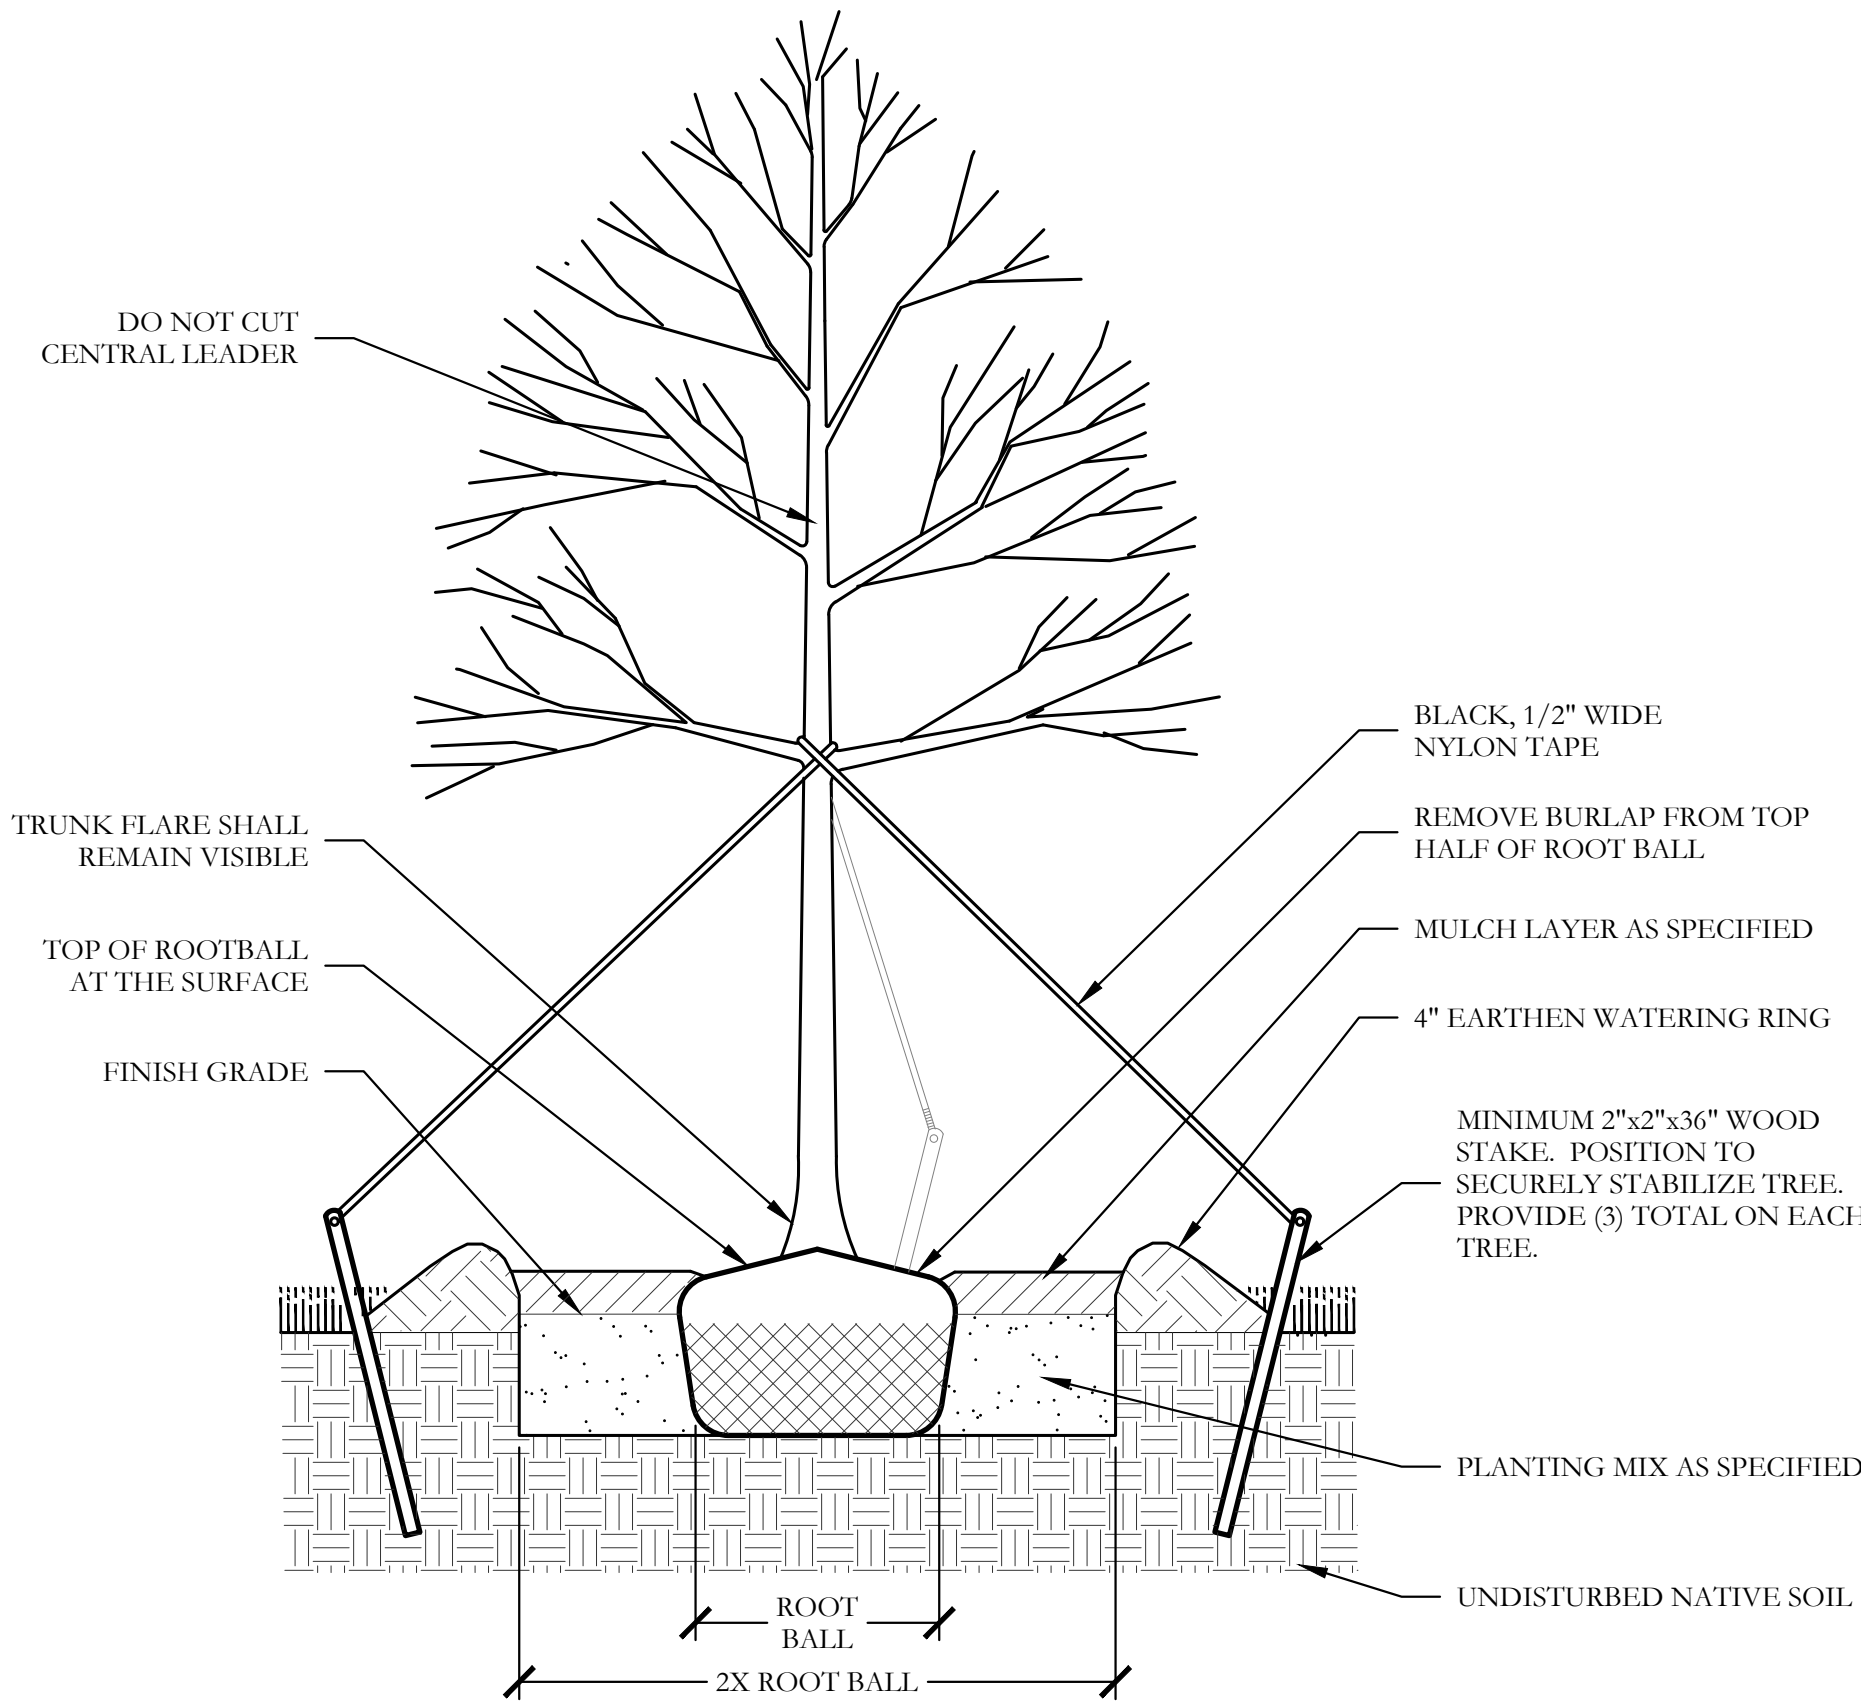

1 TYPICAL TREE PLANTING SECTION NOT TO SCALE

GENERAL LANDSCAPE NOTES

INSPECTIONS:

1. NO EXCAVATION SHALL OCCUR IN CITY R.O.W. WITHOUT A R.O.W. PERMIT--CONTACT THE PUBLIC WORKS DEPARTMENT.
2. THE CONTRACTOR SHALL MARK ALL WATER LINES, SEWER LINES, AND TREE LOCATIONS PRIOR TO CALLING FOR ROW INSPECTION AND PERMIT.
3. THE LANDSCAPE INSTALLATION SHALL COMPLY WITH APPROVED LANDSCAPE DRAWINGS PRIOR TO FINAL ACCEPTANCE BY THE CITY AND ISSUANCE OF A CERTIFICATE OF OCCUPANCY.
4. WATER METERS, CLEANOUTS AND OTHER APPURTENANCES, SHALL BE ACCESSIBLE, ADJUSTED TO GRADE, CLEARLY MARKED WITH FLAGGING AND COMPLIANT WITH PUBLIC WORKS DEPARTMENT STANDARDS PRIOR TO CALLING FOR FINAL LANDSCAPE AND ROW INSPECTIONS.

LANDSCAPE STANDARDS:

1. PLANTINGS AND LANDSCAPE ELEMENTS SHALL COMPLY WITH THE CITY'S ENGINEERING DESIGN STANDARDS, PUBLIC R.O.W. VISIBILITY REQUIREMENTS.
2. UNLESS OTHERWISE SPECIFIED, TREES SHALL BE PLANTED NO LESS THAN 4' FROM CURBS, SIDEWALKS, UTILITY LINES, SCREENING WALLS AND OTHER STRUCTURES. THE CITY HAS FINAL APPROVAL FOR ALL TREE PLACEMENTS.
3. A MINIMUM THREE FEET (3') RADIUS AROUND A FIRE HYDRANT MUST REMAIN CLEAR OF LANDSCAPE PURSUANT TO THE FIRE CODE.
4. STREET TREES, WHERE REQUIRED, SHALL BE (10') MINIMUM FROM THE EDGE OF A STORM SEWER CURB INLET BOX AND THE EDGE OF THE ROOT BALL SHALL BE (4') MINIMUM FROM THE WATER METER.
5. THE AMERICAN STANDARD FOR NURSERY STOCK (ANSI Z60.1-2004) SPECIFICATIONS SHALL GOVERN PLANT QUALIFICATIONS, GRADES, AND STANDARDS.
6. TREE PLANTING SHALL COMPLY WITH DETAILS HEREIN AND THE INTERNATIONAL SOCIETY OF ARBORICULTURE (ISA) STANDARDS.
7. A 2-3" LAYER OF MULCH SHALL BE PROVIDED AROUND THE BASE OF THE PLANTED TREE. THE MULCH SHALL BE PULLED BACK 4" FROM THE TRUNK OF THE TREE.
8. TREE PITS SHALL BE TESTED FOR WATER PERCOLATION. IF WATER DOES NOT DRAIN OUT OF TREE PIT WITHIN 24-HOURS, THE TREE SHALL BE MOVED OR DRAINAGE SHALL BE PROVIDED.
9. ALL BEDS TO HAVE 3" OF COMPOSTED SOIL, LIVING EARTH TECHNOLOGY, OR APPROVED EQUAL TILLED AND TURNED TO A DEPTH OF 8" MINIMUM.
10. ALL PLANT BEDS SHALL BE TOP-DRESSED WITH A MINIMUM OF 3 INCHES OF HARDWOOD MULCH.
11. NATIVE SITE TOPSOIL IS TO BE PROTECTED FROM EROSION OR STOCKPILED. NATIVE SITE TOPSOIL SHALL BE LABORATORY TESTED BY AND ACCREDITED LABORATORY AND AMENDED PER SAID LABORATORY'S RECOMMENDATIONS.

IRRIGATION STANDARDS:

1. ANY CHANGES TO THESE APPROVED IRRIGATION DRAWINGS SHALL BE AUTHORIZED BY THE CITY. CONTACT DEVELOPMENT SERVICES FOR AN IRRIGATION PERMIT PRIOR TO INSTALLING THE IRRIGATION SYSTEM.
2. IRRIGATION OVER-SPRAY ON STREETS AND WALKS IS PROHIBITED.
3. MAINLINES, VALVES, OR CONTROL WIRES SHALL NOT BE LOCATED IN THE CITY'S ROW.
4. ET IRRIGATION CONTROLLERS SHALL BE PROGRAMMED AND ADJUSTED TO NOT EXCEED THE LANDSCAPE WATER ALLOWANCE (LWA) PRIOR TO APPROVAL OF LANDSCAPE INSTALLATION.
5. VALVES SHALL BE LOCATED A MINIMUM OF (3') AWAY FROM STORM SEWERS, AND SANITARY SEWER LINES AND 5 FEET FROM CITY FIRE HYDRANTS AND WATER VALVES.
6. THE BORE DEPTH UNDER STREETS, DRIVE AISLES, AND FIRE LANES SHALL PROVIDE (2') OF CLEARANCE (MINIMUM).
7. IRRIGATION HEADS THAT RUN PARALLEL AND NEAR PUBLIC WATER AND SANITARY SEWER LINES; SHALL BE FED FROM STUBBED LATERALS OR BULL-HEADS. A MINIMUM FIVE FOOT (5') SEPARATION IS REQUIRED BETWEEN IRRIGATION MAIN LINES AND LATERALS THAT RUN PARALLEL TO PUBLIC WATER AND SANITARY SEWER LINES.
8. NO VALVES, BACKFLOW PREVENTION ASSEMBLIES, QUICK COUPLERS ETC. SHALL BE LOCATED CLOSER THAN 10' FROM THE CURB AT STREET OR DRIVE INTERSECTION.


MAINTENANCE STANDARDS:


1. THE OWNER SHALL BE RESPONSIBLE FOR THE ESTABLISHMENT, MAINTENANCE, AND VIGOR OF PLANT MATERIAL IN ACCORDANCE WITH THE DESIGN INTENT AND AS APPROPRIATE FOR THE SEASON OF THE YEAR.
2. LANDSCAPE AND OPEN AREAS SHALL BE FREE OF TRASH, LITTER AND WEEDS.
3. NO PLANT MATERIAL SHALL BE ALLOWED TO ENCROACH ON R.O.W., SIDEWALKS OR EASEMENTS TO THE EXTENT THAT VISION OR ROUTE OF TRAVEL FOR VEHICULAR, PEDESTRIAN, OR BICYCLE TRAFFIC IS IMPEDED.
4. TREE MAINTENANCE SHALL BE IN ACCORDANCE WITH THE STANDARDS OF THE INTERNATIONAL SOCIETY OF ARBORICULTURE.
5. TREE STAKING MATERIALS, IF USED, SHALL BE REMOVED AFTER (1) GROWING SEASON, NO MORE THAN (1) YEAR AFTER INSTALLATION (STEEL TREE STAKES, WIRES, AND HOSES ARE PROHIBITED).

TREE PROTECTION NOTES:


1. CONTACT DEVELOPMENT SERVICES FOR A TREE REMOVAL PERMIT PRIOR TO REMOVAL OR TRANSPLANTING OF ANY TREES.
2. ALL TREES WHICH ARE TO REMAIN ON SITE SHALL BE PROTECTED WITH A (4') TALL, BRIGHTLY COLORED PLASTIC FENCE, OR SILT FENCE, PLACED AT THE DRIP LINE OF THE TREES.
3. PRIOR TO THE PRE-CONSTRUCTION MEETING OR OBTAINING A GRADING PERMIT, ALL TREE MARKINGS AND PROTECTIVE FENCING SHALL BE INSTALLED BY THE OWNER AND BE INSPECTED BY DEVELOPMENT SERVICES.
4. NO EQUIPMENT SHALL BE CLEANED, OR HARMFUL LIQUIDS DEPOSITED WITHIN THE LIMITS OF THE ROOT ZONE OF TREES WHICH REMAIN ON SITE.
5. NO SIGNS, WIRES, OR OTHER ATTACHMENTS SHALL BE ATTACHED TO ANY TREE TO REMAIN ON SITE.
6. VEHICULAR AND CONSTRUCTION EQUIPMENT SHALL NOT PARK OR DRIVE WITHIN THE LIMITS OF THE DRIP LINE.
7. GRADE CHANGES IN EXCESS OF 3 INCHES (CUT OR FILL) SHALL NOT BE ALLOWED WITHIN A ROOT ZONE, UNLESS ADEQUATE TREE PRESERVATION METHODS ARE APPROVED BY THE CITY.
8. NO TRENCHING SHALL BE ALLOWED WITHIN THE DRIP-LINE OF A TREE, UNLESS APPROVED BY THE CITY.
9. ALL REMOVED TREES SHALL BE CHIPPED AND USED FOR MULCH ON SITE OR HAULED OFF-SITE.
10. ALL TREE MAINTENANCE TECHNIQUES SHALL BE IN CONFORMANCE WITH INDUSTRY IDENTIFIED STANDARDS. IMPROPER OR MALICIOUS PRUNING TECHNIQUES ARE STRICTLY PROHIBITED.

F:\civil 3d projects\2209 - marina villages - townhomes - rockwall\landscape\2209 - tree survey plan.dwg

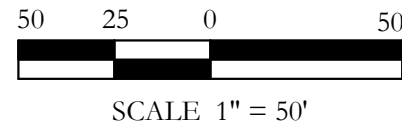

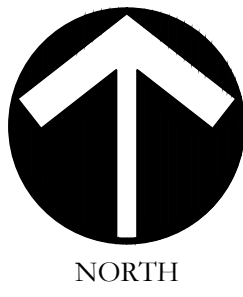

SCALE:
1" = 50'
One Inch
JVC No 2209

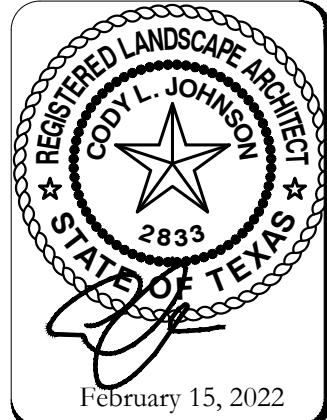

TREE SURVEY PLAN
TREE SURVEY PLAN

MARINA VILLAGE TOWNHOMES
CITY OF ROCKWALL
ROCKWALL COUNTY, TEXAS

F:\civil 3d projects\2209 - marina villages - townhomes - rockwall\landscpe\2209 - tree survey plan.dwg



LEGEND

7

EXISTING TREE TO BE REMOVED

23

EXISTING TREE TO REMAIN

TREE PROTECTION FENCE, TYP.

- TREE PROTECTION NOTES
1.


EXISTING TREES SHOWN TO REMAIN ARE TO BE PROTECTED DURING CONSTRUCTION. ORANGE COATED CHAINLINK FENCING (MIN. 4'-0" HEIGHT) SHALL BE INSTALLED AT THE DRIP LINE OF ALL TREES OR TREE GROUPS TO REMAIN. PARKING OF VEHICLES OR PERFORMING WORK WITHIN THESE AREAS OTHER THAN SHOWN ON THE PLAN, WILL NOT BE ALLOWED. THE TREE PROTECTION SHALL REMAIN DURING CONSTRUCTION. OTHER TREE PROTECTION MEASURES SHALL BE IN ACCORDANCE WITH THE CITY'S STANDARDS AND ORDINANCES.
2.

DISPOSAL OF ANY WASTE MATERIAL SUCH AS, BUT NOT LIMITED TO, PAINT, ASPHALT, OIL SOLVENTS, CONCRETE, MORTAR, ETC. WITHIN THE CANOPY AREA OF THE EXISTING TREES SHALL NOT BE ALLOWED.
3.

NO ATTACHMENTS OR WIRES OF ANY KIND, OTHER THAN THOSE OF A PROTECTIVE NATURE, SHALL BE ATTACHED TO ANY TREE.
4.


NO FILL OR EXCAVATION OF ANY NATURE SHALL OCCUR WITHIN THE DRIP LINE OF A TREE TO BE PRESERVED, UNLESS THERE IS A SPECIFIED WELL OR RETAINING WALL SHOWN ON THE GRADING PLAN.
5.

NO MATERIALS SHALL BE STORED WITHIN THE DRIPLINE AREA OF A TREE TO BE PRESERVED

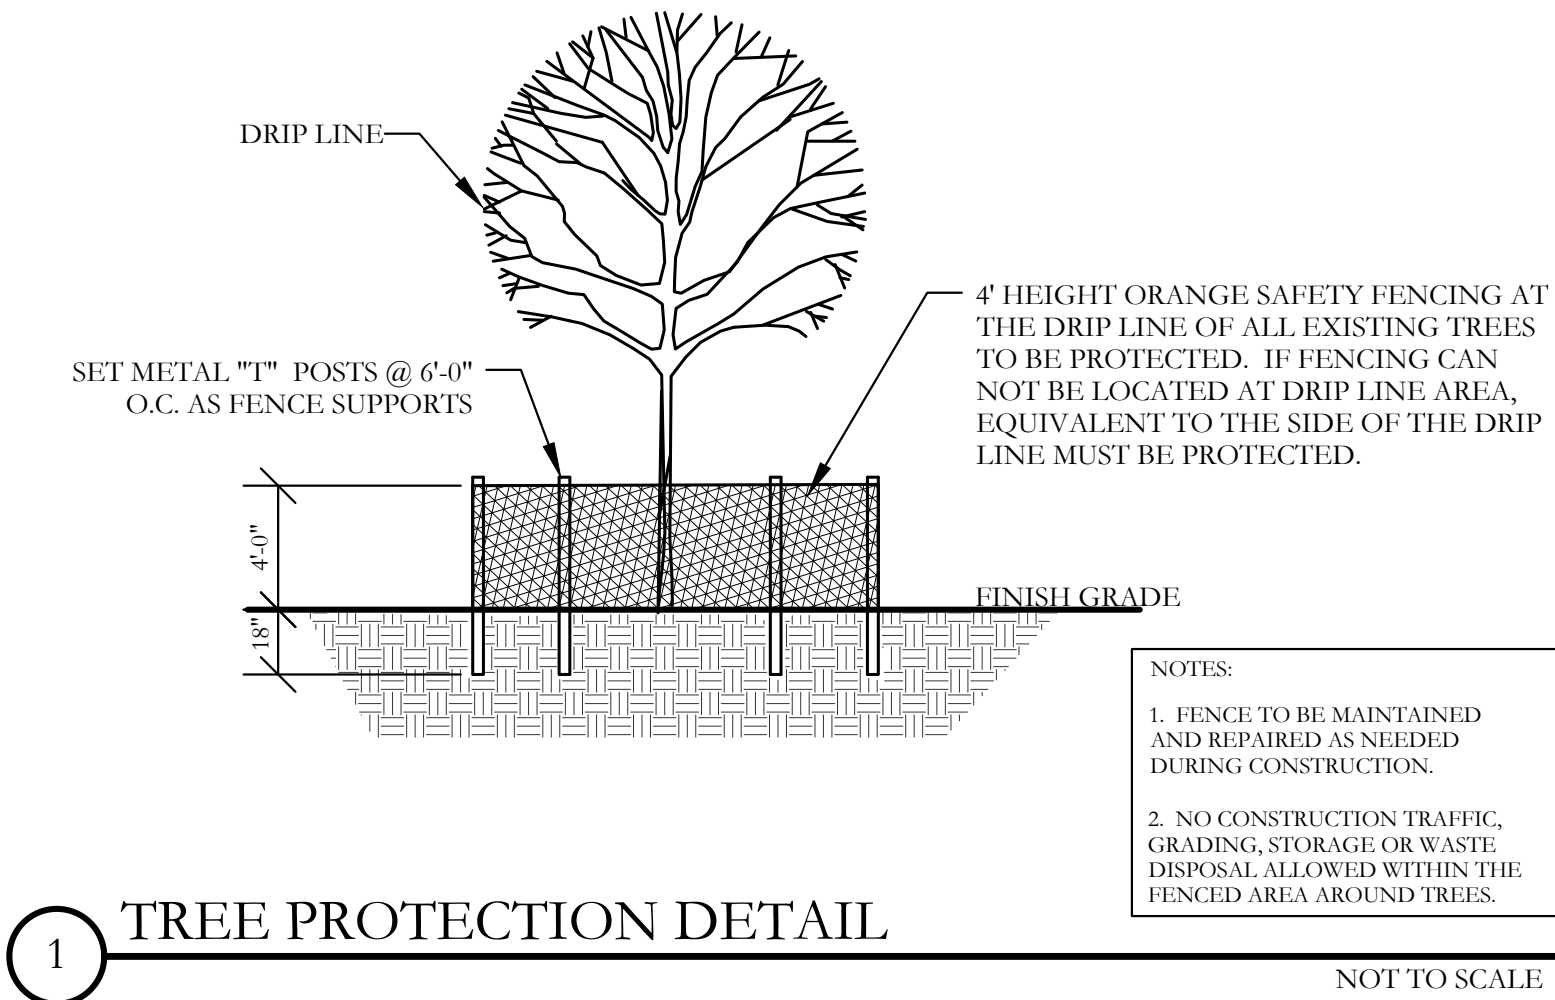

F:\civil 3d projects\2209 - marina villages - townhomes - rockwall\landscape\2209 - tree survey plan.dwg

Tree ID Number	Diameter at Breast Height (DBH) (inches)	Common Name	Scientific Name	Protected Tree?	Condition	Comment	Location	Remove or Remain	Mitigation Required, Percentage	Mitigation Required in Caliper Inches
0	28.0	Mesquite	Prosopis spp.	Yes	Healthy	Multi-trunk		Remove	100%	28.0
1	40.0	Bois d'Arc	Machua pomifera	No	Damaged	Leaning/Fall Hazard		Remove	0%	0.0
2	20.0	Bois d'Arc	Machua pomifera	No	Healthy			Remove	0%	0.0
3	8.0	Hackberry	Celtis occidentalis	No	Healthy			Remove	0%	0.0
4	12.0	Crape Myrtle	Lagerostroemia indica	Yes	Healthy			Remove	100%	12.0
5	8.0	Hackberry	Celtis occidentalis	No	Healthy	Multi-trunk		Remove	0%	0.0
6	14.0	Hackberry	Celtis occidentalis	Yes	Healthy			Remove	50%	7.0
7	14.0	Cedar Elm	Ulmus crassifolia	Yes	Healthy			Remove	100%	14.0
8	9.0	Eastern Red Cedar	Juniperus viginiana	No	Healthy			Remain		0.0
9	12.0	Hackberry	Celtis occidentalis	Yes	Healthy			Remain		0.0
10	19.0	Hackberry	Celtis occidentalis	Yes	Healthy			Remain		0.0
11	44.0	Hackberry	Celtis occidentalis	Yes	Healthy			Remain		0.0
12	21.0	Hackberry	Celtis occidentalis	Yes	Healthy			Remain		0.0
13	11.0	Hackberry	Celtis occidentalis	No	Healthy			Remain		0.0
14	24.0	Hackberry	Celtis occidentalis	Yes	Healthy	Multi-trunk		Remain		0.0
15	34.0	Eastern Red Cedar	Juniperus viginiana	Yes	Healthy	Multi-trunk		Remain		0.0
16	35.0	Eastern Red Cedar	Juniperus viginiana	Yes	Healthy	Multi-trunk		Remain		0.0
17	12.0	Eastern Red Cedar	Juniperus viginiana	Yes	Healthy			Remain		0.0
18	9.0	Eastern Red Cedar	Juniperus viginiana	No	Healthy			Remain		0.0
19	29.0	Bois d'Arc	Machua pomifera	No	Healthy	Multi-trunk		Remain		0.0
20	10.0	Eastern Red Cedar	Juniperus viginiana	No	Healthy			Remain		0.0
21	12.0	Green Ash	Fraxinus pennsylvanica	Yes	Healthy			Remain		0.0
22	10.0	Eastern Red Cedar	Juniperus viginiana	No	Healthy			Remain		0.0
23	9.0	Eastern Red Cedar	Juniperus viginiana	No	Healthy			Remain		0.0
24	15.0	Hackberry	Celtis occidentalis	Yes	Healthy			Remain		0.0
25	8.0	Eastern Red Cedar	Juniperus viginiana	No	Healthy			Remain		0.0
26	7.0	Hackberry	Celtis occidentalis	No	Healthy			Remain		0.0
27	29.0	Eastern Red Cedar	Juniperus viginiana	Yes	Healthy	Multi-trunk		Remain		0.0
28	12.0	Hackberry	Celtis occidentalis	Yes	Healthy			Remain		0.0
29	21.0	Green Ash	Fraxinus pennsylvanica	Yes	Healthy	Multi-trunk		Remain		0.0
30	7.0	Green Ash	Fraxinus pennsylvanica	Yes	Healthy	Multi-trunk		Remain		0.0
31	20.0	Hackberry	Celtis occidentalis	Yes	Healthy			Remove	50%	10.0
32	24.0	Eastern Red Cedar	Juniperus viginiana	Yes	Healthy	Multi-trunk		Remove	50%	12.0
33	23.0	Hackberry	Celtis occidentalis	Yes	Healthy	Multi-trunk		Remove	50%	11.5
34	9.0	Hackberry	Celtis occidentalis	No	Healthy			Remove	0%	0.0
35	20.0	Hackberry	Celtis occidentalis	Yes	Healthy	Multi-trunk		Remove	50%	10.0
36	24.0	Green Ash	Fraxinus pennsylvanica	Yes	Healthy	Multi-trunk		Remove	100%	24.0
37	12.0	Hackberry	Celtis occidentalis	Yes	Healthy			Remove	50%	6.0
38	21.0	Hackberry	Celtis occidentalis	Yes	Healthy	Multi-trunk		Remove	50%	10.5
39	19.0	Hackberry	Celtis occidentalis	Yes	Healthy			Remove	50%	9.5
40	21.0	Hackberry	Celtis occidentalis	Yes	Healthy			Remove	50%	10.5
41	24.0	Hackberry	Celtis occidentalis	Yes	Healthy	Multi-trunk		Remove	50%	12.0
42	17.0	Hackberry	Celtis occidentalis	Yes	Healthy			Remove	50%	8.5
43	12.0	Hackberry	Celtis occidentalis	Yes	Healthy			Remove	50%	6.0
										191.5
	Total Tree Population									Total Tree Replacement, caliper inches

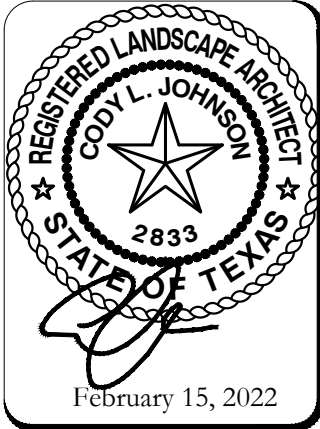

SCALE:

One Inch

JVC No 2209

MARINA VILLAGE TOWNHOMES
CITY OF ROCKWALL
ROCKWALL COUNTY, TEXAS

JOHNSON VOLK
CONSULTING

TBPELS Engineering Firm No. 11962 / Land Surveying Firm No. 10194033
704 Central Parkway East | Suite 1200 | Plano, TX 75074 | 972.201.3100

Mapcheck 1: MARINA VILLAGE

Closure Summary

Precision, 1 part in: 1438904.41'
Error distance: 0.00'
Error direction: S23°37'10.02"W
Area: 300075.68 Sq. Ft.
Square area: 300075.68
Perimeter: 2677.88'

Point of Beginning

Easting: 2588822.58'
Northing: 7007539.35'

Side 1: Line

Direction: S04°01'18"E
Angle: [-004.02 (d)]
Deflection angle: [175.98 (d)]
Distance: 39.64'
Easting: 2588825.36'
Northing: 7007499.81'

Side 2: Line

Direction: S49°01'18"E
Angle: [135.00 (d)]
Deflection angle: [-045.00 (d)]
Distance: 160.16'
Easting: 2588946.28'
Northing: 7007394.78'

Side 3: Line

Direction: S36°41'52"W
Angle: [-094.28 (d)]
Deflection angle: [085.72 (d)]
Distance: 180.50'
Easting: 2588838.41'
Northing: 7007250.06'

Side 4: Line

Direction: S04°01'18"E
Angle: [139.28 (d)]
Deflection angle: [-040.72 (d)]
Distance: 142.73'
Easting: 2588848.42'
Northing: 7007107.68'

Side 5: Line

Direction: S47°49'42"W
Angle: [-128.15 (d)]
Deflection angle: [051.85 (d)]

Distance: 95.59'
Easting: 2588777.58'
Northing: 7007043.50'

Side 6: Line

Direction: S40°58'42"W
Angle: [173.15 (d)]
Deflection angle: [-006.85 (d)]
Distance: 56.00'
Easting: 2588740.85'
Northing: 7007001.23'

Side 7: Line

Direction: S49°01'18"E
Angle: [090.00 (d)]
Deflection angle: [-090.00 (d)]
Distance: 203.00'
Easting: 2588894.11'
Northing: 7006868.10'

Side 8: Line

Direction: S40°58'42"W
Angle: [-090.00 (d)]
Deflection angle: [090.00 (d)]
Distance: 480.10'
Easting: 2588579.27'
Northing: 7006505.65'

Side 9: Line

Direction: N15°09'39"W
Angle: [-056.14 (d)]
Deflection angle: [123.86 (d)]
Distance: 407.29'
Easting: 2588472.76'
Northing: 7006898.76'

Side 10: Line

Direction: N02°08'12"W
Angle: [-166.98 (d)]
Deflection angle: [013.02 (d)]
Distance: 70.75'
Easting: 2588470.12'
Northing: 7006969.46'

Side 11: Line

Direction: N21°26'12"W
Angle: [160.70 (d)]
Deflection angle: [-019.30 (d)]
Distance: 156.54'

Easting: 2588412.91'
Northing: 7007115.18'

Side 12: Line

Direction: N32°04'21"W
Angle: [169.36 (d)]
Deflection angle: [-010.64 (d)]
Distance: 109.80'
Easting: 2588354.60'
Northing: 7007208.22'

Side 13: Line

Direction: N57°55'37"E
Angle: [-090.00 (d)]
Deflection angle: [090.00 (d)]
Distance: 90.00'
Easting: 2588430.87'
Northing: 7007256.01'

Side 14: Line

Direction: N44°54'57"E
Angle: [166.99 (d)]
Deflection angle: [-013.01 (d)]
Distance: 54.37'
Easting: 2588469.26'
Northing: 7007294.51'

Side 15: Curve

Curve direction: Clockwise
Radius: [471.20']
Arc length: 153.06'
Delta angle: 018.61 (d)
Tangent: [77.21']
Chord direction: N54°13'19"E
Chord angle: [-170.69 (d)]
Deflection angle: [009.31 (d)]
Chord distance: 152.39'
Easting: 2588592.89'
Northing: 7007383.60'

Side 16: Curve

Curve direction: Counter-clockwise
Radius: [1039.99']
Arc length: 278.35'
Delta angle: 015.34 (d)
Tangent: [140.01']
Chord direction: N55°51'37"E
Chord angle: [172.33 (d)]

Deflection angle: [-007.67 (d)]

Chord distance: 277.52'

Easting: 2588822.58'

Northing: 7007539.35'



DEVELOPMENT APPLICATION

City of Rockwall
Planning and Zoning Department
385 S. Goliad Street
Rockwall, Texas 75087

STAFF USE ONLY

PLANNING & ZONING CASE NO.

B022-056

NOTE: THE APPLICATION IS NOT CONSIDERED ACCEPTED BY THE CITY UNTIL THE PLANNING DIRECTOR AND CITY ENGINEER HAVE SIGNED BELOW.

DIRECTOR OF PLANNING:

CITY ENGINEER:

PLEASE CHECK THE APPROPRIATE BOX BELOW TO INDICATE THE TYPE OF DEVELOPMENT REQUEST [SELECT ONLY ONE BOX]:

PLATTING APPLICATION FEES:

- ☐ MASTER PLAT (\$100.00 + \$15.00 ACRE) ¹
- ☐ PRELIMINARY PLAT (\$200.00 + \$15.00 ACRE) ¹
- ☒ FINAL PLAT (\$300.00 + \$20.00 ACRE) ¹
- ☐ REPLAT (\$300.00 + \$20.00 ACRE) ¹
- ☐ AMENDING OR MINOR PLAT (\$150.00)
- ☐ PLAT REINSTATEMENT REQUEST (\$100.00)

SITE PLAN APPLICATION FEES:

- ☐ SITE PLAN (\$250.00 + \$20.00 ACRE) ¹
- ☐ AMENDED SITE PLAN/ELEVATIONS/LANDSCAPING PLAN (\$100.00)

ZONING APPLICATION FEES:

- ☐ ZONING CHANGE (\$200.00 + \$15.00 ACRE) ¹
- ☐ SPECIFIC USE PERMIT (\$200.00 + \$15.00 ACRE) ^{1 & 2}
- ☐ PD DEVELOPMENT PLANS (\$200.00 + \$15.00 ACRE) ¹

OTHER APPLICATION FEES:

- ☐ TREE REMOVAL (\$75.00)
- ☐ VARIANCE REQUEST/SPECIAL EXCEPTIONS (\$100.00) ²

NOTES:

¹: IN DETERMINING THE FEE, PLEASE USE THE EXACT ACREAGE WHEN MULTIPLYING BY THE PER ACRE AMOUNT. FOR REQUESTS ON LESS THAN ONE ACRE, ROUND UP TO ONE (1) ACRE.

²: A \$1,000.00 FEE WILL BE ADDED TO THE APPLICATION FEE FOR ANY REQUEST THAT INVOLVES CONSTRUCTION WITHOUT OR NOT IN COMPLIANCE TO AN APPROVED BUILDING PERMIT.

PROPERTY INFORMATION [PLEASE PRINT]

ADDRESS A0207 E Teal, Tract 134-12, Acres 2.564 Prop ID# 30591; Spyglass Hill #4, Block A, Lot 4, Acres 4.316 Prop ID# 29883

SUBDIVISION Marina Village

LOT

BLOCK

GENERAL LOCATION Henry M Chandler Dr, Behind Marina

ZONING, SITE PLAN AND PLATTING INFORMATION [PLEASE PRINT]

CURRENT ZONING PD-8, Ord No. 21-38

CURRENT USE

PROPOSED ZONING PD-8, Ord No. 21-38

PROPOSED USE Multi-Family Residential

ACREAGE 6.889

LOTS [CURRENT] 1

LOTS [PROPOSED] 36

- ☐ **SITE PLANS AND PLATS:** BY CHECKING THIS BOX YOU ACKNOWLEDGE THAT DUE TO THE PASSAGE OF HB3167 THE CITY NO LONGER HAS FLEXIBILITY WITH REGARD TO ITS APPROVAL PROCESS, AND FAILURE TO ADDRESS ANY OF STAFF'S COMMENTS BY THE DATE PROVIDED ON THE DEVELOPMENT CALENDAR WILL RESULT IN THE DENIAL OF YOUR CASE.

OWNER/APPLICANT/AGENT INFORMATION [PLEASE PRINT/CHECK THE PRIMARY CONTACT/ORIGINAL SIGNATURES ARE REQUIRED]

☐ OWNER LTL Family Holdings, LLC

☐ APPLICANT Michael Joyce Properties

CONTACT PERSON William Johnson

CONTACT PERSON Ryan Joyce

ADDRESS 14918 Mystic Terrace Lane

ADDRESS 767 Justin Road

CITY, STATE & ZIP Cypress, TX 77429

CITY, STATE & ZIP Rockwall, TX 75087

PHONE

PHONE

512-965-6280

E-MAIL

E-MAIL

ryan@michaeljoyceproperties.com

NOTARY VERIFICATION [REQUIRED]


BEFORE ME, THE UNDERSIGNED AUTHORITY, ON THIS DAY PERSONALLY APPEARED William Johnson [OWNER] THE UNDERSIGNED, WHO STATED THE INFORMATION ON THIS APPLICATION TO BE TRUE AND CERTIFIED THE FOLLOWING:

"I HEREBY CERTIFY THAT I AM THE OWNER FOR THE PURPOSE OF THIS APPLICATION; ALL INFORMATION SUBMITTED HEREIN IS TRUE AND CORRECT; AND THE APPLICATION FEE OF \$ 437.78 TO COVER THE COST OF THIS APPLICATION, HAS BEEN PAID TO THE CITY OF ROCKWALL ON THIS THE 14 DAY OF October, 2022. BY SIGNING THIS APPLICATION, I AGREE THAT THE CITY OF ROCKWALL (I.E. "CITY") IS AUTHORIZED AND PERMITTED TO PROVIDE INFORMATION CONTAINED WITHIN THIS APPLICATION TO THE PUBLIC. THE CITY IS ALSO AUTHORIZED AND PERMITTED TO REPRODUCE ANY COPYRIGHTED INFORMATION SUBMITTED IN CONJUNCTION WITH THIS APPLICATION, IF SUCH REPRODUCTION IS ASSOCIATED OR IN RESPONSE TO A REQUEST FOR PUBLIC INFORMATION."

GIVEN UNDER MY HAND AND SEAL OF OFFICE ON THIS THE 14 DAY OF October, 2022.

OWNER'S SIGNATURE

NOTARY PUBLIC IN AND FOR THE STATE OF TEXAS

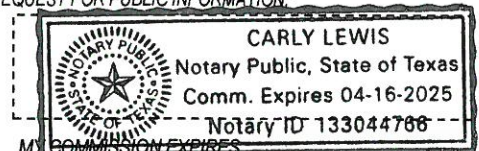

4-16-25




City of Rockwall

Planning & Zoning Department
385 S. Goliad Street
Rockwall, Texas 75032
(P): (972) 771-7745
(W): www.rockwall.com

The City of Rockwall GIS maps are continually under development and therefore subject to change without notice. While we endeavor to provide timely and accurate information, we make no guarantees. The City of Rockwall makes no warranty, express or implied, including warranties of merchantability and fitness for a particular purpose. Use of the information is the sole responsibility of the user.



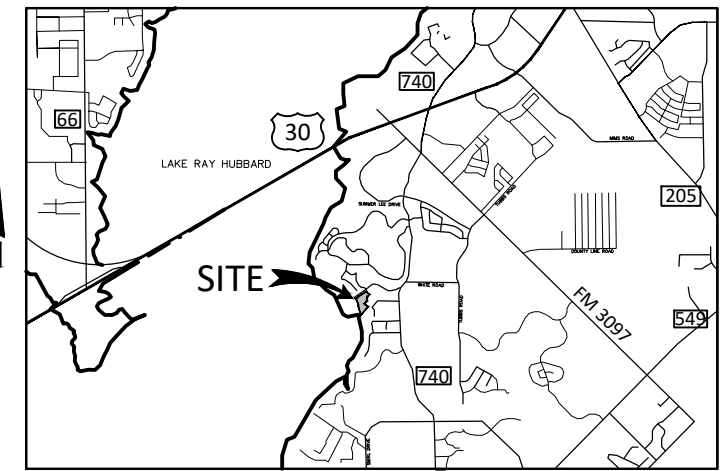

VICINITY MAP
N.T.S.


LEGEND

- Point of Curvature or Tangency on Center Line
- 1/2" Iron rod set with a yellow plastic cap stamped "JVC" (unless otherwise noted)
- 1/2" IRF (unless otherwise noted)

AC	Acre
BL	Building Line
C1	Curve No.
<CM>	Control Monument
DE	Drainage Easement
WLE	Water Line Easement
SSE	Sanitary Sewer Easement
Esmt	Easement
L1	Line No.
SF	Square Feet
UE	Utility Easement
PE	Pedestrian Easement
PUDE	Pedestrian, Utility & Drainage Easement
VAM	Visibility Easement

D.R.R.C.T.= Deed Records of Rockwall County, Texas
P.R.R.C.T.= Plat Records of Rockwall County, Texas
M.R.R.C.T.= Map Records of Rockwall County, Texas
O.R.R.C.T.= Official Records of Rockwall County, Texas

Easement Abandonment

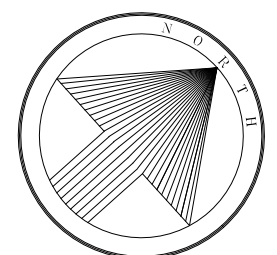

SCALE 1" = 60'

FINAL PLAT MARINA VILLAGE

LOTS 1X, 2-29, 30X, 31X, 32-39 BLOCK A
6.889 ACRES

36 TOWNHOME LOTS AND
4 COMMON AREAS
SITUATED WITHIN THE
EDWARD TEAL SURVEY, ABSTRACT NO. 207
CITY OF ROCKWALL
ROCKWALL COUNTY, TEXAS


P2022-008
October 14, 2022
SHEET 1 OF 2



JBPELS: Engineering Firm No. 11962 / Land Surveying Firm No. 10194033
704 Central Parkway East | Suite 1200 | Plano, TX 75074 | 972.201.3100

Owner/Applicant:
LTL Family Holdings, LLC
William Johnson
14918 Mystic Terrace Lane
Cyprus, Texas 77429
Phone: 713-325-4294

Engineer/Surveyor:
Johnson Volk Consulting, Inc.
704 Central Parkway East, Suite. 1200
Plano, Texas 75074
Phone: 682-225-7189
Contact: Tom Dayton, PE

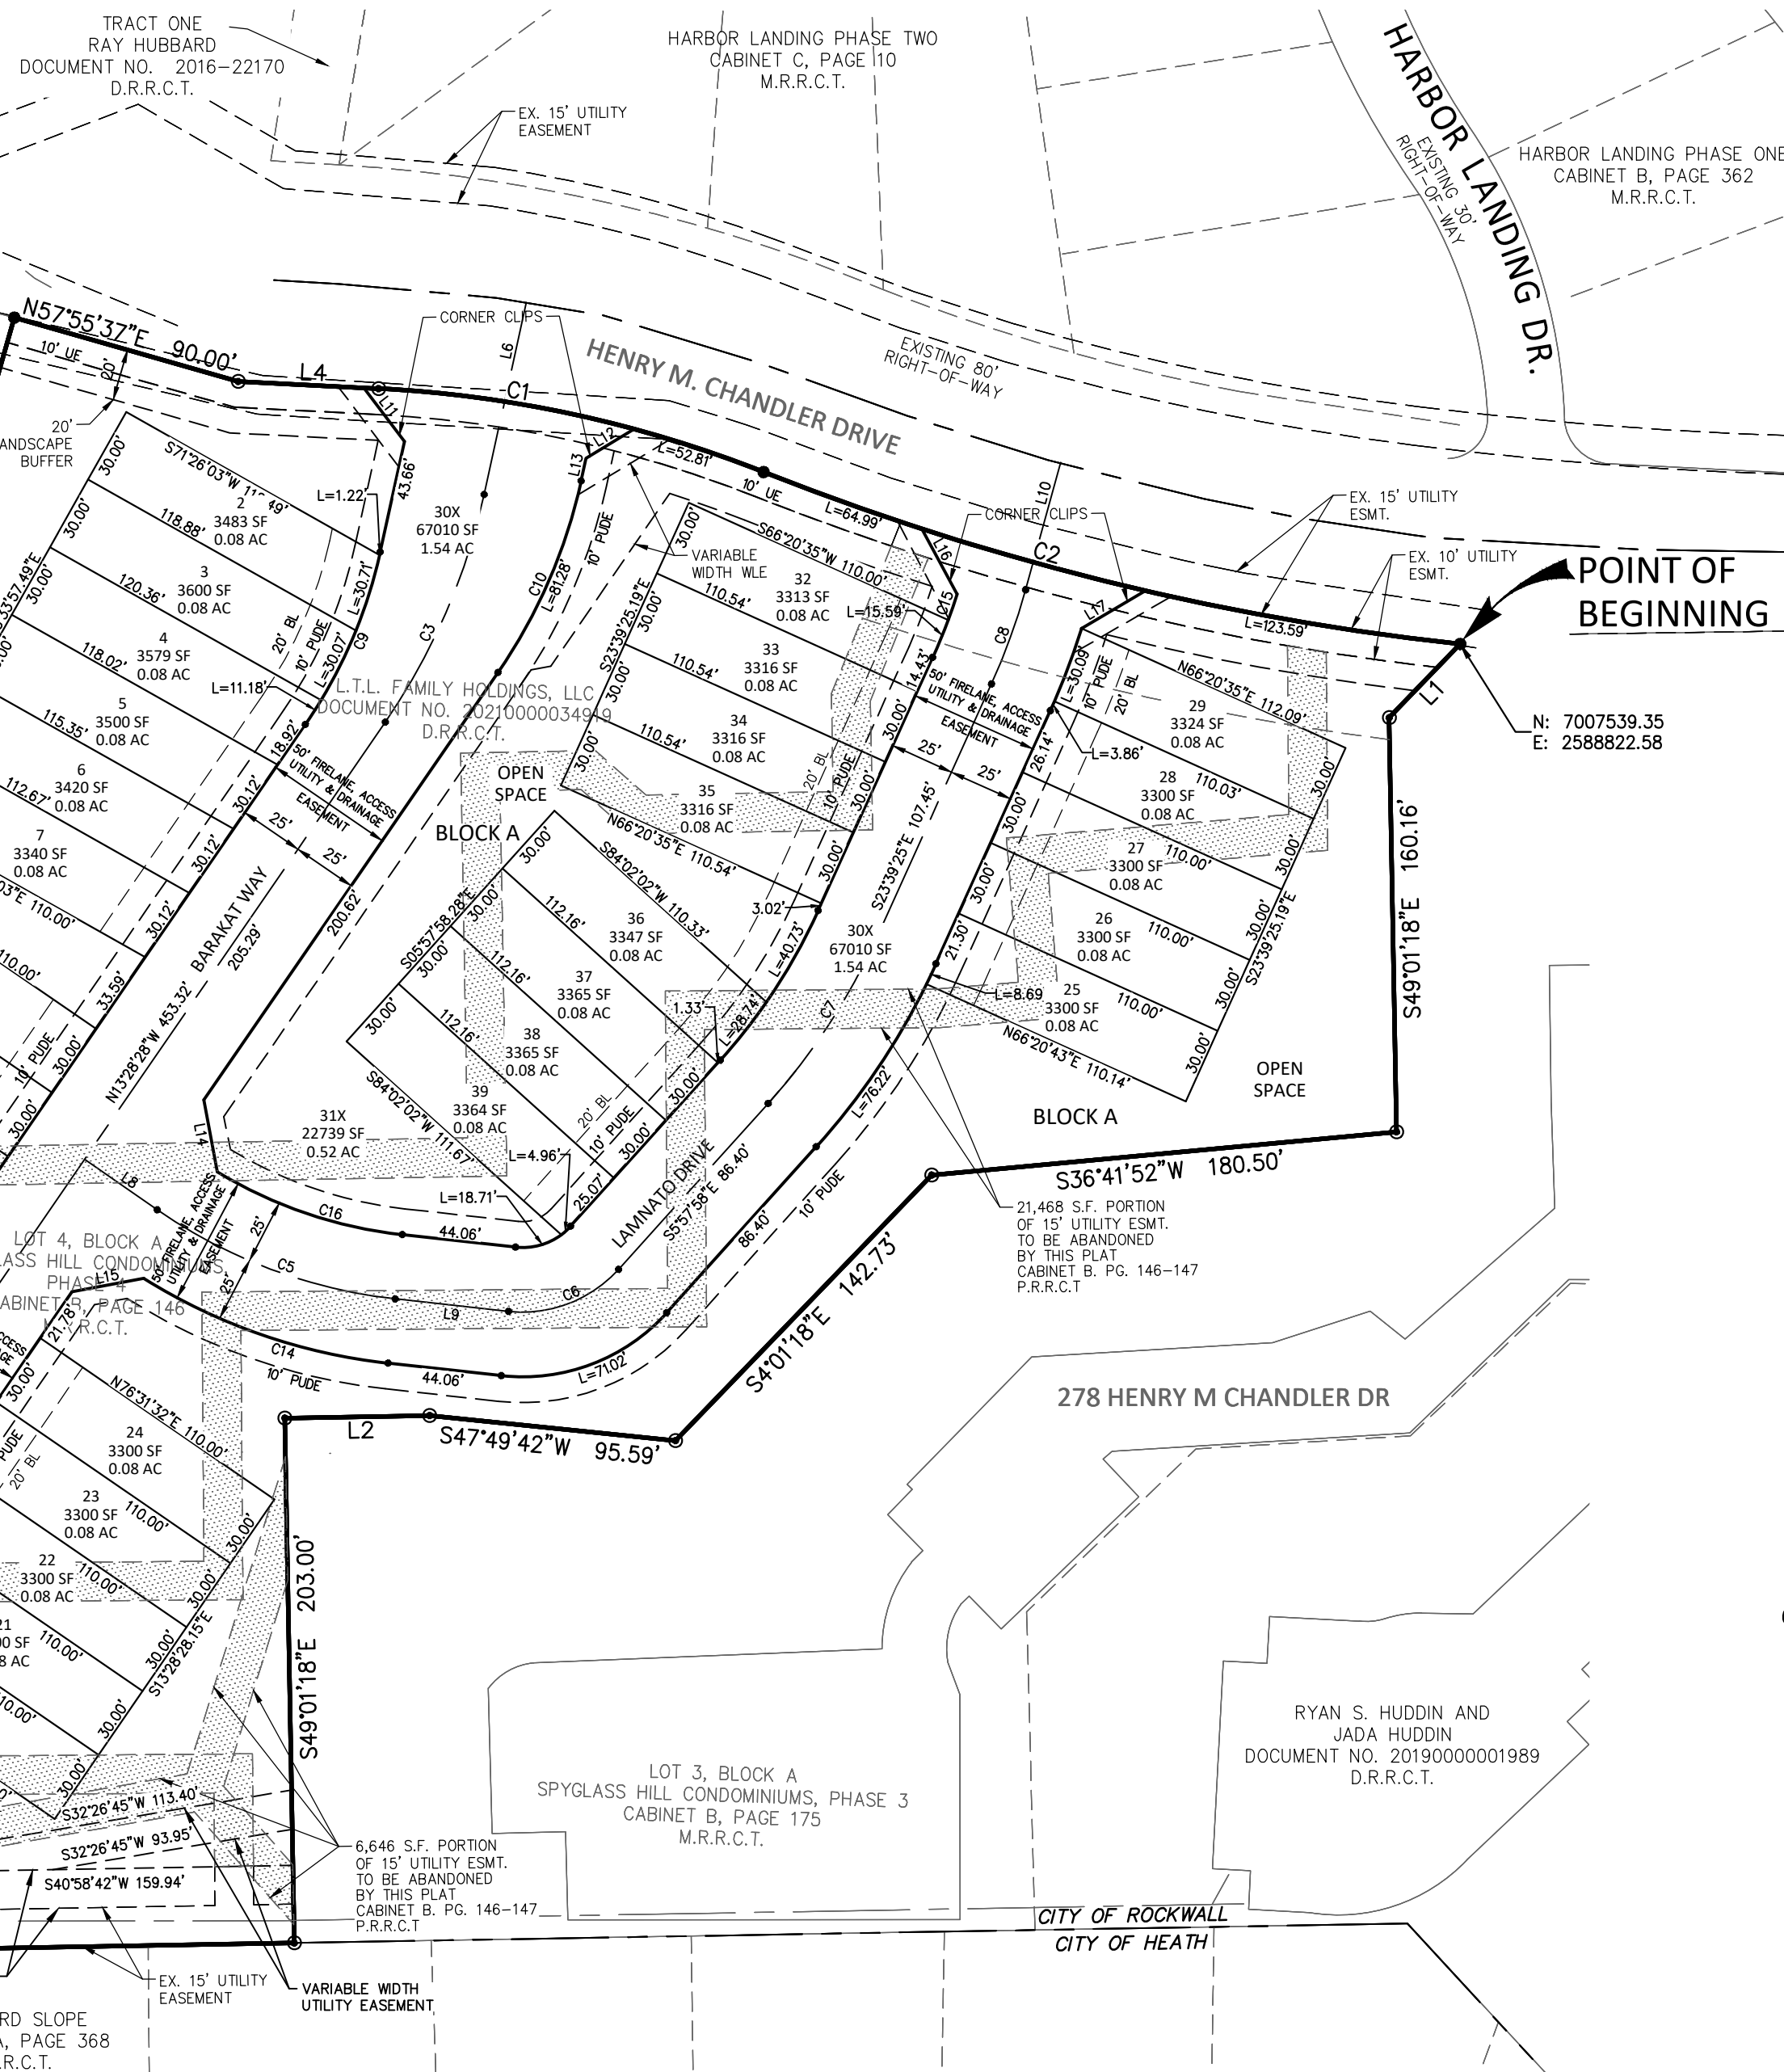

GENERAL NOTES:

- ALL LOT CORNERS MONUMENTED WITH A 1/2" IRON ROD WITH A YELLOW PLASTIC CAP STAMPED "JVC" UNLESS OTHERWISE NOTED.
- ALL UTILITY EASEMENTS AND DRAINAGE EASEMENTS WITHIN THIS PLATTED PROPERTY ARE CREATED BY THIS PLAT, UNLESS OTHERWISE NOTED.
- BASIS OF BEARING AND COORDINATES SHOWN HEREON REFER TO "TEXAS STATE PLANE COORDINATE SYSTEM, NORTH CENTRAL ZONE (4202), NORTH AMERICAN DATUM OF 1983 ON GRID COORDINATE VALUES.
- LOCATION OF 1% ANNUAL FLOOD CHANCE ESTIMATED FROM FEMA FIRM PANEL 48139C0325F DATED JUNE 3, 2013.
- LOTS ADJACENT TO FLOODPLAIN SHALL HAVE A MINIMUM FINISHED FLOOR ELEVATION 2' ABOVE THE 100-YR WSEL.
- IT SHALL BE THE POLICY OF THE CITY OF ROCKWALL TO WITHHOLD ISSUING BUILDING PERMITS UNTIL ALL STREETS, WATER, SEWER AND STORM DRAINAGE SYSTEMS HAVE BEEN ACCEPTED BY THE CITY. THE APPROVAL OF A PLAT BY THE CITY DOES NOT CONSTITUTE ANY REPRESENTATION, ASSURANCE OR GUARANTEE THAT ANY BUILDING WITHIN SUCH PLAT SHALL BE APPROVED, AUTHORIZED OR PERMIT THEREFORE ISSUED, NOR SHALL SUCH APPROVAL CONSTITUTE ANY REPRESENTATION, ASSURANCE OR GUARANTEE BY THE CITY OF THE ADEQUACY AND AVAILABILITY FOR WATER FOR PERSONAL USE AND FIRE PROTECTION WITHIN SUCH PLAT, AS REQUIRED UNDER ORDINANCE 83-54.
- PROPERTY OWNER SHALL BE RESPONSIBLE FOR MAINTAINING, REPAIRING, AND REPLACING ALL SYSTEMS WITHIN THE DRAINAGE AND DETENTION EASEMENTS.
- ALL ROW, PAVING AND DRAINAGE SHALL BE PRIVATE AND MAINTAINED, REPLACED AND REPAIRED BY HOA/PROPERTY OWNER.

BENCHMARKS

CITY OF ROCKWALL MONUMENT NO. COR-5:
STANDARD CITY OF ROCKWALL CONTROL MONUMENT LOCATED AT THE NORTHEAST CORNER OF THE INTERSECTION OF HENRY W. CHANDLER DRIVE AND COMMODORE PLAZA APPROXIMATELY 400' WEST OF THE INTERSECTION OF HENRY W. CHANDLER DRIVE AND RIDGE ROAD.
ELEVATION = PLAN 560.58' FIELD 561.09'

CITY OF ROCKWALL MONUMENT NO. COR-7:
STANDARD CITY OF ROCKWALL CONTROL MONUMENT LOCATED ON THE SOUTH SIDE OF SUMMER LEE DRIVE APPROXIMATELY 250' WEST OF THE INTERSECTION OF SUMMER LEE DRIVE AND RIDGE ROAD.
ELEVATION = PLAN 567.52' FIELD 567.78'

CITY OF ROCKWALL MONUMENT NO. COR-10:
BRASS DISK STAMPED "CITY OF ROCKWALL SURVEY MONUMENT" ON THE SOUTHEAST SIDE OF LAGUNA DRIVE AT THE SOUTHEAST CORNER OF A CURB INLET APPROXIMATELY 325' NORTHEAST OF THE INTERSECTION OF VILLAGE LANE AND LAGUNA DRIVE.
ELEVATION = PLAN 521.61' FIELD 521.57'

CITY OF ROCKWALL MONUMENT NO. COR-11:
BRASS DISK STAMPED "CITY OF ROCKWALL SURVEY MONUMENT" ON THE NORTHEAST SIDE OF MIMS ROAD AT THE SOUTHERLY END OF A CONCRETE HEADWALL AT THE INTERSECTION OF THE NORTHEAST LINE OF MIMS ROAD WITH THE SOUTHEAST LINE OF I-30.
ELEVATION = PLAN 565.98' FIELD 566.02'

STATE OF TEXAS §
COUNTY OF ROCKWALL §

WHEREAS L.T.L. Family Holdings, LLC, BEING THE OWNER OF A TRACT OF land in the County of Rockwall, State of Texas, said tract being described as follows:

BEING a tract of land situated in the E. TEAL SURVEY, ABSTRACT NO. 207, City of Rockwall, Rockwall County, Texas and being all of Lot 4, Block A of SPYGLASS HILL CONDOMINIUMS PHASE FOUR, an Addition to the City of Rockwall, Rockwall County, Texas according to the Plat thereof recorded in Cabinet B, Page 146, Map Records, Rockwall County, Texas and being all of that tract of land described in Deed to L.T.L. Family Holdings, LLC, as recorded in Document No. 20210000034919, Deed Records, Rockwall County, Texas and being more particularly described as follows:

BEGINNING at a 1/2 inch iron rod with a yellow plastic cap stamped "BISON CREEK" found in the southeast line of Henry Chandler Drive, an 80 foot right-of-way, for the common northeast corner of said L.T.L. Family Holdings, LLC tract, northeast corner of said Lot 4 and northwest corner of Lot 3, Block A of SPYGLASS HILL CONDOMINIUMS, PHASE 3, an Addition to the City of Rockwall, Rockwall County, Texas according to the Plat thereof recorded in Cabinet B, Page 175, Map Records, Rockwall County, Texas;

THENCE Southerly, with the common east line of said Lot 4, east line of said L.T.L. Family Holdings, LLC tract and west line of said Lot 3, the following seven (7) courses and distances:

South 04 degrees 01 minutes 18 seconds East, leaving said southeast line, a distance of 39.64 feet to a 1/2 inch iron rod found for corner;

South 49 degrees 01 minutes 18 seconds East, a distance of 160.16 feet to a 1/2 inch iron rod found for corner;

South 36 degrees 41 minutes 52 seconds West, a distance of 180.50 feet to a 1/2 inch iron rod with a yellow plastic cap stamped "BISON CREEK" found for corner;

South 04 degrees 01 minutes 18 seconds East, a distance of 142.73 feet to a 1/2 inch iron rod with a yellow plastic cap stamped "BISON CREEK" found for corner;

South 47 degrees 49 minutes 42 seconds West, a distance of 95.59 feet to a 1/2 inch iron rod found for corner;

South 40 degrees 58 minutes 42 seconds West, a distance of 56.00 feet to a 1/2 inch iron rod with a yellow plastic cap stamped "BISON CREEK" found for corner;

South 49 degrees 01 minutes 18 seconds East, a distance of 203.00 feet to a 1/2 inch iron rod found in the northwest line of WINDWARD SLOPE, an Addition to the City of Rockwall, Rockwall County, Texas according to the Plat thereof recorded in Cabinet A, page 368, Map Records, Rockwall County, Texas for the common south corner of said Lot 3 and an exterior ell corner of said Lot 4 and said L.T.L. Family Holdings, LLC tract;

THENCE South 40 degrees 58 minutes 42 seconds West, with the common southeast line of said Lot 4 and said L.T.L. Family Holdings, LLC tract and said northwest line, a distance of 480.10 feet to a 1/2 inch iron rod with a yellow plastic cap stamped "JVC" set for the common south corner of said Lot 4 and said L.T.L. Family Holdings, LLC tract;

THENCE Northerly, with the west line of said L.T.L. Family Holdings, LLC tract, the following four (4) courses and distances:

North 15 degrees 09 minutes 39 seconds West, a distance of 407.29 feet to a 1/2 inch iron rod with a yellow plastic cap stamped "JVC" set for corner;

North 02 degrees 08 minutes 12 seconds West, a distance of 70.75 feet to a 1/2 inch iron rod with a yellow plastic cap stamped "BISON CREEK" found for corner;

North 21 degrees 26 minutes 12 seconds West, a distance of 156.54 feet to a 1/2 inch iron rod with a yellow plastic cap stamped "BISON CREEK" found for corner;

North 32 degrees 04 minutes 21 seconds West, a distance of 109.80 feet to a 1/2 inch iron rod with a yellow plastic cap stamped "JVC" set in the southeast line of the above mentioned Henry Chandler Drive for the northwest corner of said L.T.L. Family Holdings, LLC tract;

THENCE Northeasterly, with said southeast line, the following four (4) courses and distances:

North 57 degrees 55 minutes 37 seconds East, a distance of 90.00 feet to a 1/2 inch iron rod found for corner;

North 44 degrees 54 minutes 57 seconds East, a distance of 54.37 feet to a 1/2 inch iron rod found for corner at the beginning of a curve to the right having a central angle of 18 degrees 36 minutes 42 seconds, a radius of 471.19 feet and a chord bearing and distance of North 54 degrees 13 minutes 19 seconds East, 152.39 feet;

Northeasterly, with said curve to the right, an arc distance of 153.06 feet to a 1/2 inch iron rod with a yellow plastic cap stamped "JVC" set for corner at the beginning of a reverse curve to the left having a central angle of 15 degrees 20 minutes 06 seconds, a radius of 1,040.00 feet and a chord bearing and distance of North 55 degrees 51 minutes 37 seconds East, 277.52 feet;

Northeasterly, with said curve to the left, an arc distance of 278.35 feet to the POINT OF BEGINNING and containing 6.889 acres of land, more or less.

Line Table		
Line	Length	Direction
L1	39.64	S4° 01' 18"E
L2	56.00	S40° 58' 42"W
L3	70.75	N2° 08' 12"W
L4	48.71	N44° 54' 57"E
L5	7.87	N37° 31' 07"E
L6	75.93	N35° 35' 51"W
L7	10.11	N54° 16' 59"W
L8	34.22	S76° 43' 41"W
L9	44.06	S48° 17' 23"W
L10	51.06	S32° 31' 55"E
L11	26.01	S85° 01' 36"E
L12	21.71	N10° 45' 15"E
L13	8.92	N35° 35' 51"W
L14	28.27	S58° 28' 11"E
L15	28.28	N31° 30' 26"E
L16	28.64	S76° 19' 54"E
L17	28.68	S11° 22' 41"W

Curve Table					
Curve #	Length	Radius	Delta	Chord Length	Chord Bearing
C1	153.06	471.19	018°36'42"	152.39	N54° 13' 19"E
C2	278.35	1040.00	015°20'06"	277.52	N55° 51' 37"E
C3	96.53	250.00	022°07'23"	95.93	N24° 32' 09"W
C4	35.61	50.00	040°48'31"	34.86	S33° 52' 43"E
C5	99.27	200.00	028°26'17"	98.25	N62° 30' 32"E
C6	47.35	50.00	054°15'21"	45.60	N21° 09' 42"E
C7	77.19	250.00	017°41'27"	76.88	N14° 48' 42"W
C8	38.72	250.00	008°52'30"	38.69	N28° 05' 40"W
C9	30.07	189.50	009°05'28"	30.04	N21° 23' 59"W
C10	81.28	210.50	022°07'23"	80.77	N24° 32' 09"W
C11	10.65	20.00	030°29'56"	10.52	N01° 46' 30"E
C12	191.73	54.00	203°26'04"	105.75	N19° 00' 37"E
C13	24.17	20.00	069°13'57"	22.72	S48° 05' 27"E
C14	100.81	225.00	025°40'18"	99.97	N61° 07' 32"E
C15	10.62	225.00	002°42'17"	10.62	S28° 58' 42"E
C16	76.17	175.00	024°56'24"	75.57	N60° 45' 35"E
C17	39.36	96.46	023°22'43"	39.09	S22° 39' 49"W

OWNER'S CERTIFICATION:

NOW THEREFORE, KNOW ALL MEN BY THESE PRESENTS:

STATE OF TEXAS §
COUNTY OF ROCKWALL §

I (we) the undersigned owner(s) of the land shown on this plat, and designated herein as the MARINA VILLAGE subdivision to the City of Rockwall, Texas, and whose name is subscribed hereto, hereby dedicate to the use of the public forever any streets, alleys, parks, water courses, drains, easements and public places thereon shown on the purpose and consideration therein expressed. I (we) further certify that all other parties who have a mortgage or lien interest in the MARINA VILLAGE subdivision have been notified and signed this plat. I (we) understand and do hereby reserve the easement strips shown on this plat for the purposes stated and for the mutual use and accommodation of all utilities desiring to use or using same. I (we) also understand the following:

- No buildings shall be constructed or placed upon, over, or across the utility easements as described herein.
- Any public utility shall have the right to remove and keep removed all or part of any buildings, fences, trees, shrubs, or other growths or improvements which in any way endanger or interfere with construction, maintenance or efficiency of their respective system on any of these easement strips; and any public utility shall at all times have the right of ingress or egress to, from and upon the said easement strips for purpose of construction, reconstruction, inspecting, patrolling, maintaining, and either adding to or removing all or part of there respective system without the necessity of, at any time, procuring the permission of anyone.
- The City of Rockwall will not be responsible for any claims of any nature resulting from or occasioned by the establishment of grade of streets in the subdivision.
- The developer and subdivision engineer shall bear total responsibility for storm drain improvements.
- The developer shall be responsible for the necessary facilities to provide drainage patterns and drainage controls such that properties within the drainage area are not adversely affected by storm drainage from the development.
- No house dwelling unit, or other structure shall be constructed on any lot in this addition by the owner or any other person until the developer and/or owner has complied with all requirements of the Subdivision Regulations of the City of Rockwall regarding improvements with respect to the entire block on the street or streets on which property abuts, including the actual installation of streets with the required base and paving, curb and gutter, water and sewer, drainage structures, storm sewers, and alleys all according to the specifications of the City of Rockwall; or

Until an escrow deposit, sufficient to pay for the cost of such improvements, as determined by the city's engineer and/or city administrator, computed on a private commercial rate basis, has been made with the city secretary, accompanied by an agreement signed by the developer and/or owner, authorizing the city to make such improvements at prevailing private commercial rates, or have the same made by a contractor and pay the same out of the escrow deposit, should the developer and/or owner fail to refuse to install the required improvements within the time stated in such written agreement, but in no case shall the City be obligated to make such improvements itself. Such deposit may be used by the owner and/or developer as progress payments as the work progresses in making such improvements by making certified requisitions to the city secretary, supported by evidence of work done; or

Until the developer and/or owner files a corporate surety bond with the city secretary in a sum equal to the cost of such improvements for the designated area, guaranteeing the installation thereof within the time stated in the bond, which shall be fixed by the city council of the City of Rockwall.

I (we) further acknowledge that the dedications and/or exactions made herein are proportional to the impact of the Subdivision upon the public services required in order that the development will comport with the present and future growth needs of the City; I (we), my (our) successors and assigns hereby waive any claim, damage, or cause of action that I (we) may have as a result of the dedication of exactions made herein.

Property Owner Signature

STATE OF TEXAS §
COUNTY OF ROCKWALL §

BEFORE ME, the undersigned authority, on this day personally appeared L.T.L. Family Holdings, LLC, known to me to be the person whose name is subscribed to the foregoing instrument and acknowledged to me that he executed the same for the purpose and consideration therein stated.

Given under my hand and seal of office, this ____ day of _____, 2022.

Notary public in and for the State of Texas

My Commission Expires

STATE OF TEXAS §
COUNTY OF ROCKWALL §

BEFORE ME, the undersigned authority, on this day personally appeared L.T.L. Family Holdings, LLC, known to me to be the person whose name is subscribed to the foregoing instrument and acknowledged to me that he executed the same for the purpose and consideration therein stated.

Given under my hand and seal of office, this ____ day of _____, 2022.

Notary public in and for the State of Texas

My Commission Expires

SURVEYOR'S CERTIFICATE:

NOW, THEREFORE KNOW ALL MEN BY THESE PRESENTS:

THAT I, Ryan S. Reynolds, do hereby certify that I prepared this plat from an actual and accurate survey of the land, and that the corner monuments shown thereon were properly placed under my personal supervision.

RYAN S. REYNOLDS, R.P.L.S.
Texas Registered Professional Land Surveyor No. 6385.

STATE OF TEXAS §
COUNTY OF COLLIN §

BEFORE ME, the undersigned authority, on this day personally appeared Ryan S. Reynolds, known to me to be the person whose name is subscribed to the above and foregoing instrument, and acknowledged to me that he executed the same for the purposes and consideration expressed and in the capacity therein stated.

Given under my hand and seal of office, this ____ day of _____, 2022.

Notary public for and in the State of Texas

My commission expires: _____

Planning & Zoning Commission, Chairperson

Date

APPROVED:
I hereby certify that the above and foregoing plat of an addition to the City of Rockwall, Texas be approved by the City Council of the City of Rockwall on ____ day of _____, 2022.

This approval shall be invalid unless the approved plat for such addition is recorded in the office of the County Clerk of Rockwall, County, Texas, within one hundred eighty (180) days from said date of approval.

WITNESS OUR HANDS, this ____ day of _____, 2022.

Mayor, City of Rockwall

City Secretary

City Engineer

FINAL PLAT
MARINA VILLAGE
LOTS 1X, 2-29, 30X, 31X, 32-39 BLOCK A
6.889 ACRES
36 TOWNHOME LOTS AND
4 COMMON AREAS
SITUATED WITHIN THE
EDWARD TEAL SURVEY, ABSTRACT NO. 107
CITY OF ROCKWALL
ROCKWALL COUNTY, TEXAS
P2022-008
October 14, 2022
SHEET 2 OF 2






JOHNSON VOLK
CONSULTING

TBPELS: Engineering Firm No. 11962 / Land Surveying Firm No. 10194033
704 Central Parkway East | Suite 1200 | Plano, TX 75074 | 972.201.3100


Owner/Applicant:
LTL Family Holdings, LLC
William Johnson
14918 Mystic Terrace Lane
Cyprus, Texas 77429
Phone: 713-325-4294

Engineer/Surveyor:
Johnson Volk Consulting, Inc.
704 Central Parkway East, Suite. 1200
Plano, Texas 75074
Phone: 682-225-7189
Contact: Tom Dayton, PE

F:\level 3\projects\2209 - marina villages - townhomes - rockwall\landscapes\2209 - treescape plan.dwg

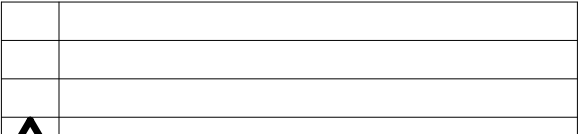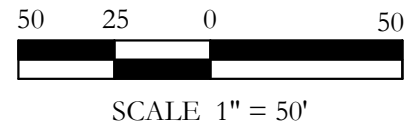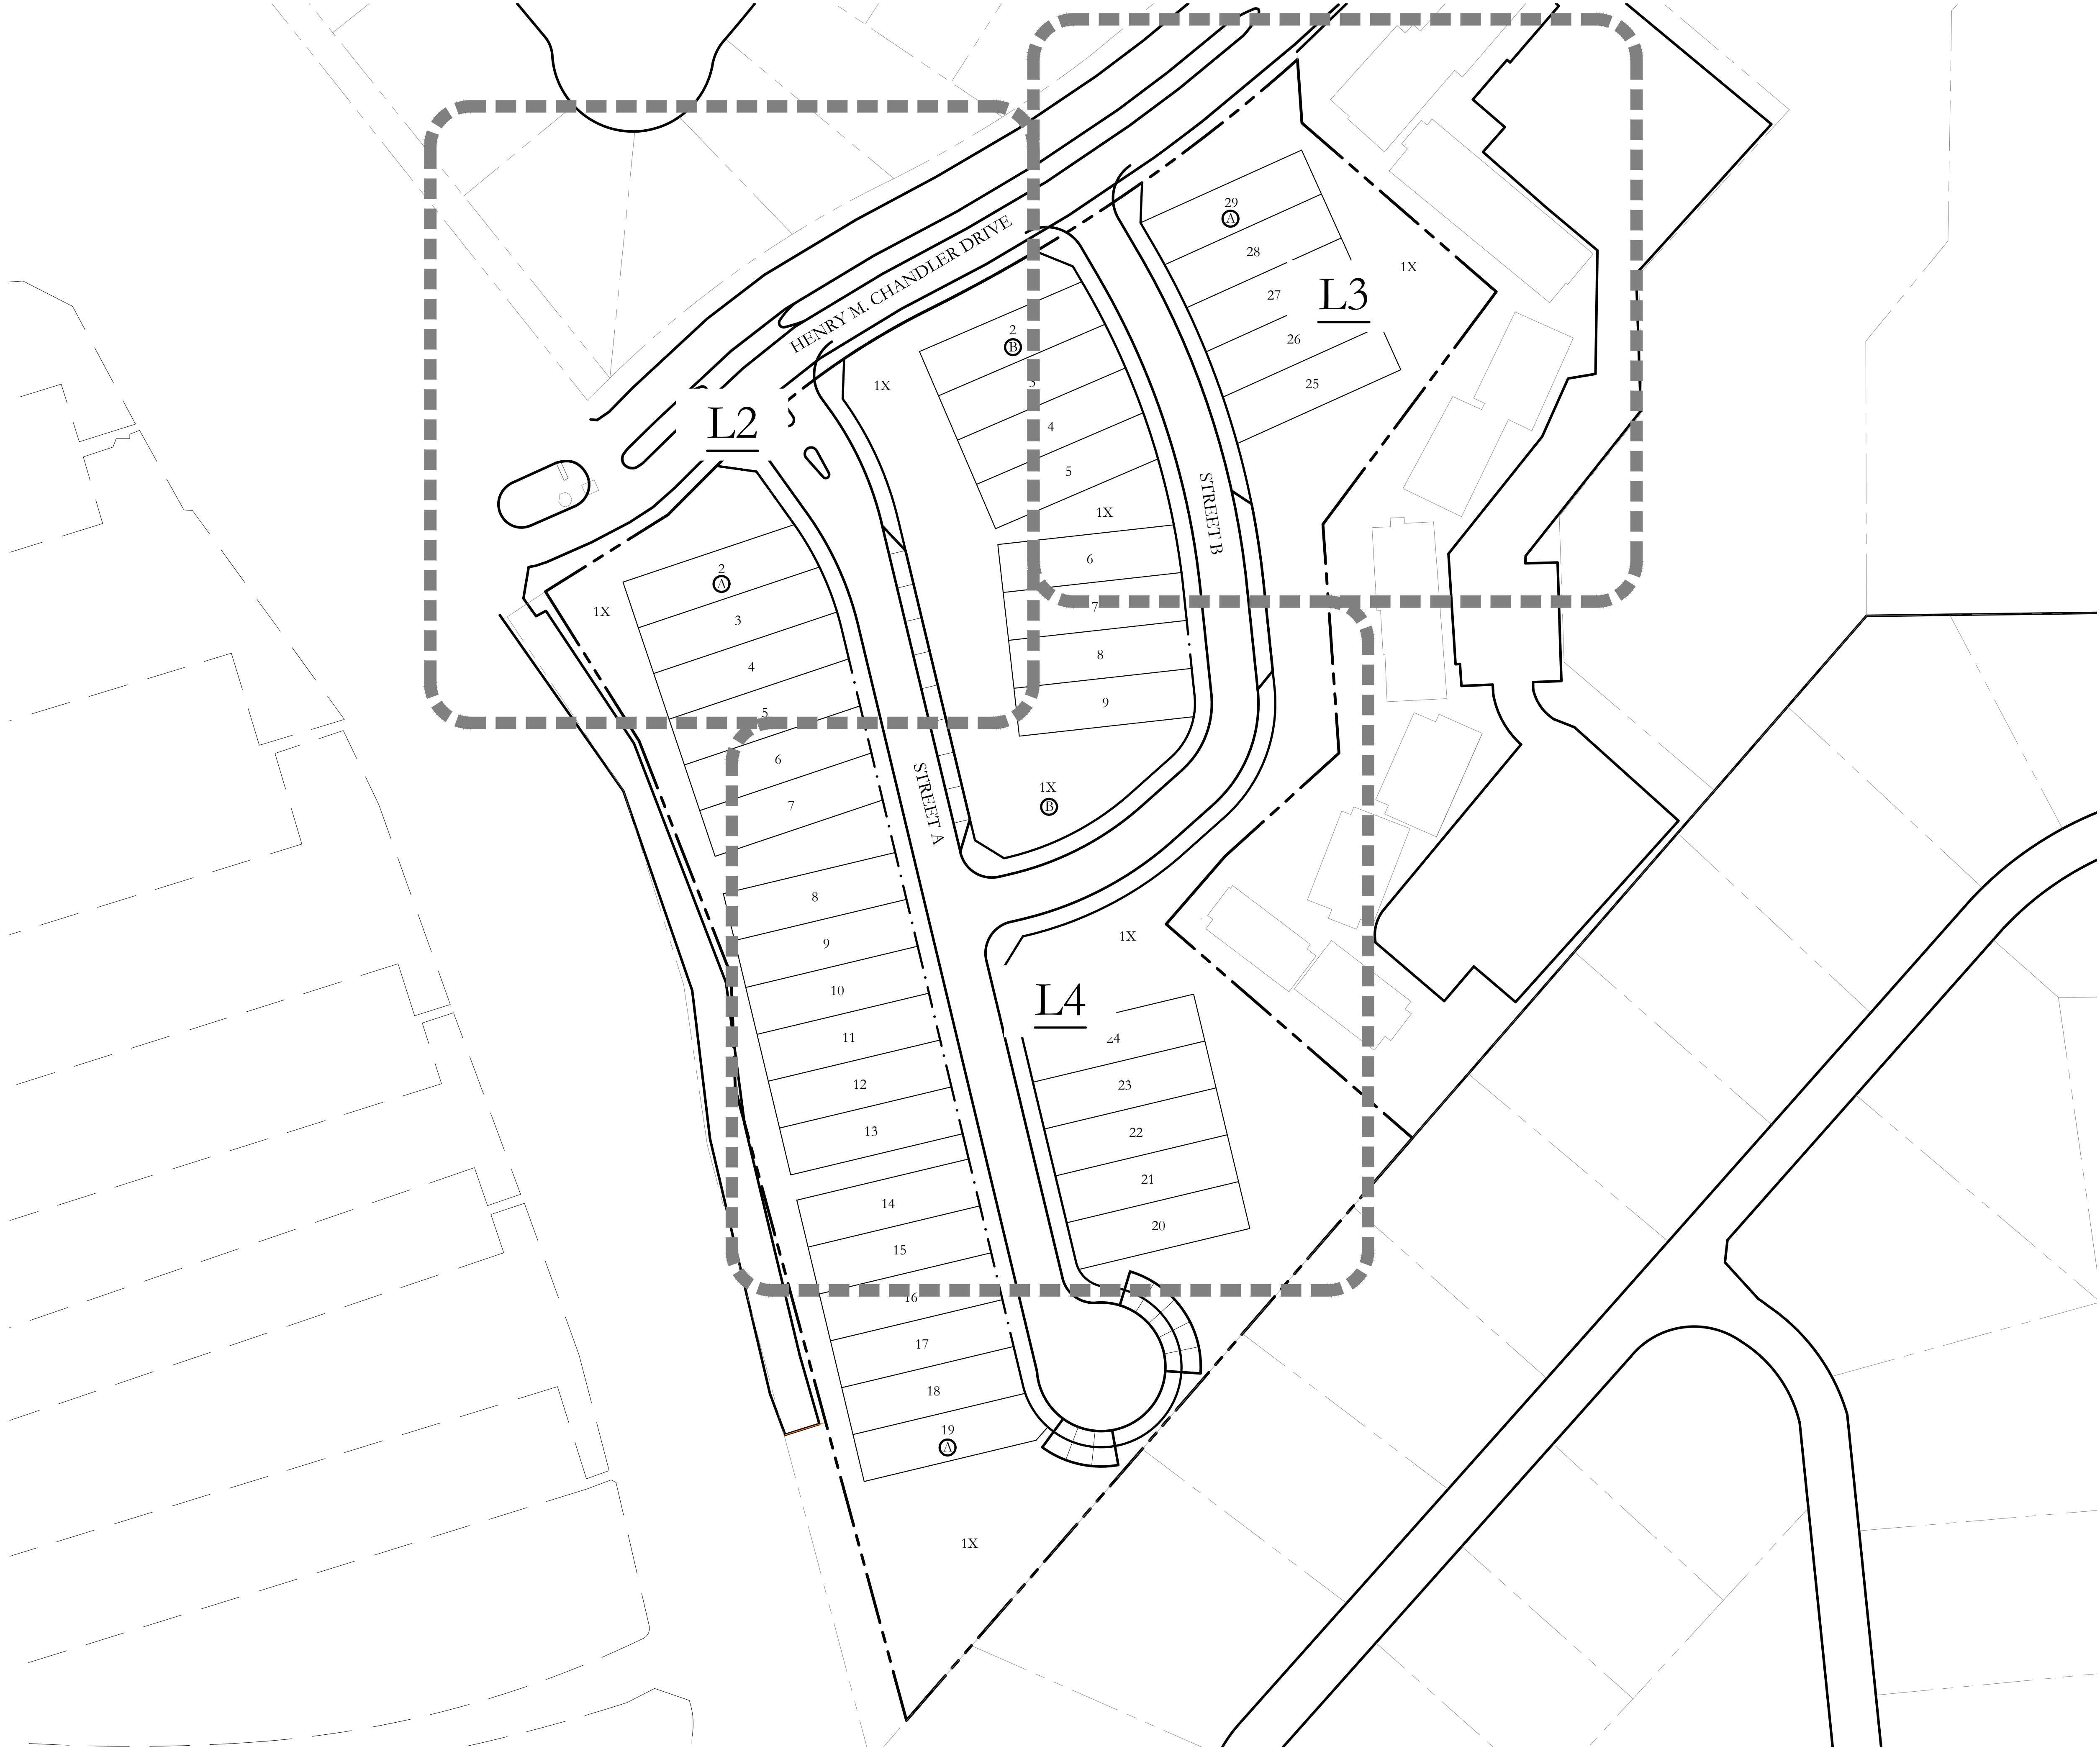


SCALE:
1" = 50'
One Inch
JVC No 2209

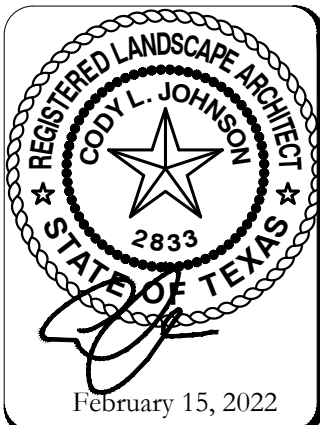


TREESCAPE PLAN
OVERALL LAYOUT PLAN

MARINA VILLAGE TOWNHOMES
CITY OF ROCKWALL
ROCKWALL COUNTY, TEXAS


JOHNSON VOLK
CONSULTING
TBPELS: Engineering Firm No. 11962 / Land Surveying Firm No. 10194033
704 Central Parkway East | Suite 1200 | Plano, TX 75074 | 972.201.3100

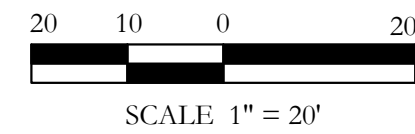


F:\civil 3d projects\2209 - marina villages - townhomes - rockwall\landscapes\2209 - treescape plan.dwg

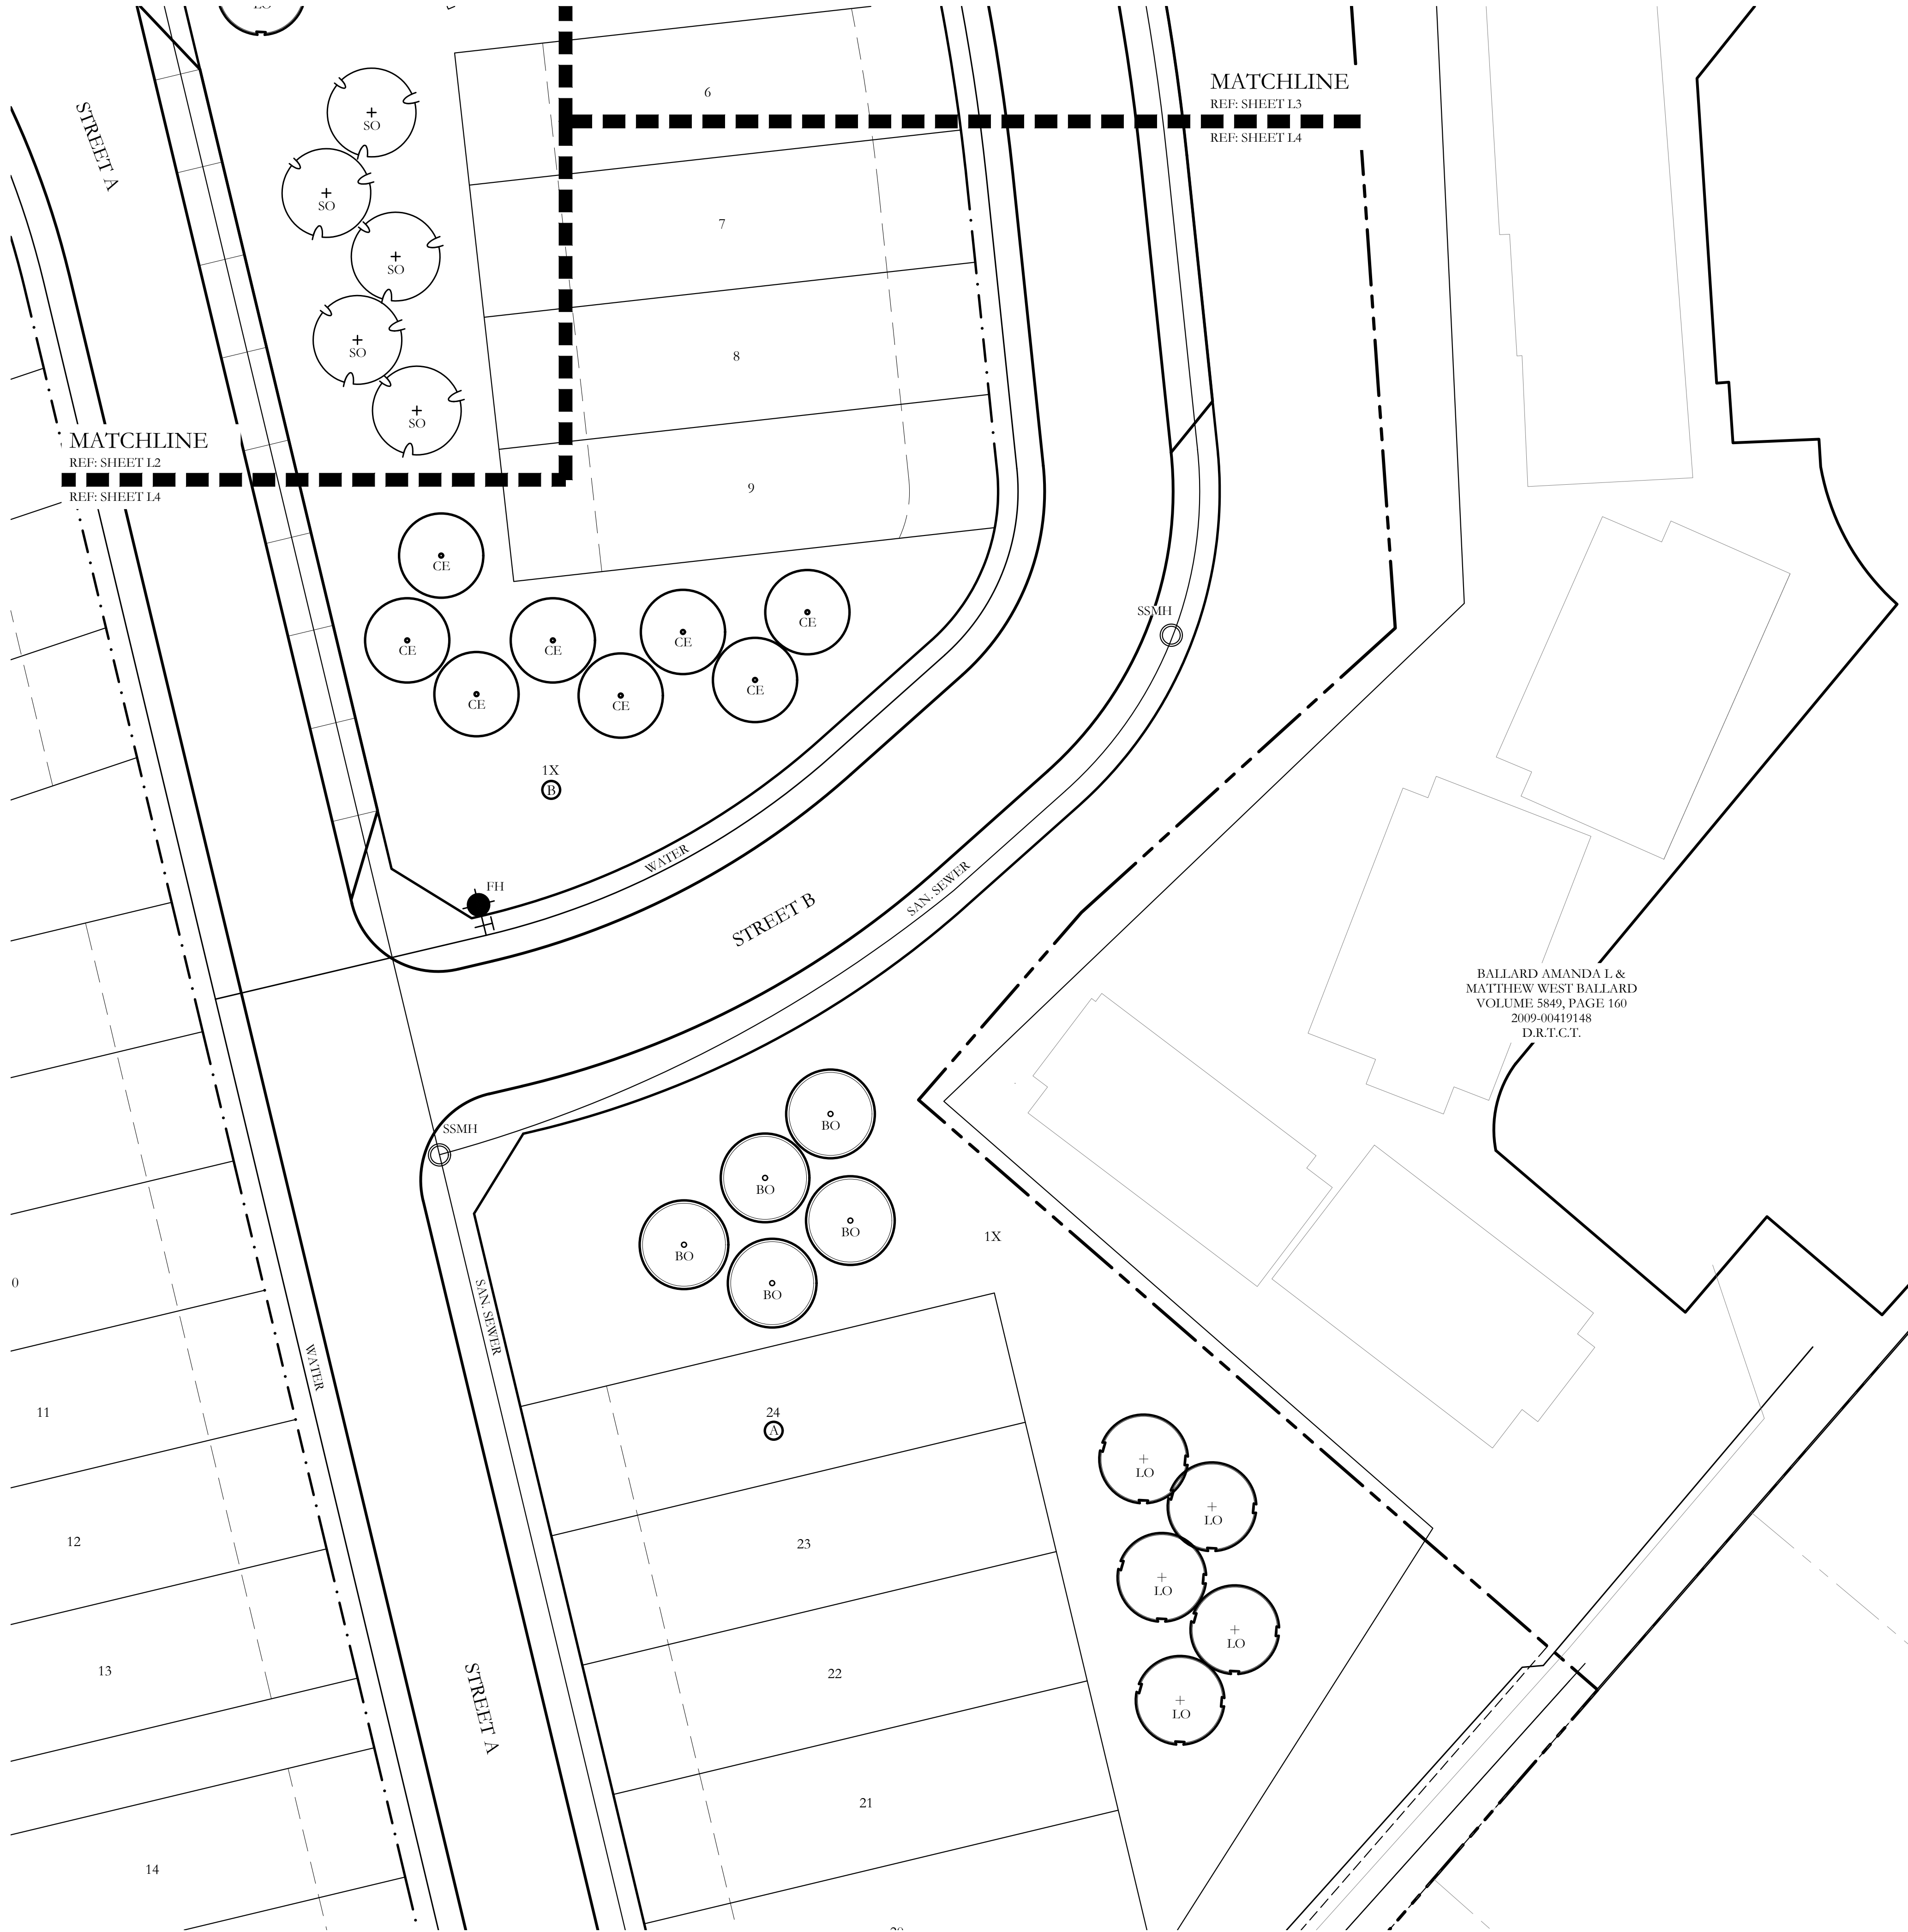

PLANT LEGEND					
SYMBOL	KEY	COMMON NAME	SCIENTIFIC NAME	SIZE	SPACING
	LO	LIVE OAK	QUERCUS VIRGINIANA	4" CALIPER	AS SHOWN
	SO	SHUMARD OAK	QUERCUS SHUMARDII	4" CALIPER	AS SHOWN
	BO	BUR OAK	QUERCUS MACROCARPA	4" CALIPER	AS SHOWN
	CE	CEDAR ELM	ULMUS CRASSIFOLIA	4" CALIPER	AS SHOWN
	DW	DESERT WILLOW	CHILOPSIS LINEARIS	2" CALIPER	AS SHOWN
	RB	TEXAS REDBUD	CERCIS CANADENSIS VAR. TEXENSIS	2" CALIPER	AS SHOWN

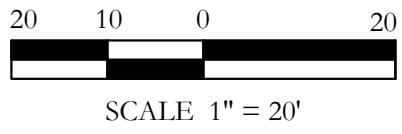

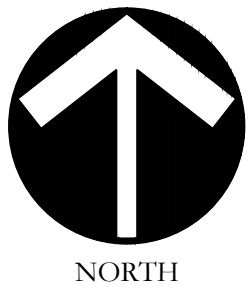

F:\civil 3d projects\2209 - marina villages - townhomes - rockwall\landscape\2209 - treescape planting.dwg

LANDSCAPE PROVIDED

HENRY M. CHANDLER DR.

MINIMUM TEN (10) FOOT LANDSCAPE BUFFER PROVIDED


1 - 4" CAL. CANOPY TREE & 1 ACCENT TREE / 50 LF OF LINEAR FRONTAGE
576 LF OF FRONTAGE / 50 LF = 12 - 4" CAL. TREES & 12 ACCENT TREES REQUIRED.
PROVIDED: 12 - 4" CALIPER CANOPY TREES & 13 ACCENT TREES PROVIDED

TREE MITIGATION

191.5 CAL. INCHES REMOVED

43 - 4" CAL. CANOPY TREES & 13 - 2" CAL. ACCENT TREES = 198 CAL. INCHES REPLACED.

PLANT LIST						
KEY	ESTIMATED QUANTITY	COMMON NAME	SCIENTIFIC NAME	SIZE	SPACING	REMARKS
LO	13	LIVE OAK	QUERCUS VIRGINIANA	4" CALIPER	AS SHOWN	NURSERY GROWN; FULL HEAD; MINIMUM BRANCHING HEIGHT AT 6'-0"; MINIMUM 10'-0" OVERALL HEIGHT.
SO	11	SHUMARD OAK	QUERCUS SHUMARDII	4" CALIPER	AS SHOWN	NURSERY GROWN; FULL HEAD; MINIMUM BRANCHING HEIGHT AT 6'-0"; MINIMUM 10'-0" OVERALL HEIGHT.
BO	8	BUR OAK	QUERCUS MACROCARPA	4" CALIPER	AS SHOWN	NURSERY GROWN; FULL HEAD; MINIMUM BRANCHING HEIGHT AT 6'-0"; MINIMUM 10'-0" OVERALL HEIGHT.
CE	11	CEDAR ELM	ULMUS CRASSIFOLIA	4" CALIPER	AS SHOWN	NURSERY GROWN; FULL HEAD; MINIMUM BRANCHING HEIGHT AT 6'-0"; MINIMUM 10'-0" OVERALL HEIGHT.
DW	7	DESERT WILLOW	CHILOPSIS LINEARIS	2" CALIPER	AS SHOWN	NURSERY GROWN; FULL HEAD; MINIMUM 8'-0" OVERALL HEIGHT.
RB	6	TEXAS REDBUD	CERCIS CANADENSIS VAR. TEXENSIS	2" CALIPER	AS SHOWN	NURSERY GROWN; FULL HEAD; MINIMUM 8'-0" OVERALL HEIGHT.

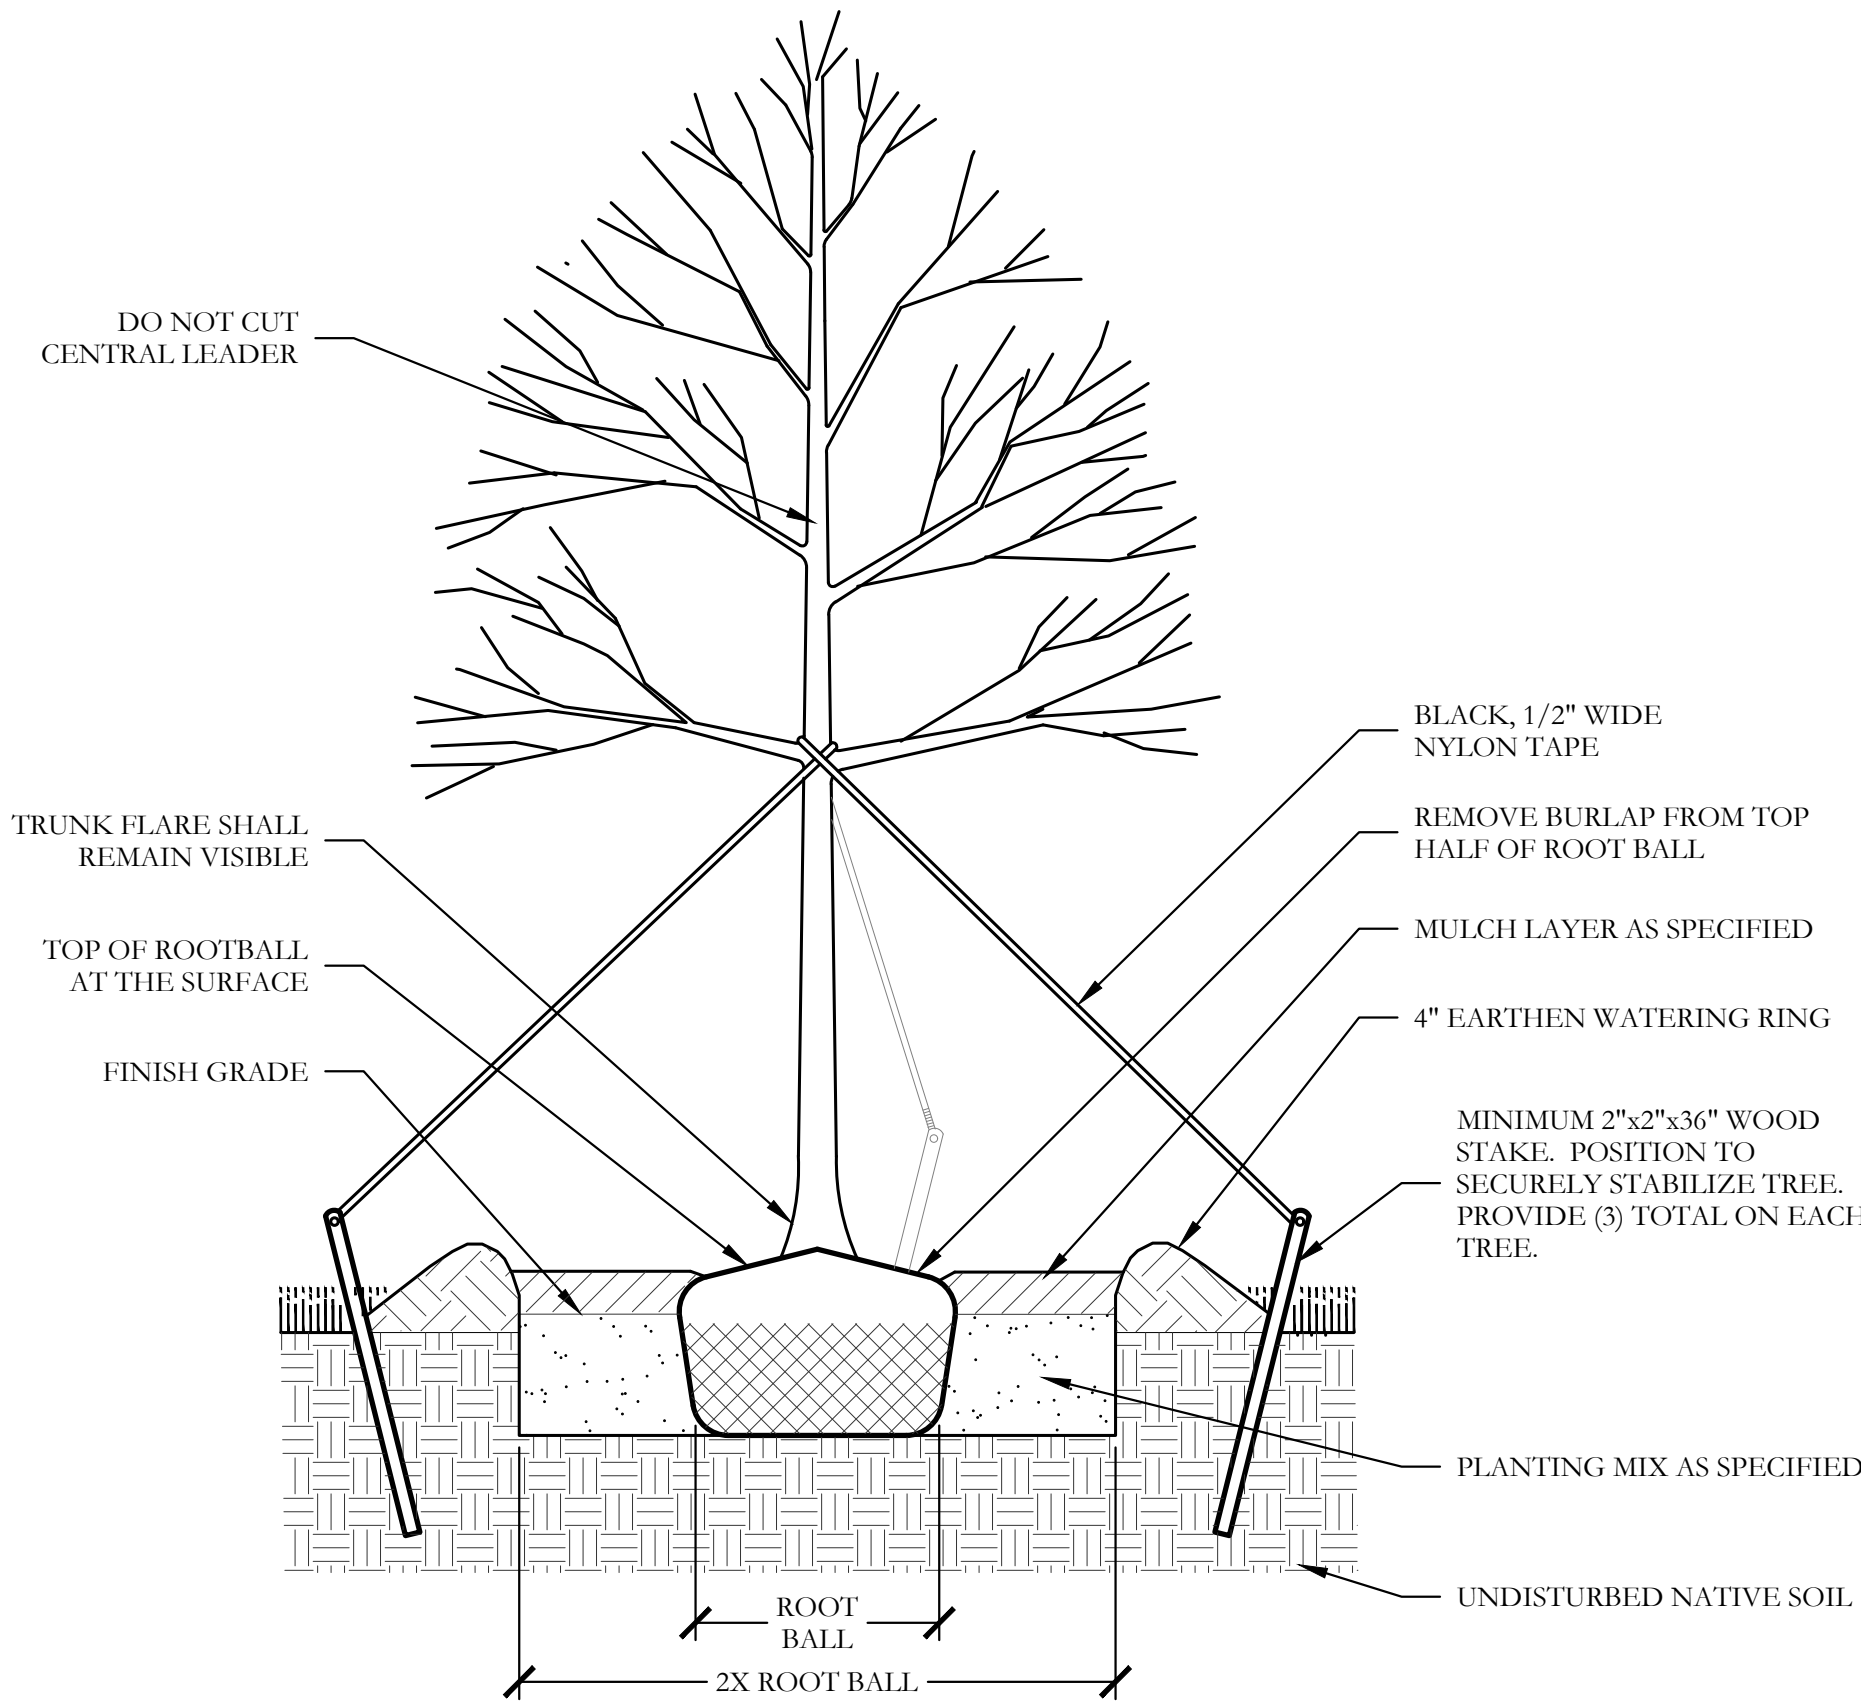

1 TYPICAL TREE PLANTING SECTION NOT TO SCALE

GENERAL LANDSCAPE NOTES

INSPECTIONS:

- NO EXCAVATION SHALL OCCUR IN CITY R.O.W. WITHOUT A R.O.W. PERMIT--CONTACT THE PUBLIC WORKS DEPARTMENT.
- THE CONTRACTOR SHALL MARK ALL WATER LINES, SEWER LINES, AND TREE LOCATIONS PRIOR TO CALLING FOR ROW INSPECTION AND PERMIT.
- THE LANDSCAPE INSTALLATION SHALL COMPLY WITH APPROVED LANDSCAPE DRAWINGS PRIOR TO FINAL ACCEPTANCE BY THE CITY AND ISSUANCE OF A CERTIFICATE OF OCCUPANCY.
- WATER METERS, CLEANOUTS AND OTHER APPURTENANCES, SHALL BE ACCESSIBLE, ADJUSTED TO GRADE, CLEARLY MARKED WITH FLAGGING AND COMPLIANT WITH PUBLIC WORKS DEPARTMENT STANDARDS PRIOR TO CALLING FOR FINAL LANDSCAPE AND ROW INSPECTIONS.

LANDSCAPE STANDARDS:

- PLANTINGS AND LANDSCAPE ELEMENTS SHALL COMPLY WITH THE CITY'S ENGINEERING DESIGN STANDARDS, PUBLIC R.O.W. VISIBILITY REQUIREMENTS.
- UNLESS OTHERWISE SPECIFIED, TREES SHALL BE PLANTED NO LESS THAN 4' FROM CURBS, SIDEWALKS, UTILITY LINES, SCREENING WALLS AND OTHER STRUCTURES. THE CITY HAS FINAL APPROVAL FOR ALL TREE PLACEMENTS.
- A MINIMUM THREE FEET (3') RADIUS AROUND A FIRE HYDRANT MUST REMAIN CLEAR OF LANDSCAPE PURSUANT TO THE FIRE CODE.
- STREET TREES, WHERE REQUIRED, SHALL BE (10') MINIMUM FROM THE EDGE OF A STORM SEWER CURB INLET BOX AND THE EDGE OF THE ROOT BALL SHALL BE (4') MINIMUM FROM THE WATER METER.
- THE AMERICAN STANDARD FOR NURSERY STOCK (ANSI Z60.1-2004) SPECIFICATIONS SHALL GOVERN PLANT QUALIFICATIONS, GRADES, AND STANDARDS.
- TREE PLANTING SHALL COMPLY WITH DETAILS HEREIN AND THE INTERNATIONAL SOCIETY OF ARBORICULTURE (ISA) STANDARDS.
- A 2-3" LAYER OF MULCH SHALL BE PROVIDED AROUND THE BASE OF THE PLANTED TREE. THE MULCH SHALL BE PULLED BACK 4" FROM THE TRUNK OF THE TREE.
- TREE PITS SHALL BE TESTED FOR WATER PERCOLATION. IF WATER DOES NOT DRAIN OUT OF TREE PIT WITHIN 24-HOURS, THE TREE SHALL BE MOVED OR DRAINAGE SHALL BE PROVIDED.
- ALL BEDS TO HAVE 3" OF COMPOSTED SOIL, LIVING EARTH TECHNOLOGY, OR APPROVED EQUAL TILLED AND TURNED TO A DEPTH OF 8" MINIMUM.
- ALL PLANT BEDS SHALL BE TOP-DRESSED WITH A MINIMUM OF 3 INCHES OF HARDWOOD MULCH.
- NATIVE SITE TOPSOIL IS TO BE PROTECTED FROM EROSION OR STOCKPILED. NATIVE SITE TOPSOIL SHALL BE LABORATORY TESTED BY AND ACCREDITED LABORATORY AND AMENDED PER SAID LABORATORY'S RECOMMENDATIONS.

IRRIGATION STANDARDS:

- ANY CHANGES TO THESE APPROVED IRRIGATION DRAWINGS SHALL BE AUTHORIZED BY THE CITY. CONTACT DEVELOPMENT SERVICES FOR AN IRRIGATION PERMIT PRIOR TO INSTALLING THE IRRIGATION SYSTEM.
- IRRIGATION OVER-SPRAY ON STREETS AND WALKS IS PROHIBITED.
- MAINLINES, VALVES, OR CONTROL WIRES SHALL NOT BE LOCATED IN THE CITY'S ROW.
- ET IRRIGATION CONTROLLERS SHALL BE PROGRAMMED AND ADJUSTED TO NOT EXCEED THE LANDSCAPE WATER ALLOWANCE (LWA) PRIOR TO APPROVAL OF LANDSCAPE INSTALLATION.
- VALVES SHALL BE LOCATED A MINIMUM OF (3') AWAY FROM STORM SEWERS, AND SANITARY SEWER LINES AND 5 FEET FROM CITY FIRE HYDRANTS AND WATER VALVES.
- THE BORE DEPTH UNDER STREETS, DRIVE AISLES, AND FIRE LANES SHALL PROVIDE (2') OF CLEARANCE (MINIMUM).
- IRRIGATION HEADS THAT RUN PARALLEL AND NEAR PUBLIC WATER AND SANITARY SEWER LINES; SHALL BE FED FROM STUBBED LATERALS OR BULL-HEADS. A MINIMUM FIVE FOOT (5') SEPARATION IS REQUIRED BETWEEN IRRIGATION MAIN LINES AND LATERALS THAT RUN PARALLEL TO PUBLIC WATER AND SANITARY SEWER LINES.
- NO VALVES, BACKFLOW PREVENTION ASSEMBLIES, QUICK COUPLERS ETC. SHALL BE LOCATED CLOSER THAN 10' FROM THE CURB AT STREET OR DRIVE INTERSECTION.


MAINTENANCE STANDARDS:


- THE OWNER SHALL BE RESPONSIBLE FOR THE ESTABLISHMENT, MAINTENANCE, AND VIGOR OF PLANT MATERIAL IN ACCORDANCE WITH THE DESIGN INTENT AND AS APPROPRIATE FOR THE SEASON OF THE YEAR.
- LANDSCAPE AND OPEN AREAS SHALL BE FREE OF TRASH, LITTER AND WEEDS.
- NO PLANT MATERIAL SHALL BE ALLOWED TO ENCROACH ON R.O.W., SIDEWALKS OR EASEMENTS TO THE EXTENT THAT VISION OR ROUTE OF TRAVEL FOR VEHICULAR, PEDESTRIAN, OR BICYCLE TRAFFIC IS IMPEDED.
- TREE MAINTENANCE SHALL BE IN ACCORDANCE WITH THE STANDARDS OF THE INTERNATIONAL SOCIETY OF ARBORICULTURE.
- TREE STAKING MATERIALS, IF USED, SHALL BE REMOVED AFTER (1) GROWING SEASON, NO MORE THAN (1) YEAR AFTER INSTALLATION (STEEL TREE STAKES, WIRES, AND HOSES ARE PROHIBITED).

TREE PROTECTION NOTES:


- CONTACT DEVELOPMENT SERVICES FOR A TREE REMOVAL PERMIT PRIOR TO REMOVAL OR TRANSPLANTING OF ANY TREES.
- ALL TREES WHICH ARE TO REMAIN ON SITE SHALL BE PROTECTED WITH A (4') TALL, BRIGHTLY COLORED PLASTIC FENCE, OR SILT FENCE, PLACED AT THE DRIP LINE OF THE TREES.
- PRIOR TO THE PRE-CONSTRUCTION MEETING OR OBTAINING A GRADING PERMIT, ALL TREE MARKINGS AND PROTECTIVE FENCING SHALL BE INSTALLED BY THE OWNER AND BE INSPECTED BY DEVELOPMENT SERVICES.
- NO EQUIPMENT SHALL BE CLEANED, OR HARMFUL LIQUIDS DEPOSITED WITHIN THE LIMITS OF THE ROOT ZONE OF TREES WHICH REMAIN ON SITE.
- NO SIGNS, WIRES, OR OTHER ATTACHMENTS SHALL BE ATTACHED TO ANY TREE TO REMAIN ON SITE.
- VEHICULAR AND CONSTRUCTION EQUIPMENT SHALL NOT PARK OR DRIVE WITHIN THE LIMITS OF THE DRIP LINE.
- GRADE CHANGES IN EXCESS OF 3 INCHES (CUT OR FILL) SHALL NOT BE ALLOWED WITHIN A ROOT ZONE, UNLESS ADEQUATE TREE PRESERVATION METHODS ARE APPROVED BY THE CITY.
- NO TRENCHING SHALL BE ALLOWED WITHIN THE DRIP-LINE OF A TREE, UNLESS APPROVED BY THE CITY.
- ALL REMOVED TREES SHALL BE CHIPPED AND USED FOR MULCH ON SITE OR HAULED OFF-SITE.
- ALL TREE MAINTENANCE TECHNIQUES SHALL BE IN CONFORMANCE WITH INDUSTRY IDENTIFIED STANDARDS. IMPROPER OR MALICIOUS PRUNING TECHNIQUES ARE STRICTLY PROHIBITED.

F:\civil 3d projects\2209 - marina villages - townhomes - rockwall\landscape\2209 - tree survey plan.dwg

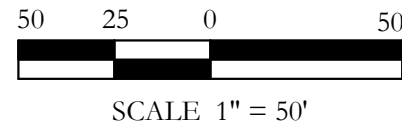

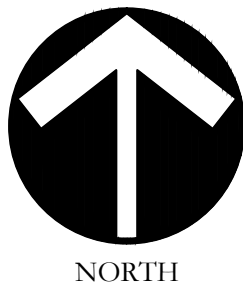

SCALE:
1" = 50'
One Inch
JVC No 2209

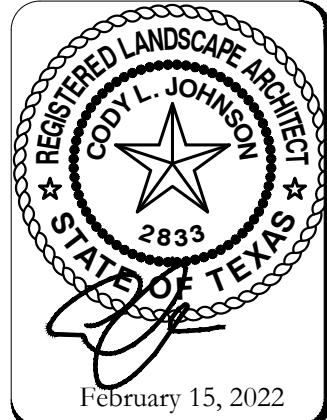

TREE SURVEY PLAN
TREE SURVEY PLAN

MARINA VILLAGE TOWNHOMES
CITY OF ROCKWALL
ROCKWALL COUNTY, TEXAS

F:\civil 3d projects\2209 - marina villages - townhomes - rockwall\landscpe\2209 - tree survey plan.dwg



LEGEND

7

EXISTING TREE TO BE REMOVED

23

EXISTING TREE TO REMAIN

TREE PROTECTION FENCE, TYP.

- TREE PROTECTION NOTES
1.


EXISTING TREES SHOWN TO REMAIN ARE TO BE PROTECTED DURING CONSTRUCTION. ORANGE COATED CHAINLINK FENCING (MIN. 4'-0" HEIGHT) SHALL BE INSTALLED AT THE DRIP LINE OF ALL TREES OR TREE GROUPS TO REMAIN. PARKING OF VEHICLES OR PERFORMING WORK WITHIN THESE AREAS OTHER THAN SHOWN ON THE PLAN, WILL NOT BE ALLOWED. THE TREE PROTECTION SHALL REMAIN DURING CONSTRUCTION. OTHER TREE PROTECTION MEASURES SHALL BE IN ACCORDANCE WITH THE CITY'S STANDARDS AND ORDINANCES.
2.

DISPOSAL OF ANY WASTE MATERIAL SUCH AS, BUT NOT LIMITED TO, PAINT, ASPHALT, OIL, SOLVENTS, CONCRETE, MORTAR, ETC. WITHIN THE CANOPY AREA OF THE EXISTING TREES SHALL NOT BE ALLOWED.
3.

NO ATTACHMENTS OR WIRES OF ANY KIND, OTHER THAN THOSE OF A PROTECTIVE NATURE, SHALL BE ATTACHED TO ANY TREE.
4.


NO FILL OR EXCAVATION OF ANY NATURE SHALL OCCUR WITHIN THE DRIP LINE OF A TREE TO BE PRESERVED, UNLESS THERE IS A SPECIFIED WELL OR RETAINING WALL SHOWN ON THE GRADING PLAN.
5.

NO MATERIALS SHALL BE STORED WITHIN THE DRIPLINE AREA OF A TREE TO BE PRESERVED

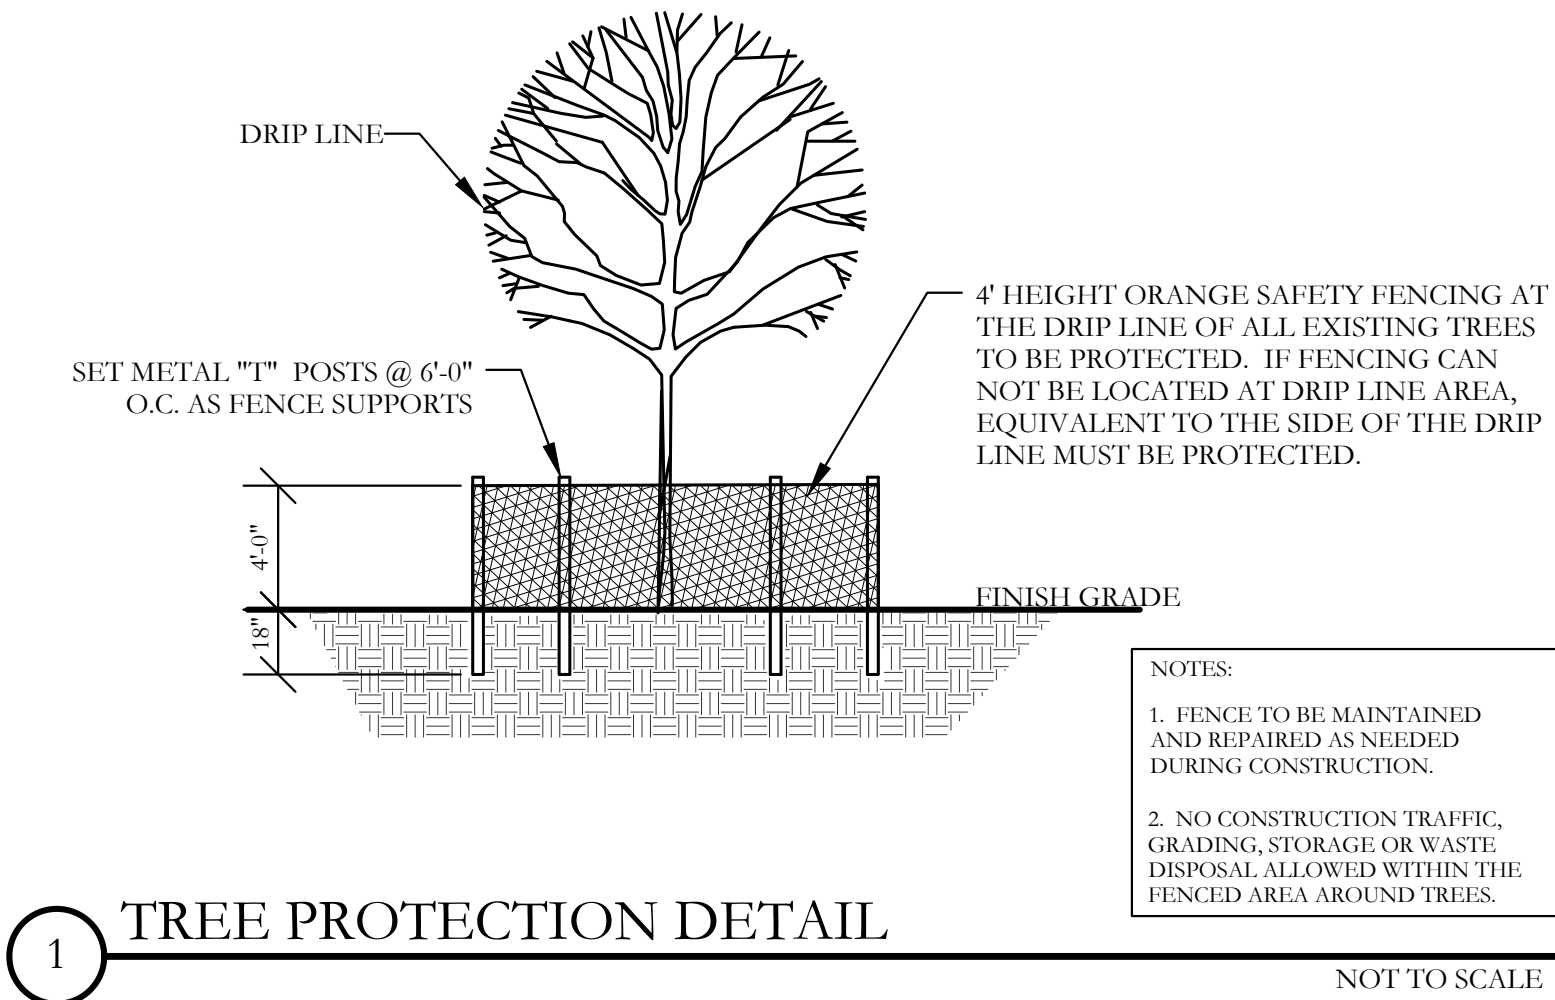

F:\civil 3d projects\2209 - marina villages - townhomes - rockwall\landscape\2209 - tree survey plan.dwg

Tree ID Number	Diameter at Breast Height (DBH) (inches)	Common Name	Scientific Name	Protected Tree?	Condition	Comment	Location	Remove or Remain	Mitigation Required, Percentage	Mitigation Required in Caliper Inches
0	28.0	Mesquite	Prosopis spp.	Yes	Healthy	Multi-trunk		Remove	100%	28.0
1	40.0	Bois d'Arc	Machua pomifera	No	Damaged	Leaning/Fall Hazard		Remove	0%	0.0
2	20.0	Bois d'Arc	Machua pomifera	No	Healthy			Remove	0%	0.0
3	8.0	Hackberry	Celtis occidentalis	No	Healthy			Remove	0%	0.0
4	12.0	Crape Myrtle	Lagerostroemia indica	Yes	Healthy			Remove	100%	12.0
5	8.0	Hackberry	Celtis occidentalis	No	Healthy	Multi-trunk		Remove	0%	0.0
6	14.0	Hackberry	Celtis occidentalis	Yes	Healthy			Remove	50%	7.0
7	14.0	Cedar Elm	Ulmus crassifolia	Yes	Healthy			Remove	100%	14.0
8	9.0	Eastern Red Cedar	Juniperus viginiana	No	Healthy			Remain		0.0
9	12.0	Hackberry	Celtis occidentalis	Yes	Healthy			Remain		0.0
10	19.0	Hackberry	Celtis occidentalis	Yes	Healthy			Remain		0.0
11	44.0	Hackberry	Celtis occidentalis	Yes	Healthy			Remain		0.0
12	21.0	Hackberry	Celtis occidentalis	Yes	Healthy			Remain		0.0
13	11.0	Hackberry	Celtis occidentalis	No	Healthy			Remain		0.0
14	24.0	Hackberry	Celtis occidentalis	Yes	Healthy	Multi-trunk		Remain		0.0
15	34.0	Eastern Red Cedar	Juniperus viginiana	Yes	Healthy	Multi-trunk		Remain		0.0
16	35.0	Eastern Red Cedar	Juniperus viginiana	Yes	Healthy	Multi-trunk		Remain		0.0
17	12.0	Eastern Red Cedar	Juniperus viginiana	Yes	Healthy			Remain		0.0
18	9.0	Eastern Red Cedar	Juniperus viginiana	No	Healthy			Remain		0.0
19	29.0	Bois d'Arc	Machua pomifera	No	Healthy	Multi-trunk		Remain		0.0
20	10.0	Eastern Red Cedar	Juniperus viginiana	No	Healthy			Remain		0.0
21	12.0	Green Ash	Fraxinus pennsylvanica	Yes	Healthy			Remain		0.0
22	10.0	Eastern Red Cedar	Juniperus viginiana	No	Healthy			Remain		0.0
23	9.0	Eastern Red Cedar	Juniperus viginiana	No	Healthy			Remain		0.0
24	15.0	Hackberry	Celtis occidentalis	Yes	Healthy			Remain		0.0
25	8.0	Eastern Red Cedar	Juniperus viginiana	No	Healthy			Remain		0.0
26	7.0	Hackberry	Celtis occidentalis	No	Healthy			Remain		0.0
27	29.0	Eastern Red Cedar	Juniperus viginiana	Yes	Healthy	Multi-trunk		Remain		0.0
28	12.0	Hackberry	Celtis occidentalis	Yes	Healthy			Remain		0.0
29	21.0	Green Ash	Fraxinus pennsylvanica	Yes	Healthy	Multi-trunk		Remain		0.0
30	7.0	Green Ash	Fraxinus pennsylvanica	Yes	Healthy	Multi-trunk		Remain		0.0
31	20.0	Hackberry	Celtis occidentalis	Yes	Healthy			Remove	50%	10.0
32	24.0	Eastern Red Cedar	Juniperus viginiana	Yes	Healthy	Multi-trunk		Remove	50%	12.0
33	23.0	Hackberry	Celtis occidentalis	Yes	Healthy	Multi-trunk		Remove	50%	11.5
34	9.0	Hackberry	Celtis occidentalis	No	Healthy			Remove	0%	0.0
35	20.0	Hackberry	Celtis occidentalis	Yes	Healthy	Multi-trunk		Remove	50%	10.0
36	24.0	Green Ash	Fraxinus pennsylvanica	Yes	Healthy	Multi-trunk		Remove	100%	24.0
37	12.0	Hackberry	Celtis occidentalis	Yes	Healthy			Remove	50%	6.0
38	21.0	Hackberry	Celtis occidentalis	Yes	Healthy	Multi-trunk		Remove	50%	10.5
39	19.0	Hackberry	Celtis occidentalis	Yes	Healthy			Remove	50%	9.5
40	21.0	Hackberry	Celtis occidentalis	Yes	Healthy			Remove	50%	10.5
41	24.0	Hackberry	Celtis occidentalis	Yes	Healthy	Multi-trunk		Remove	50%	12.0
42	17.0	Hackberry	Celtis occidentalis	Yes	Healthy			Remove	50%	8.5
43	12.0	Hackberry	Celtis occidentalis	Yes	Healthy			Remove	50%	6.0
										191.5
	Total Tree Population									Total Tree Replacement, caliper inches

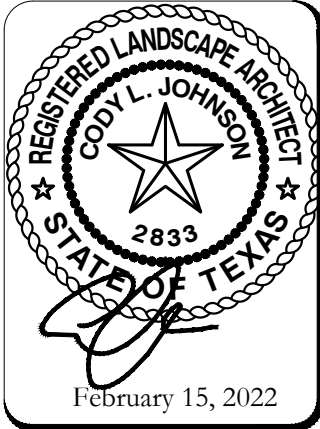

SCALE:

One Inch
JVC No 2209

TR3 of 3

TREE SURVEY PLAN
TREE SURVEY DETAILS

MARINA VILLAGE TOWNHOMES
CITY OF ROCKWALL
ROCKWALL COUNTY, TEXAS

Mapcheck 1: MARINA VILLAGE

Closure Summary

Precision, 1 part in: 1438904.41'
Error distance: 0.00'
Error direction: S23°37'10.02"W
Area: 300075.68 Sq. Ft.
Square area: 300075.68
Perimeter: 2677.88'

Point of Beginning

Easting: 2588822.58'
Northing: 7007539.35'

Side 1: Line

Direction: S04°01'18"E
Angle: [-004.02 (d)]
Deflection angle: [175.98 (d)]
Distance: 39.64'
Easting: 2588825.36'
Northing: 7007499.81'

Side 2: Line

Direction: S49°01'18"E
Angle: [135.00 (d)]
Deflection angle: [-045.00 (d)]
Distance: 160.16'
Easting: 2588946.28'
Northing: 7007394.78'

Side 3: Line

Direction: S36°41'52"W
Angle: [-094.28 (d)]
Deflection angle: [085.72 (d)]
Distance: 180.50'
Easting: 2588838.41'
Northing: 7007250.06'

Side 4: Line

Direction: S04°01'18"E
Angle: [139.28 (d)]
Deflection angle: [-040.72 (d)]
Distance: 142.73'
Easting: 2588848.42'
Northing: 7007107.68'

Side 5: Line

Direction: S47°49'42"W
Angle: [-128.15 (d)]
Deflection angle: [051.85 (d)]

Distance: 95.59'
Easting: 2588777.58'
Northing: 7007043.50'

Side 6: Line

Direction: S40°58'42"W
Angle: [173.15 (d)]
Deflection angle: [-006.85 (d)]
Distance: 56.00'
Easting: 2588740.85'
Northing: 7007001.23'

Side 7: Line

Direction: S49°01'18"E
Angle: [090.00 (d)]
Deflection angle: [-090.00 (d)]
Distance: 203.00'
Easting: 2588894.11'
Northing: 7006868.10'

Side 8: Line

Direction: S40°58'42"W
Angle: [-090.00 (d)]
Deflection angle: [090.00 (d)]
Distance: 480.10'
Easting: 2588579.27'
Northing: 7006505.65'

Side 9: Line

Direction: N15°09'39"W
Angle: [-056.14 (d)]
Deflection angle: [123.86 (d)]
Distance: 407.29'
Easting: 2588472.76'
Northing: 7006898.76'

Side 10: Line

Direction: N02°08'12"W
Angle: [-166.98 (d)]
Deflection angle: [013.02 (d)]
Distance: 70.75'
Easting: 2588470.12'
Northing: 7006969.46'

Side 11: Line

Direction: N21°26'12"W
Angle: [160.70 (d)]
Deflection angle: [-019.30 (d)]
Distance: 156.54'

Easting: 2588412.91'
Northing: 7007115.18'

Side 12: Line

Direction: N32°04'21"W
Angle: [169.36 (d)]
Deflection angle: [-010.64 (d)]
Distance: 109.80'
Easting: 2588354.60'
Northing: 7007208.22'

Side 13: Line

Direction: N57°55'37"E
Angle: [-090.00 (d)]
Deflection angle: [090.00 (d)]
Distance: 90.00'
Easting: 2588430.87'
Northing: 7007256.01'

Side 14: Line

Direction: N44°54'57"E
Angle: [166.99 (d)]
Deflection angle: [-013.01 (d)]
Distance: 54.37'
Easting: 2588469.26'
Northing: 7007294.51'

Side 15: Curve

Curve direction: Clockwise
Radius: [471.20']
Arc length: 153.06'
Delta angle: 018.61 (d)
Tangent: [77.21']
Chord direction: N54°13'19"E
Chord angle: [-170.69 (d)]
Deflection angle: [009.31 (d)]
Chord distance: 152.39'
Easting: 2588592.89'
Northing: 7007383.60'

Side 16: Curve

Curve direction: Counter-clockwise
Radius: [1039.99']
Arc length: 278.35'
Delta angle: 015.34 (d)
Tangent: [140.01']
Chord direction: N55°51'37"E
Chord angle: [172.33 (d)]

Deflection angle: [-007.67 (d)]

Chord distance: 277.52'

Easting: 2588822.58'

Northing: 7007539.35'

PROJECT COMMENTS



CITY OF ROCKWALL
385 S. GOLIAD STREET
ROCKWALL, TEXAS 75087
PHONE: (972) 771-7700

DATE: 10/20/2022

PROJECT NUMBER: P2022-056
PROJECT NAME: Final Plat for Marina Village
SITE ADDRESS/LOCATIONS:

CASE MANAGER: Bethany Ross
CASE MANAGER PHONE: (972) 772-6488
CASE MANAGER EMAIL: bross@rockwall.com

CASE CAPTION: Discuss and consider a request by Ryan Joyce of Michael Joyce Properties on behalf of William Johnson of LTL Family Holdings, LLC for the approval of a Final Plat for the Marina Village Subdivision being a 6.88-acre tract of land identified as Lot 4, Block A, Spyglass Hill #4 Addition and Tract 134-12 of the E. Teal Survey, Abstract No. 207, City of Rockwall, Rockwall County, Texas, zoned Planned Development District 8 (PD-8) [Ordinance No. 92-39] for Zero Lot Line (ZL-5) District land uses, generally located on the south side of Henry M. Chandler Drive west of Ridge Road [FM-740], and take any action necessary.

DEPARTMENT	REVIEWER	DATE OF REVIEW	STATUS OF PROJECT
PLANNING	Ryan Miller	10/20/2022	Approved w/ Comments

10/20/2022: P2022-056: Final Plat for Marina Villages

Please address the following comments (M= Mandatory Comments; I = Informational Comments)

I.1 This is a request by Ryan Joyce of Michael Joyce Properties on behalf of William Johnson of LTL Family Holdings, LLC for the approval of a Final Plat for the Marina Village Subdivision being a 6.88-acre tract of land identified as Lot 4, Block A, Spyglass Hill #4 Addition and Tract 134-12 of the E. Teal Survey, Abstract No. 207, City of Rockwall, Rockwall County, Texas, zoned Planned Development District 8 (PD-8) [Ordinance No. 92-39] for Zero Lot Line (ZL-5) District land uses, and generally located on the south side of Henry M. Chandler Drive west of Ridge Road [FM-740].

I.2 For questions or comments concerning this case please contact Bethany Ross in the Planning Department at (972) 772-6488 or email bross@rockwall.com.

M.3 For reference, include the case number (P2022-056) in the lower right-hand corner of all pages on future submittals.

M.4 Change lots 1X, 30X, and 31X to Lots 1, 30 and 31.

M.5 Please correct the Title Block to the following:

Final Plat
Lots 1-39, Block A
Marina Village
6.889 Acres (300,084 SF)
36 Townhome Lots and 4 Common Areas
Situated within
The Edward Teal Survey, Abstract No. 207
City of Rockwall, Rockwall County, Texas

M.6 Indicate the percentage of open space to show conformance to Planned Development District 8 (PD-8).

M.7 Please review and correct all items listed by the Engineering Department.

I.8 Staff has identified the aforementioned items necessary to continue the submittal process. Please make all revisions and corrections and return to staff as soon as possible for a subsequent review prior to approval. The Planning and Zoning Commission Meeting for this case will be held on November 15, 2022.

I.9 The projected meeting dates for this case are as follows:

I.10 Please note that once the Final Plat has been approved by the Planning and Zoning Commission and City Council, the case will be considered to be conditionally approved pending all of staff's comments from all City Departments and any applicable conditions of approval contained in staff's case memo are addressed prior to the subdivision plat being filed.

DEPARTMENT	REVIEWER	DATE OF REVIEW	STATUS OF PROJECT
ENGINEERING	Sarah Johnston	10/19/2022	Needs Review

10/19/2022: - Overlapping text. Cant read distance.

- Need bearing and distances for WLE.

- Label line.

- Add Note on Landscape plan regarding tree planting clearance from public water and sanitary sewer. See markup on sheet L5.

- Add Note:

No tree to be planted within 5' of any public water or sanitary sewer line with a diameter of less than 10-inches or 10' of any public water or sanitary sewer line with a diameter 10-inches or larger

DEPARTMENT	REVIEWER	DATE OF REVIEW	STATUS OF PROJECT
BUILDING	Ryan Miller	10/20/2022	N/A

No Comments

DEPARTMENT	REVIEWER	DATE OF REVIEW	STATUS OF PROJECT
FIRE	Ariana Kistner	10/20/2022	Approved

No Comments

DEPARTMENT	REVIEWER	DATE OF REVIEW	STATUS OF PROJECT
GIS	Lance Singleton	10/17/2022	Approved w/ Comments

10/17/2022: Please submit a CAD (.dwg) of the road centerlines and lot lines so addressing can begin.


Send to lsingleton@rockwall.com

DEPARTMENT	REVIEWER	DATE OF REVIEW	STATUS OF PROJECT
POLICE	Chris Cleveland	10/17/2022	Approved

No Comments

DEPARTMENT	REVIEWER	DATE OF REVIEW	STATUS OF PROJECT
PARKS	Travis Sales	10/17/2022	Approved

No Comments

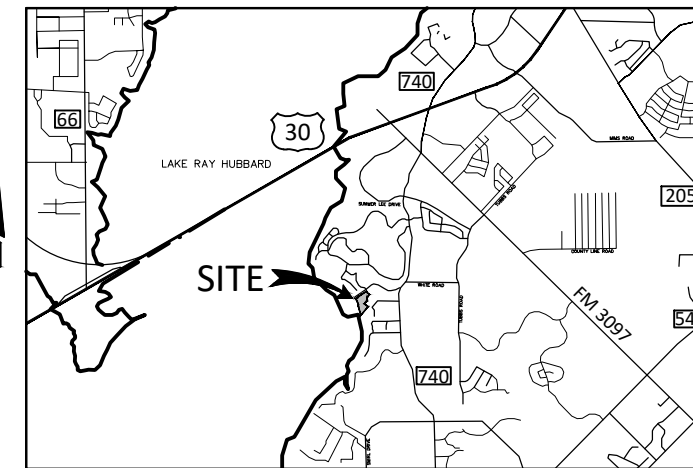

VICINITY MAP
N.T.S.


LEGEND

- Point of Curvature or Tangency on Center Line
- 1/2" Iron rod set with a yellow plastic cap stamped "JVC" (unless otherwise noted)
- 1/2" IRF (unless otherwise noted)

AC	Acre
BL	Building Line
C1	Curve No.
<CM>	Control Monument
DE	Drainage Easement
WLE	Water Line Easement
SSE	Sanitary Sewer Easement
Esmt	Easement
L1	Line No.
SF	Square Feet
UE	Utility Easement
PE	Pedestrian Easement
PUDE	Pedestrian, Utility & Drainage Easement
VAM	Visibility Easement

D.R.R.C.T.= Deed Records of Rockwall County, Texas
P.R.R.C.T.= Plat Records of Rockwall County, Texas
M.R.R.C.T.= Map Records of Rockwall County, Texas
O.R.R.C.T.= Official Records of Rockwall County, Texas

Easement Abandonment

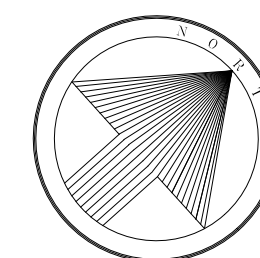

SCALE 1" = 60'

FINAL PLAT MARINA VILLAGE

LOTS 1X, 2-29, 30X, 31X, 32-39 BLOCK A
6.889 ACRES

36 TOWNHOME LOTS AND
4 COMMON AREAS

SITUATED WITHIN THE
EDWARD TEAL SURVEY, ABSTRACT NO. 207

CITY OF ROCKWALL
ROCKWALL COUNTY, TEXAS

P2022-008

October 14, 2022

SHEET 1 OF 2



JBPELS: Engineering Firm No. 11962 / Land Surveying Firm No. 10194033
704 Central Parkway East | Suite 1200 | Plano, TX 75074 | 972.201.3100

Owner/Applicant:
LTL Family Holdings, LLC
William Johnson
14918 Mystic Terrace Lane
Cyprus, Texas 77429
Phone: 713-325-4294

Engineer/Surveyor:
Johnson Volk Consulting, Inc.
704 Central Parkway East, Suite. 1200
Plano, Texas 75074
Phone: 682-225-7189
Contact: Tom Dayton, PE

TRACT ONE
RAY HUBBARD
DOCUMENT NO. 2016-22170
D.R.R.C.T.

HARBOR LANDING PHASE TWO
CABINET C, PAGE 110
M.R.R.C.T.

HARBOR LANDING PHASE ONE
CABINET B, PAGE 362
M.R.R.C.T.

Overlapping text.
Cant read distance.

Need bearing and
distances for WLE

Label line.

POINT OF
BEGINNING

Add Note on Landscape
plan regarding tree planting
clearance from public water
and sanitary sewer. See
markup on sheet L5

GENERAL NOTES:

- ALL LOT CORNERS MONUMENTED WITH A 1/2" IRON ROD WITH A YELLOW PLASTIC CAP STAMPED "JVC" UNLESS OTHERWISE NOTED.
- ALL UTILITY EASEMENTS AND DRAINAGE EASEMENTS WITHIN THIS PLATTED PROPERTY ARE CREATED BY THIS PLAT, UNLESS OTHERWISE NOTED.
- BASIS OF BEARING AND COORDINATES SHOWN HEREON REFER TO "TEXAS STATE PLANE COORDINATE SYSTEM, NORTH CENTRAL ZONE (+4202), NORTH AMERICAN DATUM OF 1983 ON GRID COORDINATE VALUES.
- LOCATION OF 1% ANNUAL FLOOD CHANCE ESTIMATED FROM FEMA FIRM PANEL 48139C0325F DATED JUNE 3, 2013.
- LOTS ADJACENT TO FLOODPLAIN SHALL HAVE A MINIMUM FINISHED FLOOR ELEVATION 2' ABOVE THE 100-YR WSEL.
- IT SHALL BE THE POLICY OF THE CITY OF ROCKWALL TO WITHHOLD ISSUING BUILDING PERMITS UNTIL ALL STREETS, WATER, SEWER AND STORM DRAINAGE SYSTEMS HAVE BEEN ACCEPTED BY THE CITY. THE APPROVAL OF A PLAT BY THE CITY DOES NOT CONSTITUTE ANY REPRESENTATION, ASSURANCE OR GUARANTEE THAT ANY BUILDING WITHIN SUCH PLAT SHALL BE APPROVED, AUTHORIZED OR PERMIT THEREFORE ISSUED, NOR SHALL SUCH APPROVAL CONSTITUTE ANY REPRESENTATION, ASSURANCE OR GUARANTEE BY THE CITY OF THE ADEQUACY AND AVAILABILITY FOR WATER FOR PERSONAL USE AND FIRE PROTECTION WITHIN SUCH PLAT, AS REQUIRED UNDER ORDINANCE 83-54.
- PROPERTY OWNER SHALL BE RESPONSIBLE FOR MAINTAINING, REPAIRING, AND REPLACING ALL SYSTEMS WITHIN THE DRAINAGE AND DETENTION EASEMENTS.
- ALL ROW, PAVING AND DRAINAGE SHALL BE PRIVATE AND MAINTAINED, REPLACED AND REPAIRED BY HOA/PROPERTY OWNER.

BENCHMARKS

CITY OF ROCKWALL MONUMENT NO. COR-5:
STANDARD CITY OF ROCKWALL CONTROL MONUMENT LOCATED AT THE NORTHEAST CORNER OF THE INTERSECTION OF HENRY W. CHANDLER DRIVE AND COMMODORE PLAZA APPROXIMATELY 400' WEST OF THE INTERSECTION OF HENRY W. CHANDLER DRIVE AND RIDGE ROAD.
ELEVATION = PLAN 560.58' FIELD 561.09'

CITY OF ROCKWALL MONUMENT NO. COR-7:
STANDARD CITY OF ROCKWALL CONTROL MONUMENT LOCATED ON THE SOUTH SIDE OF SUMMER LEE DRIVE APPROXIMATELY 250' WEST OF THE INTERSECTION OF SUMMER LEE DRIVE AND RIDGE ROAD.
ELEVATION = PLAN 567.52' FIELD 567.78'

CITY OF ROCKWALL MONUMENT NO. COR-10:
BRASS DISK STAMPED "CITY OF ROCKWALL SURVEY MONUMENT" ON THE SOUTHEAST SIDE OF LAGUNA DRIVE AT THE SOUTHEAST CORNER OF A CURB INLET APPROXIMATELY 325' NORTHEAST OF THE INTERSECTION OF VILLAGE LANE AND LAGUNA DRIVE.
ELEVATION = PLAN 521.61' FIELD 521.57'

CITY OF ROCKWALL MONUMENT NO. COR-11:
BRASS DISK STAMPED "CITY OF ROCKWALL SURVEY MONUMENT" ON THE NORTHEAST SIDE OF MIMS ROAD AT THE SOUTHERLY END OF A CONCRETE HEADWALL AT THE INTERSECTION OF THE NORTHEAST LINE OF MIMS ROAD WITH THE SOUTHEAST LINE OF I-30.
ELEVATION = PLAN 565.98' FIELD 566.02'

F:\civil 3d projects\2209 - marina villages - townhomes - rockwall\landscape\2209 - treescape planting.dwg

LANDSCAPE PROVIDED

HENRY M. CHANDLER DR.

MINIMUM TEN (10) FOOT LANDSCAPE BUFFER PROVIDED

1 - 4" CAL. CANOPY TREE & 1 ACCENT TREE / 50 LF OF LINEAR FRONTAGE
576 LF OF FRONTAGE / 50 LF = 12 - 4" CAL. TREES & 12 ACCENT TREES REQUIRED.
PROVIDED: 12 - 4" CALIPER CANOPY TREES & 13 ACCENT TREES PROVIDED

TREE MITIGATION


191.5 CAL. INCHES REMOVED

43 - 4" CAL. CANOPY TREES & 13 - 2" CAL. ACCENT TREES = 198 CAL. INCHES REPLACED.

PLANT LIST

KEY	ESTIMATED QUANTITY	COMMON NAME	SCIENTIFIC NAME	SIZE	SPACING	REMARKS
LO	13	LIVE OAK	QUERCUS VIRGINIANA	4" CALIPER	AS SHOWN	NURSERY GROWN; FULL HEAD; MINIMUM BRANCHING HEIGHT AT 6'-0"; MINIMUM 10'-0" OVERALL HEIGHT.
SO	11	SHUMARD OAK	QUERCUS SHUMARDII	4" CALIPER	AS SHOWN	NURSERY GROWN; FULL HEAD; MINIMUM BRANCHING HEIGHT AT 6'-0"; MINIMUM 10'-0" OVERALL HEIGHT.
BO	8	BUR OAK	QUERCUS MACROCARPA	4" CALIPER	AS SHOWN	NURSERY GROWN; FULL HEAD; MINIMUM BRANCHING HEIGHT AT 6'-0"; MINIMUM 10'-0" OVERALL HEIGHT.
CE	11	CEDAR ELM	ULMUS CRASSIFOLIA	4" CALIPER	AS SHOWN	NURSERY GROWN; FULL HEAD; MINIMUM BRANCHING HEIGHT AT 6'-0"; MINIMUM 10'-0" OVERALL HEIGHT.
DW	7	DESERT WILLOW	CHILOPSIS LINEARIS	2" CALIPER	AS SHOWN	NURSERY GROWN; FULL HEAD; MINIMUM 8'-0" OVERALL HEIGHT.
RB	6	TEXAS REDBUD	CERCIS CANADENSIS VAR. TEXENSIS	2" CALIPER	AS SHOWN	NURSERY GROWN; FULL HEAD; MINIMUM 8'-0" OVERALL HEIGHT.

Add Note:
No tree to be planted within 5' of any public water or sanitary sewer line with a diameter of less than 10-inches or 10' of any public water or sanitary sewer line with a diameter 10-inches or larger

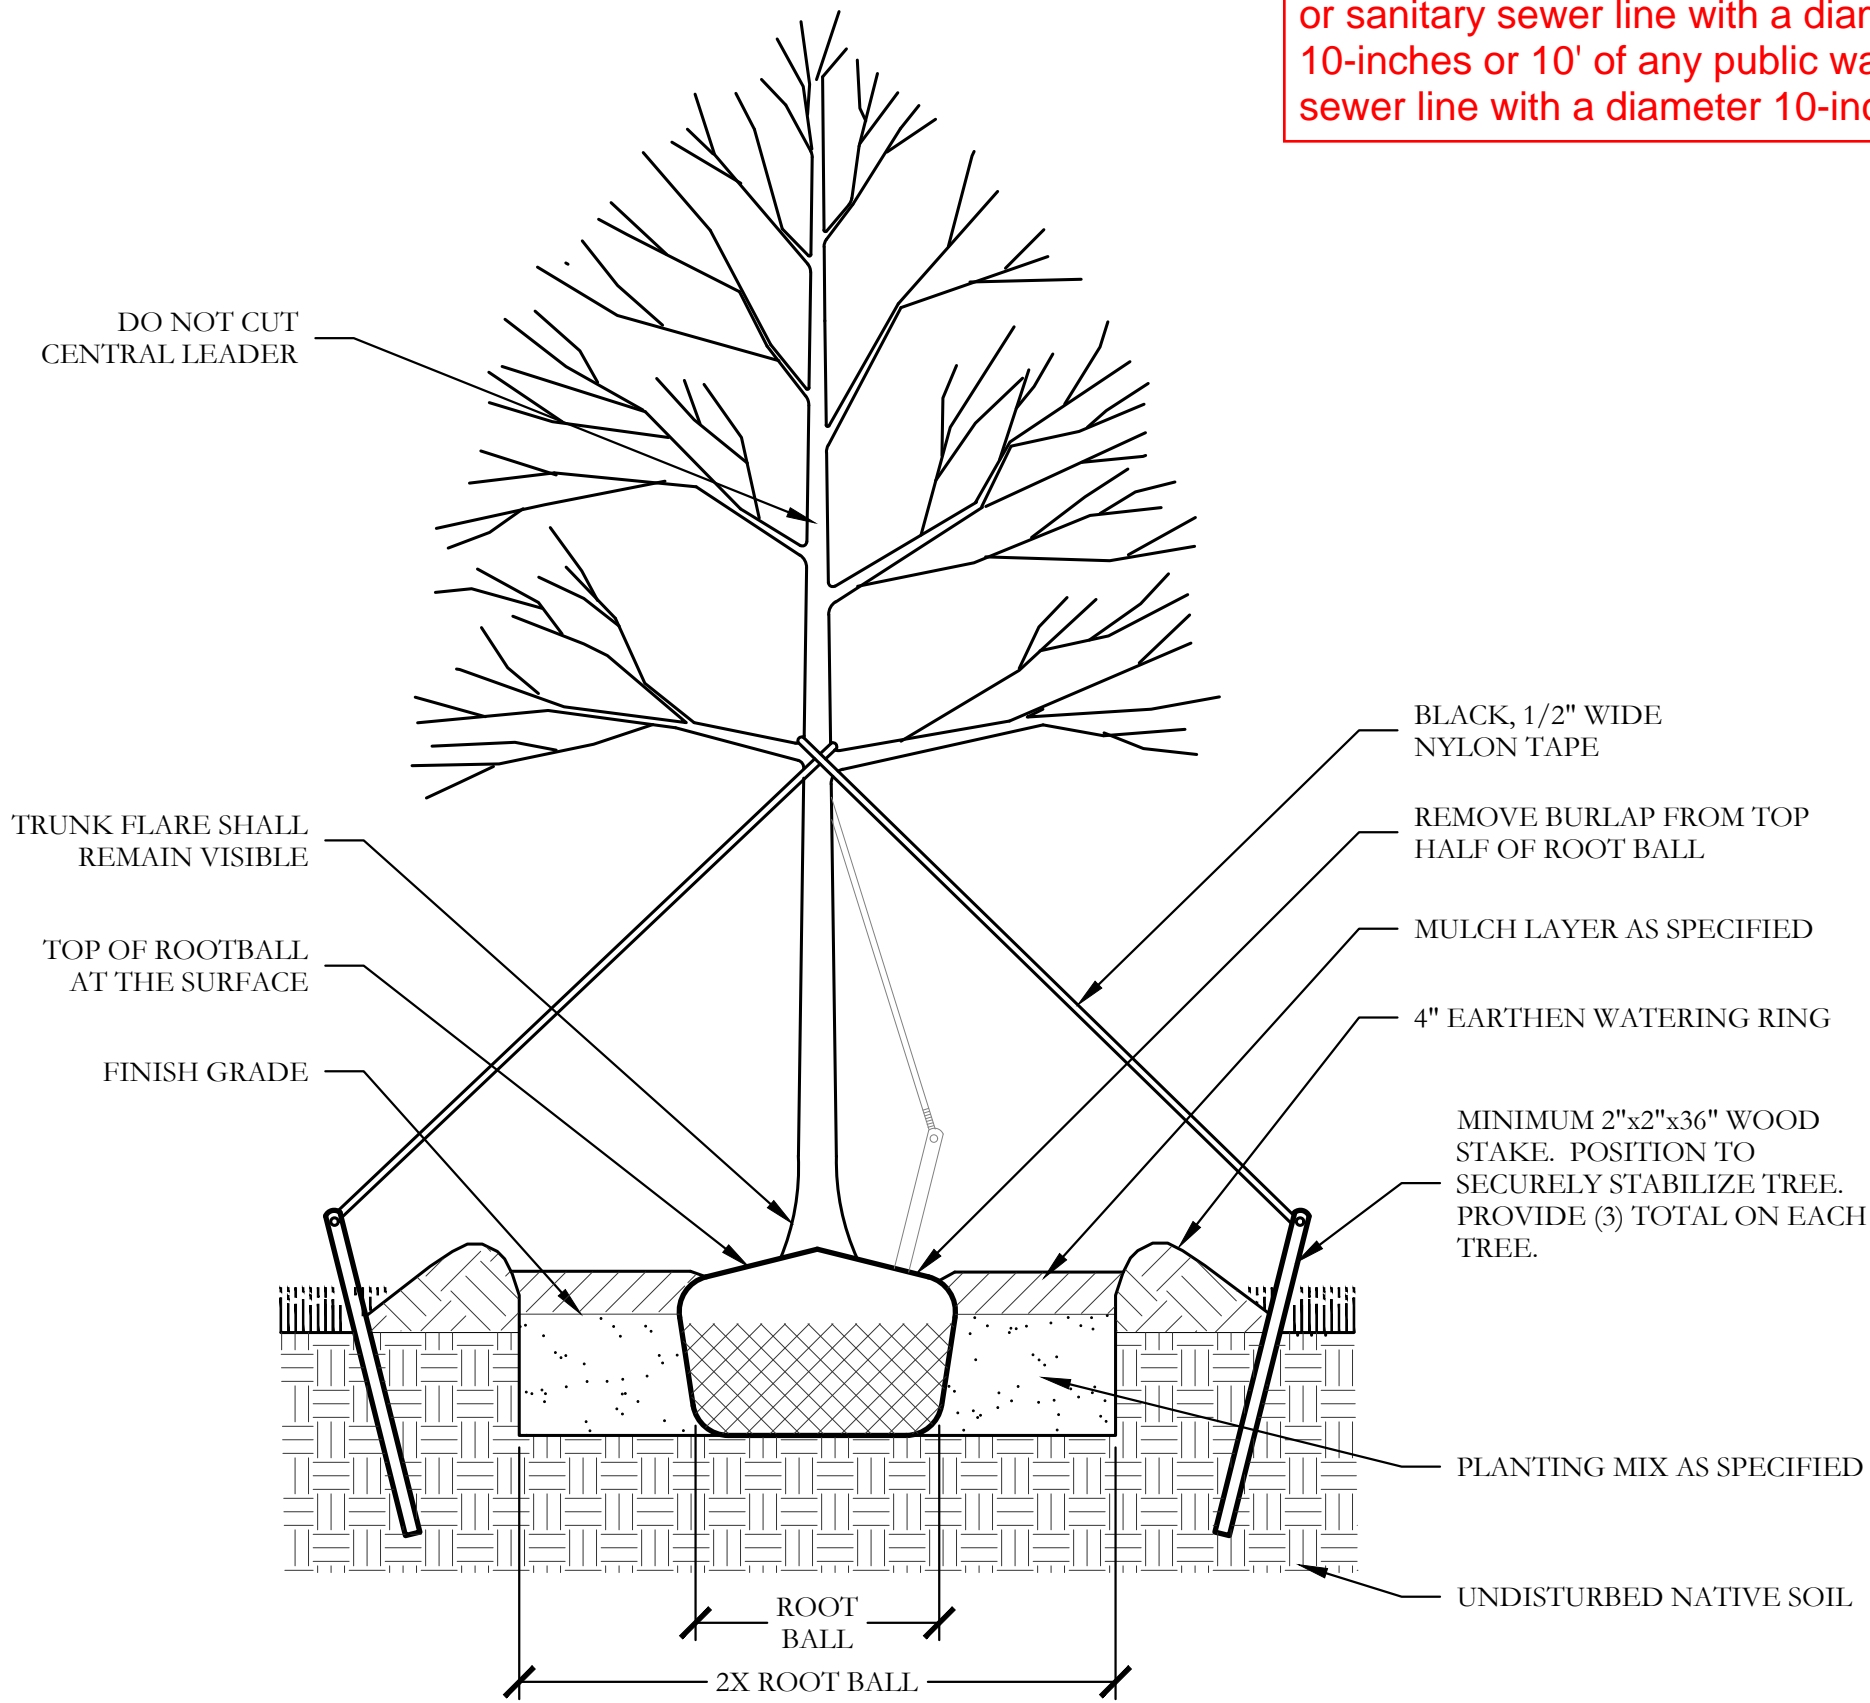

1 TYPICAL TREE PLANTING SECTION NOT TO SCALE

GENERAL LANDSCAPE NOTES

INSPECTIONS:

- NO EXCAVATION SHALL OCCUR IN CITY R.O.W. WITHOUT A R.O.W. PERMIT--CONTACT THE PUBLIC WORKS DEPARTMENT.
- THE CONTRACTOR SHALL MARK ALL WATER LINES, SEWER LINES, AND TREE LOCATIONS PRIOR TO CALLING FOR ROW INSPECTION AND PERMIT.
- THE LANDSCAPE INSTALLATION SHALL COMPLY WITH APPROVED LANDSCAPE DRAWINGS PRIOR TO FINAL ACCEPTANCE BY THE CITY AND ISSUANCE OF A CERTIFICATE OF OCCUPANCY.
- WATER METERS, CLEANOUTS AND OTHER APPURTENANCES, SHALL BE ACCESSIBLE, ADJUSTED TO GRADE, CLEARLY MARKED WITH FLAGGING AND COMPLIANT WITH PUBLIC WORKS DEPARTMENT STANDARDS PRIOR TO CALLING FOR FINAL LANDSCAPE AND ROW INSPECTIONS.

LANDSCAPE STANDARDS:

- PLANTINGS AND LANDSCAPE ELEMENTS SHALL COMPLY WITH THE CITY'S ENGINEERING DESIGN STANDARDS, PUBLIC R.O.W. VISIBILITY REQUIREMENTS.
- UNLESS OTHERWISE SPECIFIED, TREES SHALL BE PLANTED NO LESS THAN 4' FROM CURBS, SIDEWALKS, UTILITY LINES, SCREENING WALLS AND OTHER STRUCTURES. THE CITY HAS FINAL APPROVAL FOR ALL TREE PLACEMENTS.
- A MINIMUM THREE FEET (3') RADIUS AROUND A FIRE HYDRANT MUST REMAIN CLEAR OF LANDSCAPE PURSUANT TO THE FIRE CODE.
- STREET TREES, WHERE REQUIRED, SHALL BE (10') MINIMUM FROM THE EDGE OF A STORM SEWER CURB INLET BOX AND THE EDGE OF THE ROOT BALL SHALL BE (4') MINIMUM FROM THE WATER METER.
- THE AMERICAN STANDARD FOR NURSERY STOCK (ANSI Z60.1-2004) SPECIFICATIONS SHALL GOVERN PLANT QUALIFICATIONS, GRADES, AND STANDARDS.
- TREE PLANTING SHALL COMPLY WITH DETAILS HEREIN AND THE INTERNATIONAL SOCIETY OF ARBORICULTURE (ISA) STANDARDS.
- A 2-3" LAYER OF MULCH SHALL BE PROVIDED AROUND THE BASE OF THE PLANTED TREE. THE MULCH SHALL BE PULLED BACK 4" FROM THE TRUNK OF THE TREE.
- TREE PITS SHALL BE TESTED FOR WATER PERCOLATION. IF WATER DOES NOT DRAIN OUT OF TREE PIT WITHIN 24-HOURS, THE TREE SHALL BE MOVED OR DRAINAGE SHALL BE PROVIDED.
- ALL BEDS TO HAVE 3" OF COMPOSTED SOIL, LIVING EARTH TECHNOLOGY, OR APPROVED EQUAL TILLED AND TURNED TO A DEPTH OF 8" MINIMUM.
- ALL PLANT BEDS SHALL BE TOP-DRESSED WITH A MINIMUM OF 3 INCHES OF HARDWOOD MULCH.
- NATIVE SITE TOPSOIL IS TO BE PROTECTED FROM EROSION OR STOCKPILED. NATIVE SITE TOPSOIL SHALL BE LABORATORY TESTED BY AND ACCREDITED LABORATORY AND AMENDED PER SAID LABORATORY'S RECOMMENDATIONS.

IRRIGATION STANDARDS:

- ANY CHANGES TO THESE APPROVED IRRIGATION DRAWINGS SHALL BE AUTHORIZED BY THE CITY. CONTACT DEVELOPMENT SERVICES FOR AN IRRIGATION PERMIT PRIOR TO INSTALLING THE IRRIGATION SYSTEM.
- IRRIGATION OVER-SPRAY ON STREETS AND WALKS IS PROHIBITED.
- MAINLINES, VALVES, OR CONTROL WIRES SHALL NOT BE LOCATED IN THE CITY'S ROW.
- ET IRRIGATION CONTROLLERS SHALL BE PROGRAMMED AND ADJUSTED TO NOT EXCEED THE LANDSCAPE WATER ALLOWANCE (LWA) PRIOR TO APPROVAL OF LANDSCAPE INSTALLATION.
- VALVES SHALL BE LOCATED A MINIMUM OF (3') AWAY FROM STORM SEWERS, AND SANITARY SEWER LINES AND 5 FEET FROM CITY FIRE HYDRANTS AND WATER VALVES.
- THE BORE DEPTH UNDER STREETS, DRIVE AISLES, AND FIRE LANES SHALL PROVIDE (2') OF CLEARANCE (MINIMUM).
- IRRIGATION HEADS THAT RUN PARALLEL AND NEAR PUBLIC WATER AND SANITARY SEWER LINES; SHALL BE FED FROM STUBBED LATERALS OR BULL-HEADS. A MINIMUM FIVE FOOT (5') SEPARATION IS REQUIRED BETWEEN IRRIGATION MAIN LINES AND LATERALS THAT RUN PARALLEL TO PUBLIC WATER AND SANITARY SEWER LINES.
- NO VALVES, BACKFLOW PREVENTION ASSEMBLIES, QUICK COUPLERS ETC. SHALL BE LOCATED CLOSER THAN 10' FROM THE CURB AT STREET OR DRIVE INTERSECTION.

MAINTENANCE STANDARDS:

- THE OWNER SHALL BE RESPONSIBLE FOR THE ESTABLISHMENT, MAINTENANCE, AND VIGOR OF PLANT MATERIAL IN ACCORDANCE WITH THE DESIGN INTENT AND AS APPROPRIATE FOR THE SEASON OF THE YEAR.
- LANDSCAPE AND OPEN AREAS SHALL BE FREE OF TRASH, LITTER AND WEEDS.
- NO PLANT MATERIAL SHALL BE ALLOWED TO ENCROACH ON R.O.W., SIDEWALKS OR EASEMENTS TO THE EXTENT THAT VISION OR ROUTE OF TRAVEL FOR VEHICULAR, PEDESTRIAN, OR BICYCLE TRAFFIC IS IMPEDED.
- TREE MAINTENANCE SHALL BE IN ACCORDANCE WITH THE STANDARDS OF THE INTERNATIONAL SOCIETY OF ARBORICULTURE.
- TREE STAKING MATERIALS, IF USED, SHALL BE REMOVED AFTER (1) GROWING SEASON, NO MORE THAN (1) YEAR AFTER INSTALLATION (STEEL TREE STAKES, WIRES, AND HOSES ARE PROHIBITED).

TREE PROTECTION NOTES:

- CONTACT DEVELOPMENT SERVICES FOR A TREE REMOVAL PERMIT PRIOR TO REMOVAL OR TRANSPLANTING OF ANY TREES.
- ALL TREES WHICH ARE TO REMAIN ON SITE SHALL BE PROTECTED WITH A (4') TALL, BRIGHTLY COLORED PLASTIC FENCE, OR SILT FENCE, PLACED AT THE DRIP LINE OF THE TREES.
- PRIOR TO THE PRE-CONSTRUCTION MEETING OR OBTAINING A GRADING PERMIT, ALL TREE MARKINGS AND PROTECTIVE FENCING SHALL BE INSTALLED BY THE OWNER AND BE INSPECTED BY DEVELOPMENT SERVICES.
- NO EQUIPMENT SHALL BE CLEANED, OR HARMFUL LIQUIDS DEPOSITED WITHIN THE LIMITS OF THE ROOT ZONE OF TREES WHICH REMAIN ON SITE.
- NO SIGNS, WIRES, OR OTHER ATTACHMENTS SHALL BE ATTACHED TO ANY TREE TO REMAIN ON SITE.
- VEHICULAR AND CONSTRUCTION EQUIPMENT SHALL NOT PARK OR DRIVE WITHIN THE LIMITS OF THE DRIP LINE.
- GRADE CHANGES IN EXCESS OF 3 INCHES (CUT OR FILL) SHALL NOT BE ALLOWED WITHIN A ROOT ZONE, UNLESS ADEQUATE TREE PRESERVATION METHODS ARE APPROVED BY THE CITY.
- NO TRENCHING SHALL BE ALLOWED WITHIN THE DRIP-LINE OF A TREE, UNLESS APPROVED BY THE CITY.
- ALL REMOVED TREES SHALL BE CHIPPED AND USED FOR MULCH ON SITE OR HAULED OFF-SITE.
- ALL TREE MAINTENANCE TECHNIQUES SHALL BE IN CONFORMANCE WITH INDUSTRY IDENTIFIED STANDARDS. IMPROPER OR MALICIOUS PRUNING TECHNIQUES ARE STRICTLY PROHIBITED.



DEVELOPMENT APPLICATION

City of Rockwall
Planning and Zoning Department
385 S. Goliad Street
Rockwall, Texas 75087

STAFF USE ONLY

PLANNING & ZONING CASE NO. 2022-056

NOTE: THE APPLICATION IS NOT CONSIDERED ACCEPTED BY THE CITY UNTIL THE PLANNING DIRECTOR AND CITY ENGINEER HAVE SIGNED BELOW.

DIRECTOR OF PLANNING:

CITY ENGINEER:

PLEASE CHECK THE APPROPRIATE BOX BELOW TO INDICATE THE TYPE OF DEVELOPMENT REQUEST (SELECT ONLY ONE BOX):

PLATTING APPLICATION FEES:

- ☐ MASTER PLAT (\$100.00 + \$15.00 ACRE) ¹
☐ PRELIMINARY PLAT (\$200.00 + \$15.00 ACRE) ¹
☒ FINAL PLAT (\$300.00 + \$20.00 ACRE) ¹
☐ REPLAT (\$300.00 + \$20.00 ACRE) ¹
☐ AMENDING OR MINOR PLAT (\$150.00)
☐ PLAT REINSTATEMENT REQUEST (\$100.00)

SITE PLAN APPLICATION FEES:

- ☐ SITE PLAN (\$250.00 + \$20.00 ACRE) ¹
☐ AMENDED SITE PLAN/ELEVATIONS/LANDSCAPING PLAN (\$100.00)

ZONING APPLICATION FEES:

- ☐ ZONING CHANGE (\$200.00 + \$15.00 ACRE) ¹
☐ SPECIFIC USE PERMIT (\$200.00 + \$15.00 ACRE) ^{1 & 2}
☐ PD DEVELOPMENT PLANS (\$200.00 + \$15.00 ACRE) ¹

OTHER APPLICATION FEES:

- ☐ TREE REMOVAL (\$75.00)
☐ VARIANCE REQUEST/SPECIAL EXCEPTIONS (\$100.00) ²

NOTES:

¹: IN DETERMINING THE FEE, PLEASE USE THE EXACT ACREAGE WHEN MULTIPLYING BY THE PER ACRE AMOUNT. FOR REQUESTS ON LESS THAN ONE ACRE, ROUND UP TO ONE (1) ACRE.

²: A \$1,000.00 FEE WILL BE ADDED TO THE APPLICATION FEE FOR ANY REQUEST THAT INVOLVES CONSTRUCTION WITHOUT OR NOT IN COMPLIANCE TO AN APPROVED BUILDING PERMIT.

PROPERTY INFORMATION [PLEASE PRINT]

ADDRESS A0207 E Teal, Tract 134-12, Acres 2.564 Prop ID# 30591; Spyglass Hill #4, Block A, Lot 4, Acres 4.316 Prop ID# 29883

SUBDIVISION Marina Village

LOT

BLOCK

GENERAL LOCATION Henry M Chandler Dr, Behind Marina

ZONING, SITE PLAN AND PLATTING INFORMATION [PLEASE PRINT]

CURRENT ZONING PD-8, Ord No. 21-38

CURRENT USE

PROPOSED ZONING PD-8, Ord No. 21-38

PROPOSED USE Multi-Family Residential

ACREAGE 6.889

LOTS [CURRENT] 1

LOTS [PROPOSED] 36

- ☐ **SITE PLANS AND PLATS:** BY CHECKING THIS BOX YOU ACKNOWLEDGE THAT DUE TO THE PASSAGE OF HB3167 THE CITY NO LONGER HAS FLEXIBILITY WITH REGARD TO ITS APPROVAL PROCESS, AND FAILURE TO ADDRESS ANY OF STAFF'S COMMENTS BY THE DATE PROVIDED ON THE DEVELOPMENT CALENDAR WILL RESULT IN THE DENIAL OF YOUR CASE.

OWNER/APPLICANT/AGENT INFORMATION [PLEASE PRINT/CHECK THE PRIMARY CONTACT/ORIGINAL SIGNATURES ARE REQUIRED]

☐ OWNER LTL Family Holdings, LLC

☐ APPLICANT Michael Joyce Properties

CONTACT PERSON William Johnson

CONTACT PERSON Ryan Joyce

ADDRESS 14918 Mystic Terrace Lane

ADDRESS 767 Justin Road

CITY, STATE & ZIP Cypress, TX 77429

CITY, STATE & ZIP Rockwall, TX 75087

PHONE

PHONE

512-965-6280

E-MAIL

E-MAIL

ryan@michaeljoyceproperties.com

NOTARY VERIFICATION [REQUIRED]

BEFORE ME, THE UNDERSIGNED AUTHORITY, ON THIS DAY PERSONALLY APPEARED William Johnson [OWNER] THE UNDERSIGNED, WHO STATED THE INFORMATION ON THIS APPLICATION TO BE TRUE AND CERTIFIED THE FOLLOWING:

"I HEREBY CERTIFY THAT I AM THE OWNER FOR THE PURPOSE OF THIS APPLICATION; ALL INFORMATION SUBMITTED HEREIN IS TRUE AND CORRECT; AND THE APPLICATION FEE OF \$ 437.78 TO COVER THE COST OF THIS APPLICATION, HAS BEEN PAID TO THE CITY OF ROCKWALL ON THIS THE 14 DAY OF October, 2022. BY SIGNING THIS APPLICATION, I AGREE THAT THE CITY OF ROCKWALL (I.E. "CITY") IS AUTHORIZED AND PERMITTED TO PROVIDE INFORMATION CONTAINED WITHIN THIS APPLICATION TO THE PUBLIC. THE CITY IS ALSO AUTHORIZED AND PERMITTED TO REPRODUCE ANY COPYRIGHTED INFORMATION SUBMITTED IN CONJUNCTION WITH THIS APPLICATION, IF SUCH REPRODUCTION IS ASSOCIATED OR IN RESPONSE TO A REQUEST FOR PUBLIC INFORMATION."


GIVEN UNDER MY HAND AND SEAL OF OFFICE ON THIS THE 14 DAY OF October, 2022

OWNER'S SIGNATURE

[Signature]

NOTARY PUBLIC IN AND FOR THE STATE OF TEXAS

[Signature]

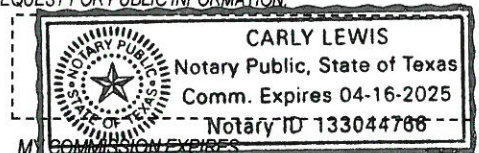

4-16-25




City of Rockwall

Planning & Zoning Department
385 S. Goliad Street
Rockwall, Texas 75032
(P): (972) 771-7745
(W): www.rockwall.com

The City of Rockwall GIS maps are continually under development and therefore subject to change without notice. While we endeavor to provide timely and accurate information, we make no guarantees. The City of Rockwall makes no warranty, express or implied, including warranties of merchantability and fitness for a particular purpose. Use of the information is the sole responsibility of the user.



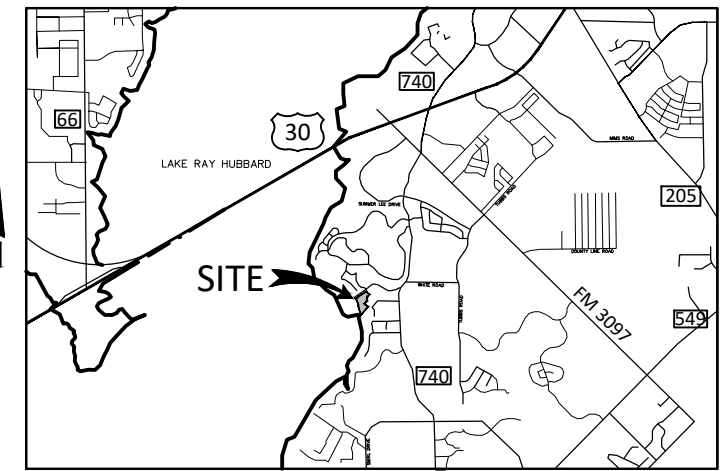

VICINITY MAP
N.T.S.


LEGEND

- Point of Curvature or Tangency on Center Line
- 1/2" Iron rod set with a yellow plastic cap stamped "JVC" (unless otherwise noted)
- 1/2" IRF (unless otherwise noted)

AC	Acre
BL	Building Line
C1	Curve No.
<CM>	Control Monument
DE	Drainage Easement
WLE	Water Line Easement
SSE	Sanitary Sewer Easement
Esmt	Easement
L1	Line No.
SF	Square Feet
UE	Utility Easement
PE	Pedestrian Easement
PUDE	Pedestrian, Utility & Drainage Easement
VAM	Visibility Easement

D.R.R.C.T.= Deed Records of Rockwall County, Texas
P.R.R.C.T.= Plat Records of Rockwall County, Texas
M.R.R.C.T.= Map Records of Rockwall County, Texas
O.R.R.C.T.= Official Records of Rockwall County, Texas

Easement Abandonment

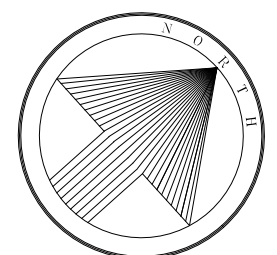

SCALE 1" = 60'

FINAL PLAT MARINA VILLAGE

LOTS 1X, 2-29, 30X, 31X, 32-39 BLOCK A
6.889 ACRES

36 TOWNHOME LOTS AND
4 COMMON AREAS

SITUATED WITHIN THE
EDWARD TEAL SURVEY, ABSTRACT NO. 207
CITY OF ROCKWALL
ROCKWALL COUNTY, TEXAS

P2022-008
October 14, 2022
SHEET 1 OF 2



JBPELS: Engineering Firm No. 11962 / Land Surveying Firm No. 10194033
704 Central Parkway East | Suite 1200 | Plano, TX 75074 | 972.201.3100

Owner/Applicant:
LTL Family Holdings, LLC
William Johnson
14918 Mystic Terrace Lane
Cyprus, Texas 77429
Phone: 713-325-4294

Engineer/Surveyor:
Johnson Volk Consulting, Inc.
704 Central Parkway East, Suite. 1200
Plano, Texas 75074
Phone: 682-225-7189
Contact: Tom Dayton, PE

TRACT ONE
RAY HUBBARD
DOCUMENT NO. 2016-22170
D.R.R.C.T.

HARBOR LANDING PHASE TWO
CABINET C, PAGE 110
M.R.R.C.T.

HARBOR LANDING PHASE ONE
CABINET B, PAGE 362
M.R.R.C.T.

EX. 15' UTILITY
EASEMENT

HARBOR LANDING DR.
EXISTING 30' W.
RIGHT-OF-WAY

HENRY M. CHANDLER DRIVE

POINT OF
BEGINNING

N: 7007539.35
E: 2588822.58

278 HENRY M CHANDLER DR

RYAN S. HUDDIN AND
JADA HUDDIN
DOCUMENT NO. 20190000001989
D.R.R.C.T.

LOT 3, BLOCK A
SPYGLASS HILL CONDOMINIUMS, PHASE 3
CABINET B, PAGE 175
M.R.R.C.T.

6,646 S.F. PORTION
OF 15' UTILITY ESMT.
TO BE ABANDONED
BY THIS PLAT
CABINET B, PG. 146-147
P.R.R.C.T.

CITY OF ROCKWALL
CITY OF HEATH

GENERAL NOTES:

- ALL LOT CORNERS MONUMENTED WITH A 1/2" IRON ROD WITH A YELLOW PLASTIC CAP STAMPED "JVC" UNLESS OTHERWISE NOTED.
- ALL UTILITY EASEMENTS AND DRAINAGE EASEMENTS WITHIN THIS PLATTED PROPERTY ARE CREATED BY THIS PLAT, UNLESS OTHERWISE NOTED.
- BASIS OF BEARING AND COORDINATES SHOWN HEREON REFER TO "TEXAS STATE PLANE COORDINATE SYSTEM, NORTH CENTRAL ZONE (4202), NORTH AMERICAN DATUM OF 1983 ON GRID COORDINATE VALUES.
- LOCATION OF 1% ANNUAL FLOOD CHANCE ESTIMATED FROM FEMA FIRM PANEL 48139C0325F DATED JUNE 3, 2013.
- LOTS ADJACENT TO FLOODPLAIN SHALL HAVE A MINIMUM FINISHED FLOOR ELEVATION 2' ABOVE THE 100-YR WSEL.
- IT SHALL BE THE POLICY OF THE CITY OF ROCKWALL TO WITHHOLD ISSUING BUILDING PERMITS UNTIL ALL STREETS, WATER, SEWER AND STORM DRAINAGE SYSTEMS HAVE BEEN ACCEPTED BY THE CITY. THE APPROVAL OF A PLAT BY THE CITY DOES NOT CONSTITUTE ANY REPRESENTATION, ASSURANCE OR GUARANTEE THAT ANY BUILDING WITHIN SUCH PLAT SHALL BE APPROVED, AUTHORIZED OR PERMIT THEREFORE ISSUED, NOR SHALL SUCH APPROVAL CONSTITUTE ANY REPRESENTATION, ASSURANCE OR GUARANTEE BY THE CITY OF THE ADEQUACY AND AVAILABILITY FOR WATER FOR PERSONAL USE AND FIRE PROTECTION WITHIN SUCH PLAT, AS REQUIRED UNDER ORDINANCE 83-54.
- PROPERTY OWNER SHALL BE RESPONSIBLE FOR MAINTAINING, REPAIRING, AND REPLACING ALL SYSTEMS WITHIN THE DRAINAGE AND DETENTION EASEMENTS.
- ALL ROW, PAVING AND DRAINAGE SHALL BE PRIVATE AND MAINTAINED, REPLACED AND REPAIRED BY HOA/PROPERTY OWNER.

BENCHMARKS

CITY OF ROCKWALL MONUMENT NO. COR-5:
STANDARD CITY OF ROCKWALL CONTROL MONUMENT LOCATED AT THE NORTHEAST CORNER OF THE INTERSECTION OF HENRY W. CHANDLER DRIVE AND COMMODORE PLAZA APPROXIMATELY 400' WEST OF THE INTERSECTION OF HENRY W. CHANDLER DRIVE AND RIDGE ROAD.
ELEVATION = PLAN 560.58' FIELD 561.09'

CITY OF ROCKWALL MONUMENT NO. COR-7:
STANDARD CITY OF ROCKWALL CONTROL MONUMENT LOCATED ON THE SOUTH SIDE OF SUMMER LEE DRIVE APPROXIMATELY 250' WEST OF THE INTERSECTION OF SUMMER LEE DRIVE AND RIDGE ROAD.
ELEVATION = PLAN 567.52' FIELD 567.78'

CITY OF ROCKWALL MONUMENT NO. COR-10:
BRASS DISK STAMPED "CITY OF ROCKWALL SURVEY MONUMENT" ON THE SOUTHEAST SIDE OF LAGUNA DRIVE AT THE SOUTHEAST CORNER OF A CURB INLET APPROXIMATELY 325' NORTHEAST OF THE INTERSECTION OF VILLAGE LANE AND LAGUNA DRIVE.
ELEVATION = PLAN 521.61' FIELD 521.57'

CITY OF ROCKWALL MONUMENT NO. COR-11:
BRASS DISK STAMPED "CITY OF ROCKWALL SURVEY MONUMENT" ON THE NORTHEAST SIDE OF MIMS ROAD AT THE SOUTHERLY END OF A CONCRETE HEADWALL AT THE INTERSECTION OF THE NORTHEAST LINE OF MIMS ROAD WITH THE SOUTHEAST LINE OF I-30.
ELEVATION = PLAN 565.98' FIELD 566.02'

17,241 S.F. PORTION
OF 15' UTILITY ESMT.
TO BE ABANDONED
BY THIS PLAT
CABINET B, PG. 146-147
P.R.R.C.T.

BLOCK A
1X
88642 SF
2.03 AC
OPEN
SPACE

975 S.F. PORTION
OF 15' UTILITY ESMT.
TO BE ABANDONED
BY THIS PLAT
CABINET B, PG. 146-147
P.R.R.C.T.

15' WLE
(BY THIS PLAT)
WINDWARD SLOPE
CABINET A, PAGE 368
M.R.R.C.T.

EX. 15' UTILITY
EASEMENT

VARIABLE WIDTH
UTILITY EASEMENT

STATE OF TEXAS §
COUNTY OF ROCKWALL §

WHEREAS L.T.L. Family Holdings, LLC, BEING THE OWNER OF A TRACT OF land in the County of Rockwall, State of Texas, said tract being described as follows:

BEING a tract of land situated in the E. TEAL SURVEY, ABSTRACT NO. 207, City of Rockwall, Rockwall County, Texas and being all of Lot 4, Block A of SPYGLASS HILL CONDOMINIUMS PHASE FOUR, an Addition to the City of Rockwall, Rockwall County, Texas according to the Plat thereof recorded in Cabinet B, Page 146, Map Records, Rockwall County, Texas and being all of that tract of land described in Deed to L.T.L. Family Holdings, LLC, as recorded in Document No. 20210000034919, Deed Records, Rockwall County, Texas and being more particularly described as follows:

BEGINNING at a 1/2 inch iron rod with a yellow plastic cap stamped "BISON CREEK" found in the southeast line of Henry Chandler Drive, an 80 foot right-of-way, for the common northeast corner of said L.T.L. Family Holdings, LLC tract, northeast corner of said Lot 4 and northwest corner of Lot 3, Block A of SPYGLASS HILL CONDOMINIUMS, PHASE 3, an Addition to the City of Rockwall, Rockwall County, Texas according to the Plat thereof recorded in Cabinet B, Page 175, Map Records, Rockwall County, Texas;

THENCE Southerly, with the common east line of said Lot 4, east line of said L.T.L. Family Holdings, LLC tract and west line of said Lot 3, the following seven (7) courses and distances:

South 04 degrees 01 minutes 18 seconds East, leaving said southeast line, a distance of 39.64 feet to a 1/2 inch iron rod found for corner;

South 49 degrees 01 minutes 18 seconds East, a distance of 160.16 feet to a 1/2 inch iron rod found for corner;

South 36 degrees 41 minutes 52 seconds West, a distance of 180.50 feet to a 1/2 inch iron rod with a yellow plastic cap stamped "BISON CREEK" found for corner;

South 04 degrees 01 minutes 18 seconds East, a distance of 142.73 feet to a 1/2 inch iron rod with a yellow plastic cap stamped "BISON CREEK" found for corner;

South 47 degrees 49 minutes 42 seconds West, a distance of 95.59 feet to a 1/2 inch iron rod found for corner;

South 40 degrees 58 minutes 42 seconds West, a distance of 56.00 feet to a 1/2 inch iron rod with a yellow plastic cap stamped "BISON CREEK" found for corner;

South 49 degrees 01 minutes 18 seconds East, a distance of 203.00 feet to a 1/2 inch iron rod found in the northwest line of WINDWARD SLOPE, an Addition to the City of Rockwall, Rockwall County, Texas according to the Plat thereof recorded in Cabinet A, page 368, Map Records, Rockwall County, Texas for the common south corner of said Lot 3 and an exterior ell corner of said Lot 4 and said L.T.L. Family Holdings, LLC tract;

THENCE South 40 degrees 58 minutes 42 seconds West, with the common southeast line of said Lot 4 and said L.T.L. Family Holdings, LLC tract and said northwest line, a distance of 480.10 feet to a 1/2 inch iron rod with a yellow plastic cap stamped "JVC" set for the common south corner of said Lot 4 and said L.T.L. Family Holdings, LLC tract;

THENCE Northerly, with the west line of said L.T.L. Family Holdings, LLC tract, the following four (4) courses and distances:

North 15 degrees 09 minutes 39 seconds West, a distance of 407.29 feet to a 1/2 inch iron rod with a yellow plastic cap stamped "JVC" set for corner;

North 02 degrees 08 minutes 12 seconds West, a distance of 70.75 feet to a 1/2 inch iron rod with a yellow plastic cap stamped "BISON CREEK" found for corner;

North 21 degrees 26 minutes 12 seconds West, a distance of 156.54 feet to a 1/2 inch iron rod with a yellow plastic cap stamped "BISON CREEK" found for corner;

North 32 degrees 04 minutes 21 seconds West, a distance of 109.80 feet to a 1/2 inch iron rod with a yellow plastic cap stamped "JVC" set in the southeast line of the above mentioned Henry Chandler Drive for the northwest corner of said L.T.L. Family Holdings, LLC tract;

THENCE Northeasterly, with said southeast line, the following four (4) courses and distances:

North 57 degrees 55 minutes 37 seconds East, a distance of 90.00 feet to a 1/2 inch iron rod found for corner;

North 44 degrees 54 minutes 57 seconds East, a distance of 54.37 feet to a 1/2 inch iron rod found for corner at the beginning of a curve to the right having a central angle of 18 degrees 36 minutes 42 seconds, a radius of 471.19 feet and a chord bearing and distance of North 54 degrees 13 minutes 19 seconds East, 152.39 feet;

Northeasterly, with said curve to the right, an arc distance of 153.06 feet to a 1/2 inch iron rod with a yellow plastic cap stamped "JVC" set for corner at the beginning of a reverse curve to the left having a central angle of 15 degrees 20 minutes 06 seconds, a radius of 1,040.00 feet and a chord bearing and distance of North 55 degrees 51 minutes 37 seconds East, 277.52 feet;

Northeasterly, with said curve to the left, an arc distance of 278.35 feet to the POINT OF BEGINNING and containing 6.889 acres of land, more or less.

Line Table		
Line	Length	Direction
L1	39.64	S4° 01' 18"E
L2	56.00	S40° 58' 42"W
L3	70.75	N2° 08' 12"W
L4	48.71	N44° 54' 57"E
L5	7.87	N37° 31' 07"E
L6	75.93	N35° 35' 51"W
L7	10.11	N54° 16' 59"W
L8	34.22	S76° 43' 41"W
L9	44.06	S48° 17' 23"W
L10	51.06	S32° 31' 55"E
L11	26.01	S85° 01' 36"E
L12	21.71	N10° 45' 15"E
L13	8.92	N35° 35' 51"W
L14	28.27	S58° 28' 11"E
L15	28.28	N31° 30' 26"E
L16	28.64	S76° 19' 54"E
L17	28.68	S11° 22' 41"W

Curve Table					
Curve #	Length	Radius	Delta	Chord Length	Chord Bearing
C1	153.06	471.19	018°36'42"	152.39	N54° 13' 19"E
C2	278.35	1040.00	015°20'06"	277.52	N55° 51' 37"E
C3	96.53	250.00	022°07'23"	95.93	N24° 32' 09"W
C4	35.61	50.00	040°48'31"	34.86	S33° 52' 43"E
C5	99.27	200.00	028°26'17"	98.25	N62° 30' 32"E
C6	47.35	50.00	054°15'21"	45.60	N21° 09' 42"E
C7	77.19	250.00	017°41'27"	76.88	N14° 48' 42"W
C8	38.72	250.00	008°52'30"	38.69	N28° 05' 40"W
C9	30.07	189.50	009°05'28"	30.04	N21° 23' 59"W
C10	81.28	210.50	022°07'23"	80.77	N24° 32' 09"W
C11	10.65	20.00	030°29'56"	10.52	N01° 46' 30"E
C12	191.73	54.00	203°26'04"	105.75	N19° 00' 37"E
C13	24.17	20.00	069°13'57"	22.72	S48° 05' 27"E
C14	100.81	225.00	025°40'18"	99.97	N61° 07' 32"E
C15	10.62	225.00	002°42'17"	10.62	S28° 58' 42"E
C16	76.17	175.00	024°56'24"	75.57	N60° 45' 35"E
C17	39.36	96.46	023°22'43"	39.09	S22° 39' 49"W

OWNER'S CERTIFICATION:

NOW THEREFORE, KNOW ALL MEN BY THESE PRESENTS:

STATE OF TEXAS §
COUNTY OF ROCKWALL §

I (we) the undersigned owner(s) of the land shown on this plat, and designated herein as the MARINA VILLAGE subdivision to the City of Rockwall, Texas, and whose name is subscribed hereto, hereby dedicate to the use of the public forever any streets, alleys, parks, water courses, drains, easements and public places thereon shown on the purpose and consideration therein expressed. I (we) further certify that all other parties who have a mortgage or lien interest in the MARINA VILLAGE subdivision have been notified and signed this plat. I (we) understand and do hereby reserve the easement strips shown on this plat for the purposes stated and for the mutual use and accommodation of all utilities desiring to use or using same. I (we) also understand the following:

- No buildings shall be constructed or placed upon, over, or across the utility easements as described herein.
- Any public utility shall have the right to remove and keep removed all or part of any buildings, fences, trees, shrubs, or other growths or improvements which in any way endanger or interfere with construction, maintenance or efficiency of their respective system on any of these easement strips; and any public utility shall at all times have the right of ingress or egress to, from and upon the said easement strips for purpose of construction, reconstruction, inspecting, patrolling, maintaining, and either adding to or removing all or part of there respective system without the necessity of, at any time, procuring the permission of anyone.
- The City of Rockwall will not be responsible for any claims of any nature resulting from or occasioned by the establishment of grade of streets in the subdivision.
- The developer and subdivision engineer shall bear total responsibility for storm drain improvements.
- The developer shall be responsible for the necessary facilities to provide drainage patterns and drainage controls such that properties within the drainage area are not adversely affected by storm drainage from the development.
- No house dwelling unit, or other structure shall be constructed on any lot in this addition by the owner or any other person until the developer and/or owner has complied with all requirements of the Subdivision Regulations of the City of Rockwall regarding improvements with respect to the entire block on the street or streets on which property abuts, including the actual installation of streets with the required base and paving, curb and gutter, water and sewer, drainage structures, storm sewers, and alleys all according to the specifications of the City of Rockwall; or

Until an escrow deposit, sufficient to pay for the cost of such improvements, as determined by the city's engineer and/or city administrator, computed on a private commercial rate basis, has been made with the city secretary, accompanied by an agreement signed by the developer and/or owner, authorizing the city to make such improvements at prevailing private commercial rates, or have the same made by a contractor and pay the same out of the escrow deposit, should the developer and/or owner fail to refuse to install the required improvements within the time stated in such written agreement, but in no case shall the City be obligated to make such improvements itself. Such deposit may be used by the owner and/or developer as progress payments as the work progresses in making such improvements by making certified requisitions to the city secretary, supported by evidence of work done; or

Until the developer and/or owner files a corporate surety bond with the city secretary in a sum equal to the cost of such improvements for the designated area, guaranteeing the installation thereof within the time stated in the bond, which shall be fixed by the city council of the City of Rockwall.

I (we) further acknowledge that the dedications and/or exactions made herein are proportional to the impact of the Subdivision upon the public services required in order that the development will comport with the present and future growth needs of the City; I (we), my (our) successors and assigns hereby waive any claim, damage, or cause of action that I (we) may have as a result of the dedication of exactions made herein.

Property Owner Signature

STATE OF TEXAS §
COUNTY OF ROCKWALL §

BEFORE ME, the undersigned authority, on this day personally appeared L.T.L. Family Holdings, LLC, known to me to be the person whose name is subscribed to the foregoing instrument and acknowledged to me that he executed the same for the purpose and consideration therein stated.

Given under my hand and seal of office, this ____ day of _____, 2022.

Notary public in and for the State of Texas

My Commission Expires

STATE OF TEXAS §
COUNTY OF ROCKWALL §

BEFORE ME, the undersigned authority, on this day personally appeared L.T.L. Family Holdings, LLC, known to me to be the person whose name is subscribed to the foregoing instrument and acknowledged to me that he executed the same for the purpose and consideration therein stated.

Given under my hand and seal of office, this ____ day of _____, 2022.

Notary public in and for the State of Texas

My Commission Expires

SURVEYOR'S CERTIFICATE:

NOW, THEREFORE KNOW ALL MEN BY THESE PRESENTS:

THAT I, Ryan S. Reynolds, do hereby certify that I prepared this plat from an actual and accurate survey of the land, and that the corner monuments shown thereon were properly placed under my personal supervision.

RYAN S. REYNOLDS, R.P.L.S.
Texas Registered Professional Land Surveyor No. 6385.

STATE OF TEXAS §
COUNTY OF COLLIN §

BEFORE ME, the undersigned authority, on this day personally appeared Ryan S. Reynolds, known to me to be the person whose name is subscribed to the above and foregoing instrument, and acknowledged to me that he executed the same for the purposes and consideration expressed and in the capacity therein stated.

Given under my hand and seal of office, this ____ day of _____, 2022.

Notary public for and in the State of Texas

My commission expires: _____

Planning & Zoning Commission, Chairperson

Date

APPROVED:
I hereby certify that the above and foregoing plat of an addition to the City of Rockwall, Texas be approved by the City Council of the City of Rockwall on ____ day of _____, 2022.

This approval shall be invalid unless the approved plat for such addition is recorded in the office of the County Clerk of Rockwall, County, Texas, within one hundred eighty (180) days from said date of approval.

WITNESS OUR HANDS, this ____ day of _____, 2022.

Mayor, City of Rockwall

City Secretary

City Engineer

FINAL PLAT
MARINA VILLAGE

LOTS 1X, 2-29, 30X, 31X, 32-39 BLOCK A
6.889 ACRES

36 TOWNHOME LOTS AND

4 COMMON AREAS

SITUATED WITHIN THE

EDWARD TEAL SURVEY, ABSTRACT NO. 107

CITY OF ROCKWALL

ROCKWALL COUNTY, TEXAS

P2022-008

October 14, 2022

SHEET 2 OF 2



JOHNSON VOLK
CONSULTING

TBPELS: Engineering Firm No. 11962 / Land Surveying Firm No. 10194033
704 Central Parkway East | Suite 1200 | Plano, TX 75074 | 972.201.3100

Owner/Applicant:

LTL Family Holdings, LLC

William Johnson

14918 Mystic Terrace Lane

Cyprus, Texas 77429

Phone: 713-325-4294

Engineer/Surveyor:

Johnson Volk Consulting, Inc.




704 Central Parkway East, Suite. 1200

Plano, Texas 75074


Phone: 682-225-7189

Contact: Tom Dayton, PE

F:\level 3\projects\2209 - marina villages - townhomes - rockwall\landscapes\2209 - treescape plan.dwg

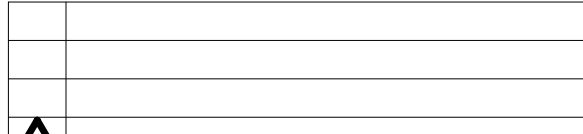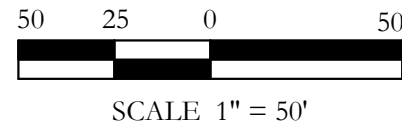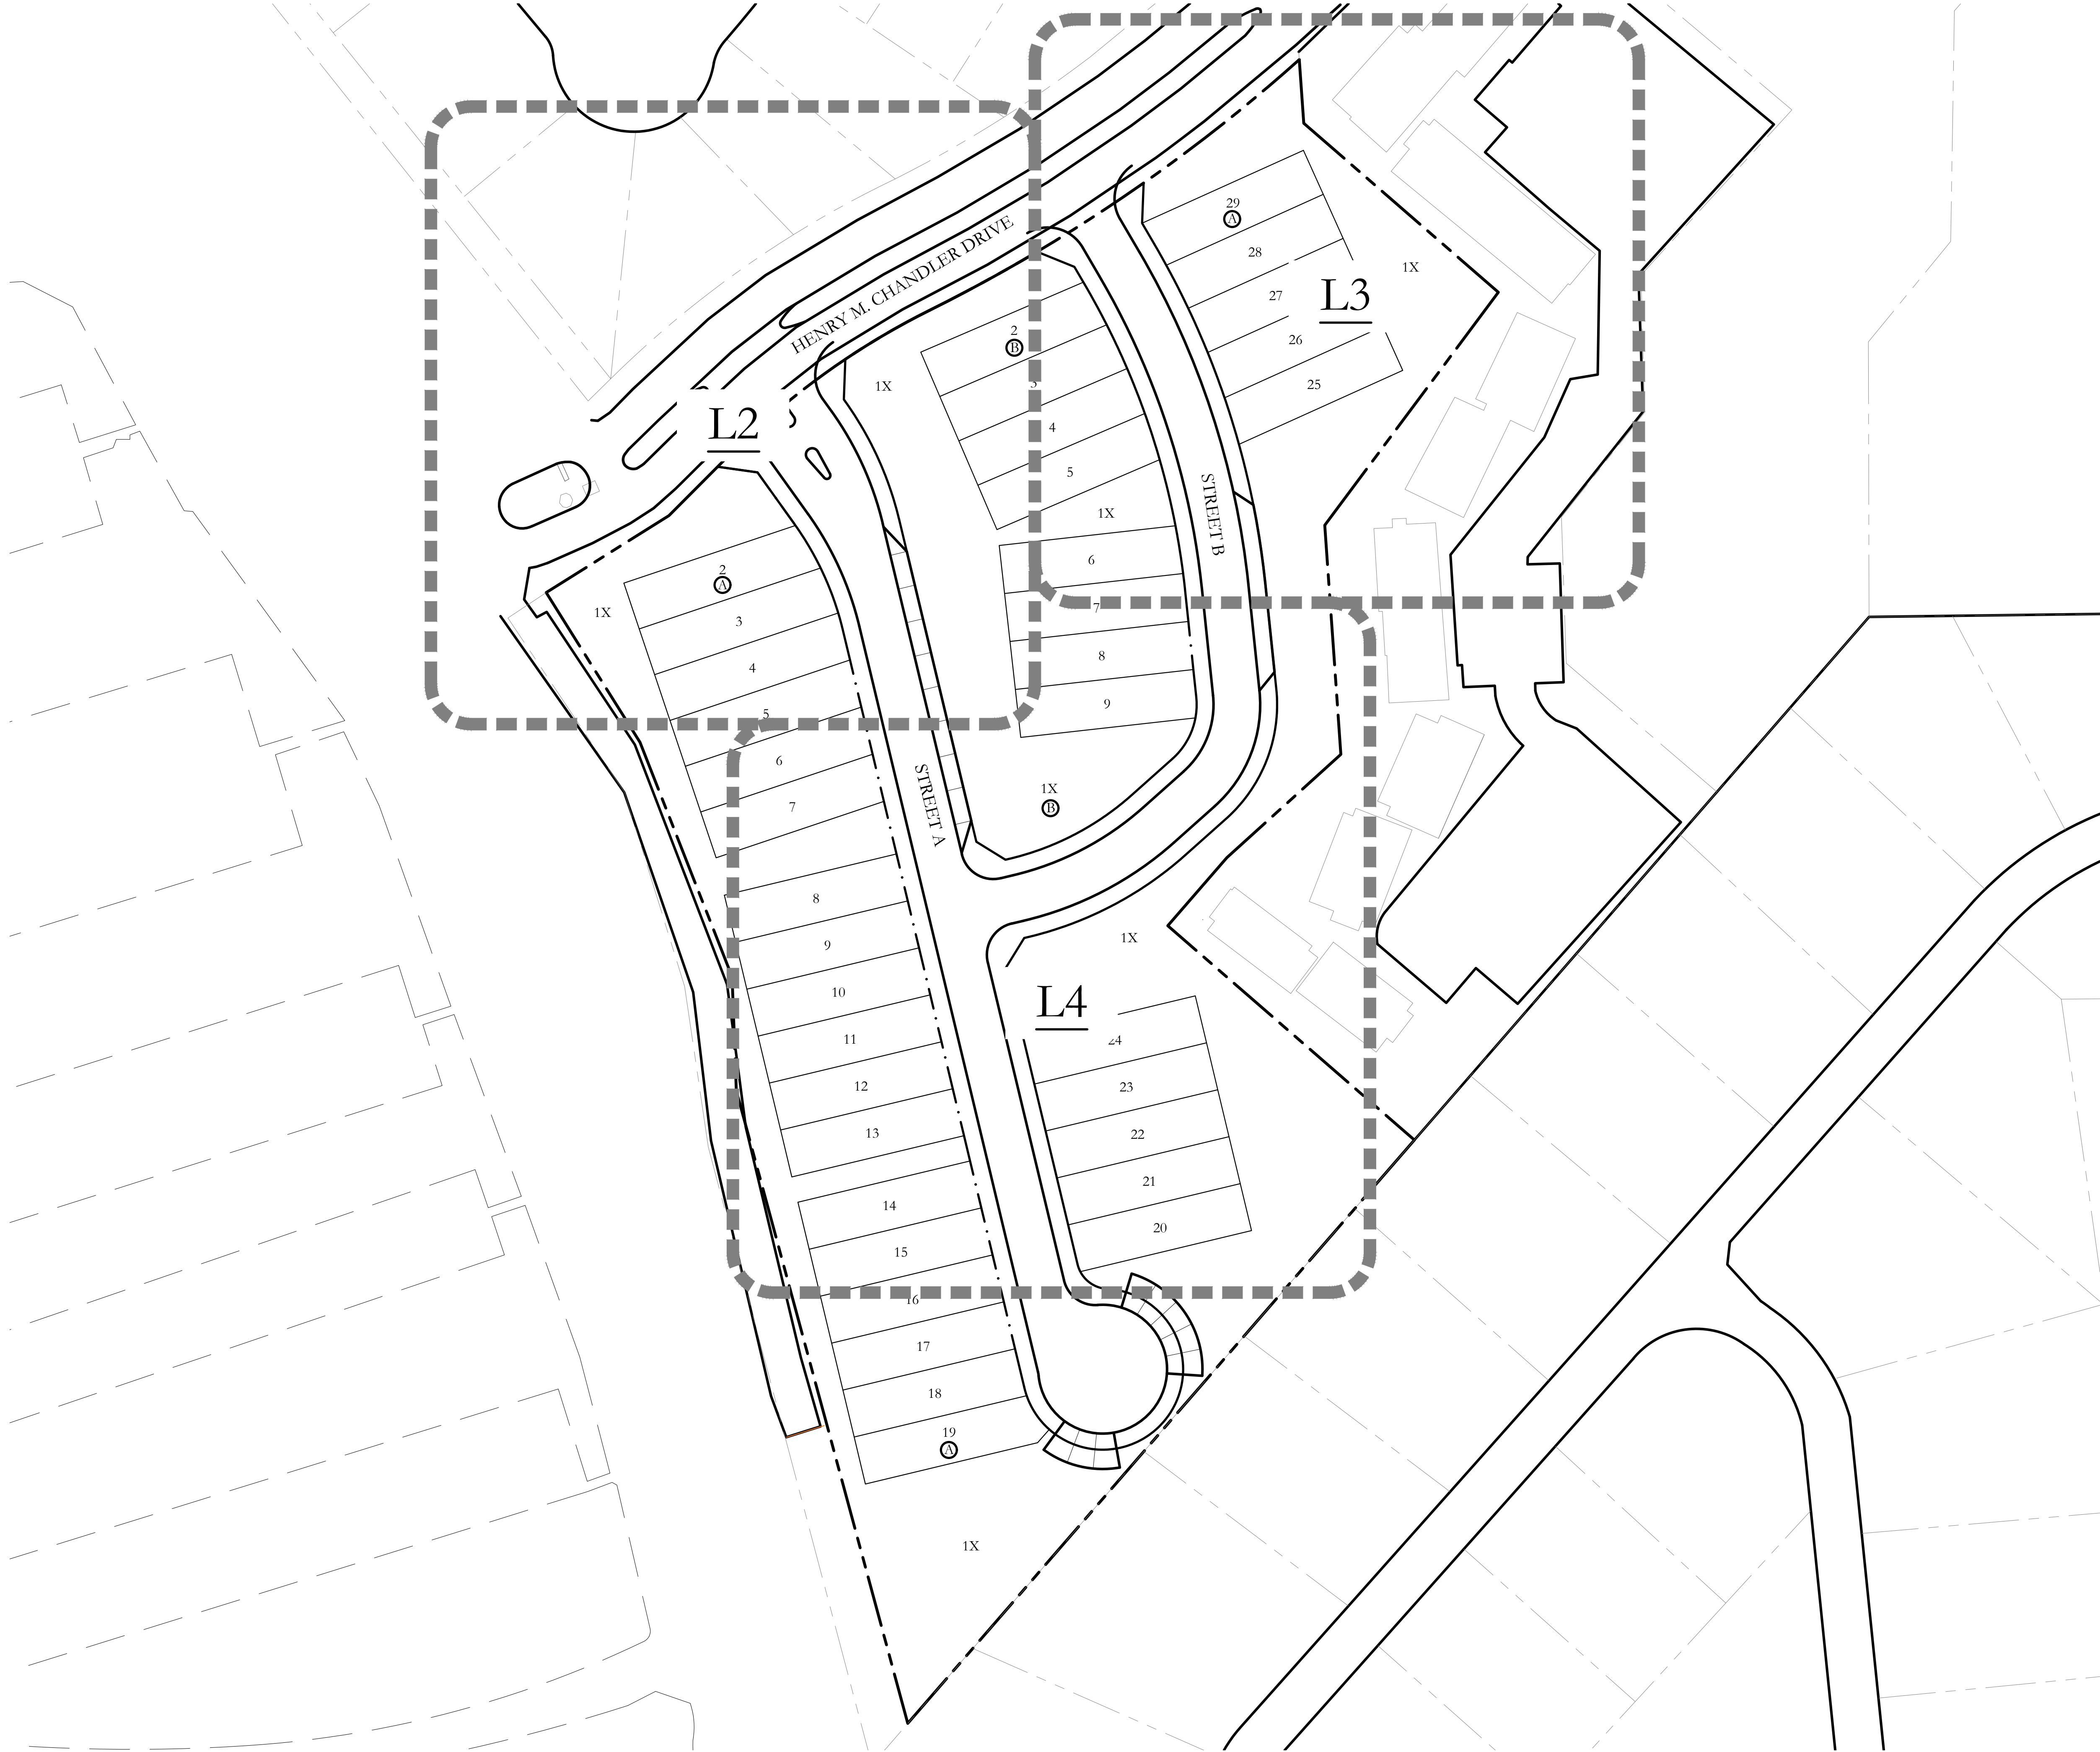


SCALE:
1" = 50'
One Inch
JVC No 2209

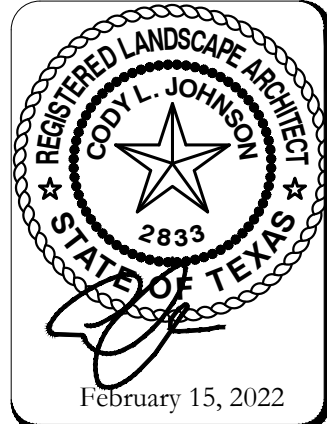

TREESCAPE PLAN
OVERALL LAYOUT PLAN

MARINA VILLAGE TOWNHOMES
CITY OF ROCKWALL
ROCKWALL COUNTY, TEXAS

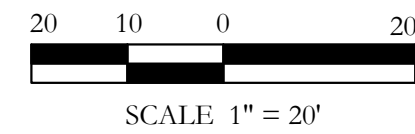

F:\civil 3d projects\2209 - marina villages - townhomes - rockwall\landscape\2209 - treescape planting.dwg

LANDSCAPE PROVIDED

HENRY M. CHANDLER DR.

MINIMUM TEN (10) FOOT LANDSCAPE BUFFER PROVIDED


1 - 4" CAL. CANOPY TREE & 1 ACCENT TREE / 50 LF OF LINEAR FRONTAGE
576 LF OF FRONTAGE / 50 LF = 12 - 4" CAL. TREES & 12 ACCENT TREES REQUIRED.
PROVIDED: 12 - 4" CALIPER CANOPY TREES & 13 ACCENT TREES PROVIDED

TREE MITIGATION

191.5 CAL. INCHES REMOVED

43 - 4" CAL. CANOPY TREES & 13 - 2" CAL. ACCENT TREES = 198 CAL. INCHES REPLACED.

PLANT LIST						
KEY	ESTIMATED QUANTITY	COMMON NAME	SCIENTIFIC NAME	SIZE	SPACING	REMARKS
LO	13	LIVE OAK	QUERCUS VIRGINIANA	4" CALIPER	AS SHOWN	NURSERY GROWN; FULL HEAD; MINIMUM BRANCHING HEIGHT AT 6'-0"; MINIMUM 10'-0" OVERALL HEIGHT.
SO	11	SHUMARD OAK	QUERCUS SHUMARDII	4" CALIPER	AS SHOWN	NURSERY GROWN; FULL HEAD; MINIMUM BRANCHING HEIGHT AT 6'-0"; MINIMUM 10'-0" OVERALL HEIGHT.
BO	8	BUR OAK	QUERCUS MACROCARPA	4" CALIPER	AS SHOWN	NURSERY GROWN; FULL HEAD; MINIMUM BRANCHING HEIGHT AT 6'-0"; MINIMUM 10'-0" OVERALL HEIGHT.
CE	11	CEDAR ELM	ULMUS CRASSIFOLIA	4" CALIPER	AS SHOWN	NURSERY GROWN; FULL HEAD; MINIMUM BRANCHING HEIGHT AT 6'-0"; MINIMUM 10'-0" OVERALL HEIGHT.
DW	7	DESERT WILLOW	CHILOPSIS LINEARIS	2" CALIPER	AS SHOWN	NURSERY GROWN; FULL HEAD; MINIMUM 8'-0" OVERALL HEIGHT.
RB	6	TEXAS REDBUD	CERCIS CANADENSIS VAR. TEXENSIS	2" CALIPER	AS SHOWN	NURSERY GROWN; FULL HEAD; MINIMUM 8'-0" OVERALL HEIGHT.

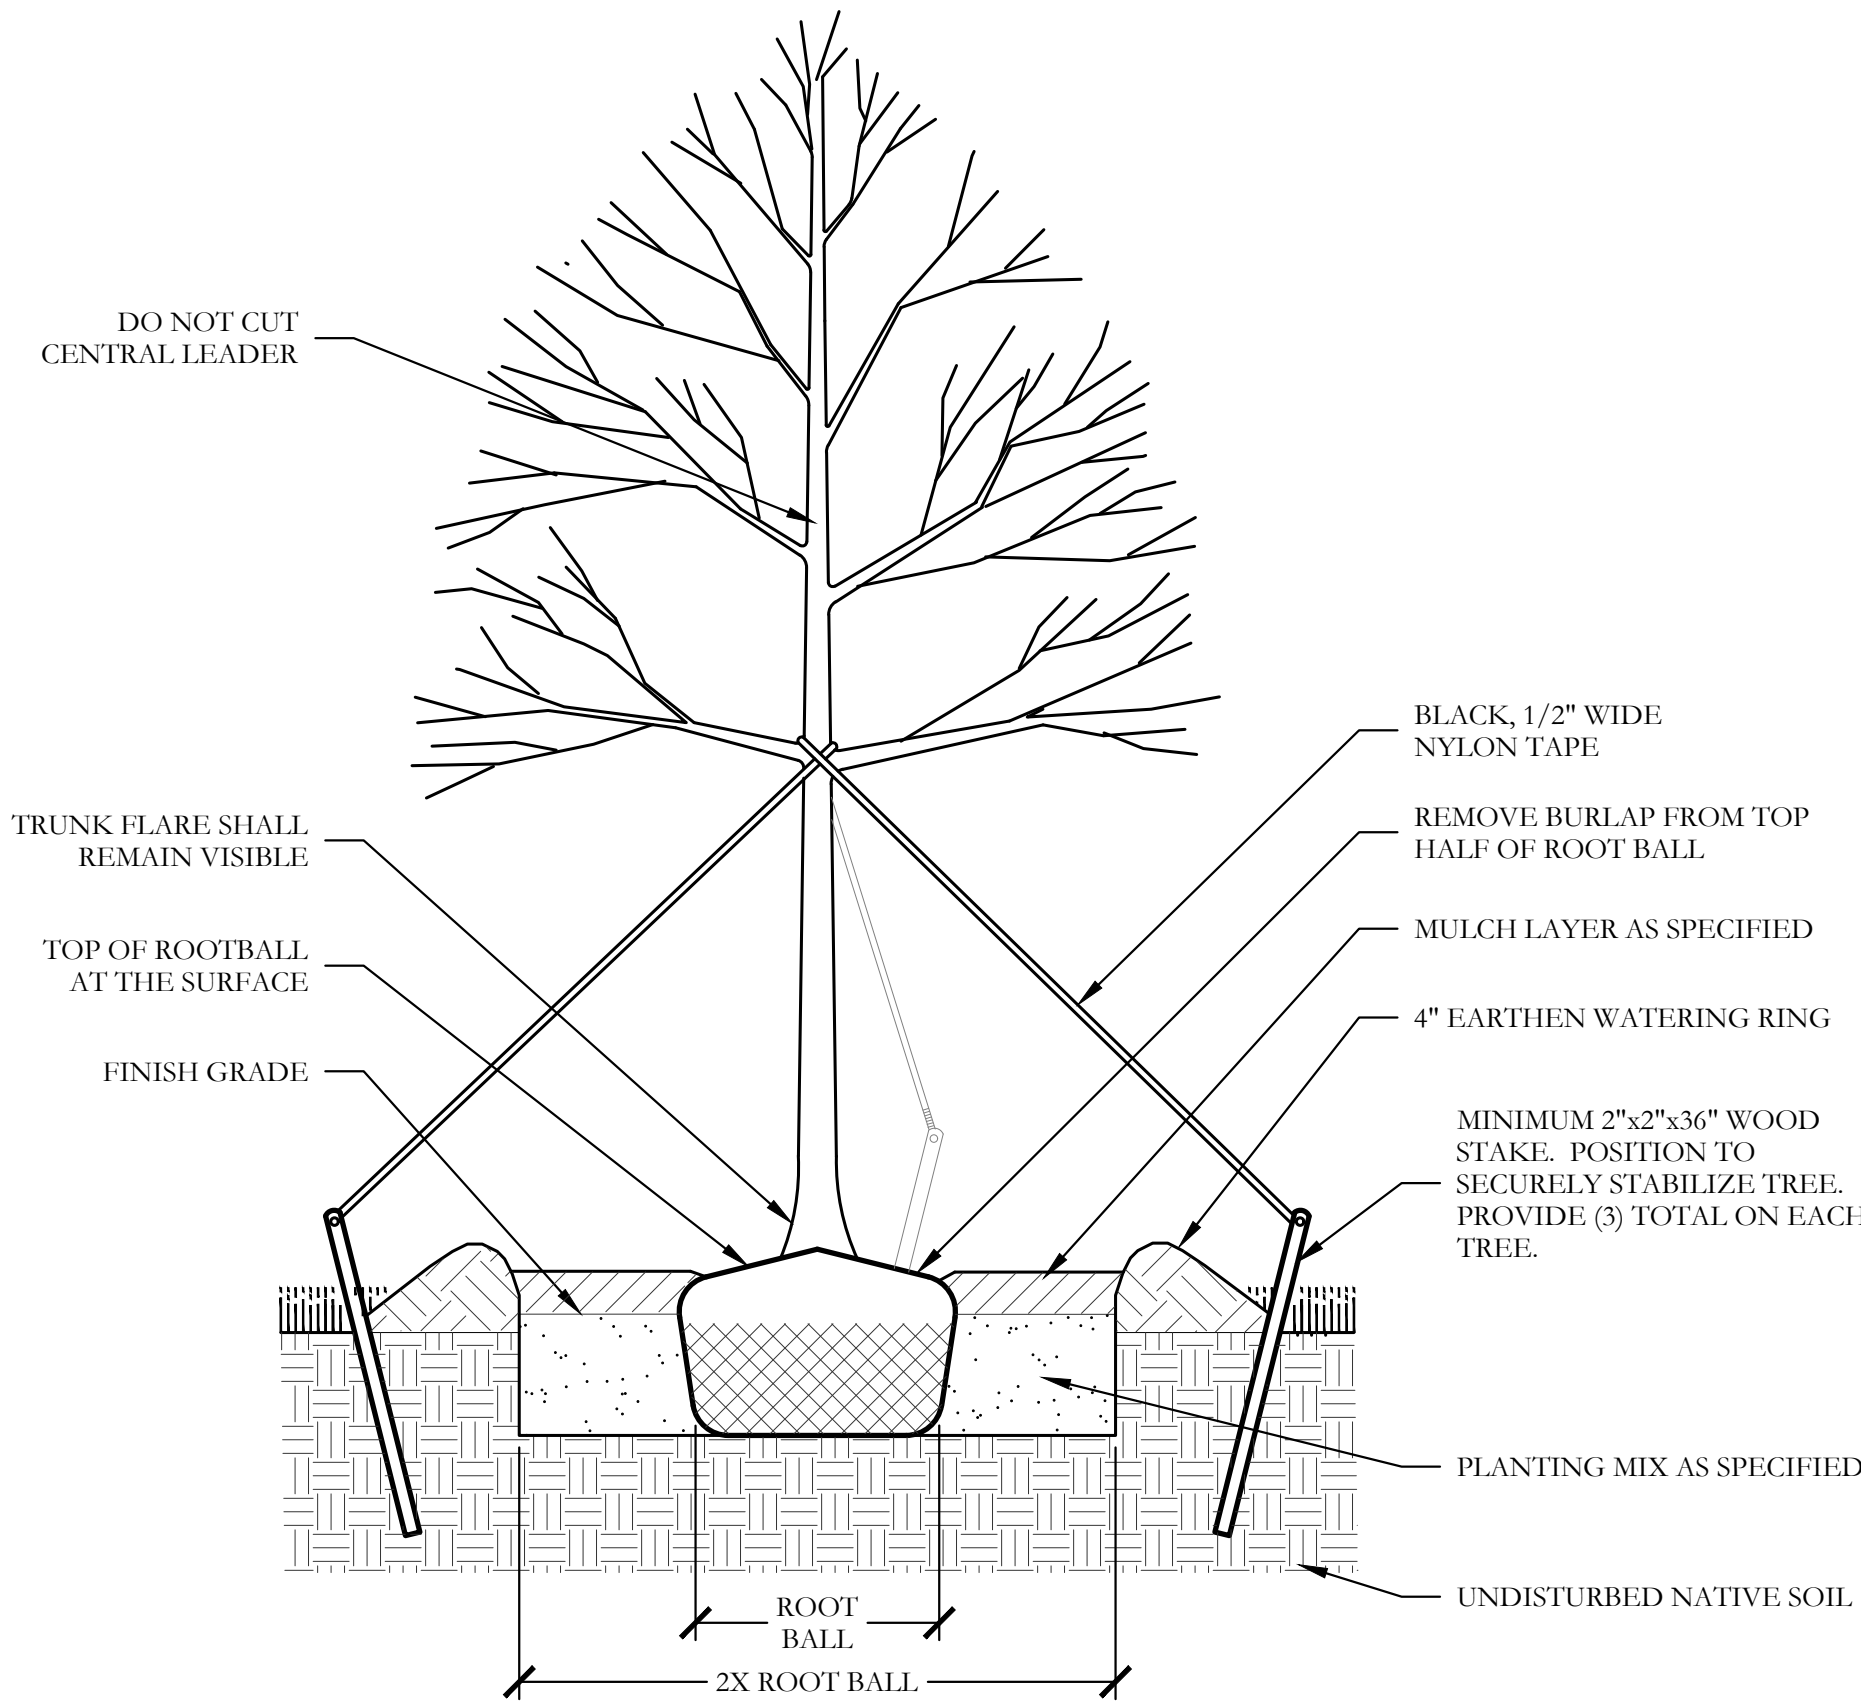

1 TYPICAL TREE PLANTING SECTION NOT TO SCALE

GENERAL LANDSCAPE NOTES

INSPECTIONS:

1. NO EXCAVATION SHALL OCCUR IN CITY R.O.W. WITHOUT A R.O.W. PERMIT--CONTACT THE PUBLIC WORKS DEPARTMENT.
2. THE CONTRACTOR SHALL MARK ALL WATER LINES, SEWER LINES, AND TREE LOCATIONS PRIOR TO CALLING FOR ROW INSPECTION AND PERMIT.
3. THE LANDSCAPE INSTALLATION SHALL COMPLY WITH APPROVED LANDSCAPE DRAWINGS PRIOR TO FINAL ACCEPTANCE BY THE CITY AND ISSUANCE OF A CERTIFICATE OF OCCUPANCY.
4. WATER METERS, CLEANOUTS AND OTHER APPURTENANCES, SHALL BE ACCESSIBLE, ADJUSTED TO GRADE, CLEARLY MARKED WITH FLAGGING AND COMPLIANT WITH PUBLIC WORKS DEPARTMENT STANDARDS PRIOR TO CALLING FOR FINAL LANDSCAPE AND ROW INSPECTIONS.

LANDSCAPE STANDARDS:

1. PLANTINGS AND LANDSCAPE ELEMENTS SHALL COMPLY WITH THE CITY'S ENGINEERING DESIGN STANDARDS, PUBLIC R.O.W. VISIBILITY REQUIREMENTS.
2. UNLESS OTHERWISE SPECIFIED, TREES SHALL BE PLANTED NO LESS THAN 4' FROM CURBS, SIDEWALKS, UTILITY LINES, SCREENING WALLS AND OTHER STRUCTURES. THE CITY HAS FINAL APPROVAL FOR ALL TREE PLACEMENTS.
3. A MINIMUM THREE FEET (3') RADIUS AROUND A FIRE HYDRANT MUST REMAIN CLEAR OF LANDSCAPE PURSUANT TO THE FIRE CODE.
4. STREET TREES, WHERE REQUIRED, SHALL BE (10') MINIMUM FROM THE EDGE OF A STORM SEWER CURB INLET BOX AND THE EDGE OF THE ROOT BALL SHALL BE (4') MINIMUM FROM THE WATER METER.
5. THE AMERICAN STANDARD FOR NURSERY STOCK (ANSI Z60.1-2004) SPECIFICATIONS SHALL GOVERN PLANT QUALIFICATIONS, GRADES, AND STANDARDS.
6. TREE PLANTING SHALL COMPLY WITH DETAILS HEREIN AND THE INTERNATIONAL SOCIETY OF ARBORICULTURE (ISA) STANDARDS.
7. A 2-3" LAYER OF MULCH SHALL BE PROVIDED AROUND THE BASE OF THE PLANTED TREE. THE MULCH SHALL BE PULLED BACK 4" FROM THE TRUNK OF THE TREE.
8. TREE PITS SHALL BE TESTED FOR WATER PERCOLATION. IF WATER DOES NOT DRAIN OUT OF TREE PIT WITHIN 24-HOURS, THE TREE SHALL BE MOVED OR DRAINAGE SHALL BE PROVIDED.
9. ALL BEDS TO HAVE 3" OF COMPOSTED SOIL, LIVING EARTH TECHNOLOGY, OR APPROVED EQUAL TILLED AND TURNED TO A DEPTH OF 8" MINIMUM.
10. ALL PLANT BEDS SHALL BE TOP-DRESSED WITH A MINIMUM OF 3 INCHES OF HARDWOOD MULCH.
11. NATIVE SITE TOPSOIL IS TO BE PROTECTED FROM EROSION OR STOCKPILED. NATIVE SITE TOPSOIL SHALL BE LABORATORY TESTED BY AND ACCREDITED LABORATORY AND AMENDED PER SAID LABORATORY'S RECOMMENDATIONS.

IRRIGATION STANDARDS:

1. ANY CHANGES TO THESE APPROVED IRRIGATION DRAWINGS SHALL BE AUTHORIZED BY THE CITY. CONTACT DEVELOPMENT SERVICES FOR AN IRRIGATION PERMIT PRIOR TO INSTALLING THE IRRIGATION SYSTEM.
2. IRRIGATION OVER-SPRAY ON STREETS AND WALKS IS PROHIBITED.
3. MAINLINES, VALVES, OR CONTROL WIRES SHALL NOT BE LOCATED IN THE CITY'S ROW.
4. ET IRRIGATION CONTROLLERS SHALL BE PROGRAMMED AND ADJUSTED TO NOT EXCEED THE LANDSCAPE WATER ALLOWANCE (LWA) PRIOR TO APPROVAL OF LANDSCAPE INSTALLATION.
5. VALVES SHALL BE LOCATED A MINIMUM OF (3') AWAY FROM STORM SEWERS, AND SANITARY SEWER LINES AND 5 FEET FROM CITY FIRE HYDRANTS AND WATER VALVES.
6. THE BORE DEPTH UNDER STREETS, DRIVE AISLES, AND FIRE LANES SHALL PROVIDE (2') OF CLEARANCE (MINIMUM).
7. IRRIGATION HEADS THAT RUN PARALLEL AND NEAR PUBLIC WATER AND SANITARY SEWER LINES; SHALL BE FED FROM STUBBED LATERALS OR BULL-HEADS. A MINIMUM FIVE FOOT (5') SEPARATION IS REQUIRED BETWEEN IRRIGATION MAIN LINES AND LATERALS THAT RUN PARALLEL TO PUBLIC WATER AND SANITARY SEWER LINES.
8. NO VALVES, BACKFLOW PREVENTION ASSEMBLIES, QUICK COUPLERS ETC. SHALL BE LOCATED CLOSER THAN 10' FROM THE CURB AT STREET OR DRIVE INTERSECTION.



MAINTENANCE STANDARDS:

1. THE OWNER SHALL BE RESPONSIBLE FOR THE ESTABLISHMENT, MAINTENANCE, AND VIGOR OF PLANT MATERIAL IN ACCORDANCE WITH THE DESIGN INTENT AND AS APPROPRIATE FOR THE SEASON OF THE YEAR.
2. LANDSCAPE AND OPEN AREAS SHALL BE FREE OF TRASH, LITTER AND WEEDS.
3. NO PLANT MATERIAL SHALL BE ALLOWED TO ENCROACH ON R.O.W., SIDEWALKS OR EASEMENTS TO THE EXTENT THAT VISION OR ROUTE OF TRAVEL FOR VEHICULAR, PEDESTRIAN, OR BICYCLE TRAFFIC IS IMPEDED.
4. TREE MAINTENANCE SHALL BE IN ACCORDANCE WITH THE STANDARDS OF THE INTERNATIONAL SOCIETY OF ARBORICULTURE.
5. TREE STAKING MATERIALS, IF USED, SHALL BE REMOVED AFTER (1) GROWING SEASON, NO MORE THAN (1) YEAR AFTER INSTALLATION (STEEL TREE STAKES, WIRES, AND HOSES ARE PROHIBITED).


TREE PROTECTION NOTES:

1. CONTACT DEVELOPMENT SERVICES FOR A TREE REMOVAL PERMIT PRIOR TO REMOVAL OR TRANSPLANTING OF ANY TREES.
2. ALL TREES WHICH ARE TO REMAIN ON SITE SHALL BE PROTECTED WITH A (4') TALL, BRIGHTLY COLORED PLASTIC FENCE, OR SILT FENCE, PLACED AT THE DRIP LINE OF THE TREES.
3. PRIOR TO THE PRE-CONSTRUCTION MEETING OR OBTAINING A GRADING PERMIT, ALL TREE MARKINGS AND PROTECTIVE FENCING SHALL BE INSTALLED BY THE OWNER AND BE INSPECTED BY DEVELOPMENT SERVICES.
4. NO EQUIPMENT SHALL BE CLEANED, OR HARMFUL LIQUIDS DEPOSITED WITHIN THE LIMITS OF THE ROOT ZONE OF TREES WHICH REMAIN ON SITE.
5. NO SIGNS, WIRES, OR OTHER ATTACHMENTS SHALL BE ATTACHED TO ANY TREE TO REMAIN ON SITE.
6. VEHICULAR AND CONSTRUCTION EQUIPMENT SHALL NOT PARK OR DRIVE WITHIN THE LIMITS OF THE DRIP LINE.
7. GRADE CHANGES IN EXCESS OF 3 INCHES (CUT OR FILL) SHALL NOT BE ALLOWED WITHIN A ROOT ZONE, UNLESS ADEQUATE TREE PRESERVATION METHODS ARE APPROVED BY THE CITY.
8. NO TRENCHING SHALL BE ALLOWED WITHIN THE DRIP-LINE OF A TREE, UNLESS APPROVED BY THE CITY.
9. ALL REMOVED TREES SHALL BE CHIPPED AND USED FOR MULCH ON SITE OR HAULED OFF-SITE.
10. ALL TREE MAINTENANCE TECHNIQUES SHALL BE IN CONFORMANCE WITH INDUSTRY IDENTIFIED STANDARDS. IMPROPER OR MALICIOUS PRUNING TECHNIQUES ARE STRICTLY PROHIBITED.

F:\civil 3d projects\2209 - marina villages - townhomes - rockwall\landscape\2209 - tree survey plan.dwg

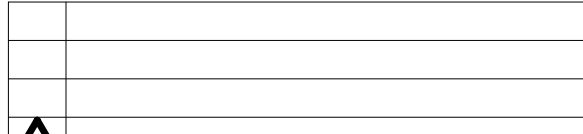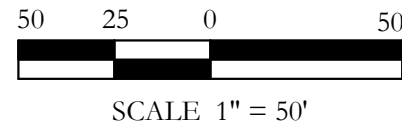

SCALE:
1" = 50'
One Inch
JVC No 2209

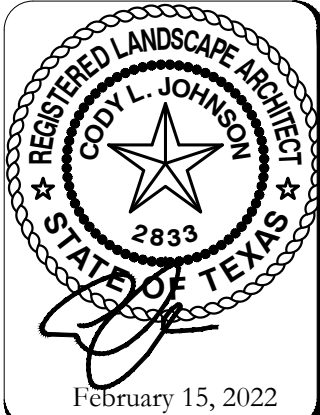


TREE SURVEY PLAN
TREE SURVEY PLAN

MARINA VILLAGE TOWNHOMES
CITY OF ROCKWALL
ROCKWALL COUNTY, TEXAS

F:\civil 3d projects\2209 - marina villages - townhomes - rockwall\landscape\2209 - tree survey plan.dwg

Tree ID Number	Diameter at Breast Height (DBH) (inches)	Common Name	Scientific Name	Protected Tree?	Condition	Comment	Location	Remove or Remain	Mitigation Required, Percentage	Mitigation Required in Caliper Inches
0	28.0	Mesquite	Prosopis spp.	Yes	Healthy	Multi-trunk		Remove	100%	28.0
1	40.0	Bois d'Arc	Machua pomifera	No	Damaged	Leaning/Fall Hazard		Remove	0%	0.0
2	20.0	Bois d'Arc	Machua pomifera	No	Healthy			Remove	0%	0.0
3	8.0	Hackberry	Celtis occidentalis	No	Healthy			Remove	0%	0.0
4	12.0	Crape Myrtle	Lagerostroemia indica	Yes	Healthy			Remove	100%	12.0
5	8.0	Hackberry	Celtis occidentalis	No	Healthy	Multi-trunk		Remove	0%	0.0
6	14.0	Hackberry	Celtis occidentalis	Yes	Healthy			Remove	50%	7.0
7	14.0	Cedar Elm	Ulmus crassifolia	Yes	Healthy			Remove	100%	14.0
8	9.0	Eastern Red Cedar	Juniperus viginiana	No	Healthy			Remain		0.0
9	12.0	Hackberry	Celtis occidentalis	Yes	Healthy			Remain		0.0
10	19.0	Hackberry	Celtis occidentalis	Yes	Healthy			Remain		0.0
11	44.0	Hackberry	Celtis occidentalis	Yes	Healthy			Remain		0.0
12	21.0	Hackberry	Celtis occidentalis	Yes	Healthy			Remain		0.0
13	11.0	Hackberry	Celtis occidentalis	No	Healthy			Remain		0.0
14	24.0	Hackberry	Celtis occidentalis	Yes	Healthy	Multi-trunk		Remain		0.0
15	34.0	Eastern Red Cedar	Juniperus viginiana	Yes	Healthy	Multi-trunk		Remain		0.0
16	35.0	Eastern Red Cedar	Juniperus viginiana	Yes	Healthy	Multi-trunk		Remain		0.0
17	12.0	Eastern Red Cedar	Juniperus viginiana	Yes	Healthy			Remain		0.0
18	9.0	Eastern Red Cedar	Juniperus viginiana	No	Healthy			Remain		0.0
19	29.0	Bois d'Arc	Machua pomifera	No	Healthy	Multi-trunk		Remain		0.0
20	10.0	Eastern Red Cedar	Juniperus viginiana	No	Healthy			Remain		0.0
21	12.0	Green Ash	Fraxinus pennsylvanica	Yes	Healthy			Remain		0.0
22	10.0	Eastern Red Cedar	Juniperus viginiana	No	Healthy			Remain		0.0
23	9.0	Eastern Red Cedar	Juniperus viginiana	No	Healthy			Remain		0.0
24	15.0	Hackberry	Celtis occidentalis	Yes	Healthy			Remain		0.0
25	8.0	Eastern Red Cedar	Juniperus viginiana	No	Healthy			Remain		0.0
26	7.0	Hackberry	Celtis occidentalis	No	Healthy			Remain		0.0
27	29.0	Eastern Red Cedar	Juniperus viginiana	Yes	Healthy	Multi-trunk		Remain		0.0
28	12.0	Hackberry	Celtis occidentalis	Yes	Healthy			Remain		0.0
29	21.0	Green Ash	Fraxinus pennsylvanica	Yes	Healthy	Multi-trunk		Remain		0.0
30	7.0	Green Ash	Fraxinus pennsylvanica	Yes	Healthy	Multi-trunk		Remain		0.0
31	20.0	Hackberry	Celtis occidentalis	Yes	Healthy			Remove	50%	10.0
32	24.0	Eastern Red Cedar	Juniperus viginiana	Yes	Healthy	Multi-trunk		Remove	50%	12.0
33	23.0	Hackberry	Celtis occidentalis	Yes	Healthy	Multi-trunk		Remove	50%	11.5
34	9.0	Hackberry	Celtis occidentalis	No	Healthy			Remove	0%	0.0
35	20.0	Hackberry	Celtis occidentalis	Yes	Healthy	Multi-trunk		Remove	50%	10.0
36	24.0	Green Ash	Fraxinus pennsylvanica	Yes	Healthy	Multi-trunk		Remove	100%	24.0
37	12.0	Hackberry	Celtis occidentalis	Yes	Healthy			Remove	50%	6.0
38	21.0	Hackberry	Celtis occidentalis	Yes	Healthy	Multi-trunk		Remove	50%	10.5
39	19.0	Hackberry	Celtis occidentalis	Yes	Healthy			Remove	50%	9.5
40	21.0	Hackberry	Celtis occidentalis	Yes	Healthy			Remove	50%	10.5
41	24.0	Hackberry	Celtis occidentalis	Yes	Healthy	Multi-trunk		Remove	50%	12.0
42	17.0	Hackberry	Celtis occidentalis	Yes	Healthy			Remove	50%	8.5
43	12.0	Hackberry	Celtis occidentalis	Yes	Healthy			Remove	50%	6.0
										191.5
	Total Tree Population									Total Tree Replacement, caliper inches

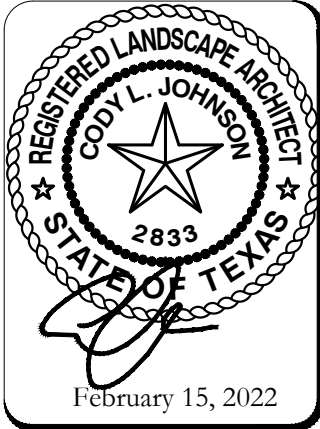

SCALE:

One Inch
JVC No 2209

TR3 of 3

TREE SURVEY PLAN
TREE SURVEY DETAILS

MARINA VILLAGE TOWNHOMES
CITY OF ROCKWALL
ROCKWALL COUNTY, TEXAS

Mapcheck 1: MARINA VILLAGE

Closure Summary

Precision, 1 part in: 1438904.41'
Error distance: 0.00'
Error direction: S23°37'10.02"W
Area: 300075.68 Sq. Ft.
Square area: 300075.68
Perimeter: 2677.88'

Point of Beginning

Easting: 2588822.58'
Northing: 7007539.35'

Side 1: Line

Direction: S04°01'18"E
Angle: [-004.02 (d)]
Deflection angle: [175.98 (d)]
Distance: 39.64'
Easting: 2588825.36'
Northing: 7007499.81'

Side 2: Line

Direction: S49°01'18"E
Angle: [135.00 (d)]
Deflection angle: [-045.00 (d)]
Distance: 160.16'
Easting: 2588946.28'
Northing: 7007394.78'

Side 3: Line

Direction: S36°41'52"W
Angle: [-094.28 (d)]
Deflection angle: [085.72 (d)]
Distance: 180.50'
Easting: 2588838.41'
Northing: 7007250.06'

Side 4: Line

Direction: S04°01'18"E
Angle: [139.28 (d)]
Deflection angle: [-040.72 (d)]
Distance: 142.73'
Easting: 2588848.42'
Northing: 7007107.68'

Side 5: Line

Direction: S47°49'42"W
Angle: [-128.15 (d)]
Deflection angle: [051.85 (d)]

Distance: 95.59'
Easting: 2588777.58'
Northing: 7007043.50'

Side 6: Line

Direction: S40°58'42"W
Angle: [173.15 (d)]
Deflection angle: [-006.85 (d)]
Distance: 56.00'
Easting: 2588740.85'
Northing: 7007001.23'

Side 7: Line

Direction: S49°01'18"E
Angle: [090.00 (d)]
Deflection angle: [-090.00 (d)]
Distance: 203.00'
Easting: 2588894.11'
Northing: 7006868.10'

Side 8: Line

Direction: S40°58'42"W
Angle: [-090.00 (d)]
Deflection angle: [090.00 (d)]
Distance: 480.10'
Easting: 2588579.27'
Northing: 7006505.65'

Side 9: Line

Direction: N15°09'39"W
Angle: [-056.14 (d)]
Deflection angle: [123.86 (d)]
Distance: 407.29'
Easting: 2588472.76'
Northing: 7006898.76'

Side 10: Line

Direction: N02°08'12"W
Angle: [-166.98 (d)]
Deflection angle: [013.02 (d)]
Distance: 70.75'
Easting: 2588470.12'
Northing: 7006969.46'

Side 11: Line

Direction: N21°26'12"W
Angle: [160.70 (d)]
Deflection angle: [-019.30 (d)]
Distance: 156.54'

Easting: 2588412.91'
Northing: 7007115.18'

Side 12: Line

Direction: N32°04'21"W
Angle: [169.36 (d)]
Deflection angle: [-010.64 (d)]
Distance: 109.80'
Easting: 2588354.60'
Northing: 7007208.22'

Side 13: Line

Direction: N57°55'37"E
Angle: [-090.00 (d)]
Deflection angle: [090.00 (d)]
Distance: 90.00'
Easting: 2588430.87'
Northing: 7007256.01'

Side 14: Line

Direction: N44°54'57"E
Angle: [166.99 (d)]
Deflection angle: [-013.01 (d)]
Distance: 54.37'
Easting: 2588469.26'
Northing: 7007294.51'

Side 15: Curve

Curve direction: Clockwise
Radius: [471.20']
Arc length: 153.06'
Delta angle: 018.61 (d)
Tangent: [77.21']
Chord direction: N54°13'19"E
Chord angle: [-170.69 (d)]
Deflection angle: [009.31 (d)]
Chord distance: 152.39'
Easting: 2588592.89'
Northing: 7007383.60'

Side 16: Curve

Curve direction: Counter-clockwise
Radius: [1039.99']
Arc length: 278.35'
Delta angle: 015.34 (d)
Tangent: [140.01']
Chord direction: N55°51'37"E
Chord angle: [172.33 (d)]

Deflection angle: [-007.67 (d)]

Chord distance: 277.52'

Easting: 2588822.58'

Northing: 7007539.35'



CITY OF ROCKWALL

CITY COUNCIL MEMORANDUM

PLANNING AND ZONING DEPARTMENT

385 S. GOLIAD STREET • ROCKWALL, TX 75087

PHONE: (972) 771-7745 • EMAIL: PLANNING@ROCKWALL.COM

TO: Mayor and City Council
DATE: November 21, 2022
APPLICANT: Ryan Joyce; *Michael Joyce Properties*
CASE NUMBER: P2022-056; *Final Plat for the Marina Village Subdivision*

SUMMARY

Consider a request by Ryan Joyce of Michael Joyce Properties on behalf of William Johnson of LTL Family Holdings, LLC for the approval of a Final Plat for the Marina Village Subdivision being a 6.88-acre tract of land identified as Lot 4, Block A, Spyglass Hill #4 Addition and Tract 134-12 of the E. Teal Survey, Abstract No. 207, City of Rockwall, Rockwall County, Texas, zoned Planned Development District 8 (PD-8) [Ordinance No. 92-39] for Zero Lot Line (ZL-5) District land uses, generally located on the south side of Henry M. Chandler Drive west of Ridge Road [FM-740], and take any action necessary.

PLAT INFORMATION

- ☒ The applicant is requesting the approval of a Final Plat for a 6.88-acre tract of land (*i.e. Lot 4, Block A, Spyglass Hill #4 Addition and Tract 134-12 of the E. Teal Survey, Abstract No. 207*) for the purpose of establishing the Marina Village Subdivision. The subdivision will consist of 36 townhomes that are zoned Planned Development District 8 (PD-8) [Ordinance No. 21-38] for Two-Family (2F) District land uses. The site is generally located on the south side of Henry M. Chandler Drive west of Ridge Road [FM-740]. It should be noted that the applicant has submitted a site plan (*i.e. Case No. SP2022-059*) concurrently with this final plat that shows the proposed building elevations, landscaping, and hardscape plans for the subdivision.
- ☒ The subject property was annexed into the City of Rockwall and zoned Agricultural (AG) District on October 29, 1973 (Ordinance No. 73-43). On November 12, 1973, the subject property was rezoned to Planned Development District 8 (PD-8) and designated for a *Multi-Family Structure or Condominium* by Ordinance No. 73-48. This designation was amended on October 19, 1992 by Ordinance No. 92-39 (Case No. PZ1992-008-01), which re-designated the subject property to allow 36 zero-lot-line, single-family homes. On October 13, 2017, a request was made by Ed Cavendish of Cavendish Homes/VPS Construction requesting to reinstate the preliminary plat that was approved in 1992 in accordance with Ordinance No. 92-39. This preliminary plat depicted the proposed layout for the 36 zero-lot-line, single-family homes. The Planning and Zoning Commission approved the reinstatement request October 24, 2017; however, the applicant ultimately chose to submit an application on November 17, 2017 requesting to amend Ordinance No. 92-39 to allow for a 48-unit townhome development (Case No. Z2017-059). This request was denied by the City Council on February 5, 2018. On June 18, 2021, a request was made by Troy Lewis of Newstream Capital Partners to amend Planned Development District 8 (PD-8) [Ordinance No. 92-39] to allow a townhome development consisting of 36 townhomes (Case No. Z2021-026). This request was approved [Ordinance No. 21-38] by the City Council on August 2, 2021 by vote of 6-0 with Council Member Daniels absent.
- ☒ On November 1, 2022, the Parks and Recreation Board reviewed the *Final Plat* and made the following recommendations concerning the proposed subdivision:
 - (1) The property owner shall pay pro-rata equipment fees of \$7,920 (*i.e. \$220.00 x 36 Lots*), which will be due prior to the issuance of a building permit.
 - (2) The property owner shall pay cash-in-lieu of land fees of \$8,352.00 (*i.e. \$232.00 x 36 Lots*), which will be due prior to the issuance of a building permit.

- ☑ The surveyor has completed the majority of the technical revisions requested by staff, and this Final Plat -- conforming to the requirements for plats as stipulated by the Subdivision Ordinance in the Municipal Code of Ordinances -- is recommended for conditional approval pending the completion of final technical modifications and submittal requirements.
- ☑ Conditional approval of this Final Plat by the City Council shall constitute approval subject to the conditions stipulated in the *Conditions of Approval* section below.
- ☑ With the exception of the items listed in the *Conditions of Approval* section of this case memo, this plat is in substantial compliance with the requirements of the *Subdivision Ordinance* in the Municipal Code of Ordinances.

CONDITIONS OF APPROVAL

If City Council chooses to approve a Final Plat for the *Marina Village Subdivision*, staff would propose the following conditions of approval:

- (1) All technical comments from City Staff (*i.e. Engineering, Planning and Fire Department*) shall be addressed prior to submittal of civil engineering plans;
- (2) The development of the subject property shall adhere to the recommendations made by Parks and Recreation Board; and,
- (3) Any construction resulting from the approval of this Final Plat shall conform to the requirements set forth by the Unified Development Code (UDC), the International Building Code (IBC), the Rockwall Municipal Code of Ordinances, city adopted engineering and fire codes and with all other applicable regulatory requirements administered and/or enforced by the state and federal government.

PLANNING AND ZONING COMMISSION

On November 15, 2022, the Planning and Zoning Commission recommended approval of the Final Plat, by a vote of 5-0, with Commissioners Conway and Llewellyn absent.



DEVELOPMENT APPLICATION

City of Rockwall
Planning and Zoning Department
385 S. Goliad Street
Rockwall, Texas 75087

STAFF USE ONLY

PLANNING & ZONING CASE NO. B022-056

NOTE: THE APPLICATION IS NOT CONSIDERED ACCEPTED BY THE CITY UNTIL THE PLANNING DIRECTOR AND CITY ENGINEER HAVE SIGNED BELOW.

DIRECTOR OF PLANNING:

CITY ENGINEER:

PLEASE CHECK THE APPROPRIATE BOX BELOW TO INDICATE THE TYPE OF DEVELOPMENT REQUEST [SELECT ONLY ONE BOX]:

PLATTING APPLICATION FEES:

- ☐ MASTER PLAT (\$100.00 + \$15.00 ACRE) ¹
☐ PRELIMINARY PLAT (\$200.00 + \$15.00 ACRE) ¹
☒ FINAL PLAT (\$300.00 + \$20.00 ACRE) ¹
☐ REPLAT (\$300.00 + \$20.00 ACRE) ¹
☐ AMENDING OR MINOR PLAT (\$150.00)
☐ PLAT REINSTATEMENT REQUEST (\$100.00)

SITE PLAN APPLICATION FEES:

- ☐ SITE PLAN (\$250.00 + \$20.00 ACRE) ¹
☐ AMENDED SITE PLAN/ELEVATIONS/LANDSCAPING PLAN (\$100.00)

ZONING APPLICATION FEES:

- ☐ ZONING CHANGE (\$200.00 + \$15.00 ACRE) ¹
☐ SPECIFIC USE PERMIT (\$200.00 + \$15.00 ACRE) ^{1 & 2}
☐ PD DEVELOPMENT PLANS (\$200.00 + \$15.00 ACRE) ¹

OTHER APPLICATION FEES:

- ☐ TREE REMOVAL (\$75.00)
☐ VARIANCE REQUEST/SPECIAL EXCEPTIONS (\$100.00) ²

NOTES:

¹: IN DETERMINING THE FEE, PLEASE USE THE EXACT ACREAGE WHEN MULTIPLYING BY THE PER ACRE AMOUNT. FOR REQUESTS ON LESS THAN ONE ACRE, ROUND UP TO ONE (1) ACRE.

²: A \$1,000.00 FEE WILL BE ADDED TO THE APPLICATION FEE FOR ANY REQUEST THAT INVOLVES CONSTRUCTION WITHOUT OR NOT IN COMPLIANCE TO AN APPROVED BUILDING PERMIT.

PROPERTY INFORMATION [PLEASE PRINT]

ADDRESS A0207 E Teal, Tract 134-12, Acres 2.564 Prop ID# 30591; Spyglass Hill #4, Block A, Lot 4, Acres 4.316 Prop ID# 29883

SUBDIVISION Marina Village

LOT

BLOCK

GENERAL LOCATION Henry M Chandler Dr, Behind Marina

ZONING, SITE PLAN AND PLATTING INFORMATION [PLEASE PRINT]

CURRENT ZONING PD-8, Ord No. 21-38

CURRENT USE

PROPOSED ZONING PD-8, Ord No. 21-38

PROPOSED USE Multi-Family Residential

ACREAGE 6.889

LOTS [CURRENT] 1

LOTS [PROPOSED] 36

- ☐ **SITE PLANS AND PLATS:** BY CHECKING THIS BOX YOU ACKNOWLEDGE THAT DUE TO THE PASSAGE OF HB3167 THE CITY NO LONGER HAS FLEXIBILITY WITH REGARD TO ITS APPROVAL PROCESS, AND FAILURE TO ADDRESS ANY OF STAFF'S COMMENTS BY THE DATE PROVIDED ON THE DEVELOPMENT CALENDAR WILL RESULT IN THE DENIAL OF YOUR CASE.

OWNER/APPLICANT/AGENT INFORMATION [PLEASE PRINT/CHECK THE PRIMARY CONTACT/ORIGINAL SIGNATURES ARE REQUIRED]

☐ OWNER LTL Family Holdings, LLC

☐ APPLICANT Michael Joyce Properties

CONTACT PERSON William Johnson

CONTACT PERSON Ryan Joyce

ADDRESS 14918 Mystic Terrace Lane

ADDRESS 767 Justin Road

CITY, STATE & ZIP Cypress, TX 77429

CITY, STATE & ZIP Rockwall, TX 75087

PHONE

PHONE

512-965-6280

E-MAIL

E-MAIL

ryan@michaeljoyceproperties.com

NOTARY VERIFICATION [REQUIRED]

BEFORE ME, THE UNDERSIGNED AUTHORITY, ON THIS DAY PERSONALLY APPEARED William Johnson [OWNER] THE UNDERSIGNED, WHO STATED THE INFORMATION ON THIS APPLICATION TO BE TRUE AND CERTIFIED THE FOLLOWING:

"I HEREBY CERTIFY THAT I AM THE OWNER FOR THE PURPOSE OF THIS APPLICATION; ALL INFORMATION SUBMITTED HEREIN IS TRUE AND CORRECT; AND THE APPLICATION FEE OF \$ 437.78 TO COVER THE COST OF THIS APPLICATION, HAS BEEN PAID TO THE CITY OF ROCKWALL ON THIS THE 14 DAY OF October, 2022. BY SIGNING THIS APPLICATION, I AGREE THAT THE CITY OF ROCKWALL (I.E. "CITY") IS AUTHORIZED AND PERMITTED TO PROVIDE INFORMATION CONTAINED WITHIN THIS APPLICATION TO THE PUBLIC. THE CITY IS ALSO AUTHORIZED AND PERMITTED TO REPRODUCE ANY COPYRIGHTED INFORMATION SUBMITTED IN CONJUNCTION WITH THIS APPLICATION, IF SUCH REPRODUCTION IS ASSOCIATED OR IN RESPONSE TO A REQUEST FOR PUBLIC INFORMATION."


GIVEN UNDER MY HAND AND SEAL OF OFFICE ON THIS THE 14 DAY OF October, 2022.

OWNER'S SIGNATURE

[Signature]

NOTARY PUBLIC IN AND FOR THE STATE OF TEXAS

[Signature]

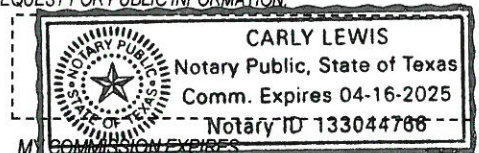

4-16-25




City of Rockwall

Planning & Zoning Department
385 S. Goliad Street
Rockwall, Texas 75032
(P): (972) 771-7745
(W): www.rockwall.com

The City of Rockwall GIS maps are continually under development and therefore subject to change without notice. While we endeavor to provide timely and accurate information, we make no guarantees. The City of Rockwall makes no warranty, express or implied, including warranties of merchantability and fitness for a particular purpose. Use of the information is the sole responsibility of the user.



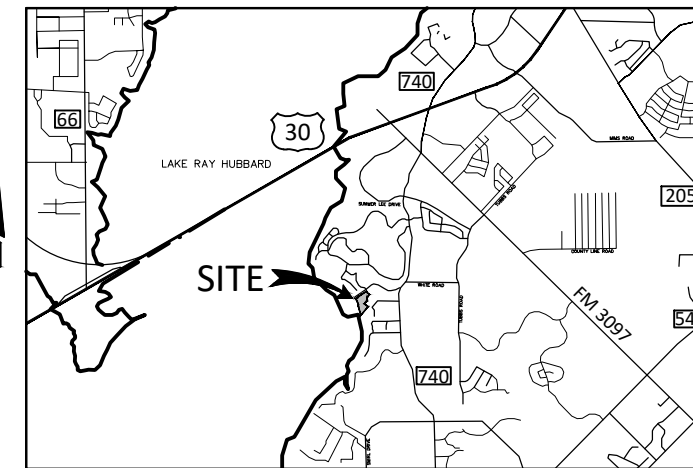

VICINITY MAP
N.T.S.


LEGEND

- Point of Curvature or Tangency on Center Line
- 1/2" Iron rod set with a yellow plastic cap stamped "JVC" (unless otherwise noted)
- 1/2" IRF (unless otherwise noted)

AC	Acre
BL	Building Line
C1	Curve No.
<CM>	Control Monument
DE	Drainage Easement
WLE	Water Line Easement
SSE	Sanitary Sewer Easement
Esmt	Easement
L1	Line No.
SF	Square Feet
UE	Utility Easement
PE	Pedestrian Easement
PUDE	Pedestrian, Utility & Drainage Easement
VAM	Visibility Easement

D.R.R.C.T.= Deed Records of Rockwall County, Texas
P.R.R.C.T.= Plat Records of Rockwall County, Texas
M.R.R.C.T.= Map Records of Rockwall County, Texas
O.R.R.C.T.= Official Records of Rockwall County, Texas

Easement Abandonment

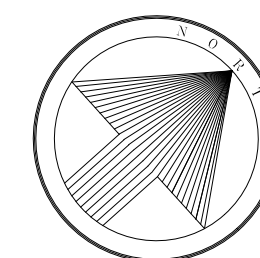

SCALE 1" = 60'

FINAL PLAT MARINA VILLAGE

LOTS 1X, 2-29, 30X, 31X, 32-39 BLOCK A
6.889 ACRES

36 TOWNHOME LOTS AND
4 COMMON AREAS

SITUATED WITHIN THE
EDWARD TEAL SURVEY, ABSTRACT NO. 207

CITY OF ROCKWALL
ROCKWALL COUNTY, TEXAS

P2022-008

October 14, 2022

SHEET 1 OF 2



JBPELS: Engineering Firm No. 11962 / Land Surveying Firm No. 10194033
704 Central Parkway East | Suite 1200 | Plano, TX 75074 | 972.201.3100

Owner/Applicant:
LTL Family Holdings, LLC
William Johnson
14918 Mystic Terrace Lane
Cyprus, Texas 77429
Phone: 713-325-4294

Engineer/Surveyor:
Johnson Volk Consulting, Inc.
704 Central Parkway East, Suite. 1200
Plano, Texas 75074
Phone: 682-225-7189
Contact: Tom Dayton, PE

TRACT ONE
RAY HUBBARD
DOCUMENT NO. 2016-22170
D.R.R.C.T.

HARBOR LANDING PHASE TWO
CABINET C, PAGE 110
M.R.R.C.T.

HARBOR LANDING PHASE ONE
CABINET B, PAGE 362
M.R.R.C.T.

EX. 15' UTILITY
EASEMENT

HARBOR LANDING DR.
EXISTING 30' W.
RIGHT-OF-WAY

HENRY M. CHANDLER DRIVE

POINT OF
BEGINNING

N: 7007539.35
E: 2588822.58

21,468 S.F. PORTION
OF 15' UTILITY ESMT.
TO BE ABANDONED
BY THIS PLAT
CABINET B, PG. 146-147
P.R.R.C.T.

278 HENRY M CHANDLER DR

RYAN S. HUDDIN AND
JADA HUDDIN
DOCUMENT NO. 20190000001989
D.R.R.C.T.

LOT 3, BLOCK A
SPYGLASS HILL CONDOMINIUMS, PHASE 3
CABINET B, PAGE 175
M.R.R.C.T.

6,646 S.F. PORTION
OF 15' UTILITY ESMT.
TO BE ABANDONED
BY THIS PLAT
CABINET B, PG. 146-147
P.R.R.C.T.

CITY OF ROCKWALL
CITY OF HEATH

GENERAL NOTES:

- ALL LOT CORNERS MONUMENTED WITH A 1/2" IRON ROD WITH A YELLOW PLASTIC CAP STAMPED "JVC" UNLESS OTHERWISE NOTED.
- ALL UTILITY EASEMENTS AND DRAINAGE EASEMENTS WITHIN THIS PLATTED PROPERTY ARE CREATED BY THIS PLAT, UNLESS OTHERWISE NOTED.
- BASIS OF BEARING AND COORDINATES SHOWN HEREON REFER TO "TEXAS STATE PLANE COORDINATE SYSTEM, NORTH CENTRAL ZONE (4202), NORTH AMERICAN DATUM OF 1983 ON GRID COORDINATE VALUES.
- LOCATION OF 1% ANNUAL FLOOD CHANCE ESTIMATED FROM FEMA FIRM PANEL 48139C0325F DATED JUNE 3, 2013.
- LOTS ADJACENT TO FLOODPLAIN SHALL HAVE A MINIMUM FINISHED FLOOR ELEVATION 2' ABOVE THE 100-YR WSEL.
- IT SHALL BE THE POLICY OF THE CITY OF ROCKWALL TO WITHHOLD ISSUING BUILDING PERMITS UNTIL ALL STREETS, WATER, SEWER AND STORM DRAINAGE SYSTEMS HAVE BEEN ACCEPTED BY THE CITY. THE APPROVAL OF A PLAT BY THE CITY DOES NOT CONSTITUTE ANY REPRESENTATION, ASSURANCE OR GUARANTEE THAT ANY BUILDING WITHIN SUCH PLAT SHALL BE APPROVED, AUTHORIZED OR PERMIT THEREFORE ISSUED, NOR SHALL SUCH APPROVAL CONSTITUTE ANY REPRESENTATION, ASSURANCE OR GUARANTEE BY THE CITY OF THE ADEQUACY AND AVAILABILITY FOR WATER FOR PERSONAL USE AND FIRE PROTECTION WITHIN SUCH PLAT, AS REQUIRED UNDER ORDINANCE 83-54.
- PROPERTY OWNER SHALL BE RESPONSIBLE FOR MAINTAINING, REPAIRING, AND REPLACING ALL SYSTEMS WITHIN THE DRAINAGE AND DETENTION EASEMENTS.
- ALL ROW, PAVING AND DRAINAGE SHALL BE PRIVATE AND MAINTAINED, REPLACED AND REPAIRED BY HOA/PROPERTY OWNER.

BENCHMARKS

CITY OF ROCKWALL MONUMENT NO. COR-5:
STANDARD CITY OF ROCKWALL CONTROL MONUMENT LOCATED AT THE NORTHEAST CORNER OF THE INTERSECTION OF HENRY W. CHANDLER DRIVE AND COMMODORE PLAZA APPROXIMATELY 400' WEST OF THE INTERSECTION OF HENRY W. CHANDLER DRIVE AND RIDGE ROAD.
ELEVATION = PLAN 560.58' FIELD 561.09'

CITY OF ROCKWALL MONUMENT NO. COR-7:
STANDARD CITY OF ROCKWALL CONTROL MONUMENT LOCATED ON THE SOUTH SIDE OF SUMMER LEE DRIVE APPROXIMATELY 250' WEST OF THE INTERSECTION OF SUMMER LEE DRIVE AND RIDGE ROAD.
ELEVATION = PLAN 567.52' FIELD 567.78'

CITY OF ROCKWALL MONUMENT NO. COR-10:
BRASS DISK STAMPED "CITY OF ROCKWALL SURVEY MONUMENT" ON THE SOUTHEAST SIDE OF LAGUNA DRIVE AT THE SOUTHEAST CORNER OF A CURB INLET APPROXIMATELY 325' NORTHEAST OF THE INTERSECTION OF VILLAGE LANE AND LAGUNA DRIVE.
ELEVATION = PLAN 521.61' FIELD 521.57'

CITY OF ROCKWALL MONUMENT NO. COR-11:
BRASS DISK STAMPED "CITY OF ROCKWALL SURVEY MONUMENT" ON THE NORTHEAST SIDE OF MIMS ROAD AT THE SOUTHERLY END OF A CONCRETE HEADWALL AT THE INTERSECTION OF THE NORTHEAST LINE OF MIMS ROAD WITH THE SOUTHEAST LINE OF I-30.
ELEVATION = PLAN 565.98' FIELD 566.02'

STATE OF TEXAS §
COUNTY OF ROCKWALL §

WHEREAS L.T.L. Family Holdings, LLC, BEING THE OWNER OF A TRACT OF land in the County of Rockwall, State of Texas, said tract being described as follows:

BEING a tract of land situated in the E. TEAL SURVEY, ABSTRACT NO. 207, City of Rockwall, Rockwall County, Texas and being all of Lot 4, Block A of SPYGLASS HILL CONDOMINIUMS PHASE FOUR, an Addition to the City of Rockwall, Rockwall County, Texas according to the Plat thereof recorded in Cabinet B, Page 146, Map Records, Rockwall County, Texas and being all of that tract of land described in Deed to L.T.L. Family Holdings, LLC, as recorded in Document No. 20210000034919, Deed Records, Rockwall County, Texas and being more particularly described as follows:

BEGINNING at a 1/2 inch iron rod with a yellow plastic cap stamped "BISON CREEK" found in the southeast line of Henry Chandler Drive, an 80 foot right-of-way, for the common northeast corner of said L.T.L. Family Holdings, LLC tract, northeast corner of said Lot 4 and northwest corner of Lot 3, Block A of SPYGLASS HILL CONDOMINIUMS, PHASE 3, an Addition to the City of Rockwall, Rockwall County, Texas according to the Plat thereof recorded in Cabinet B, Page 175, Map Records, Rockwall County, Texas;

THENCE Southerly, with the common east line of said Lot 4, east line of said L.T.L. Family Holdings, LLC tract and west line of said Lot 3, the following seven (7) courses and distances:

South 04 degrees 01 minutes 18 seconds East, leaving said southeast line, a distance of 39.64 feet to a 1/2 inch iron rod found for corner;

South 49 degrees 01 minutes 18 seconds East, a distance of 160.16 feet to a 1/2 inch iron rod found for corner;

South 36 degrees 41 minutes 52 seconds West, a distance of 180.50 feet to a 1/2 inch iron rod with a yellow plastic cap stamped "BISON CREEK" found for corner;

South 04 degrees 01 minutes 18 seconds East, a distance of 142.73 feet to a 1/2 inch iron rod with a yellow plastic cap stamped "BISON CREEK" found for corner;

South 47 degrees 49 minutes 42 seconds West, a distance of 95.59 feet to a 1/2 inch iron rod found for corner;

South 40 degrees 58 minutes 42 seconds West, a distance of 56.00 feet to a 1/2 inch iron rod with a yellow plastic cap stamped "BISON CREEK" found for corner;

South 49 degrees 01 minutes 18 seconds East, a distance of 203.00 feet to a 1/2 inch iron rod found in the northwest line of WINDWARD SLOPE, an Addition to the City of Rockwall, Rockwall County, Texas according to the Plat thereof recorded in Cabinet A, page 368, Map Records, Rockwall County, Texas for the common south corner of said Lot 3 and an exterior ell corner of said Lot 4 and said L.T.L. Family Holdings, LLC tract;

THENCE South 40 degrees 58 minutes 42 seconds West, with the common southeast line of said Lot 4 and said L.T.L. Family Holdings, LLC tract and said northwest line, a distance of 480.10 feet to a 1/2 inch iron rod with a yellow plastic cap stamped "JVC" set for the common south corner of said Lot 4 and said L.T.L. Family Holdings, LLC tract;

THENCE Northerly, with the west line of said L.T.L. Family Holdings, LLC tract, the following four (4) courses and distances:

North 15 degrees 09 minutes 39 seconds West, a distance of 407.29 feet to a 1/2 inch iron rod with a yellow plastic cap stamped "JVC" set for corner;

North 02 degrees 08 minutes 12 seconds West, a distance of 70.75 feet to a 1/2 inch iron rod with a yellow plastic cap stamped "BISON CREEK" found for corner;

North 21 degrees 26 minutes 12 seconds West, a distance of 156.54 feet to a 1/2 inch iron rod with a yellow plastic cap stamped "BISON CREEK" found for corner;

North 32 degrees 04 minutes 21 seconds West, a distance of 109.80 feet to a 1/2 inch iron rod with a yellow plastic cap stamped "JVC" set in the southeast line of the above mentioned Henry Chandler Drive for the northwest corner of said L.T.L. Family Holdings, LLC tract;

THENCE Northeasterly, with said southeast line, the following four (4) courses and distances:

North 57 degrees 55 minutes 37 seconds East, a distance of 90.00 feet to a 1/2 inch iron rod found for corner;

North 44 degrees 54 minutes 57 seconds East, a distance of 54.37 feet to a 1/2 inch iron rod found for corner at the beginning of a curve to the right having a central angle of 18 degrees 36 minutes 42 seconds, a radius of 471.19 feet and a chord bearing and distance of North 54 degrees 13 minutes 19 seconds East, 152.39 feet;

Northeasterly, with said curve to the right, an arc distance of 153.06 feet to a 1/2 inch iron rod with a yellow plastic cap stamped "JVC" set for corner at the beginning of a reverse curve to the left having a central angle of 15 degrees 20 minutes 06 seconds, a radius of 1,040.00 feet and a chord bearing and distance of North 55 degrees 51 minutes 37 seconds East, 277.52 feet;

Northeasterly, with said curve to the left, an arc distance of 278.35 feet to the POINT OF BEGINNING and containing 6.889 acres of land, more or less.

Line Table		
Line	Length	Direction
L1	39.64	S4° 01' 18"E
L2	56.00	S40° 58' 42"W
L3	70.75	N2° 08' 12"W
L4	48.71	N44° 54' 57"E
L5	7.87	N37° 31' 07"E
L6	75.93	N35° 35' 51"W
L7	10.11	N54° 16' 59"W
L8	34.22	S76° 43' 41"W
L9	44.06	S48° 17' 23"W
L10	51.06	S32° 31' 55"E
L11	26.01	S85° 01' 36"E
L12	21.71	N10° 45' 15"E
L13	8.92	N35° 35' 51"W
L14	28.27	S58° 28' 11"E
L15	28.28	N31° 30' 26"E
L16	28.64	S76° 19' 54"E
L17	28.68	S11° 22' 41"W

Curve Table					
Curve #	Length	Radius	Delta	Chord Length	Chord Bearing
C1	153.06	471.19	018°36'42"	152.39	N54° 13' 19"E
C2	278.35	1040.00	015°20'06"	277.52	N55° 51' 37"E
C3	96.53	250.00	022°07'23"	95.93	N24° 32' 09"W
C4	35.61	50.00	040°48'31"	34.86	S33° 52' 43"E
C5	99.27	200.00	028°26'17"	98.25	N62° 30' 32"E
C6	47.35	50.00	054°15'21"	45.60	N21° 09' 42"E
C7	77.19	250.00	017°41'27"	76.88	N14° 48' 42"W
C8	38.72	250.00	008°52'30"	38.69	N28° 05' 40"W
C9	30.07	189.50	009°05'28"	30.04	N21° 23' 59"W
C10	81.28	210.50	022°07'23"	80.77	N24° 32' 09"W
C11	10.65	20.00	030°29'56"	10.52	N01° 46' 30"E
C12	191.73	54.00	203°26'04"	105.75	N19° 00' 37"E
C13	24.17	20.00	069°13'57"	22.72	S48° 05' 27"E
C14	100.81	225.00	025°40'18"	99.97	N61° 07' 32"E
C15	10.62	225.00	002°42'17"	10.62	S28° 58' 42"E
C16	76.17	175.00	024°56'24"	75.57	N60° 45' 35"E
C17	39.36	96.46	023°22'43"	39.09	S22° 39' 49"W

OWNER'S CERTIFICATION:

NOW THEREFORE, KNOW ALL MEN BY THESE PRESENTS:

STATE OF TEXAS §
COUNTY OF ROCKWALL §

I (we) the undersigned owner(s) of the land shown on this plat, and designated herein as the MARINA VILLAGE subdivision to the City of Rockwall, Texas, and whose name is subscribed hereto, hereby dedicate to the use of the public forever any streets, alleys, parks, water courses, drains, easements and public places thereon shown on the purpose and consideration therein expressed. I (we) further certify that all other parties who have a mortgage or lien interest in the MARINA VILLAGE subdivision have been notified and signed this plat. I (we) understand and do hereby reserve the easement strips shown on this plat for the purposes stated and for the mutual use and accommodation of all utilities desiring to use or using same. I (we) also understand the following:

- No buildings shall be constructed or placed upon, over, or across the utility easements as described herein.
- Any public utility shall have the right to remove and keep removed all or part of any buildings, fences, trees, shrubs, or other growths or improvements which in any way endanger or interfere with construction, maintenance or efficiency of their respective system on any of these easement strips; and any public utility shall at all times have the right of ingress or egress to, from and upon the said easement strips for purpose of construction, reconstruction, inspecting, patrolling, maintaining, and either adding to or removing all or part of there respective system without the necessity of, at any time, procuring the permission of anyone.
- The City of Rockwall will not be responsible for any claims of any nature resulting from or occasioned by the establishment of grade of streets in the subdivision.
- The developer and subdivision engineer shall bear total responsibility for storm drain improvements.
- The developer shall be responsible for the necessary facilities to provide drainage patterns and drainage controls such that properties within the drainage area are not adversely affected by storm drainage from the development.
- No house dwelling unit, or other structure shall be constructed on any lot in this addition by the owner or any other person until the developer and/or owner has complied with all requirements of the Subdivision Regulations of the City of Rockwall regarding improvements with respect to the entire block on the street or streets on which property abuts, including the actual installation of streets with the required base and paving, curb and gutter, water and sewer, drainage structures, storm sewers, and alleys all according to the specifications of the City of Rockwall; or

Until an escrow deposit, sufficient to pay for the cost of such improvements, as determined by the city's engineer and/or city administrator, computed on a private commercial rate basis, has been made with the city secretary, accompanied by an agreement signed by the developer and/or owner, authorizing the city to make such improvements at prevailing private commercial rates, or have the same made by a contractor and pay the same out of the escrow deposit, should the developer and/or owner fail to refuse to install the required improvements within the time stated in such written agreement, but in no case shall the City be obligated to make such improvements itself. Such deposit may be used by the owner and/or developer as progress payments as the work progresses in making such improvements by making certified requisitions to the city secretary, supported by evidence of work done; or

Until the developer and/or owner files a corporate surety bond with the city secretary in a sum equal to the cost of such improvements for the designated area, guaranteeing the installation thereof within the time stated in the bond, which shall be fixed by the city council of the City of Rockwall.

I (we) further acknowledge that the dedications and/or exactions made herein are proportional to the impact of the Subdivision upon the public services required in order that the development will comport with the present and future growth needs of the City; I (we), my (our) successors and assigns hereby waive any claim, damage, or cause of action that I (we) may have as a result of the dedication of exactions made herein.

Property Owner Signature

STATE OF TEXAS §
COUNTY OF ROCKWALL §

BEFORE ME, the undersigned authority, on this day personally appeared L.T.L. Family Holdings, LLC, known to me to be the person whose name is subscribed to the foregoing instrument and acknowledged to me that he executed the same for the purpose and consideration therein stated.

Given under my hand and seal of office, this ____ day of _____, 2022.

Notary public in and for the State of Texas

My Commission Expires

STATE OF TEXAS §
COUNTY OF ROCKWALL §

BEFORE ME, the undersigned authority, on this day personally appeared L.T.L. Family Holdings, LLC, known to me to be the person whose name is subscribed to the foregoing instrument and acknowledged to me that he executed the same for the purpose and consideration therein stated.

Given under my hand and seal of office, this ____ day of _____, 2022.

Notary public in and for the State of Texas

My Commission Expires

SURVEYOR'S CERTIFICATE:

NOW, THEREFORE KNOW ALL MEN BY THESE PRESENTS:

THAT I, Ryan S. Reynolds, do hereby certify that I prepared this plat from an actual and accurate survey of the land, and that the corner monuments shown thereon were properly placed under my personal supervision.

RYAN S. REYNOLDS, R.P.L.S.
Texas Registered Professional Land Surveyor No. 6385.

STATE OF TEXAS §
COUNTY OF COLLIN §

BEFORE ME, the undersigned authority, on this day personally appeared Ryan S. Reynolds, known to me to be the person whose name is subscribed to the above and foregoing instrument, and acknowledged to me that he executed the same for the purposes and consideration expressed and in the capacity therein stated.

Given under my hand and seal of office, this ____ day of _____, 2022.

Notary public for and in the State of Texas

My commission expires: _____

Planning & Zoning Commission, Chairperson

Date

APPROVED:
I hereby certify that the above and foregoing plat of an addition to the City of Rockwall, Texas be approved by the City Council of the City of Rockwall on ____ day of _____, 2022.

This approval shall be invalid unless the approved plat for such addition is recorded in the office of the County Clerk of Rockwall, County, Texas, within one hundred eighty (180) days from said date of approval.

WITNESS OUR HANDS, this ____ day of _____, 2022.

Mayor, City of Rockwall

City Secretary

City Engineer

FINAL PLAT
MARINA VILLAGE

LOTS 1X, 2-29, 30X, 31X, 32-39 BLOCK A
6.889 ACRES

36 TOWNHOME LOTS AND

4 COMMON AREAS

SITUATED WITHIN THE

EDWARD TEAL SURVEY, ABSTRACT NO. 107

CITY OF ROCKWALL

ROCKWALL COUNTY, TEXAS

P2022-008

October 14, 2022

SHEET 2 OF 2



JOHNSON VOLK
CONSULTING

TBPELS: Engineering Firm No. 11962 / Land Surveying Firm No. 10194033
704 Central Parkway East | Suite 1200 | Plano, TX 75074 | 972.201.3100

Owner/Applicant:

LTL Family Holdings, LLC

William Johnson

14918 Mystic Terrace Lane

Cyprus, Texas 77429

Phone: 713-325-4294

Engineer/Surveyor:

Johnson Volk Consulting, Inc.




704 Central Parkway East, Suite. 1200

Plano, Texas 75074


Phone: 682-225-7189

Contact: Tom Dayton, PE

F:\level 3d projects\2209 - marina villages - townhomes - rockwall\landscapes\2209 - treescape plan.dwg

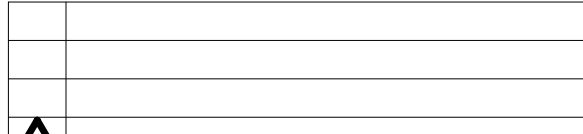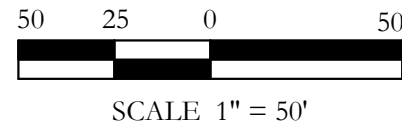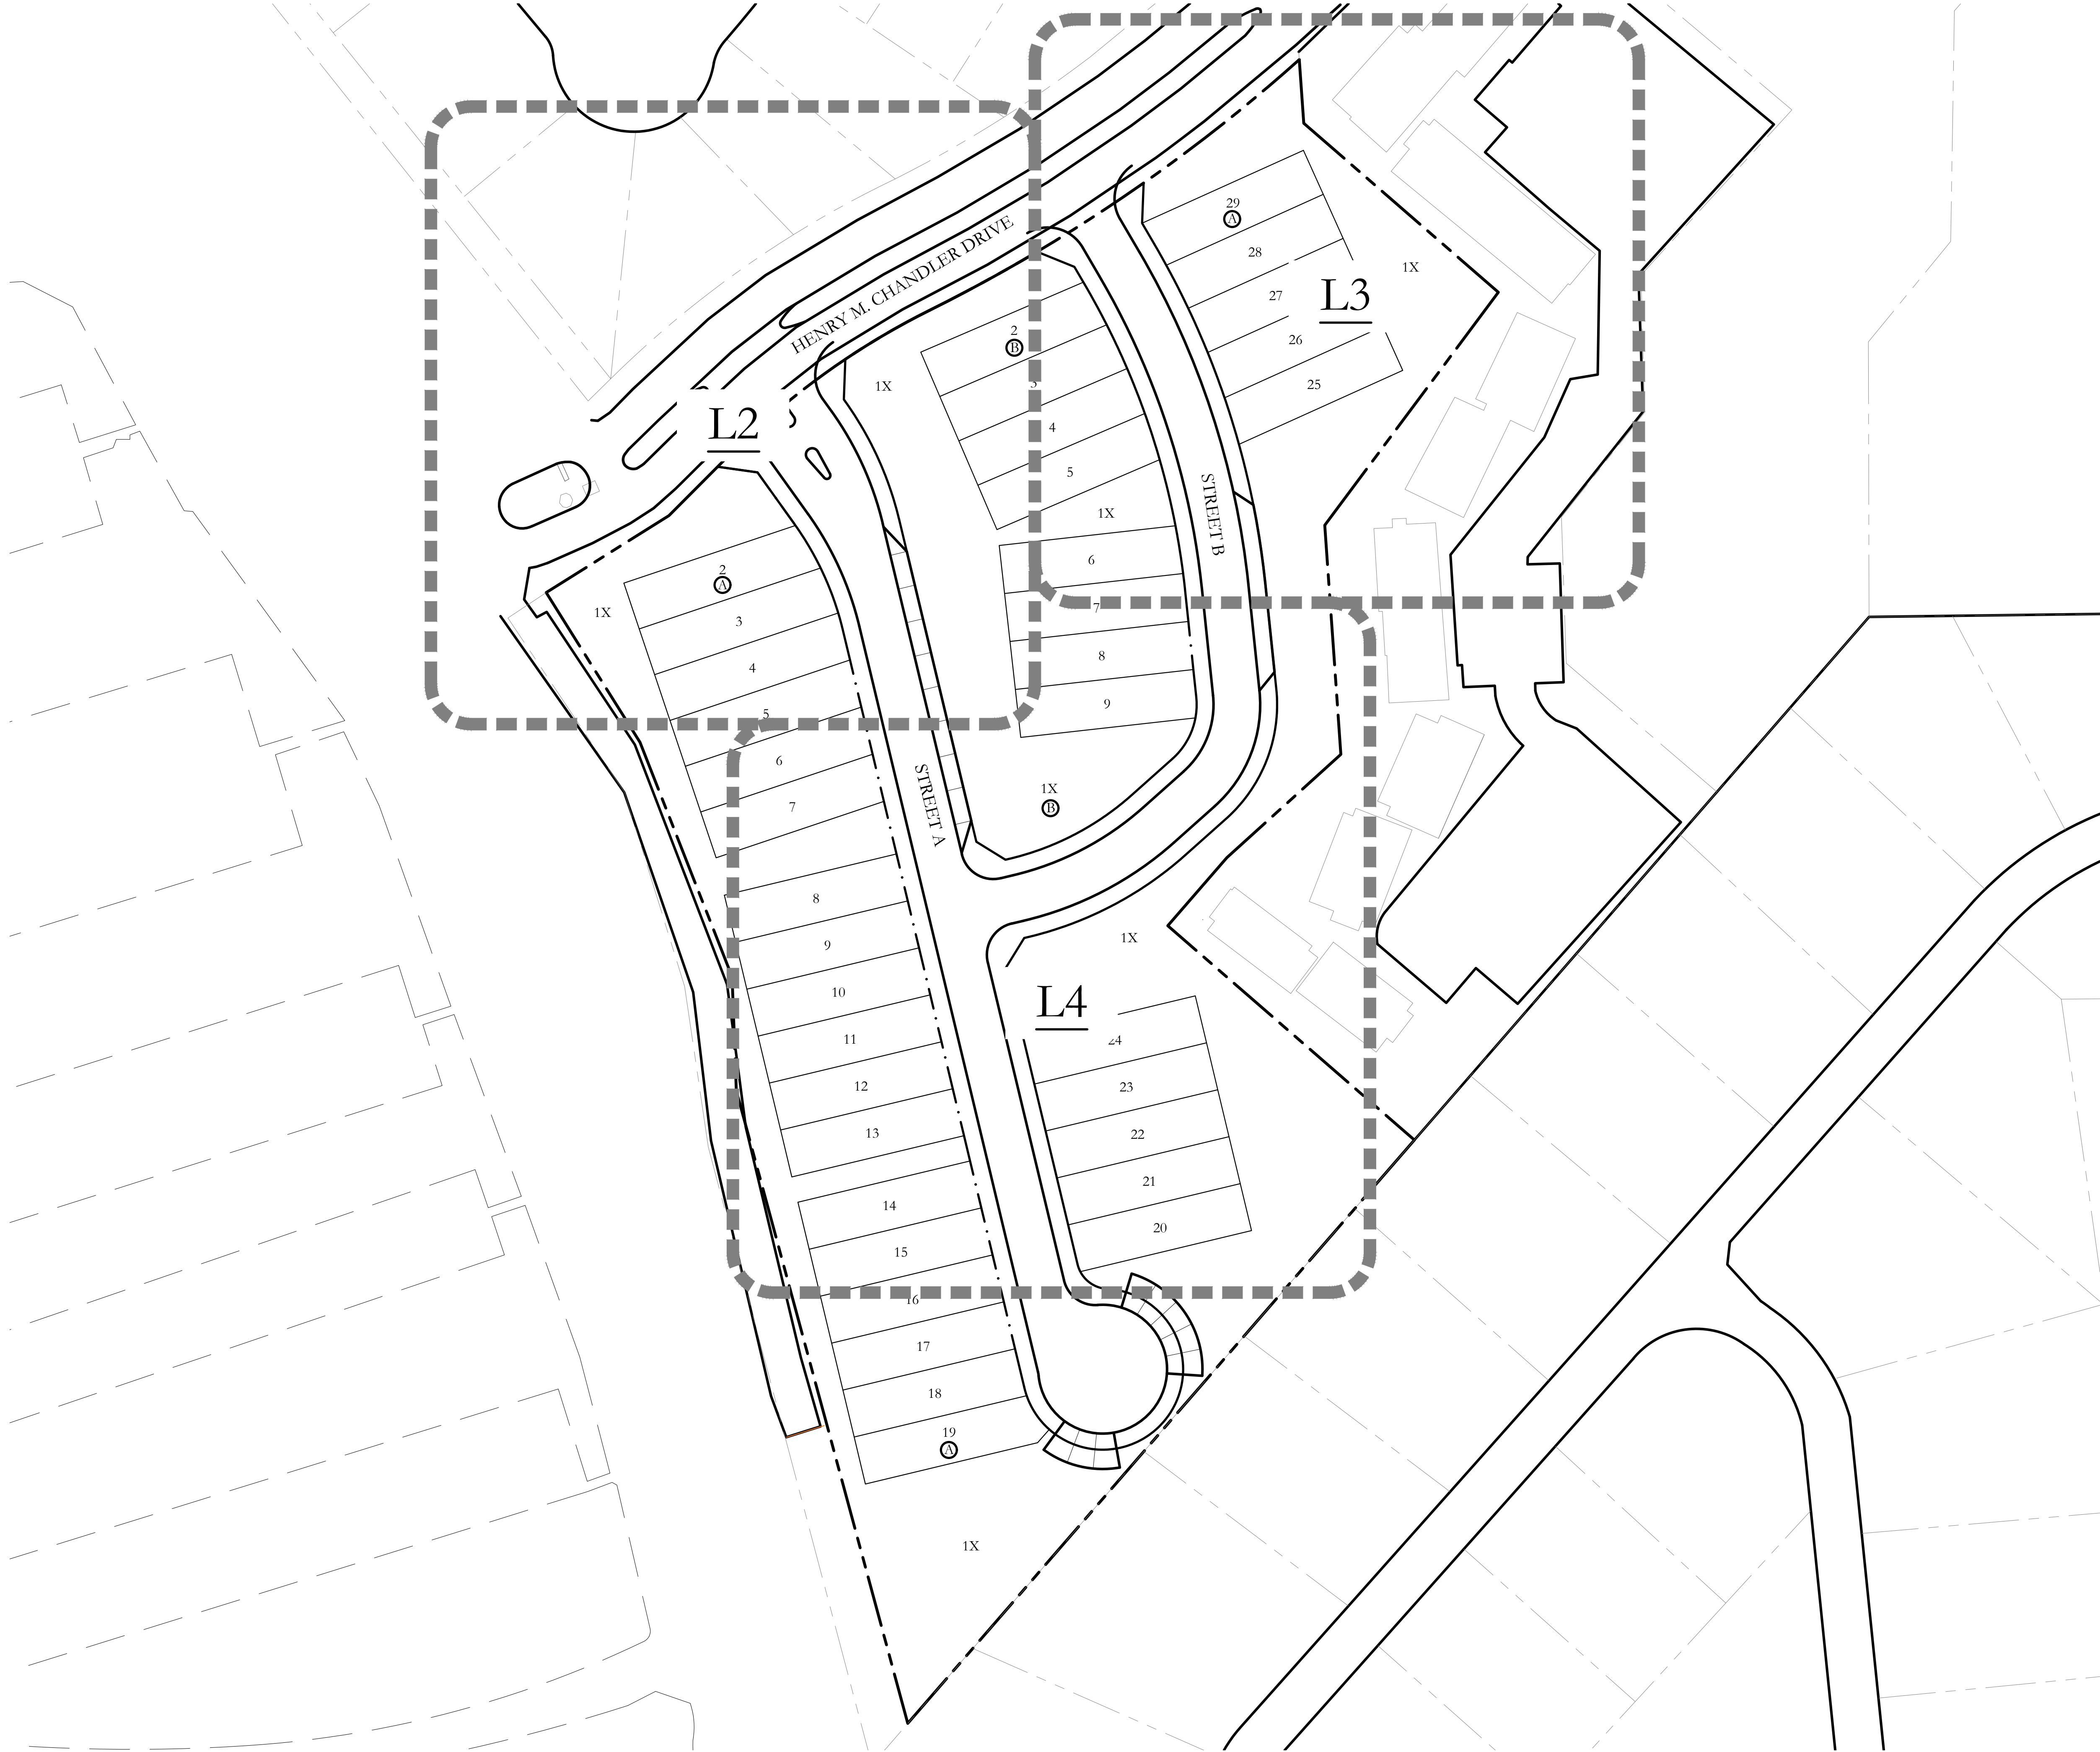

SCALE:
1" = 50'
One Inch
JVC No 2209

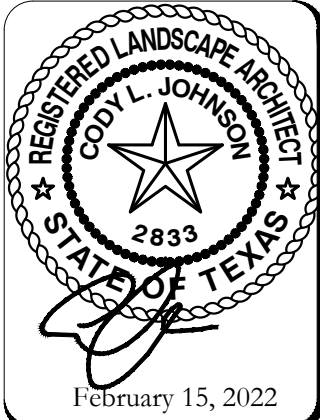


TREESCAPE PLAN
OVERALL LAYOUT PLAN

MARINA VILLAGE TOWNHOMES
CITY OF ROCKWALL
ROCKWALL COUNTY, TEXAS


JOHNSON VOLK
CONSULTING
TBPELS: Engineering Firm No. 11962 / Land Surveying Firm No. 10194033
704 Central Parkway East | Suite 1200 | Plano, TX 75074 | 972.201.3100


L1 of 5

F:\level 3\projects\2209 - marina villages - townhomes - rockwall\landscapes\2209 - treescape plan.dwg

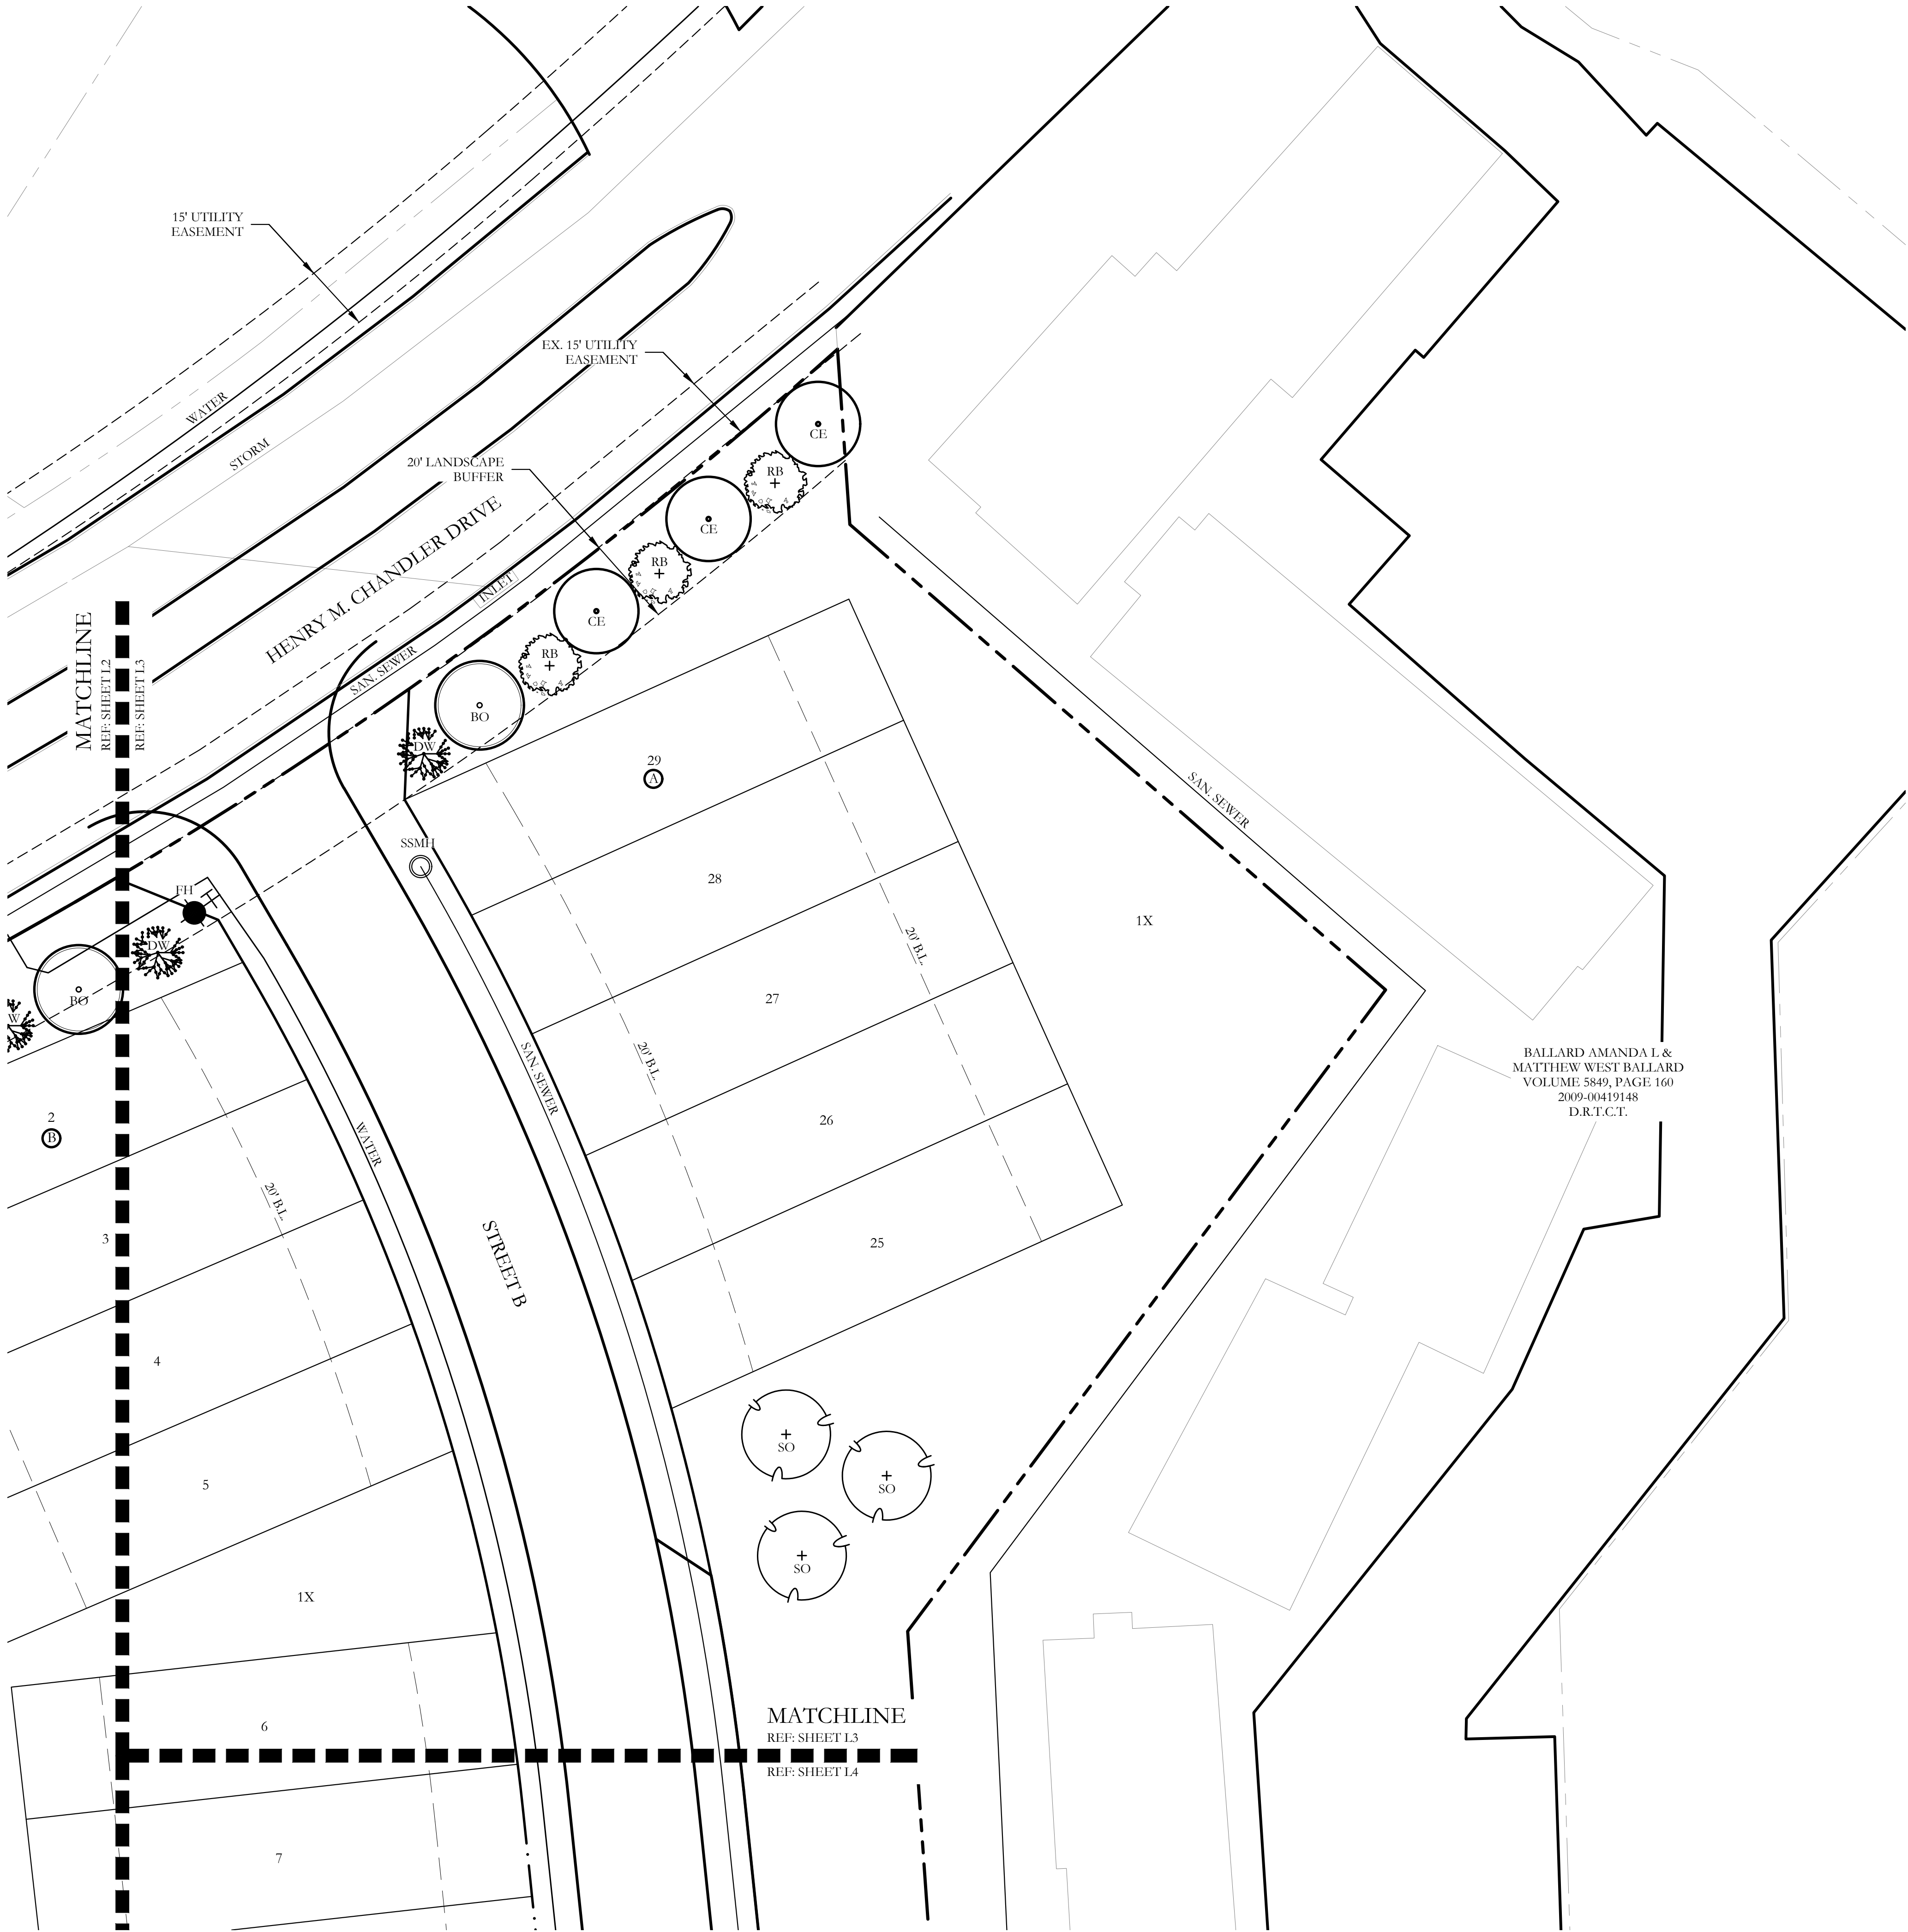

PLANT LEGEND					
SYMBOL	KEY	COMMON NAME	SCIENTIFIC NAME	SIZE	SPACING
	LO	LIVE OAK	QUERCUS VIRGINIANA	4" CALIPER	AS SHOWN
	SO	SHUMARD OAK	QUERCUS SHUMARDII	4" CALIPER	AS SHOWN
	BO	BUR OAK	QUERCUS MACROCARPA	4" CALIPER	AS SHOWN
	CE	CEDAR ELM	ULMUS CRASSIFOLIA	4" CALIPER	AS SHOWN
	DW	DESERT WILLOW	CHILOPSIS LINEARIS	2" CALIPER	AS SHOWN
	RB	TEXAS REDBUD	CERCIS CANADENSIS VAR. TEXENSIS	2" CALIPER	AS SHOWN

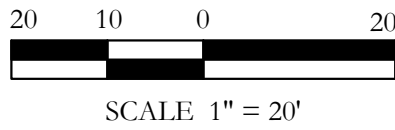


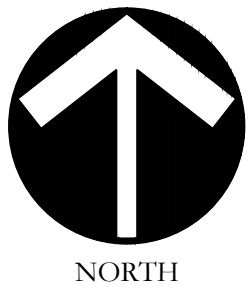


SCALE:
1" = 20'
One Inch
JVC No 2209




F:\civil 3d projects\2209 - marina villages - townhomes - rockwall\landscapes\2209 - treescape plan.dwg

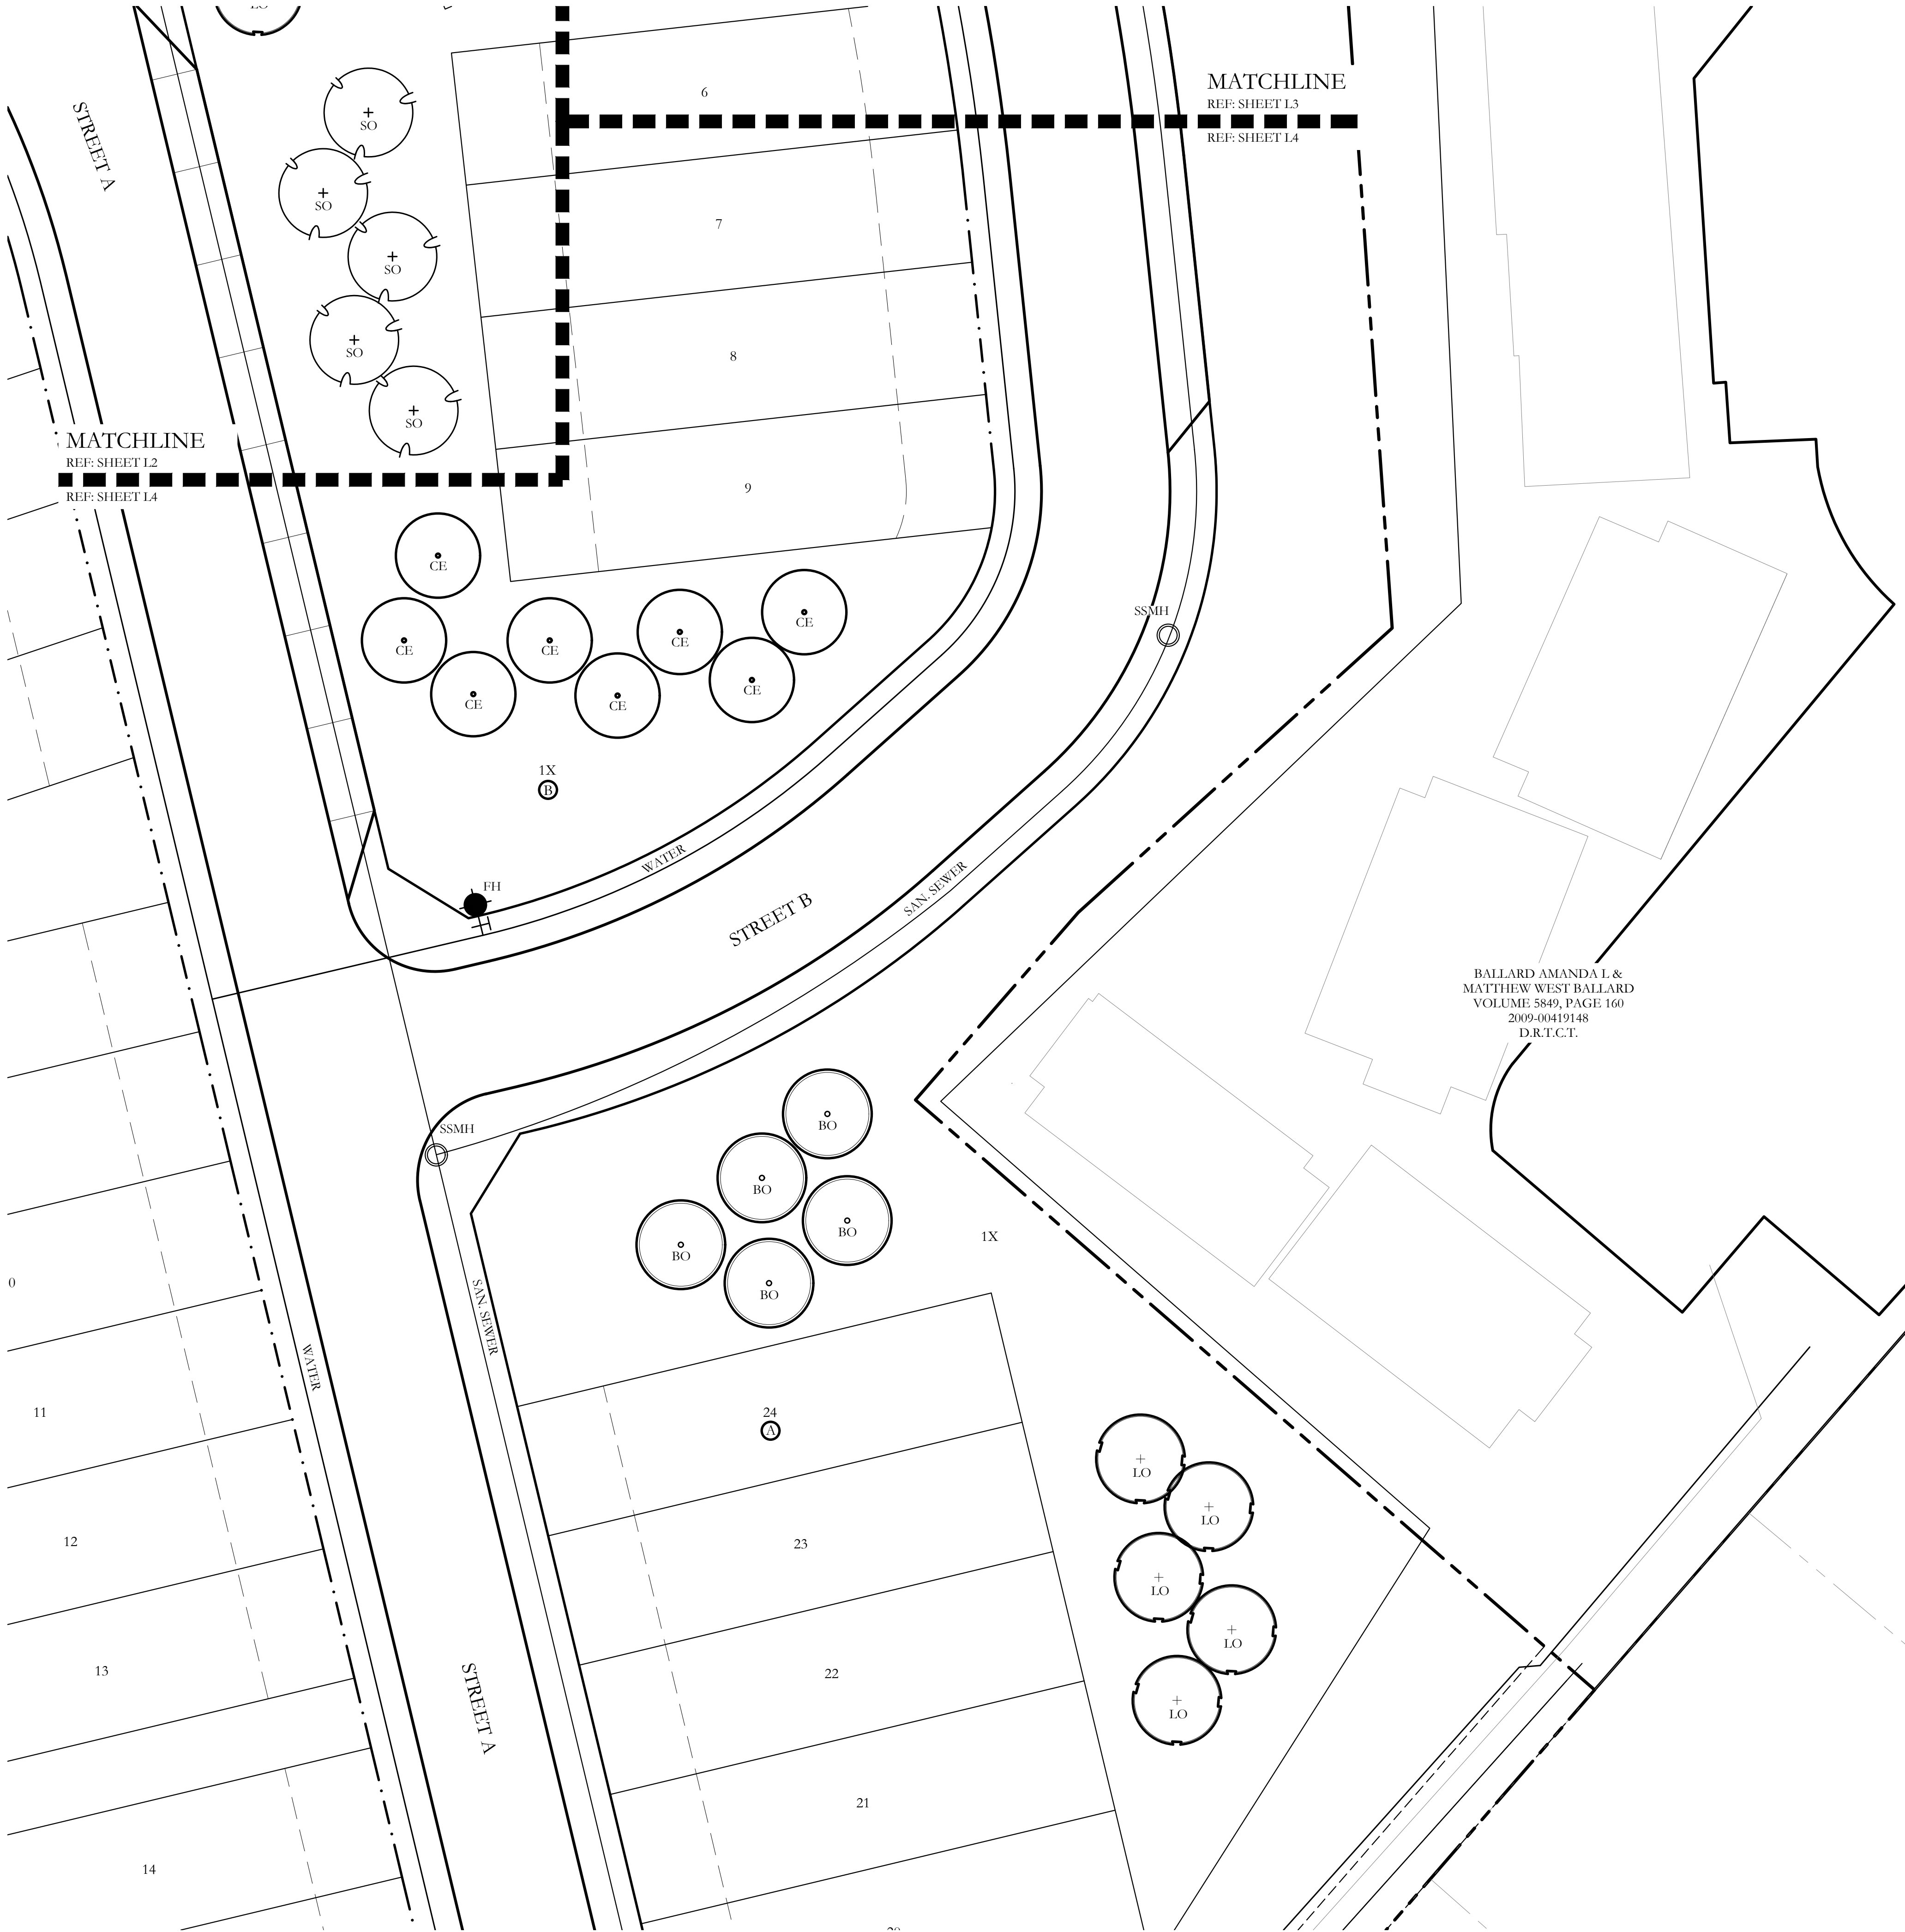

PLANT LEGEND					
SYMBOL	KEY	COMMON NAME	SCIENTIFIC NAME	SIZE	SPACING
	LO	LIVE OAK	QUERCUS VIRGINIANA	4" CALIPER	AS SHOWN
	SO	SHUMARD OAK	QUERCUS SHUMARDII	4" CALIPER	AS SHOWN
	BO	BUR OAK	QUERCUS MACROCARPA	4" CALIPER	AS SHOWN
	CE	CEDAR ELM	ULMUS CRASSIFOLIA	4" CALIPER	AS SHOWN
	DW	DESERT WILLOW	CHILOPSIS LINEARIS	2" CALIPER	AS SHOWN
	RB	TEXAS REDBUD	CERCIS CANADENSIS VAR. TEXENSIS	2" CALIPER	AS SHOWN

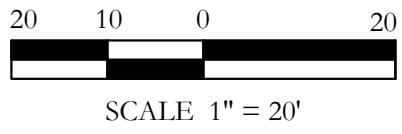

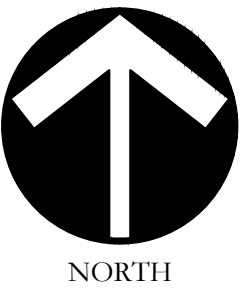

SCALE:
1" = 20'
One Inch
JVC No 2209

F:\civil 3d projects\2209 - marina villages - townhomes - rockwall\landscape\2209 - treescape planting.dwg

LANDSCAPE PROVIDED

HENRY M. CHANDLER DR.

MINIMUM TEN (10) FOOT LANDSCAPE BUFFER PROVIDED


1 - 4" CAL. CANOPY TREE & 1 ACCENT TREE / 50 LF OF LINEAR FRONTAGE
576 LF OF FRONTAGE / 50 LF = 12 - 4" CAL. TREES & 12 ACCENT TREES REQUIRED.
PROVIDED: 12 - 4" CALIPER CANOPY TREES & 13 ACCENT TREES PROVIDED

TREE MITIGATION

191.5 CAL. INCHES REMOVED

43 - 4" CAL. CANOPY TREES & 13 - 2" CAL. ACCENT TREES = 198 CAL. INCHES REPLACED.

PLANT LIST						
KEY	ESTIMATED QUANTITY	COMMON NAME	SCIENTIFIC NAME	SIZE	SPACING	REMARKS
LO	13	LIVE OAK	QUERCUS VIRGINIANA	4" CALIPER	AS SHOWN	NURSERY GROWN; FULL HEAD; MINIMUM BRANCHING HEIGHT AT 6'-0"; MINIMUM 10'-0" OVERALL HEIGHT.
SO	11	SHUMARD OAK	QUERCUS SHUMARDII	4" CALIPER	AS SHOWN	NURSERY GROWN; FULL HEAD; MINIMUM BRANCHING HEIGHT AT 6'-0"; MINIMUM 10'-0" OVERALL HEIGHT.
BO	8	BUR OAK	QUERCUS MACROCARPA	4" CALIPER	AS SHOWN	NURSERY GROWN; FULL HEAD; MINIMUM BRANCHING HEIGHT AT 6'-0"; MINIMUM 10'-0" OVERALL HEIGHT.
CE	11	CEDAR ELM	ULMUS CRASSIFOLIA	4" CALIPER	AS SHOWN	NURSERY GROWN; FULL HEAD; MINIMUM BRANCHING HEIGHT AT 6'-0"; MINIMUM 10'-0" OVERALL HEIGHT.
DW	7	DESERT WILLOW	CHILOPSIS LINEARIS	2" CALIPER	AS SHOWN	NURSERY GROWN; FULL HEAD; MINIMUM 8'-0" OVERALL HEIGHT.
RB	6	TEXAS REDBUD	CERCIS CANADENSIS VAR. TEXENSIS	2" CALIPER	AS SHOWN	NURSERY GROWN; FULL HEAD; MINIMUM 8'-0" OVERALL HEIGHT.

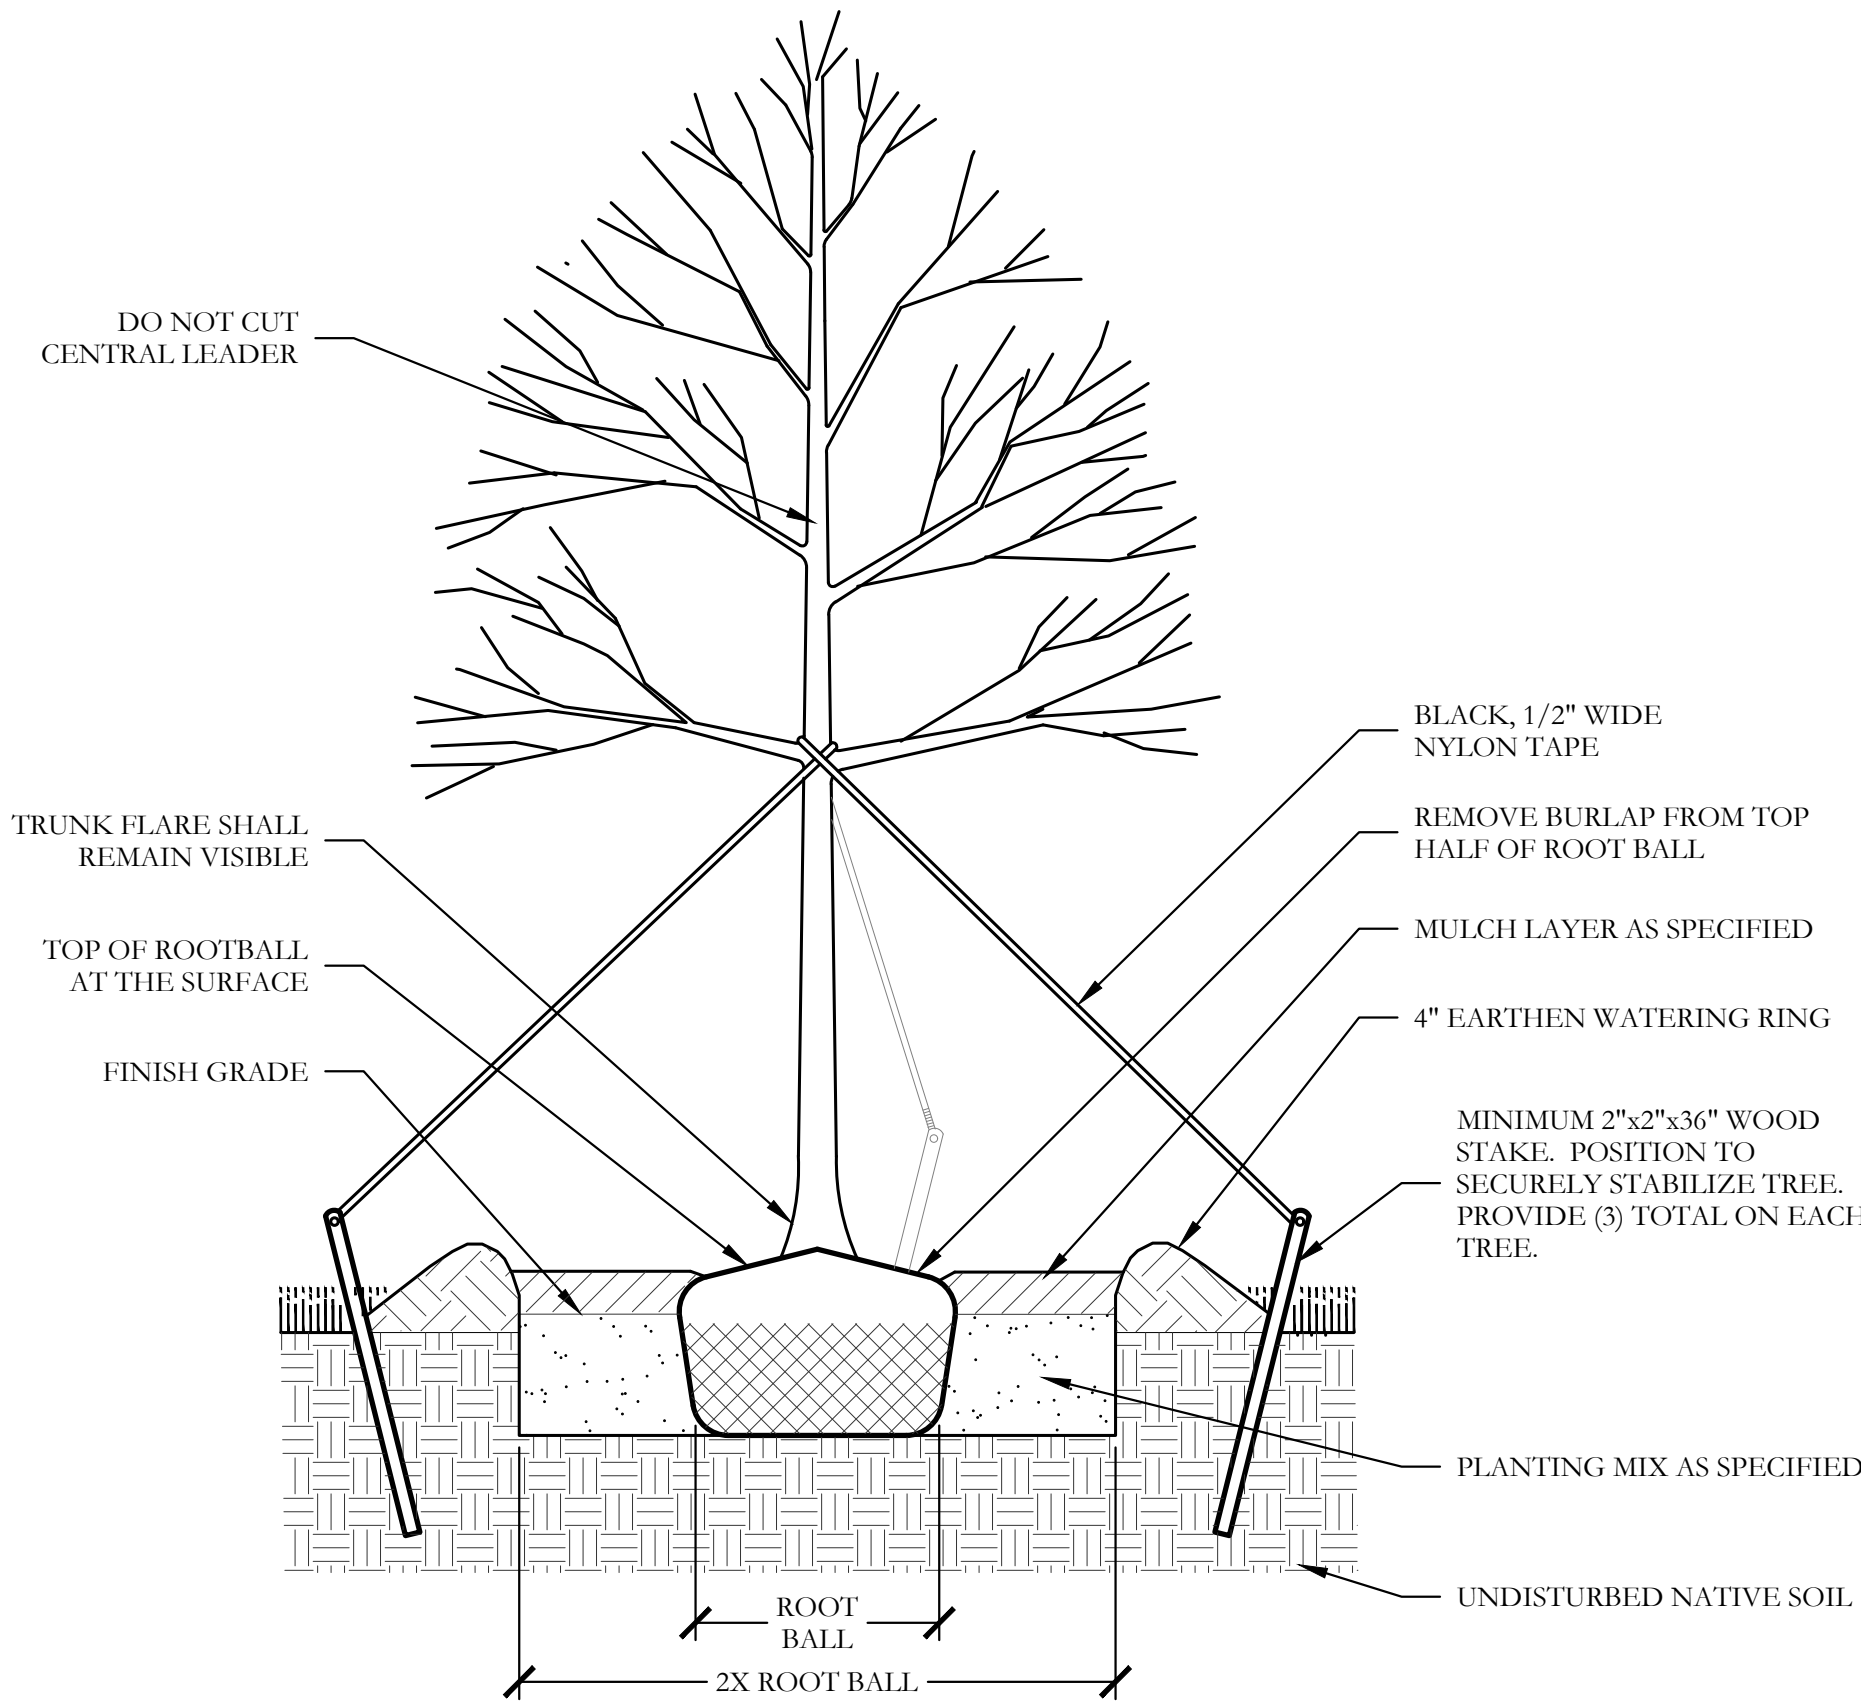

GENERAL LANDSCAPE NOTES

INSPECTIONS:

- NO EXCAVATION SHALL OCCUR IN CITY R.O.W. WITHOUT A R.O.W. PERMIT--CONTACT THE PUBLIC WORKS DEPARTMENT.
- THE CONTRACTOR SHALL MARK ALL WATER LINES, SEWER LINES, AND TREE LOCATIONS PRIOR TO CALLING FOR ROW INSPECTION AND PERMIT.
- THE LANDSCAPE INSTALLATION SHALL COMPLY WITH APPROVED LANDSCAPE DRAWINGS PRIOR TO FINAL ACCEPTANCE BY THE CITY AND ISSUANCE OF A CERTIFICATE OF OCCUPANCY.
- WATER METERS, CLEANOUTS AND OTHER APPURTENANCES, SHALL BE ACCESSIBLE, ADJUSTED TO GRADE, CLEARLY MARKED WITH FLAGGING AND COMPLIANT WITH PUBLIC WORKS DEPARTMENT STANDARDS PRIOR TO CALLING FOR FINAL LANDSCAPE AND ROW INSPECTIONS.

LANDSCAPE STANDARDS:

- PLANTINGS AND LANDSCAPE ELEMENTS SHALL COMPLY WITH THE CITY'S ENGINEERING DESIGN STANDARDS, PUBLIC R.O.W. VISIBILITY REQUIREMENTS.
- UNLESS OTHERWISE SPECIFIED, TREES SHALL BE PLANTED NO LESS THAN 4' FROM CURBS, SIDEWALKS, UTILITY LINES, SCREENING WALLS AND OTHER STRUCTURES. THE CITY HAS FINAL APPROVAL FOR ALL TREE PLACEMENTS.
- A MINIMUM THREE FEET (3') RADIUS AROUND A FIRE HYDRANT MUST REMAIN CLEAR OF LANDSCAPE PURSUANT TO THE FIRE CODE.
- STREET TREES, WHERE REQUIRED, SHALL BE (10') MINIMUM FROM THE EDGE OF A STORM SEWER CURB INLET BOX AND THE EDGE OF THE ROOT BALL SHALL BE (4') MINIMUM FROM THE WATER METER.
- THE AMERICAN STANDARD FOR NURSERY STOCK (ANSI Z60.1-2004) SPECIFICATIONS SHALL GOVERN PLANT QUALIFICATIONS, GRADES, AND STANDARDS.
- TREE PLANTING SHALL COMPLY WITH DETAILS HEREIN AND THE INTERNATIONAL SOCIETY OF ARBORICULTURE (ISA) STANDARDS.
- A 2-3" LAYER OF MULCH SHALL BE PROVIDED AROUND THE BASE OF THE PLANTED TREE. THE MULCH SHALL BE PULLED BACK 4" FROM THE TRUNK OF THE TREE.
- TREE PITS SHALL BE TESTED FOR WATER PERCOLATION. IF WATER DOES NOT DRAIN OUT OF TREE PIT WITHIN 24-HOURS, THE TREE SHALL BE MOVED OR DRAINAGE SHALL BE PROVIDED.
- ALL BEDS TO HAVE 3" OF COMPOSTED SOIL, LIVING EARTH TECHNOLOGY, OR APPROVED EQUAL TILLED AND TURNED TO A DEPTH OF 8" MINIMUM.
- ALL PLANT BEDS SHALL BE TOP-DRESSED WITH A MINIMUM OF 3 INCHES OF HARDWOOD MULCH.
- NATIVE SITE TOPSOIL IS TO BE PROTECTED FROM EROSION OR STOCKPILED. NATIVE SITE TOPSOIL SHALL BE LABORATORY TESTED BY AND ACCREDITED LABORATORY AND AMENDED PER SAID LABORATORY'S RECOMMENDATIONS.

IRRIGATION STANDARDS:

- ANY CHANGES TO THESE APPROVED IRRIGATION DRAWINGS SHALL BE AUTHORIZED BY THE CITY. CONTACT DEVELOPMENT SERVICES FOR AN IRRIGATION PERMIT PRIOR TO INSTALLING THE IRRIGATION SYSTEM.
- IRRIGATION OVER-SPRAY ON STREETS AND WALKS IS PROHIBITED.
- MAINLINES, VALVES, OR CONTROL WIRES SHALL NOT BE LOCATED IN THE CITY'S ROW.
- ET IRRIGATION CONTROLLERS SHALL BE PROGRAMMED AND ADJUSTED TO NOT EXCEED THE LANDSCAPE WATER ALLOWANCE (LWA) PRIOR TO APPROVAL OF LANDSCAPE INSTALLATION.
- VALVES SHALL BE LOCATED A MINIMUM OF (3') AWAY FROM STORM SEWERS, AND SANITARY SEWER LINES AND 5 FEET FROM CITY FIRE HYDRANTS AND WATER VALVES.
- THE BORE DEPTH UNDER STREETS, DRIVE AISLES, AND FIRE LANES SHALL PROVIDE (2') OF CLEARANCE (MINIMUM).
- IRRIGATION HEADS THAT RUN PARALLEL AND NEAR PUBLIC WATER AND SANITARY SEWER LINES; SHALL BE FED FROM STUBBED LATERALS OR BULL-HEADS. A MINIMUM FIVE FOOT (5') SEPARATION IS REQUIRED BETWEEN IRRIGATION MAIN LINES AND LATERALS THAT RUN PARALLEL TO PUBLIC WATER AND SANITARY SEWER LINES.
- NO VALVES, BACKFLOW PREVENTION ASSEMBLIES, QUICK COUPLERS ETC. SHALL BE LOCATED CLOSER THAN 10' FROM THE CURB AT STREET OR DRIVE INTERSECTION.


MAINTENANCE STANDARDS:


- THE OWNER SHALL BE RESPONSIBLE FOR THE ESTABLISHMENT, MAINTENANCE, AND VIGOR OF PLANT MATERIAL IN ACCORDANCE WITH THE DESIGN INTENT AND AS APPROPRIATE FOR THE SEASON OF THE YEAR.
- LANDSCAPE AND OPEN AREAS SHALL BE FREE OF TRASH, LITTER AND WEEDS.
- NO PLANT MATERIAL SHALL BE ALLOWED TO ENCROACH ON R.O.W., SIDEWALKS OR EASEMENTS TO THE EXTENT THAT VISION OR ROUTE OF TRAVEL FOR VEHICULAR, PEDESTRIAN, OR BICYCLE TRAFFIC IS IMPEDED.
- TREE MAINTENANCE SHALL BE IN ACCORDANCE WITH THE STANDARDS OF THE INTERNATIONAL SOCIETY OF ARBORICULTURE.
- TREE STAKING MATERIALS, IF USED, SHALL BE REMOVED AFTER (1) GROWING SEASON, NO MORE THAN (1) YEAR AFTER INSTALLATION (STEEL TREE STAKES, WIRES, AND HOSES ARE PROHIBITED).

TREE PROTECTION NOTES:


- CONTACT DEVELOPMENT SERVICES FOR A TREE REMOVAL PERMIT PRIOR TO REMOVAL OR TRANSPLANTING OF ANY TREES.
- ALL TREES WHICH ARE TO REMAIN ON SITE SHALL BE PROTECTED WITH A (4') TALL, BRIGHTLY COLORED PLASTIC FENCE, OR SILT FENCE, PLACED AT THE DRIP LINE OF THE TREES.
- PRIOR TO THE PRE-CONSTRUCTION MEETING OR OBTAINING A GRADING PERMIT, ALL TREE MARKINGS AND PROTECTIVE FENCING SHALL BE INSTALLED BY THE OWNER AND BE INSPECTED BY DEVELOPMENT SERVICES.
- NO EQUIPMENT SHALL BE CLEANED, OR HARMFUL LIQUIDS DEPOSITED WITHIN THE LIMITS OF THE ROOT ZONE OF TREES WHICH REMAIN ON SITE.
- NO SIGNS, WIRES, OR OTHER ATTACHMENTS SHALL BE ATTACHED TO ANY TREE TO REMAIN ON SITE.
- VEHICULAR AND CONSTRUCTION EQUIPMENT SHALL NOT PARK OR DRIVE WITHIN THE LIMITS OF THE DRIP LINE.
- GRADE CHANGES IN EXCESS OF 3 INCHES (CUT OR FILL) SHALL NOT BE ALLOWED WITHIN A ROOT ZONE, UNLESS ADEQUATE TREE PRESERVATION METHODS ARE APPROVED BY THE CITY.
- NO TRENCHING SHALL BE ALLOWED WITHIN THE DRIP-LINE OF A TREE, UNLESS APPROVED BY THE CITY.
- ALL REMOVED TREES SHALL BE CHIPPED AND USED FOR MULCH ON SITE OR HAULED OFF-SITE.
- ALL TREE MAINTENANCE TECHNIQUES SHALL BE IN CONFORMANCE WITH INDUSTRY IDENTIFIED STANDARDS. IMPROPER OR MALICIOUS PRUNING TECHNIQUES ARE STRICTLY PROHIBITED.

F:\civil 3d projects\2209 - marina villages - townhomes - rockwall\landscape\2209 - tree survey plan.dwg

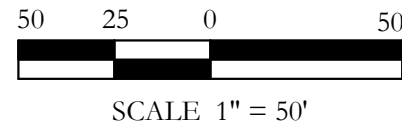

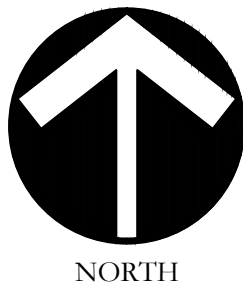

SCALE:
1" = 50'
One Inch
JVC No 2209

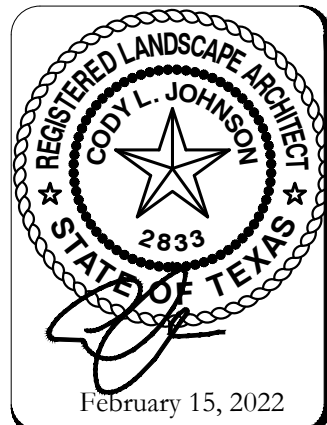

TREE SURVEY PLAN
TREE SURVEY PLAN

MARINA VILLAGE TOWNHOMES
CITY OF ROCKWALL
ROCKWALL COUNTY, TEXAS

F:\civil\3\projects\2209 - marina villages - townhomes - rockwall\landscpe\2209 - tree survey plan.dwg



LEGEND

7

EXISTING TREE TO BE REMOVED

23

EXISTING TREE TO REMAIN

TREE PROTECTION FENCE, TYP.

- TREE PROTECTION NOTES
1.


EXISTING TREES SHOWN TO REMAIN ARE TO BE PROTECTED DURING CONSTRUCTION. ORANGE COATED CHAINLINK FENCING (MIN. 4'-0" HEIGHT) SHALL BE INSTALLED AT THE DRIP LINE OF ALL TREES OR TREE GROUPS TO REMAIN. PARKING OF VEHICLES OR PERFORMING WORK WITHIN THESE AREAS OTHER THAN SHOWN ON THE PLAN, WILL NOT BE ALLOWED. THE TREE PROTECTION SHALL REMAIN DURING CONSTRUCTION. OTHER TREE PROTECTION MEASURES SHALL BE IN ACCORDANCE WITH THE CITY'S STANDARDS AND ORDINANCES.
2.

DISPOSAL OF ANY WASTE MATERIAL SUCH AS, BUT NOT LIMITED TO, PAINT, ASPHALT, OIL SOLVENTS, CONCRETE, MORTAR, ETC. WITHIN THE CANOPY AREA OF THE EXISTING TREES SHALL NOT BE ALLOWED.
3.

NO ATTACHMENTS OR WIRES OF ANY KIND, OTHER THAN THOSE OF A PROTECTIVE NATURE, SHALL BE ATTACHED TO ANY TREE.
4.


NO FILL OR EXCAVATION OF ANY NATURE SHALL OCCUR WITHIN THE DRIP LINE OF A TREE TO BE PRESERVED, UNLESS THERE IS A SPECIFIED WELL OR RETAINING WALL SHOWN ON THE GRADING PLAN.
5.

NO MATERIALS SHALL BE STORED WITHIN THE DRIPLINE AREA OF A TREE TO BE PRESERVED

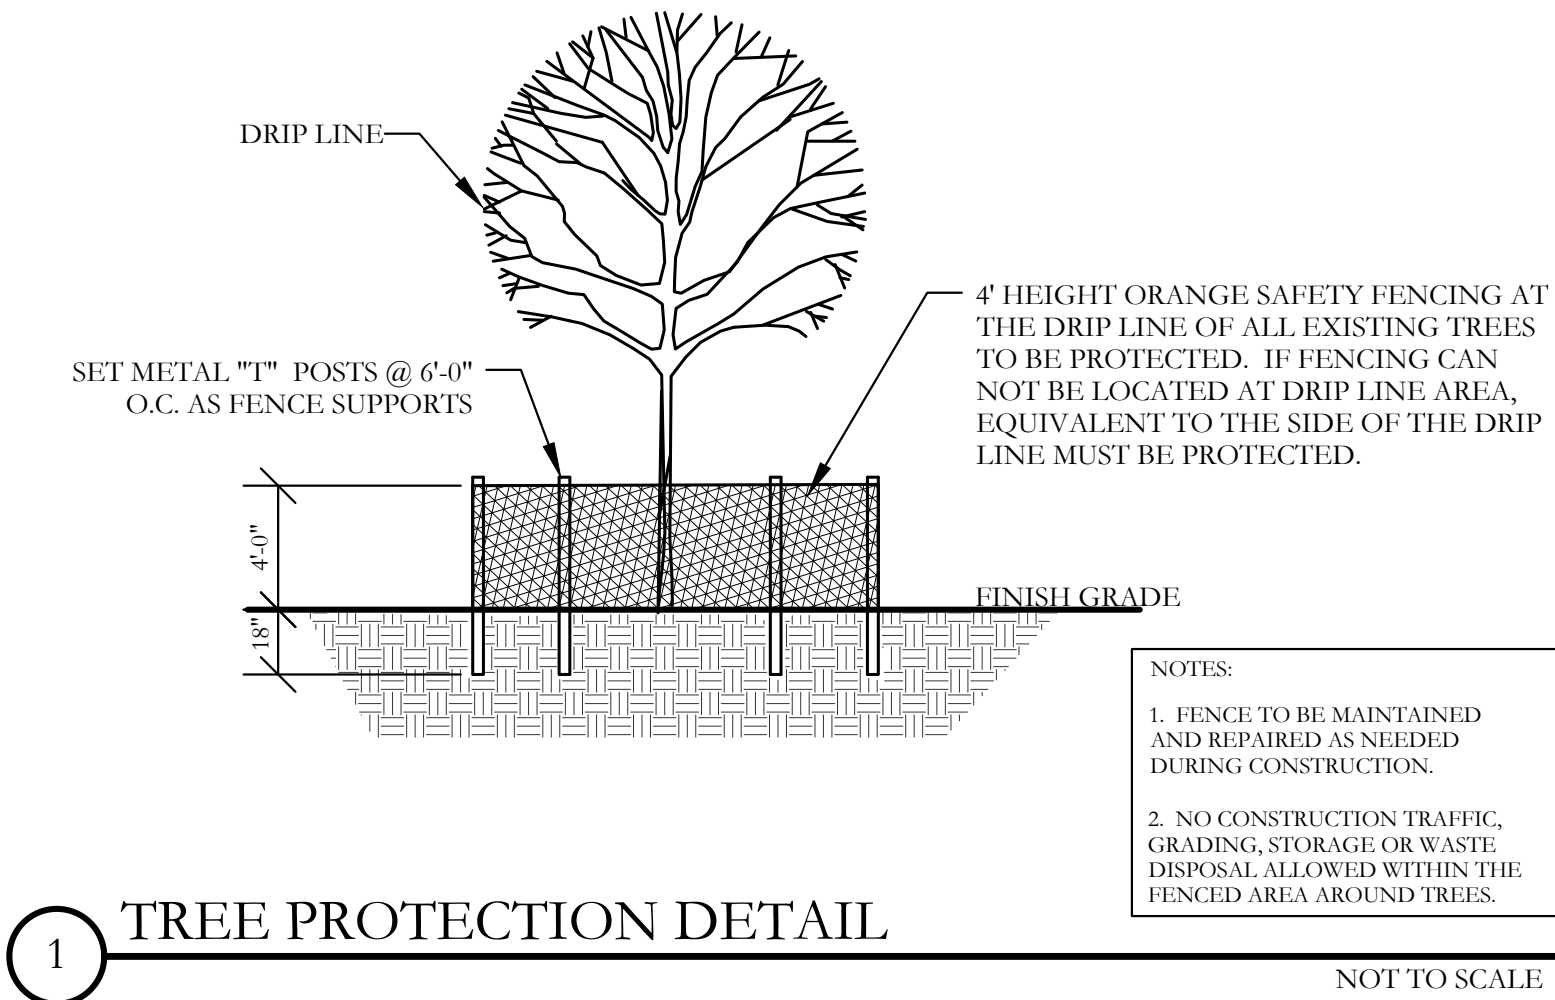

F:\civil 3d projects\2209 - marina villages - townhomes - rockwall\landscape\2209 - tree survey plan.dwg

Tree ID Number	Diameter at Breast Height (DBH) (inches)	Common Name	Scientific Name	Protected Tree?	Condition	Comment	Location	Remove or Remain	Mitigation Required, Percentage	Mitigation Required in Caliper Inches
0	28.0	Mesquite	Prosopis spp.	Yes	Healthy	Multi-trunk		Remove	100%	28.0
1	40.0	Bois d'Arc	Machua pomifera	No	Damaged	Leaning/Fall Hazard		Remove	0%	0.0
2	20.0	Bois d'Arc	Machua pomifera	No	Healthy			Remove	0%	0.0
3	8.0	Hackberry	Celtis occidentalis	No	Healthy			Remove	0%	0.0
4	12.0	Crape Myrtle	Lagerostroemia indica	Yes	Healthy			Remove	100%	12.0
5	8.0	Hackberry	Celtis occidentalis	No	Healthy	Multi-trunk		Remove	0%	0.0
6	14.0	Hackberry	Celtis occidentalis	Yes	Healthy			Remove	50%	7.0
7	14.0	Cedar Elm	Ulmus crassifolia	Yes	Healthy			Remove	100%	14.0
8	9.0	Eastern Red Cedar	Juniperus viginiana	No	Healthy			Remain		0.0
9	12.0	Hackberry	Celtis occidentalis	Yes	Healthy			Remain		0.0
10	19.0	Hackberry	Celtis occidentalis	Yes	Healthy			Remain		0.0
11	44.0	Hackberry	Celtis occidentalis	Yes	Healthy			Remain		0.0
12	21.0	Hackberry	Celtis occidentalis	Yes	Healthy			Remain		0.0
13	11.0	Hackberry	Celtis occidentalis	No	Healthy			Remain		0.0
14	24.0	Hackberry	Celtis occidentalis	Yes	Healthy	Multi-trunk		Remain		0.0
15	34.0	Eastern Red Cedar	Juniperus viginiana	Yes	Healthy	Multi-trunk		Remain		0.0
16	35.0	Eastern Red Cedar	Juniperus viginiana	Yes	Healthy	Multi-trunk		Remain		0.0
17	12.0	Eastern Red Cedar	Juniperus viginiana	Yes	Healthy			Remain		0.0
18	9.0	Eastern Red Cedar	Juniperus viginiana	No	Healthy			Remain		0.0
19	29.0	Bois d'Arc	Machua pomifera	No	Healthy	Multi-trunk		Remain		0.0
20	10.0	Eastern Red Cedar	Juniperus viginiana	No	Healthy			Remain		0.0
21	12.0	Green Ash	Fraxinus pennsylvanica	Yes	Healthy			Remain		0.0
22	10.0	Eastern Red Cedar	Juniperus viginiana	No	Healthy			Remain		0.0
23	9.0	Eastern Red Cedar	Juniperus viginiana	No	Healthy			Remain		0.0
24	15.0	Hackberry	Celtis occidentalis	Yes	Healthy			Remain		0.0
25	8.0	Eastern Red Cedar	Juniperus viginiana	No	Healthy			Remain		0.0
26	7.0	Hackberry	Celtis occidentalis	No	Healthy			Remain		0.0
27	29.0	Eastern Red Cedar	Juniperus viginiana	Yes	Healthy	Multi-trunk		Remain		0.0
28	12.0	Hackberry	Celtis occidentalis	Yes	Healthy			Remain		0.0
29	21.0	Green Ash	Fraxinus pennsylvanica	Yes	Healthy	Multi-trunk		Remain		0.0
30	7.0	Green Ash	Fraxinus pennsylvanica	Yes	Healthy	Multi-trunk		Remain		0.0
31	20.0	Hackberry	Celtis occidentalis	Yes	Healthy			Remove	50%	10.0
32	24.0	Eastern Red Cedar	Juniperus viginiana	Yes	Healthy	Multi-trunk		Remove	50%	12.0
33	23.0	Hackberry	Celtis occidentalis	Yes	Healthy	Multi-trunk		Remove	50%	11.5
34	9.0	Hackberry	Celtis occidentalis	No	Healthy			Remove	0%	0.0
35	20.0	Hackberry	Celtis occidentalis	Yes	Healthy	Multi-trunk		Remove	50%	10.0
36	24.0	Green Ash	Fraxinus pennsylvanica	Yes	Healthy	Multi-trunk		Remove	100%	24.0
37	12.0	Hackberry	Celtis occidentalis	Yes	Healthy			Remove	50%	6.0
38	21.0	Hackberry	Celtis occidentalis	Yes	Healthy	Multi-trunk		Remove	50%	10.5
39	19.0	Hackberry	Celtis occidentalis	Yes	Healthy			Remove	50%	9.5
40	21.0	Hackberry	Celtis occidentalis	Yes	Healthy			Remove	50%	10.5
41	24.0	Hackberry	Celtis occidentalis	Yes	Healthy	Multi-trunk		Remove	50%	12.0
42	17.0	Hackberry	Celtis occidentalis	Yes	Healthy			Remove	50%	8.5
43	12.0	Hackberry	Celtis occidentalis	Yes	Healthy			Remove	50%	6.0
										191.5
	Total Tree Population									Total Tree Replacement, caliper inches

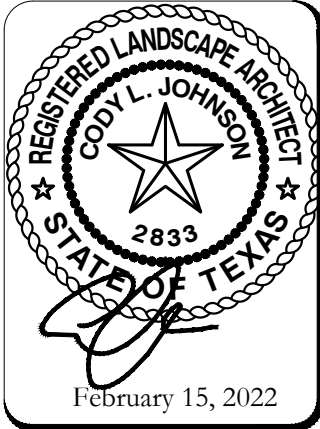

SCALE:

One Inch

JVC No 2209

Mapcheck 1: MARINA VILLAGE

Closure Summary

Precision, 1 part in: 1438904.41'
Error distance: 0.00'
Error direction: S23°37'10.02"W
Area: 300075.68 Sq. Ft.
Square area: 300075.68
Perimeter: 2677.88'

Point of Beginning

Easting: 2588822.58'
Northing: 7007539.35'

Side 1: Line

Direction: S04°01'18"E
Angle: [-004.02 (d)]
Deflection angle: [175.98 (d)]
Distance: 39.64'
Easting: 2588825.36'
Northing: 7007499.81'

Side 2: Line

Direction: S49°01'18"E
Angle: [135.00 (d)]
Deflection angle: [-045.00 (d)]
Distance: 160.16'
Easting: 2588946.28'
Northing: 7007394.78'

Side 3: Line

Direction: S36°41'52"W
Angle: [-094.28 (d)]
Deflection angle: [085.72 (d)]
Distance: 180.50'
Easting: 2588838.41'
Northing: 7007250.06'

Side 4: Line

Direction: S04°01'18"E
Angle: [139.28 (d)]
Deflection angle: [-040.72 (d)]
Distance: 142.73'
Easting: 2588848.42'
Northing: 7007107.68'

Side 5: Line

Direction: S47°49'42"W
Angle: [-128.15 (d)]
Deflection angle: [051.85 (d)]

Distance: 95.59'
Easting: 2588777.58'
Northing: 7007043.50'

Side 6: Line

Direction: S40°58'42"W
Angle: [173.15 (d)]
Deflection angle: [-006.85 (d)]
Distance: 56.00'
Easting: 2588740.85'
Northing: 7007001.23'

Side 7: Line

Direction: S49°01'18"E
Angle: [090.00 (d)]
Deflection angle: [-090.00 (d)]
Distance: 203.00'
Easting: 2588894.11'
Northing: 7006868.10'

Side 8: Line

Direction: S40°58'42"W
Angle: [-090.00 (d)]
Deflection angle: [090.00 (d)]
Distance: 480.10'
Easting: 2588579.27'
Northing: 7006505.65'

Side 9: Line

Direction: N15°09'39"W
Angle: [-056.14 (d)]
Deflection angle: [123.86 (d)]
Distance: 407.29'
Easting: 2588472.76'
Northing: 7006898.76'

Side 10: Line

Direction: N02°08'12"W
Angle: [-166.98 (d)]
Deflection angle: [013.02 (d)]
Distance: 70.75'
Easting: 2588470.12'
Northing: 7006969.46'

Side 11: Line

Direction: N21°26'12"W
Angle: [160.70 (d)]
Deflection angle: [-019.30 (d)]
Distance: 156.54'

Easting: 2588412.91'
Northing: 7007115.18'

Side 12: Line

Direction: N32°04'21"W
Angle: [169.36 (d)]
Deflection angle: [-010.64 (d)]
Distance: 109.80'
Easting: 2588354.60'
Northing: 7007208.22'

Side 13: Line

Direction: N57°55'37"E
Angle: [-090.00 (d)]
Deflection angle: [090.00 (d)]
Distance: 90.00'
Easting: 2588430.87'
Northing: 7007256.01'

Side 14: Line

Direction: N44°54'57"E
Angle: [166.99 (d)]
Deflection angle: [-013.01 (d)]
Distance: 54.37'
Easting: 2588469.26'
Northing: 7007294.51'

Side 15: Curve

Curve direction: Clockwise
Radius: [471.20']
Arc length: 153.06'
Delta angle: 018.61 (d)
Tangent: [77.21']
Chord direction: N54°13'19"E
Chord angle: [-170.69 (d)]
Deflection angle: [009.31 (d)]
Chord distance: 152.39'
Easting: 2588592.89'
Northing: 7007383.60'

Side 16: Curve

Curve direction: Counter-clockwise
Radius: [1039.99']
Arc length: 278.35'
Delta angle: 015.34 (d)
Tangent: [140.01']
Chord direction: N55°51'37"E
Chord angle: [172.33 (d)]

Deflection angle: [-007.67 (d)]

Chord distance: 277.52'

Easting: 2588822.58'

Northing: 7007539.35'



DATE: November 30, 2022

TO: Michael Joyce
Michael Joyce Properties
767 Justin Road
Rockwall, TX 75087

CC: William Johnson
LTL Family Holdings
14918 Mystic Terrace Lane
Cypress, TX 77429

FROM: Bethany Ross
City of Rockwall Planning and Zoning Department
385 S. Goliad Street
Rockwall, TX 75087

SUBJECT: P2022-056; *Final Plat for Marina Village Subdivision*

Mr. Joyce:

This letter serves to notify you that the above referenced platting case that you submitted for consideration by the City of Rockwall was approved by the City Council on November 21, 2022. The following is a record of all recommendations, voting records and conditions of approval:

Staff Recommendations

- (1) All technical comments from the Engineering, Planning and Fire Departments shall be addressed prior to the filing of this plat;
- (2) The development of the subject property shall adhere to the recommendations made by Parks and Recreation Board; and,
- (3) Any construction resulting from the approval of this plat shall conform to the requirements set forth by the Unified Development Code (UDC), the International Building Code (IBC), the Rockwall Municipal Code of Ordinances, city adopted engineering and fire codes and with all other applicable regulatory requirements administered and/or enforced by the state and federal government.

Planning and Zoning Commission

On November 15, 2022, the Planning and Zoning Commission approved a motion to recommend approval of the Final Plat by a vote of 5-0, with Commissioners Conway and Llewellyn absent.

City Council

On November 21, 2022, the City Council approved a motion to approve the Final Plat with a vote of 7-0.

Prior to submitting the required materials for filing, please send or submit a physical or digital copy of the plat to allow staff to ensure that all outstanding comments have been addressed. Once staff has verified all comments have been addressed you will be required to submit -- at a minimum -- the following:

- (1) One (1) set(s) of mylar copies of the plat.
- (2) One (1) tax certificate for each property being platted that demonstrates that the current years taxes have been paid.
- (3) A check for the filing fees (confirm fees with staff) made out to the *Rockwall County Clerk's Office*.

Please note that the filing fee amount above is only an estimate and that filing fees are subject to change based on the requirements of the *Rockwall County Clerk's Office*. In addition, if you are submitting mylars between September 1st and December 31st, you will be required to submit the current year's tax receipt showing that all assessed taxes have been paid. If taxes have not been assessed on the property being platted, a statement/letter from the *Rockwall Central Appraisal District (RCAD)* and an additional \$4.00 filing fee will be required to be submitted to staff.

All plats must be submitted to the City with the required filing fees and tax certificates a minimum of 180-days from the approval date. Failure to miss this deadline, will result in the plat being expired in accordance with the requirements of Chapter 38, *Subdivisions*, of the Municipal Code of Ordinances. Should you have any questions or concerns regarding your plat or the platting process, please feel free to contact me a (972) 771-6434.

Sincerely,



Bethany Ross, *Planner*
City of Rockwall Planning and Zoning Department