


C1.02

Sheet Number

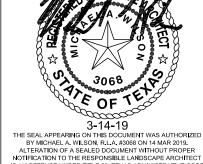

NOTIFICATION TO THE RESPONSIBLE LANDSCAPE ARCHITECT IS AN OFFENSE UNDER TITLE 22, TEXAS ADMINISTRATIVE CODE CHAPTER 3 LANDSCAPE ARCHITECTS. THE RECORD COPY OF TH DRAWING IS ON FILE AT THE OFFICES OF HALFF ASSOCIATES, IN 4000 FOSSIL CREEK BLVD, FORT WORTH, TX 76137-2720, TBPE FIRM #F-312 Project No.: 35866 03.14.19 Drawn By: MAW Checked By: KMW 1:20

Scale: Sheet Title

TREESCAPE PLAN

L1.01 Sheet Number

allowed around trees.

7. Where any of the above exceptions result in a fence being closer than 4 feet to a tree trunk, protect the trunk with strapped—on planking to a height of 8 ft. in addition to the reduced fencing provided.

8. Trees approved for removal shall be removed in a manner which does not impact trees to be preserved.

9. Any roots exposed by construction activity shall be pruned flush with the soil. Backfill root areas with good quality top soil as soon as possible. If exposed root areas are not backfilled within 2 days, cover them with organic material in a manner which reduces soil temperature and minimizes water loss due to evaporation.

10. Trenching required for the installation of irrigation shall be placed as far from existing tree trunks as possible.


11. No landscape topsoil dressing greater than 2 inches shall be permitted within the drip line of trees. No soil or mulch is permitted on the root flare of any tree.


12. Limbing & pruning to provide clearance for structures, traffic and equipment shall take place before damage occurs.


13. All finished pruning shall be done according to recognized, approved standards of the industry (Reference the National Arborist Association Pruning Standards for Shade Trees).

Case No. SP2019-007

TREE TO REMAIN, TYP. TREE TO BE REMOVED, TYP. CHAIN LINK FENCE TREES TO BE REMAIN 7" CEDAR PLAN VIEW PT. LOT 3, BLOCK A 34.4904 AC. LAKE POINTE BAPTIST CHURCH VOL. 1121, PG. 239 VOL. 1314, PG. 257 VOL. 1323, PG. 290 16" CHINESE PISTACHE 6"PINE — 18" CHINESE 3 18" CHINESE 537.89 TO 12" BRADFORD

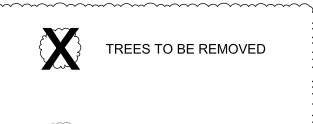

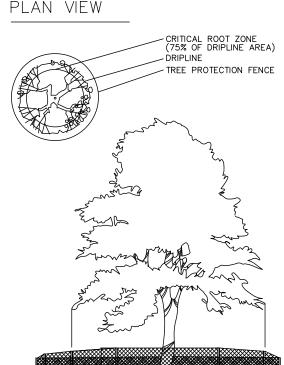

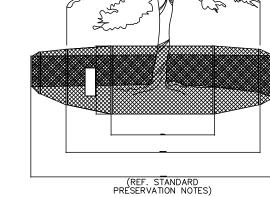

1 TREE PROTECTION DETAIL SCALE: N.T.S.

## MITIGATION REQUIREMENT:

353

MITIGATION PROVIDED: (7) 4" TREES IN PARKING LOT (2) 4" TREES IN SITE LANDSCAPING (2) 3" TREES IN SITE LANDSCAPING

TREE INVENTORY / MITIGATION

REMOVED

(PROTECTED)

**SPECIES** 

RED OAK RED OAK

RED OAK BALD CYPRESS

CEDAR ELM

LIVE OAK

RED OAK

RED OAK

RED OAK

PINE

PINE

PINE

LIVE OAK

LIVE OAK

LIVE OAK

CHINESE PISTACHE

CHINESE PISTACHE

CHINESE PISTACHE

BRADFORD PEAR

BRADFORD PEAR

10 LIVE OAK

10 LIVE OAK

LIVE OAK

CRAPE MYRTLE

CRAPE MYRTLE

CRAPE MYRTLE

12 BRADFORD PEAR

10 BRADFORD PEAR

LIVE OAK

CEDAR ELM CEDAR ELM

42

42 INCHES

BRADFORD PEAR

BALD CYPRESS

DBH (INCHES)

REMOVED

(OTHER)

RETAINED

3 4

5 6

7

8

9

10

11 12

13

14

15

16

17

18

19

20

22

23

24

TOTAL


42" TOTAL PROVIDED

## STANDARD PRESERVATION NOTES FOR TREE AND NATURAL AREA PROTECTION

- Special Note: Exceptions are permitted for areas outside the critical root zone. No disturbances are permitted within the critical root zone (75% of the dripline area). For the protection of natural areas, no exceptions to installing fences at the Limit of Construction line will be permitted, and no silting of stock piling of material or dirt is

NOTE: NO TREES WITHIN 5' OF EXISTING UTILITES

 $\langle \rangle$ 

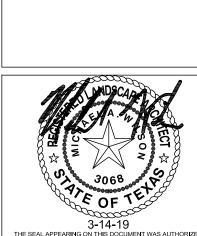

CHAPTER JLANDSCAPE ARCHITECTS. THE RECORD DRAWING IS ON FILE AT THE OFFICES OF HALFF ASS 4000 FOSSIL CREEK BLVD, FORT WORTH, TX 76 TBPE FIRM #F-312

Project No.: 35866

Issued: 03.14.19


Drawn By: MAW


Drawn By: MAW
Checked By: KMW
Scale: 1:20
Sheet Title


Case No. SP2019-007

LANDSCAPE PLAN

L2.01

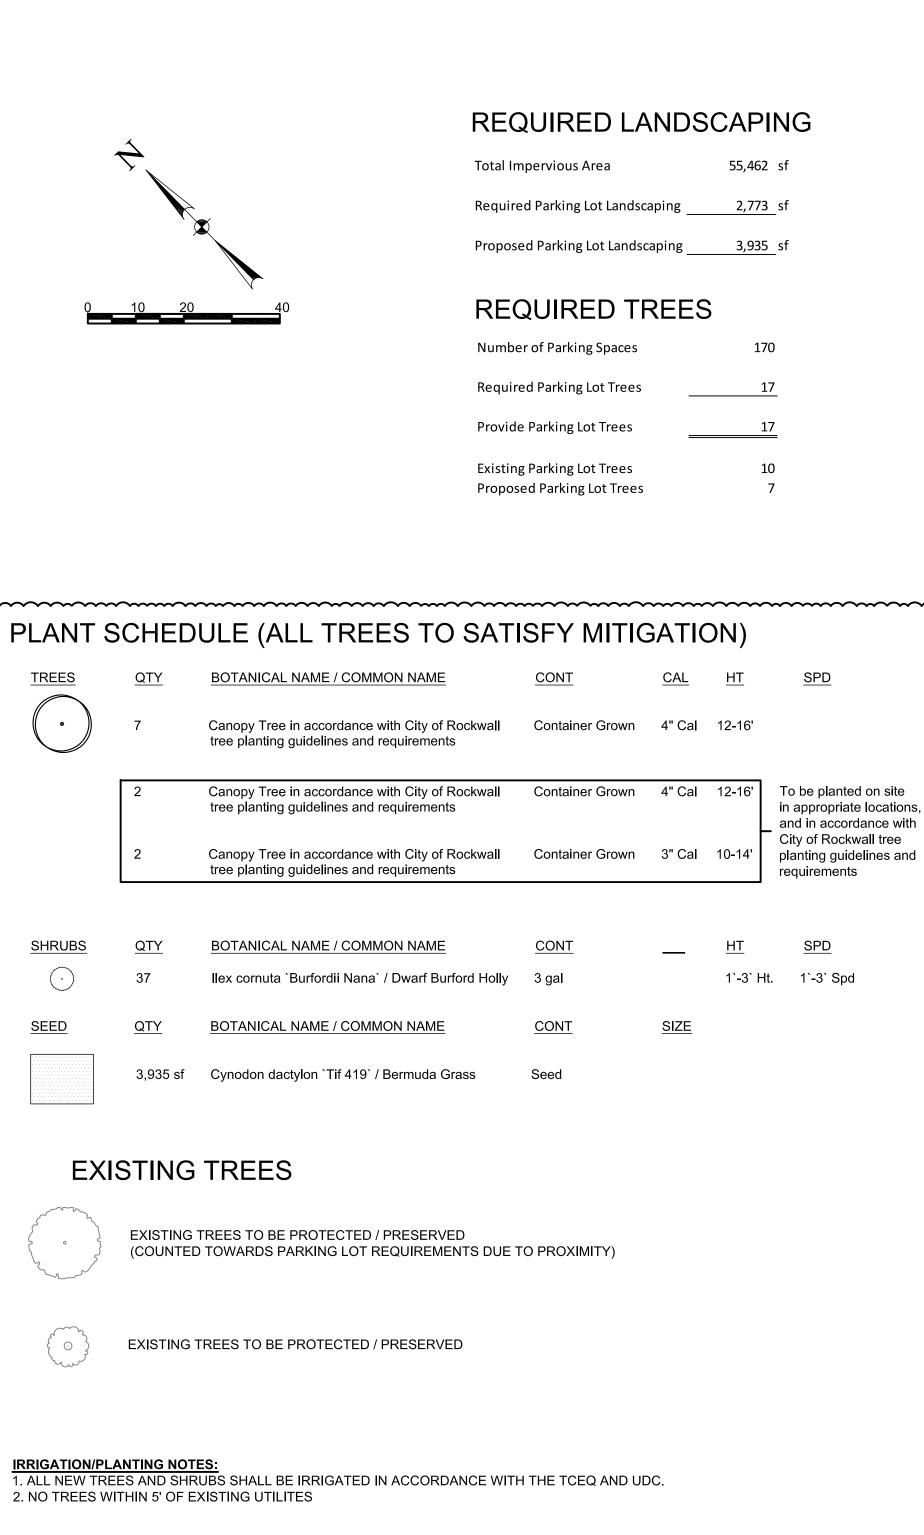

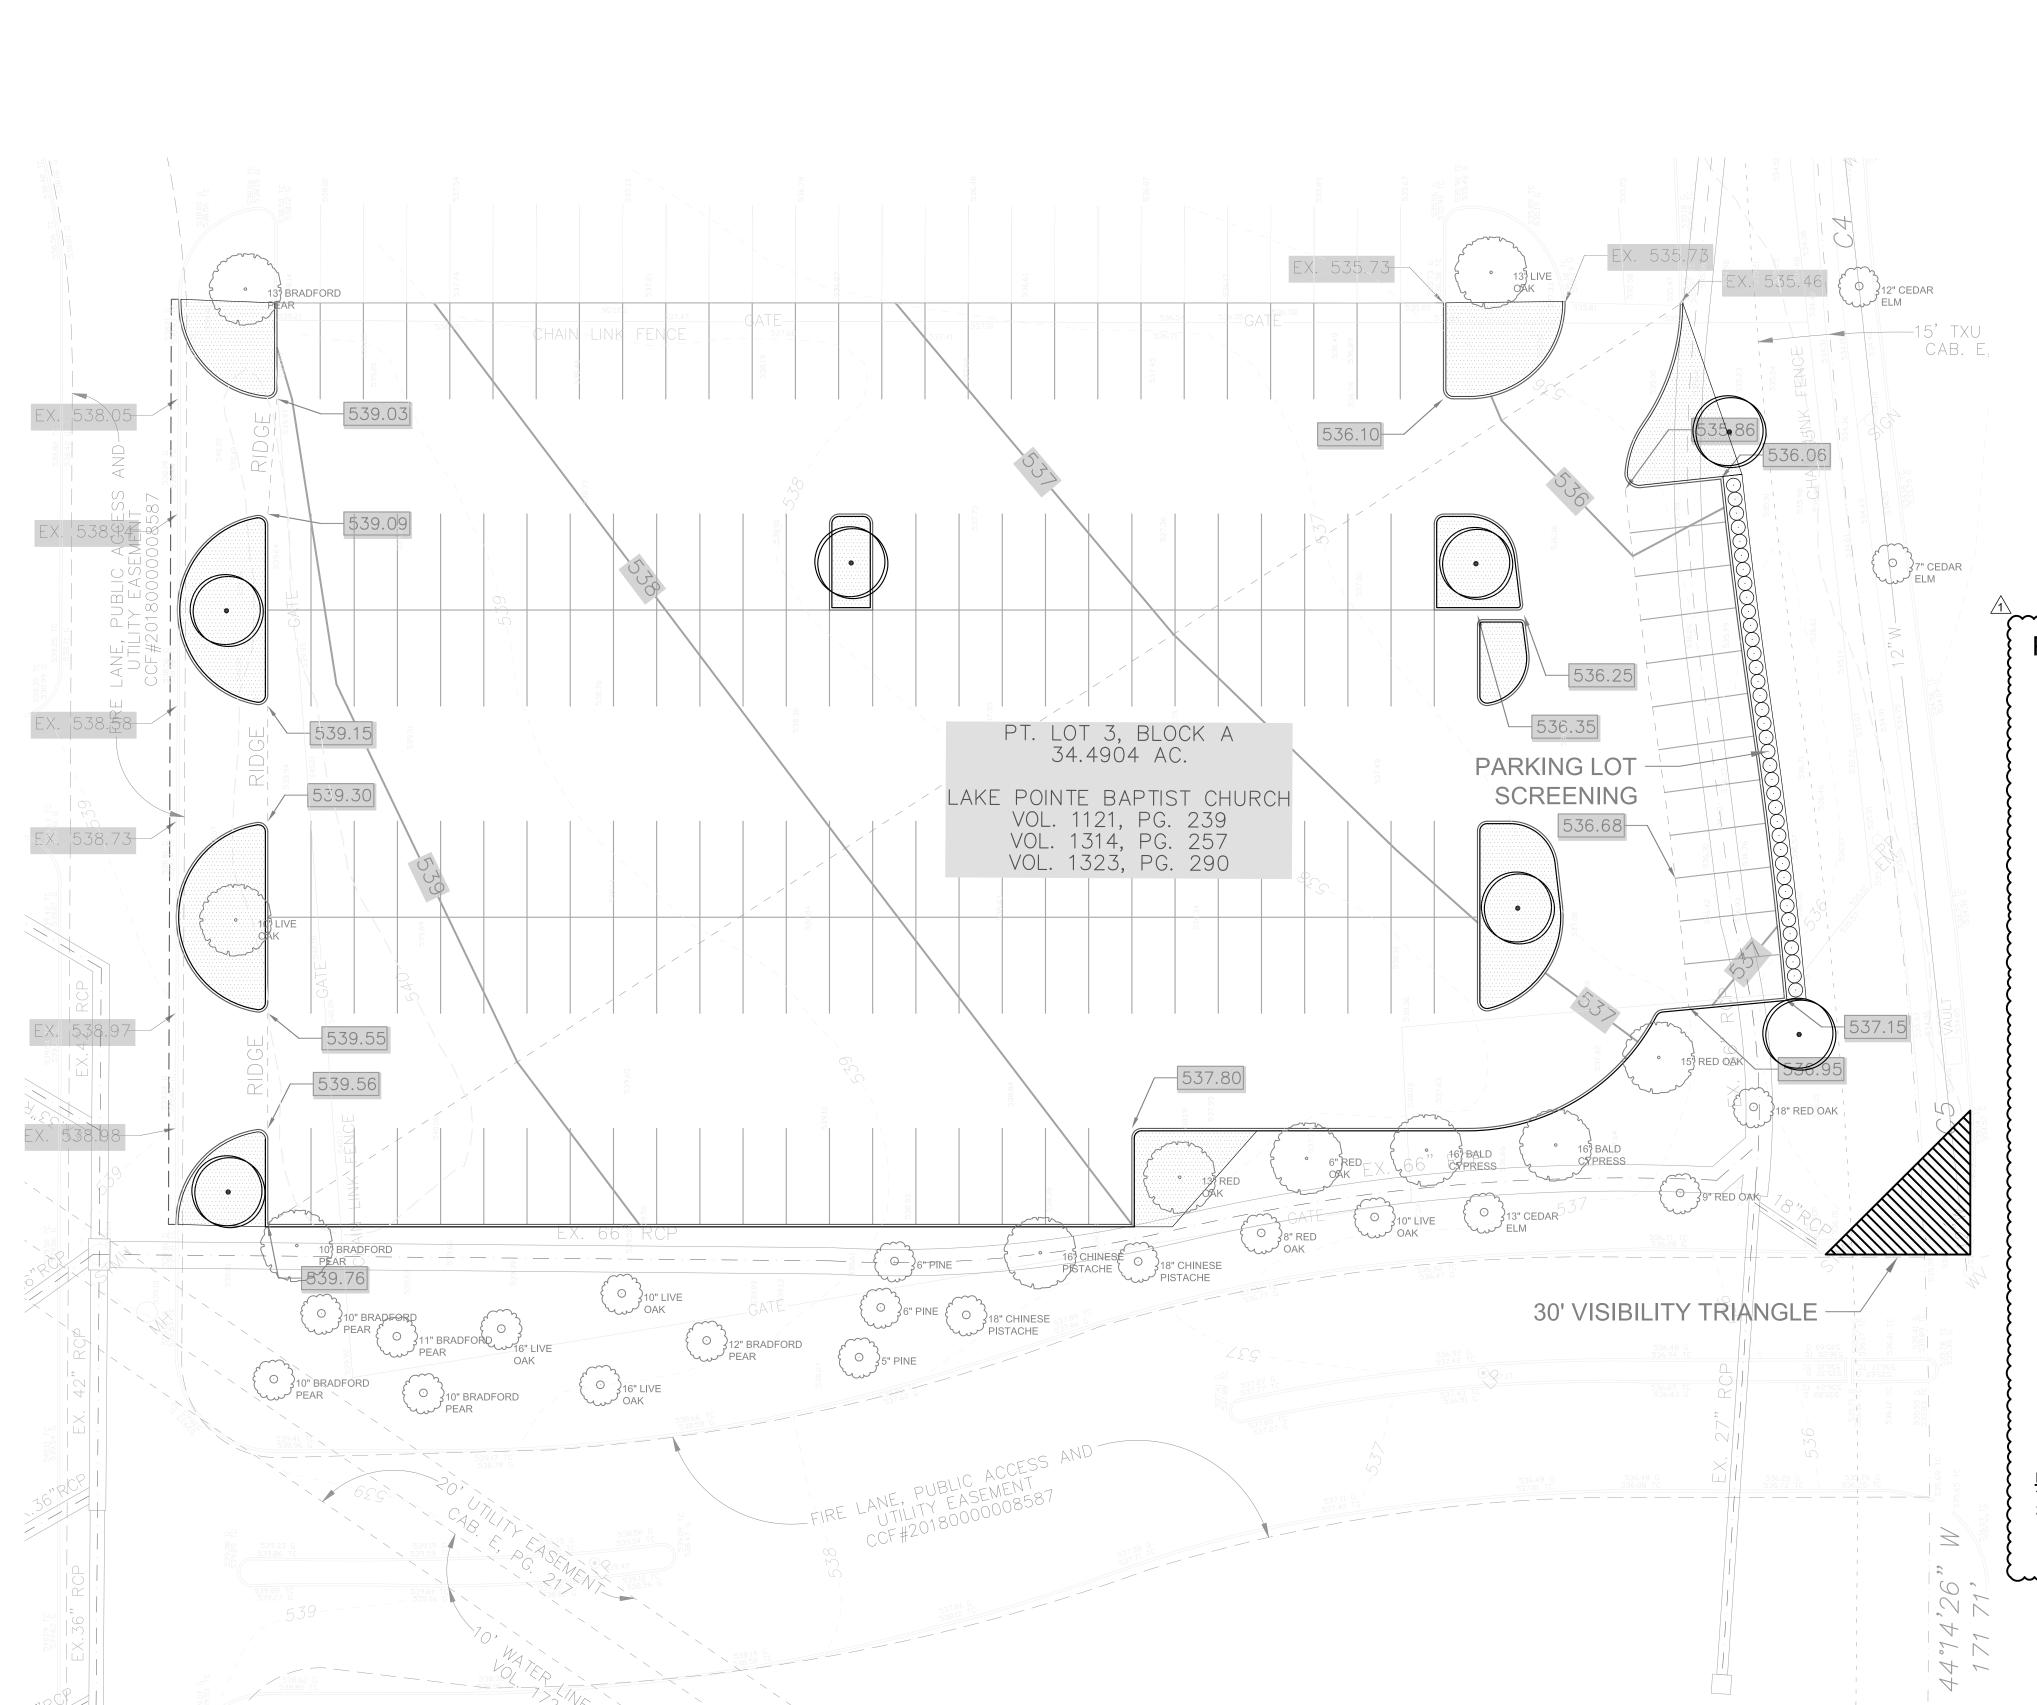

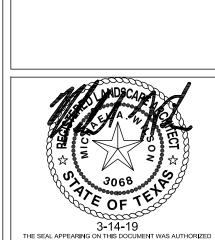

3-14-19
THE SEAL APPEARING ON THIS DOCUMENT WAS AUTHORIZED BY MICHAEL A. WILSON, R.L.A. #3088 ON 14 MAR 2019.
ALTERATION OF A SEALED DOCUMENT WITHOUT PROPER NOTIFICATION TO THE RESPONSIBLE LANDSCAPE ARCHITECT IS AN OFFENSE UNDER THILE 22, TEXAS ADMINISTRATIVE CODE. CHAPTER 3 LANDSCAPE ARCHITECTS. THE RECORD COPY OF THIS DRAWING IS ON FILE AT THE OFFICES OF HALFF ASSOCIATES, INC., 4000 FOSSIL CREEK BLVD. FORT WORTH, TX 76137-2720.

TEPE FIRM #F-312

Project No.: 35866

ISSUEd: 03.14.19

Drawn By: MAW


Checked By: KMW
Scale: AS NOTED
Sheet Title

LANDSCAPE DETAILS

L3.01
Sheet Number

— DO NOT HEAVILY PRUNE THE TREE AT PLANTING. PRUNE ONLY CROSSOVER LIMBS, CO-DOMINANT LEADERS, AND BROKEN AND DEAD BRANCHES. SOME INTERIOR TWIGS AND LATERAL BRANCHES MAY BE PRUNED; HOWEVER DO NOT REMOVE THE TERMINAL BUDS OF MARK THE NORTH SIDE OF -THE TREE IN THE NURSERY BRANCHES THAT EXTEND TO THE EDGE AND ROTATE TREE TO FACE OF THE CROWN. NORTH AT THE SITE — "ARBOR TIE" GUYING MATERIAL. ATTACH TO EARTH ANCHOR. TIGHTEN ARBOR TIE 3'-0" (TYP.) ENOUGH TO KEEP FROM SLIPPING. ALLOW FOR TRUNK MOVEMENT. REMOVE ALL TWINE, ROPE AND WIRE, — AND BURLAP FROM TOP OF ROOT BALL. IF TREE IS SHIPPED WITH A WIRE BASKET AROUND THE ROOT BALL, CUT THE BASKET IN FOUR PLACES AND FOLD DOWN INTO PLANTING HOLE TO EXPOSE 90% OF ROOT BALL THAT ROOT FLARE IS 3" ABOVE FINISHED PLACE ROOT BALL ON — UNEXCAVATED SOIL BACKFILL WITH PLANTING SOIL — 6' HARDWOOD STAKE OR APPROVED MIX AND LIGHTLY COMPACT EQUAL. 3 PER TREE, EQUALLY SPACED AROUND TREE. TO BE SET IN EXISTING TO PREVENT ROOT BALL FROM — UNDISTURBED SOIL. SHIFTING, BACKFILL WITH - 3" MULCH LAYER. MULCH TO COVER PLANTING SOIL MIX. PLACE SOIL ROOT BALL AND TAPER IN DEPTH SO IN 6" LIFTS AND COMPACT ROOT FLARE REMAINS EXPOSED. DO NOT FIRMLY WITH FOOT PRESSURE. COVER ROOT FLARE. LAYER AND COMPACT SOIL UP TO THE MIDDLE OF THE ROOT - 4" HIGH MULCH SAUCER FINISH GRADE LIMITS OF DIGGING WITH BACKHOE OR OTHER HEAVY EQUIPMENT HAND DIG UNDISTURBED SOIL X = ROOT BALL HEIGHT 1'-0" Y = ROOT BALL WIDTH SINGLE TREE TRUNK WITH STAKES

3/4" = 1'-0"

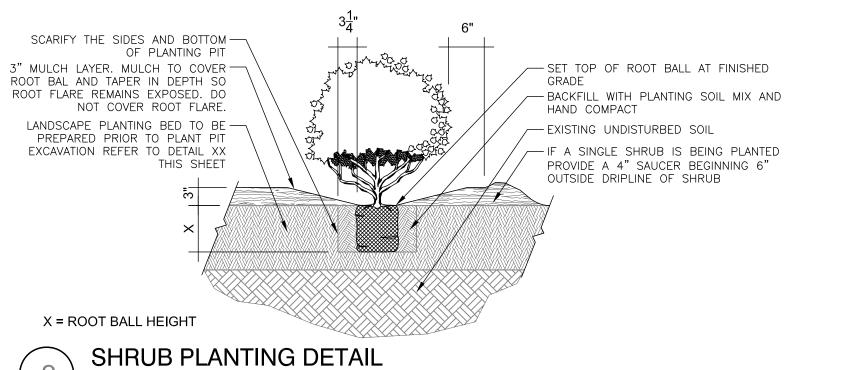

3/4" = 1'-0"

NOTE: NO TREES WITHIN 5' OF EXISTING UTILITES