

<u>LEGEND</u> DOUBLE CLEANOUT SANITARY MANHOLE JUNCTION BOX CURB INLET GRATE INLET FDC FIRE HYDRANT BARRIER FREE RAMP FIRE LANE


SITE DATA TABLE EXISTING ZONING PROPOSED USE COMMERCIAL SITE AREA 0.69 ACRES BUILDING AREA 2,705 SF EXISTING BUILDING ADDITION 1,246 SF PROPOSED BUILDING 3,951 SF PARKING REQUIRED 1/200 SF 15 STANDARD STALLS 1 ACCESSIBLE STALL PARKING PROVIDED 29 STANDARD STALLS 2 ACCESSIBLE STALLS

NOTE: PROPERTY IS CURRENTLY PLATTED

PAVING LEGEND



EXISTING ASPHALT TO BE MILLED PER TXDOT SPEC ITEM 358.4.4 AND OVERLAID PER TXDOT SPEC ITEM 340.

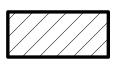

LOOP IN ACCESS TO ASSIST LAKE MEADOWS DRIVE AS FIRE APPARATUS TO ATTAIN 150' HOSE LAY DISTANCE (EXISTING CONCRETE)

- 1. ALL DIMENSIONS ARE TO FACE OF CURB UNLESS OTHERWISE SPECIFIED.
- 2. ALL CURB RADII ARE TO BE 3' UNLESS ALONG FIRELANE UNLESS OTHERWISE SPECIFIED.
- 3. REFER TO LANDSCAPE PLANS FOR HARDSCAPE IMPROVEMENTS AND IRRIGATION SLEEVES CROSSING PAVED AREAS.
- 4. REFER TO STRUCTURAL PLANS FOR ALL BUILDING, DETACHED GARAGE, AND DUMPSTER ENCLOSURE FOUNDATION DESIGNS AND DETAILS.
- 5. FIRELANE STRIPING SHOWN FOR ILLUSTRATIVE PURPOSES ONLY. REFER TO CITY DETAIL AND SPECIFICATIONS FOR EXACT LOCATION.

ROCKWALL ROTARY FOUNDATION 408 S. GOLIAD STREET

<u>DEVELOPER</u> DR. STAN LOWRANCE 408 S. GOLIAD STREET ROCKWALL, TEXAS 75087

ENGINEER MANHARD CONSULTING ROCKWALL ROTARY FOUNDATION 12225 GREENVILLE AVE STE 1000 DALLAS, TEXAS 75243 972.972.4250 PH JESSE CONRAD, P.E

SITE PLAN SIGNATURE BLOCK

I hereby certify that the above and foregoing site plan for a development in the City of Rockwall, Texas, was approved by the Planning & Zoning Commission of the City of Rockwall on the day of

WITNESS OUR HANDS, this day of

Director of Planning and Zoning

CASE NUMBER: 2021-013

SITE PLAN

408. S GOLIAD STREET - 0.69 ACRES

CITY OF ROCKWALL, ROCKWALL COUNTY, TEXAS

ROCCA VILLA

DESIGN: 05/03/2021 - REVISION #1 PER 1ST CITY COMMENTS 04/16/2021 DRAWN: 05/04/2021 - REVISION #2 PER 1ST CITY COMMENTS 07/26/2021 - REVISION #3 PER BUILDING FOOTPRINT UPDATE CHECKED: JC

ISSUED THIS DATE: 07/26/2021 PROJ. MGR.: JTP PROJ. ASSOC.: AAR

O O

ROCKWALL

ROCKWALL,

OF

CITY

OLIAD,

U

တ်

408

FOR INTERIM REVIEW ONLY

THIS DOCUMENT IS NOT ISSUED FOR CONSTRUCTION OR PERMITTING PURPOSES

JASON T. PYKA, P.E. TEXAS P.E. No. <u>124800</u>


KWALL


0

 $oldsymbol{C}$

SITE

DRAWN BY: ANV 07/26/2021 SHEET

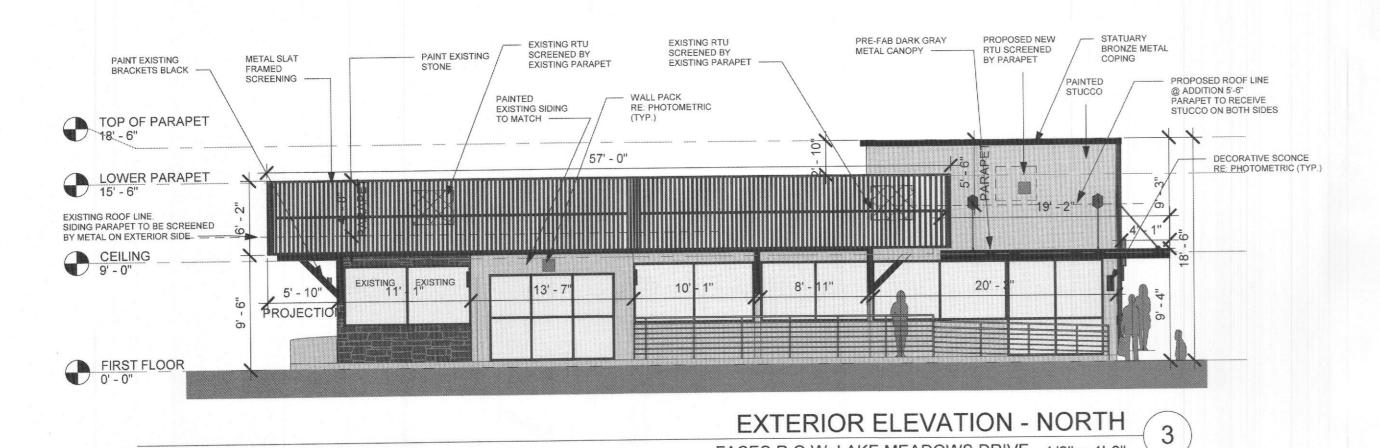


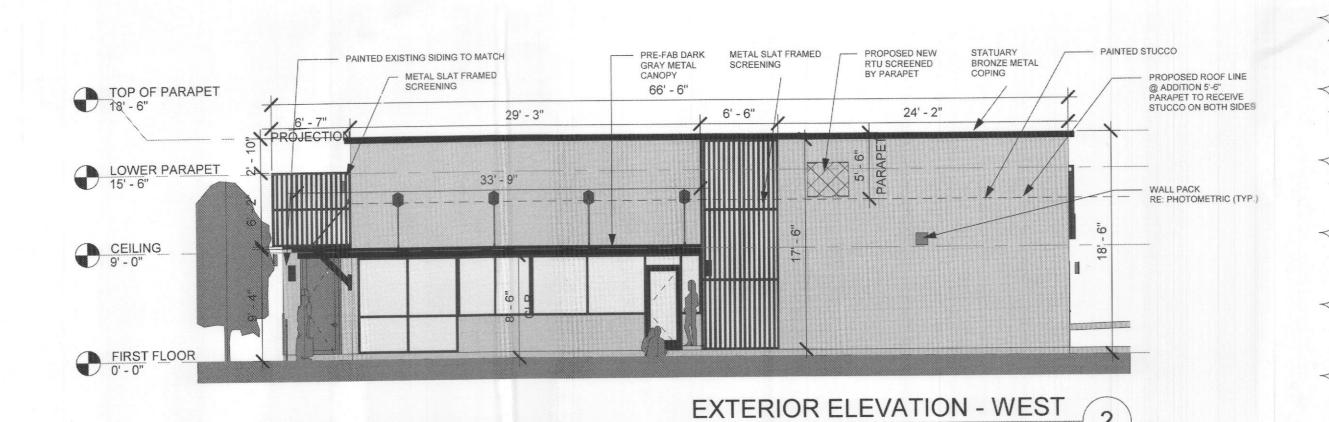

FACES R.O.W. LAKE MEADOWS DRIVE 1/8" = 1'-0"

1/8" = 1'-0"

FACES R.O.W. S GOLIAD ST. 1/8" = 1'-0"

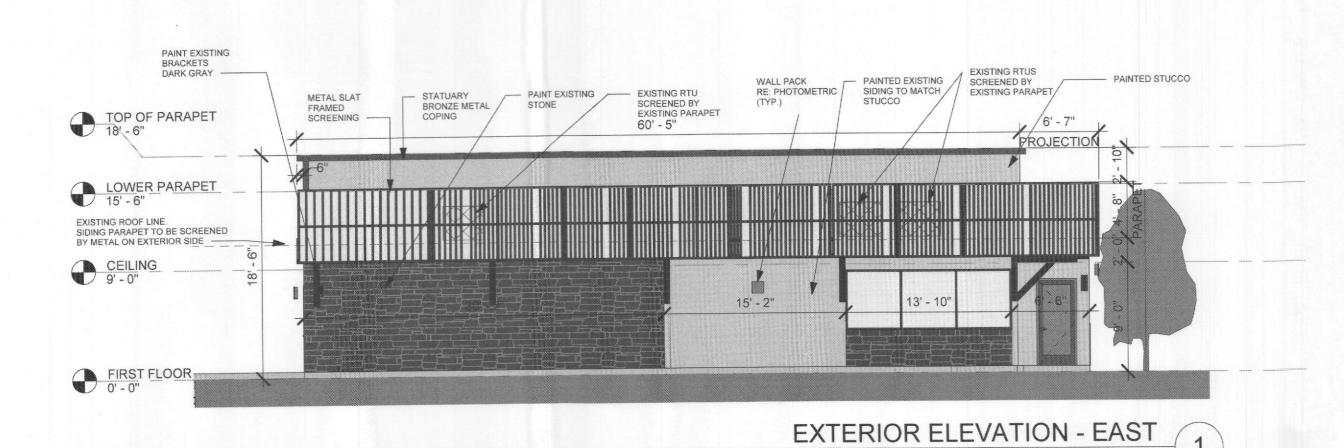

SOUTH ELEVATION-SECONDARY FACADE

NEW METAL COPING	22.53 SF	1.9%
NEW METAL CANOPY	3.56 SF	1.7%
NEW PAINTED STUCCO	373.5.SF	33%
EXISTING WOOD BRACKETS- PAINTED	5.47 SF	0.5%
NEW METAL SLAT SCREENING	22.75 SF	1.9%
EXISTING SIDING- PAINTED	670.73 SF	61%
TOTAL	1098.54 SF	100%

NORTH ELEVATION-PRIMARY FACADE

1 1 (11 (1) (1)	I I / (O/ (DE	
NEW METAL COPING	10.53 SF	1.1%
NEW METAL CANOPY	15.14 SF	1.6%
NEW PAINTED STUCCO	176.3 SF	20.9%
EXISTING WOOD BRACKETS- PAINTED	9.15 SF	1.2%
NEW METAL SLAT SCREENING	350.92 SF	41.9%
EXISTING SIDING- PAINTED	140.69 SF	16.9%
EXISTING STONE- PAINTED	44.62 SF	5.2%
EXISTING GLAZING	52.46 SF	6.1%
NEW GLAZING	42.76 SF	5.1%
TOTAL	842.57 SF	100%
		


	LEVATION- ARY FACADI	
NEW METAL COPING	30.46 SF	2.6%
NEW METAL CANOPY	26.72 SF	2.3%
NEW PAINTED STUCCO	718.77 SF	62%
EXISTING WOOD BRACKETS- PAINTED	5.47 SF	0.5%
NEW METAL SLAT SCREENING	155.87 SF	13.4%
EXISTING SIDING- PAINTED	24.39 SF	2.1%
NEW GLAZING	204.78 SF	17.1%
TOTAL	1,166.46 SF	100%


EAST ELEVATION-PRIMARY **FACADE NEW METAL** 2.6% 30.46 SF COPING **NEW PAINTED** 14.1% 170.46 SF STUCCO **EXISTING WOOD** 2% 22.81 SF BRACKETS-PAINTED NEW METAL SLAT 34% 410.48 SF SCREENING **EXISTING SIDING-**15.3% 185.24 SF PAINTED **EXISTING STONE-**317.38 SF 26.3% PAINTED EXISTING 69.17 SF 5.7% GLAZING 100% TOTAL 1206 SF

SITE PLAN SIGNATURE BLOCK


I hereby certify that the above and foregoing site plan for a development in the City of Rockwall, Texas, was approved by the Planning & Zoning Commission of the City of Rockwall on the U day of May, Zo2/. witness OUR HANDS, this 11 day of May 202 | Call Director of Planning and Zoning

MATERIAL	INDEX
Statuary Bronze	METAL COPING COLOR: STATUARY BRONZE FINISH: MATTE
	EXTRUDECK METAL CANOPY COLOR: DARK GREY FINISH: MATTE
	PAINTED STUCCO

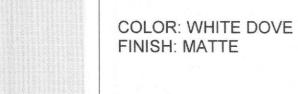


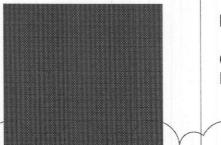


PAINTED EXISTING BRACKETS COLOR: BLACK FINISH: MATTE

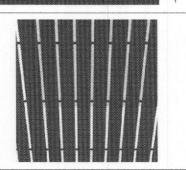

ALUMINUM SLAT SCREEN COLOR: WALNUT FINISH: MATTE

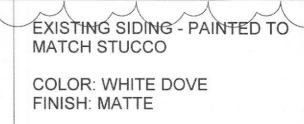

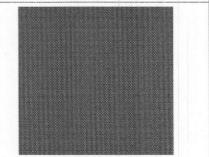

EXISTING STONE - PAINTED

COLOR: EVENING DOVE FINISH: MATTE

CASE NUMBER: SP2021-013

METHOD ON THE SUITE 2 NS, TEXAS 75201 640 - 6331

CLUB ROCKWALL

408 S GOLIAD ST. ROCKWALL, TX 75 PM: DH DE: AJ PROJECT:

MB205016 SHEET:

> A3.01 BUILDING ELEVATIONS

- A. QUALIFICATIONS OF LANDSCAPE CONTRACTOR
- ALL LANDSCAPE WORK SHOWN ON THESE PLANS SHALL BE PERFORMED BY A SINGLE FIRM SPECIALIZING IN LANDSCAPE PLANTING.
- A LIST OF SUCCESSFULLY COMPLETED PROJECTS OF THIS TYPE, SIZE AND NATURE MAY BE REQUESTED BY THE OWNER FOR FURTHER QUALIFICATION MEASURES.
- THE LANDSCAPE CONTRACTOR SHALL HOLD A VALID NURSERY AND FLORAL CERTIFICATE ISSUED BY THE TEXAS DEPARTMENT OF AGRICULTURE, AS WELL AS OPERATE UNDER A COMMERCIAL PESTICIDE APPLICATOR LICENSE ISSUED BY EITHER THE TEXAS DEPARTMENT OF AGRICULTURE OR THE TEXAS STRUCTURAL PEST CONTROL BOARD.
- WORK COVERED BY THESE SECTIONS INCLUDES THE FURNISHING AND PAYMENT OF ALL MATERIALS, LABOR, SERVICES, EQUIPMENT, LICENSES, TAXES AND ANY OTHER ITEMS THAT ARE NECESSARY FOR THE EXECUTION, INSTALLATION AND COMPLETION OF ALL WORK, SPECIFIED HEREIN AND / OR SHOWN
- ON THE LANDSCAPE PLANS, NOTES, AND DETAILS. ALL WORK SHALL BE PERFORMED IN ACCORDANCE WITH ALL APPLICABLE LAWS, CODES AND REGULATIONS REQUIRED BY AUTHORITIES HAVING JURISDICTION OVER SUCH WORK, INCLUDING ALL INSPECTIONS AND PERMITS REQUIRED BY FEDERAL, STATE AND LOCAL AUTHORITIES IN SUPPLY,
- RANSPORTATION AND INSTALLATION OF MATERIALS. THE LANDSCAPE CONTRACTOR SHALL VERIFY THE LOCATION OF ALL UNDERGROUND UTILITY LINES (WATER, SEWER, ELECTRICAL, TELEPHONE, GAS, CABLE, TELEVISION, ETC.) PRIOR TO THE START OF

PRODUCTS

- A. ALL MANUFACTURED PRODUCTS SHALL BE NEW. B. CONTAINER AND BALLED-AND-BURLAPPED PLANTS
 - FURNISH NURSERY-GROWN PLANTS COMPLYING WITH ANSI Z60.1-2014. PROVIDE WELL-SHAPED, FULLY BRANCHED, HEALTHY, VIGOROUS STOCK FREE OF DISEASE, INSECTS, EGGS, LARVAE, AND DEFECTS SUCH AS KNOTS, SUN SCALD, INJURIES, ABRASIONS, AND DISFIGUREMENT. ALL PLANTS WITHIN A SPECIES SHALL HAVE SIMILAR SIZE, AND SHALL BE OF A FORM TYPICAL FOR THE SPECIES. ALL TREES SHALL BE OBTAINED FROM SOURCES WITHIN 200 MILES OF THE PROJECT SITE, AND WITH SIMILAR
- CLIMACTIC CONDITIONS ROOT SYSTEMS SHALL BE HEALTHY, DENSELY BRANCHED ROOT SYSTEMS, NON-POT-BOUND, FREE FROM ENCIRCLING AND/OR GIRDLING ROOTS, AND FREE FROM ANY OTHER ROOT DEFECTS (SUCH AS LSHAPED ROOTS
- TREES MAY BE PLANTED FROM CONTAINERS OR BALLED-AND-BURLAPPED (B&B), UNLESS SPECIFIED ON THE PLANTING LEGEND. BARE-ROOT TREES ARE NOT ACCEPTABLE.
- ANY PLANT DEEMED UNACCEPTABLE BY THE LANDSCAPE ARCHITECT OR OWNER SHALL BE IMMEDIATELY REMOVED FROM THE SITE AND SHALL BE REPLACED WITH AN ACCEPTBLE PLANT OF LIKE TYPE AND SIZE AT THE CONTRACTOR'S OWN EXPENSE. ANY PLANTS APPEARING TO BE UNHEALTHY, EVEN IF DETERMINED TO STILL BE ALIVE, SHALL NOT BE ACCEPTED. THE LANDSCAPE ARCHITECT AND OWNER SHALL BE THE SOLE JUDGES AS TO THE ACCEPTABILITY OF PLANT MATERIAL
- ALL TREES SHALL BE STANDARD IN FORM, UNLESS OTHERWISE SPECIFIED. TREES WITH CENTRAL LEADERS WILL NOT BE ACCEPTED IF LEADER IS DAMAGED OR REMOVED. PRUNE ALL DAMAGED TWIGS
- CALIPER MEASUREMENTS FOR STANDARD (SINGLE TRUNK) TREES SHALL BE AS FOLLOWS: SIX INCHES ABOVE THE ROOT FLARE FOR TREES UP TO AND INCLUDING FOUR INCHES IN CALIPER, AND TWELVE INCHES ABOVE THE ROOT FLARE FOR TREES EXCEEDING FOUR INCHES IN CALIPER.
- MULTI-TRUNK TREES SHALL BE MEASURED BY THEIR OVERALL HEIGHT, MEASURED FROM THE TOP OF THE ROOT BALL. WHERE CALIPER MEASUREMENTS ARE USED, THE CALIPER SHALL BE CALCULATED AS ONE-HALF OF THE SUM OF THE CALIPER OF THE THREE LARGEST TRUNKS. ANY TREE OR SHRUB SHOWN TO HAVE EXCESS SOIL PLACED ON TOP OF THE ROOT BALL, SO THAT
- THE ROOT FLARE HAS BEEN COMPLETELY COVERED, SHALL BE REJECTED. C. SOD: PROVIDE WELL-ROOTED SOD OF THE VARIETY NOTED ON THE PLANS. SOD SHALL BE CUT FROM HEALTHY, MATURE TURF WITH SOIL THICKNESS OF 3/4" TO 1". EACH PALLET OF SOD SHALL BE
- ACCOMPANIED BY A CERTIFICATE FROM SUPPLIER STATING THE COMPOSITION OF THE SOD. D. TOPSOIL: SANDY TO CLAY LOAM TOPSOIL, FREE OF STONES LARGER THAN ½ INCH, FOREIGN MATTER, PLANTS, ROOTS, AND SEEDS.
- E. COMPOST: WELL-COMPOSTED, STABLE, AND WEED-FREE ORGANIC MATTER, pH RANGE OF 5.5 TO 8; MOISTURE CONTENT 35 TO 55 PERCENT BY WEIGHT; 100 PERCENT PASSING THROUGH 3/4-INCH SIEVE; SOLUBLE SALT CONTENT OF 5 TO 10 DECISIEMENS/M; NOT EXCEEDING 0.5 PERCENT INERT CONTAMINANTS AND FREE OF SUBSTANCES TOXIC TO PLANTINGS. NO MANURE OR ANIMAL-BASED PRODUCTS SHALL BE
- F. FERTILIZER: GRANULAR FERTILIZER CONSISTING OF NITROGEN, PHOSPHORUS, POTASSIUM, AND OTHER NUTRIENTS IN PROPORTIONS, AMOUNTS, AND RELEASE RATES RECOMMENDED IN A SOIL REPORT FROM A QUALIFIED SOIL-TESTING AGENCY (SEE BELOW).
- MULCH: SIZE AND TYPE AS INDICATED ON PLANS, FREE FROM DELETERIOUS MATERIALS AND SUITABLE AS A TOP DRESSING OF TREES AND SHRUBS.
- H. TREE STAKING AND GUYING STAKES: 6' LONG GREEN METAL T-POSTS.
- GUY AND TIE WIRE: ASTM A 641, CLASS 1, GALVANIZED-STEEL WIRE, 2-STRAND, TWISTED, 0.106 INCH STRAP CHAFING GUARD: REINFORCED NYLON OR CANVAS AT LEAST 1-1/2 INCH WIDE, WITH
- GROMMETS TO PROTECT TREE TRUNKS FROM DAMAGE. STEEL EDGING: PROFESSIONAL STEEL EDGING, 14 GAUGE THICK X 4 INCHES WIDE, FACTORY PAINTED DARK GREEN. ACCEPTABLE MANUFACTURERS INCLUDE COL-MET OR APPROVED EQUAL.
- PRE-EMERGENT HERBICIDES: ANY GRANULAR, NON-STAINING PRE-EMERGENT HERBICIDE THAT IS LABELED FOR THE SPECIFIC ORNAMENTALS OR TURF ON WHICH IT WILL BE UTILIZED. PRE-EMERGENT HERBICIDES SHALL BE APPLIED PER THE MANUFACTURER'S LABELED RATES.

METHODS

- BEFORE STARTING WORK, THE LANDSCAPE CONTRACTOR SHALL VERIFY THAT THE GRADE OF ALL LANDSCAPE AREAS ARE WITHIN +/-0.1' OF FINISH GRADE. THE CONTRACTOR SHALL NOTIFY THE OWNER IMMEDIATELY SHOULD ANY DISCREPANCIES EXIST.
 - SOIL TESTING AFTER FINISH GRADES HAVE BEEN ESTABLISHED, CONTRACTOR SHALL HAVE SOIL SAMPLES FROM THE PROJECT'S LANDSCAPE AREAS TESTED BY AN ESTABLISHED SOIL TESTING LABORATORY, EACH SAMPLE SUBMITTED TO THE LAB SHALL CONTAIN NO LESS THAN ONE QUART OF SOIL, TAKEN FROM BETWEEN THE SOIL SURFACE AND 6" DEPTH. IF NO SAMPLE LOCATIONS ARE INDICATED ON THE PLANS, THE CONTRACTOR SHALL TAKE A MINIMUM OF THREE SAMPLES FROM VARIOUS REPRESENTATIVE LOCATIONS FOR TESTING.
 - THE CONTRACTOR SHALL HAVE THE SOIL TESTING LABORATORY PROVIDE RESULTS FOR THE FOLLOWING: SOIL TEXTURAL CLASS, GENERAL SOIL FERTILITY, pH, ORGANIC MATTER CONTENT, SALT (CEC), LIME, SODIUM ADSORPTION RATIO (SAR) AND BORON CONTENT.
 - THE CONTRACTOR SHALL ALSO SUBMIT THE PROJECT'S PLANT LIST TO THE LABORATORY ALONG WITH THE SOIL SAMPLES. THE SOIL REPORT PRODUCED BY THE LABORATORY SHALL CONTAIN RECOMMENDATIONS FOR
 - THE FOLLOWING (AS APPROPRIATE): SEPARATE SOIL PREPARATION AND BACKFILL MIX RECOMMENDATIONS FOR GENERAL ORNAMENTAL PLANTS, XERIC PLANTS, TURF, AND NATIVE SEED, AS WELL AS PRE-PLANT FERTILIZER APPLICATIONS AND RECOMMENDATIONS FOR ANY OTHER SOIL RELATED ISSUES. THE REPORT SHALL ALSO PROVIDE A FERTILIZER PROGRAM FOR THE ESTABLISHMENT PERIOD AND FOR LONG-TERM MAINTENANCE. THE CONTRACTOR SHALL INSTALL SOIL AMENDMENTS AND FERTILIZERS PER THE SOILS REPORT
- RECOMMENDATIONS. ANY CHANGE IN COST DUE TO THE SOIL REPORT RECOMMENDATIONS, EITHER INCREASE OR DECREASE, SHALL BE SUBMITTED TO THE OWNER WITH THE REPORT. FOR BIDDING PURPOSES ONLY, THE SOIL PREPARATION SHALL CONSIST OF THE FOLLOWING: TURF: INCORPORATE THE FOLLOWING AMENDMENTS INTO THE TOP 8" OF SOIL BY MEANS OF
- ROTOTILLING AFTER CROSS-RIPPING: NITROGEN STABILIZED ORGANIC AMENDMENT - 4 CU. YDS. PER 1,000 S.F. PREPLANT TURF FERTILIZER (10-20-10 OR SIMILAR, SLOW RELEASE, ORGANIC) - 15 LBS PER 1,000
- "CLAY BUSTER" OR EQUAL USE MANUFACTURER'S RECOMMENDED RATE TREES, SHRUBS, AND PERENNIALS: INCORPORATE THE FOLLOWING AMENDMENTS INTO THE TOP 8" OF SOIL BY MEANS OF ROTOTILLING AFTER CROSS-RIPPING
- NITROGEN STABILIZED ORGANIC AMENDMENT 4 CU. YDS. PER 1,000 S.F. 12-12-12 FERTILIZER (OR SIMILAR, ORGANIC, SLOW RELEASE) - 10 LBS. PER CU. YD. "CLAY BUSTER" OR EQUAL - USE MANUFACTURER'S RECOMMENDED RATE IRON SULPHATE - 2 LBS. PER CU. YD.
- IN THE CONTEXT OF THESE PLANS, NOTES, AND SPECIFICATIONS, "FINISH GRADE" REFERS TO THE FINAL ELEVATION OF THE SOIL SURFACE (NOT TOP OF MULCH) AS INDICATED ON THE GRADING PLANS. a. BEFORE STARTING WORK, THE LANDSCAPE CONTRACTOR SHALL VERIFY THAT THE ROUGH GRADES OF ALL LANDSCAPE AREAS ARE WITHIN +/-0.1' OF FINISH GRADE. SEE SPECIFICATIONS
- FOR MORE DETAILED INSTRUCTION ON TURF AREA AND PLANTING BED PREPARATION. b. CONSTRUCT AND MAINTAIN FINISH GRADES AS SHOWN ON GRADING PLANS, AND CONSTRUCT AND MAINTAIN SLOPES AS RECOMMENDED BY THE GEOTECHNICAL REPORT. ALL LANDSCAPE AREAS SHALL HAVE POSITIVE DRAINAGE AWAY FROM STRUCTURES AT THE MINIMUM SLOPE SPECIFIED IN THE REPORT AND ON THE GRADING PLANS, AND AREAS OF POTENTIAL PONDING SHALL BE REGRADED TO BLEND IN WITH THE SURROUNDING GRADES AND ELIMINATE PONDING
- C. THE LANDSCAPE CONTRACTOR SHALL DETERMINE WHETHER OR NOT THE EXPORT OF ANY SOIL WILL BE NEEDED, TAKING INTO ACCOUNT THE ROUGH GRADE PROVIDED, THE AMOUNT OF SOIL AMENDMENTS TO BE ADDED (BASED ON A SOIL TEST, PER SPECIFICATIONS), AND THE FINISH GRADES TO BE ESTABLISHED
- d. ENSURE THAT THE FINISH GRADE IN SHRUB AREAS IMMEDIATELY ADJACENT TO WALKS AND OTHER WALKING SURFACES, AFTER INSTALLING SOIL AMENDMENTS, IS 3" BELOW THE ADJACENT FINISH SURFACE, IN ORDER TO ALLOW FOR PROPER MULCH DEPTH. TAPER THE SOIL SURFACE TO MEET FINISH GRADE, AS SPECIFIED ON THE GRADING PLANS, AT APPROXIMATELY 18" AWAY FROM THE WALKS
- ENSURE THAT THE FINISH GRADE IN TURF AREAS IMMEDIATELY ADJACENT TO WALKS AND OTHER WALKING SURFACES, AFTER INSTALLING SOIL AMENDMENTS, IS 1" BELOW THE FINISH SURFACE OF THE WALKS. TAPER THE SOIL SURFACE TO MEET FINISH GRADE, AS SPECIFIED ON THE GRADING PLANS, AT APPROXIMATELY 18" AWAY FROM THE WALKS. SHOULD ANY CONFLICTS AND/OR DISCREPANCIES ARISE BETWEEN THE GRADING PLANS, GEOTECHNICAL REPORT, THESE NOTES AND PLANS, AND ACTUAL CONDITIONS, THE CONTRACTOR SHALL IMMEDIATELY BRING SUCH ITEMS TO THE ATTENTION OF THE LANDSCAPE
- ARCHITECT, GENERAL CONTRACTOR, AND OWNER. ONCE SOIL PREPARATION IS COMPLETE, THE LANDSCAPE CONTRACTOR SHALL ENSURE THAT THERE ARE NO DEBRIS, TRASH, OR STONES LARGER THAN 1" REMAINING IN THE TOP 6" OF SOIL.

- THE CONTRACTOR SHALL PROVIDE SUBMITTALS AND SAMPLES, IF REQUIRED, TO THE LANDSCAPE ARCHITECT, AND RECEIVE APPROVAL IN WRITING FOR SUCH SUBMITTALS BEFORE WORK COMMENCES. SUBMITTALS SHALL INCLUDE PHOTOS OF PLANTS WITH A RULER OR MEASURING STICK FOR SCALE, PHOTOS OR SAMPLES OF ANY REQUIRED MULCHES, AND SOIL TEST RESULTS AND PREPARATION RECOMMENDATIONS FROM THE TESTING LAB (INCLUDING COMPOST AND FERTILIZER RATES AND
- SUBMITTALS SHALL ALSO INCLUDE MANUFACTURER CUT SHEETS FOR PLANTING ACCESSORIES SUCH AS TREE STAKES AND TIES, EDGING, AND LANDSCAPE FABRICS (IF ANY) WHERE MULTIPLE ITEMS ARE SHOWN ON A PAGE, THE CONTRACTOR SHALL CLEARLY INDICATE THE ITEM BEING CONSIDERED.

TYPES, AND OTHER AMENDMENTS FOR TREE/SHRUB, TURF, AND SEED AREAS AS MAY BE

- C. GENERAL PLANTING REMOVE ALL NURSERY TAGS AND STAKES FROM PLANTS. EXCEPT IN AREAS TO BE PLANTED WITH ORNAMENTAL GRASSES, APPLY PRE-EMERGENT HERBICIDES
- AT THE MANUFACTURER'S RECOMMENDED RATE. TRENCHING NEAR EXISTING TREES a. CONTRACTOR SHALL NOT DISTURB ROOTS 1-1/2" AND LARGER IN DIAMETER WITHIN THE CRITICAL ROOT ZONE (CRZ) OF EXISTING TREES, AND SHALL EXERCISE ALL POSSIBLE CARE AND
- DEFINED AS A CIRCULAR AREA EXTENDING OUTWARD FROM THE TREE TRUNK, WITH A RADIUS EQUAL TO 1' FOR EVERY 1" OF TRUNK DIAMETER-AT-BREAST-HEIGHT (4.5' ABOVE THE AVERAGE GRADE AT THE TRUNK). ALL EXCAVATION WITHIN THE CRZ SHALL BE PERFORMED USING HAND TOOLS. NO MACHINE

PRECAUTIONS TO AVOID INJURY TO TREE ROOTS. TRUNKS, AND BRANCHES. THE CRZ IS

- EXCAVATION OR TRENCHING OF ANY KIND SHALL BE ALLOWED WITHIN THE CRZ. ALTER ALIGNMENT OF PIPE TO AVOID TREE ROOTS 1-1/2" AND LARGER IN DIAMETER. WHERE FREE ROOTS 1-1/2" AND LARGER IN DIAMETER ARE ENCOUNTERED IN THE FIELD, TUNNEL UNDER SUCH ROOTS. WRAP EXPOSED ROOTS WITH SEVERAL LAYERS OF BURLAP AND KEEP MOIST.
- CLOSE ALL TRENCHES WITHIN THE CANOPY DRIP LINES WITHIN 24 HOURS. ALL SEVERED ROOTS SHALL BE HAND PRUNED WITH SHARP TOOLS AND ALLOWED TO AIR-DRY. DO NOT USE ANY SORT OF SEALERS OR WOUND PAINTS.
- TREE PLANTING TREE PLANTING HOLES SHALL BE EXCAVATED TO MINIMUM WIDTH OF TWO TIMES THE WIDTH OF THE ROOTBALL, AND TO A DEPTH EQUAL TO THE DEPTH OF THE ROOTBALL LESS TWO TO FOUR INCHES. SCARIFY THE SIDES AND BOTTOM OF THE PLANTING HOLE PRIOR TO THE PLACEMENT OF THE TREE REMOVE ANY GLAZING THAT MAY HAVE BEEN CAUSED DURING THE EXCAVATION OF THE HOLE.
- FOR CONTAINER AND BOX TREES, TO REMOVE ANY POTENTIALLY GIRDLING ROOTS AND OTHER ROOT DEFECTS, THE CONTRACTOR SHALL SHAVE A 1" LAYER OFF OF THE SIDES AND BOTTOM OF THE ROOTBALL OF ALL TREES JUST BEFORE PLACING INTO THE PLANTING PIT. DO NOT "TEASE" ROOTS OUT FROM THE ROOTBALL.
- INSTALL THE TREE ON UNDISTURBED SUBGRADE SO THAT THE TOP OF THE ROOTBALL IS TWO TO FOUR INCHES ABOVE THE SURROUNDING GRADE. BACKFILL THE TREE HOLE UTILIZING THE EXISTING TOPSOIL FROM ON-SITE. ROCKS LARGER THAN 1" DIA. AND ALL OTHER DEBRIS SHALL BE REMOVED FROM THE SOIL PRIOR TO THE BACKFILL. SHOULD ADDITIONAL SOIL BE REQUIRED TO ACCOMPLISH THIS TASK, USE STORED TOPSOIL FROM ON-SITE OR IMPORT ADDITIONAL TOPSOIL FROM OFF-SITE AT NO ADDITIONAL COST TO THE OWNER. IMPORTED
- TOPSOIL SHALL BE OF SIMILAR TEXTURAL CLASS AND COMPOSITION IN THE ON-SITE SOIL. TREES SHALL NOT BE STAKED UNLESS LOCAL CONDITIONS (SUCH AS HEAVY WINDS OR SLOPES) REQUIRE STAKES TO KEEP TREES UPRIGHT. SHOULD STAKING BE REQUIRED, THE TOTAL NUMBER OF TREE STAKES (BEYOND THE MINIMUMS LISTED BELOW) WILL BE LEFT TO THE LANDSCAPE CONTRACTOR'S DISCRETION. SHOULD ANY TREES FALL OR LEAN, THE LANDSCAPE CONTRACTOR SHALL STRAIGHTEN THE TREE, OR REPLACE IT SHOULD IT BECOME DAMAGED. TREE STAKING SHALL
- ADHERE TO THE FOLLOWING GUIDELINES: TWO STAKES PER TREE THREE STAKES PER TREE 2-1/2"-4" TREES
- TREES OVER 4" CALIPER GUY AS NEEDED THREE STAKES PER TREE MINIMUM, QUANTITY AND POSITIONS AS MULTI-TRUNK TREES NEEDED TO STABILIZE THE TREE THREE STAKES PER TREE MINIMUM, QUANTITY AND POSITIONS AS MULTI-TRUNK TREES
- NEEDED TO STABILIZE THE TREE UPON COMPLETION OF PLANTING, CONSTRUCT AN EARTH WATERING BASIN AROUND THE TREE. COVER THE INTERIOR OF THE TREE RING WITH THE WEED BARRIER CLOTH AND TOPDRESS WITH MULCH (TYPE AND DEPTH PER PLANS).
- SHRUB, PERENNIAL, AND GROUNDCOVER PLANTING DIG THE PLANTING HOLES TWICE AS WIDE AND 2" LESS DEEP THAN EACH PLANT'S ROOTBALL. INSTALL THE PLANT IN THE HOLE. BACKFILL AROUND THE PLANT WITH SOIL AMENDED PER SOIL TEST RECOMMENDATIONS
- INSTALL THE WEED BARRIER CLOTH, OVERLAPPING IT AT THE ENDS. UTILIZE STEEL STAPLES TO KEEP THE WEED BARRIER CLOTH IN PLACE. WHEN PLANTING IS COMPLETE, INSTALL MULCH (TYPE AND DEPTH PER PLANS) OVER ALL PLANTING BEDS, COVERING THE ENTIRE PLANTING AREA.
- SOD VARIETY TO BE AS SPECIFIED ON THE LANDSCAPE PLAN.
- LAY SOD WITHIN 24 HOURS FROM THE TIME OF STRIPPING. DO NOT LAY IF THE GROUND IS FROZEN. LAY THE SOD TO FORM A SOLID MASS WITH TIGHTLY FITTED JOINTS. BUTT ENDS AND SIDES OF SOD STRIPS - DO NOT OVERLAP. STAGGER STRIPS TO OFFSET JOINTS IN ADJACENT COURSES.
- 4. ROLL THE SOD TO ENSURE GOOD CONTACT OF THE SOD'S ROOT SYSTEM WITH THE SOIL
- WATER THE SOD THOROUGHLY WITH A FINE SPRAY IMMEDIATELY AFTER PLANTING TO OBTAIN AT LEAST SIX INCHES OF PENETRATION INTO THE SOIL BELOW THE SOD.
- INSTALL MULCH TOPDRESSING, TYPE AND DEPTH PER MULCH NOTE, IN ALL PLANTING AREAS AND DO NOT INSTALL MULCH WITHIN 6" OF TREE ROOT FLARE AND WITHIN 24" OF HABITABLE STRUCTURES, EXCEPT AS MAY BE NOTED ON THESE PLANS. MULCH COVER WITHIN 6" OF CONCRETE WALKS AND CURBS SHALL NOT PROTRUDE ABOVE THE FINISH SURFACE OF THE WALKS AND CURBS. MULCH
- COVER WITHIN 12" OF WALLS SHALL BE AT LEAST 3" LOWER THAN THE TOP OF WALL. DURING LANDSCAPE PREPARATION AND PLANTING, KEEP ALL PAVEMENT CLEAN AND ALL WORK AREAS IN A NEAT, ORDERLY CONDITION.
- DISPOSED LEGALLY OF ALL EXCAVATED MATERIALS OFF THE PROJECT SITE. INSPECTION AND ACCEPTANCE UPON COMPLETION OF THE WORK, THE LANDSCAPE CONTRACTOR SHALL PROVIDE THE SITE CLEAN, FREE OF DEBRIS AND TRASH, AND SUITABLE FOR USE AS INTENDED. THE LANDSCAPE CONTRACTOR SHALL THEN REQUEST AN INSPECTION BY THE OWNER TO DETERMINE FINAL ACCEPTABILITY.
- WHEN THE INSPECTED PLANTING WORK DOES NOT COMPLY WITH THE CONTRACT DOCUMENTS, THE LANDSCAPE CONTRACTOR SHALL REPLACE AND/OR REPAIR THE REJECTED WORK TO THE OWNER'S SATISFACTION WITHIN 24 HOURS THE LANDSCAPE MAINTENANCE PERIOD WILL NOT COMMENCE UNTIL THE LANDSCAPE WORK HAS
- BEEN RE-INSPECTED BY THE OWNER AND FOUND TO BE ACCEPTABLE. AT THAT TIME, A WRITTEN NOTICE OF FINAL ACCEPTANCE WILL BE ISSUED BY THE OWNER, AND THE MAINTENANCE AND GUARANTEE PERIODS WILL COMMENCE. LANDSCAPE MAINTENANCE
- THE LANDSCAPE CONTRACTOR SHALL BE RESPONSIBLE FOR THE MAINTENANCE OF ALL WORK SHOWN ON THESE PLANS FOR 90 DAYS BEYOND FINAL ACCEPTANCE OF ALL LANDSCAPE WORK BY THE OWNER. LANDSCAPE MAINTENANCE SHALL INCLUDE WEEKLY SITE VISITS FOR THE FOLLOWING ACTIONS (AS APPROPRIATE): PROPER PRUNING, RESTAKING OF TREES, RESETTING OF PLANTS THAT HAVE SETTLED, MOWING AND AERATION OF LAWNS, WEEDING, TREATING FOR INSECTS AND DISEASES, REPLACEMENT OF MULCH, REMOVAL OF LITTER, REPAIRS TO THE IRRIGATION SYSTEM DUE TO FAULTY PARTS AND/OR WORKMANSHIP, AND THE APPROPRIATE WATERING OF ALL PLANTINGS. THE LANDSCAPE CONTRACTOR SHALL MAINTAIN THE IRRIGATION SYSTEM IN PROPER WORKING ORDER, WITH SCHEDULING ADJUSTMENTS BY SEASON TO MAXIMIZE WATER CONSERVATION.
- SHOULD SEEDED AND/OR SODDED AREAS NOT BE COVERED BY AN AUTOMATIC IRRIGATION SYSTEM, THE LANDSCAPE CONTRACTOR SHALL BE RESPONSIBLE FOR WATERING THESE AREAS AND OBTAINING A FULL, HEALTHY STAND OF PLANTS AT NO ADDITIONAL COST TO THE OWNER.
- TO ACHIEVE FINAL ACCEPTANCE AT THE END OF THE MAINTENANCE PERIOD, ALL OF THE FOLLOWING CONDITIONS MUST OCCUR: a. THE LANDSCAPE SHALL SHOW ACTIVE, HEALTHY GROWTH (WITH EXCEPTIONS MADE FOR SEASONAL DORMANCY). ALL PLANTS NOT MEETING THIS CONDITION SHALL BE REJECTED AND
- ALL HARDSCAPE SHALL BE CLEANED PRIOR TO FINAL ACCEPTANCE. SODDED AREAS MUST BE ACTIVELY GROWING AND MUST REACH A MINIMUM HEIGHT OF 1 1/2 INCHES BEFORE FIRST MOWING. BARE AREAS LARGER THAN TWELVE SQUARE INCHES MUST BE RESODDED (AS APPROPRIATE) PRIOR TO FINAL ACCEPTANCE. ALL SODDED TURF SHALL BE
- WARRANTY PERIOD, PLANT GUARANTEE AND REPLACEMENTS THE LANDSCAPE CONTRACTOR SHALL GUARANTEE ALL TREES, SHRUBS, PERENNIALS, SOD, AND IRRIGATION SYSTEMS FOR A PERIOD OF ONE YEAR FROM THE DATE OF THE OWNER'S FINAL ACCEPTANCE (90 DAYS FOR ANNUAL PLANTS). THE CONTRACTOR SHALL REPLACE, AT HIS OWN EXPENSE AND TO THE SATISFACTION OF THE OWNER, ANY PLANTS WHICH DIE IN THAT TIME, OR REPAIR ANY PORTIONS OF THE IRRIGATION SYSTEM WHICH OPERATE IMPROPERLY.


REPLACED BY HEALTHY PLANT MATERIAL PRIOR TO FINAL ACCEPTANCE.

AFTER THE INITIAL MAINTENANCE PERIOD AND DURING THE GUARANTEE PERIOD, THE LANDSCAPE CONTRACTOR SHALL ONLY BE RESPONSIBLE FOR REPLACEMENT OF PLANTS WHEN PLANT DEATH CANNOT BE ATTRIBUTED DIRECTLY TO OVERWATERING OR OTHER DAMAGE BY HUMAN ACTIONS. PROVIDE A MINIMUM OF (2) COPIES OF RECORD DRAWINGS TO THE OWNER UPON COMPLETION OF WORK. A RECORD DRAWING IS A RECORD OF ALL CHANGES THAT OCCURRED IN THE FIELD AND THAT ARE


DOCUMENTED THROUGH CHANGE ORDERS, ADDENDA, OR CONTRACTOR/CONSULTANT DRAWING MARKUPS.

(1) ROLLED-TOP STEEL EDGING PER PLANS. (2) TAPERED STEEL STAKES. (3) MULCH, TYPE AND DEPTH PER PLANS. (4) FINISH GRADE.) INSTALL EDGING SO THAT STAKES WILL BE ON INSIDE OF PLANTING BED. BOTTOM OF EDGING SHALL BE BURIED A MINIMUM OF 1" BELOW FINISH GRADE. 3) TOP OF MULCH SHALL BE 1" LOWER THAN TOP OF EDGING.

STEEL EDGING

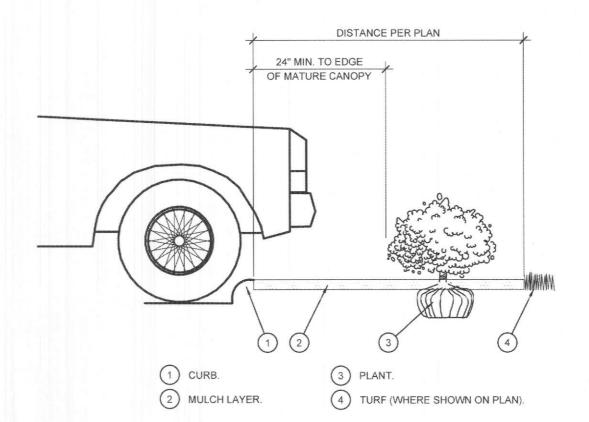

LANTING AT PARKING AREA

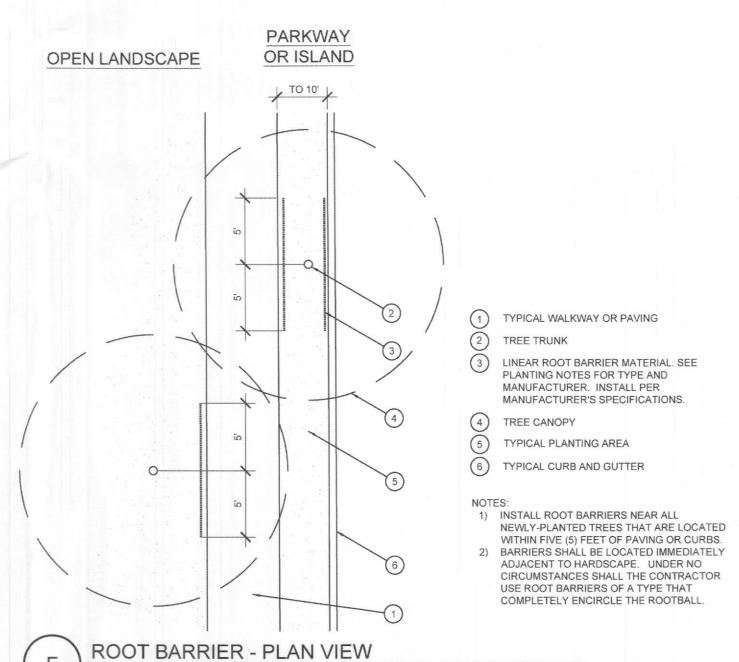

CONIFEROUS NON-CONIFEROUS (9) ROOT BALL. 3X ROOTBALL DIA STAKING EXAMPLES (PLAN VIEW)

PREVAILING

WINDS TREE PLANTING

PREVAILING

1 TREE CANOPY. (2) CINCH-TIES (24" BOX/2" CAL. TREES AND SMALLER) OR 2 GAUGE GALVANIZED WIRE WITH NYLON TREE STRAPS AT TREE AND STAKE (36" BOX/2.5" CAL. TREES AND LARGER). SECURE TIES OR STRAPS TO TRUNK

JUST ABOVE LOWEST MAJOR BRANCHES.

(3) 24" X 3/4" P.V.C. MARKERS OVER WIRES. (4) GREEN STEEL T-POSTS. EXTEND POSTS 12" MIN. INTO

UNDISTURBED SOIL. (5) PRESSURE-TREATED WOOD DEADMAN, TWO PER TREE (MIN.). BURY OUTSIDE OF PLANTING PIT AND

18" MIN. INTO UNDISTURBED SOIL.

(6) TRUNK FLARE.

7) MULCH, TYPE AND DEPTH PER PLANS. DO NOT PLACE MULCH WITHIN 6" OF TRUNK.

(8) FINISH GRADE.

BACKFILL. AMEND AND FERTILIZE ONLY AS RECOMMENDED IN SOIL FERTILITY ANALYSIS.

(11) UNDISTURBED NATIVE SOIL.

(12) 4" HIGH EARTHEN WATERING BASIN. (13) FINISH GRADE.

SCARIFY SIDES OF PLANTING PIT PRIOR TO SETTING TREE. REMOVE EXCESS SOIL APPLIED ON TOP OF THE ROOTBALL THAT COVERS THE ROOT FLARE. THE PLANTING HOLE DEPTH SHALL BE SUCH THAT THE ROOTBALL RESTS ON UNDISTURBED SOIL, AND THE ROOT FLARE IS 2"-4" ABOVE FINISH GRADE FOR B&B TREES, CUT OFF BOTTOM 1/3 OF WIRE BASKET BEFORE PLACING TREE IN HOLE, CUT OFF AND REMOVE REMAINDER OF BASKET AFTER TREE IS SET IN HOLE, REMOVE ALL NYLON TIES, TWINE, ROPE, AND OTHER PACKING MATERIAL. REMOVE AS MUCH BURLAP FROM AROUND ROOTBALL AS IS PRACTICAL. 4. REMOVE ALL NURSERY STAKES AFTER PLANTING. 5. FOR TREES 36" BOX/2.5" CAL. AND LARGER, USE THREE STAKES OR DEADMEN (AS APPROPRIATE) SPACED EVENLY AROUND TREE 6. STAKING SHALL BE TIGHT ENOUGH TO PREVENT TRUNK FROM

BENDING. BUT LOOSE ENOUGH TO ALLOW SOME TRUNK MOVEMENT

 SHRUB, PERENNIAL, OR ORNAMENTAL GRASS. MULCH, TYPE AND DEPTH PER PLANS. PLACE NO MORE THAN 1" OF MULCH WITHIN 6" OF PLANT CENTER (3) FINISH GRADE

> (4) ROOT BALL (5) BACKFILL. AMEND AND FERTILIZE ONLY AS RECOMMENDED IN SOIL FERTILITY ANALYSIS.

(6) UNDISTURBED NATIVE SOIL.

SHRUB AND PERENNIAL PLANTING

Addison, TX 75001 www.EvergreenDesignGroup.com

EVERGREEN

(800) 680-6630

15455 Dallas Pkwy., Ste 600

05/11/2021

0

Q

O

(7) 3" HIGH EARTHEN WATERING BASIN.

0 0

Landscape Planting Details & Specs.

Date Comment Project Number SP2021-013

05/05/202 Drawn By Checked By DB/RM

SITE PLAN SIGNATURE BLOCK

I hereby certify that the above and foregoing site plan for a development in the City of Rockwall, Texas, was approved by the Planning & Zoning Commission of the City of Rockwall on the 11 day of May, 2021

Plenning & Zoning Commission, Chairman Director of Planning and Zoning

- BY SUBMITTING A PROPOSAL FOR THE LANDSCAPE PLANTING SCOPE OF WORK, THE CONTRACTOR CONFIRMS THAT HE HAS READ, AND WILL COMPLY WITH, THE ASSOCIATED NOTES, SPECIFICATIONS, AND DETAILS
- THE GENERAL CONTRACTOR IS RESPONSIBLE FOR REMOVING ALL EXISTING VEGETATION (EXCEPT WHERE NOTED TO REMAIN).
- 3. IN THE CONTEXT OF THESE PLANS, NOTES, AND SPECIFICATIONS, "FINISH GRADE" REFERS TO THE FINAL ELEVATION OF THE SOIL SURFACE (NOT TOP OF MULCH) AS INDICATED ON THE GRADING PLANS. a. BEFORE STARTING WORK, THE LANDSCAPE CONTRACTOR SHALL VERIFY THAT THE ROUGH GRADES OF ALL LANDSCAPE AREAS ARE WITHIN +/-0.1' OF FINISH GRADE. SEE SPECIFICATIONS FOR MORE DETAILED INSTRUCTION ON TURF AREA AND PLANTING BED
- PREPARATION. b. CONSTRUCT AND MAINTAIN FINISH GRADES AS SHOWN ON GRADING PLANS AND CONSTRUCT AND MAINTAIN SLOPES AS RECOMMENDED BY THE GEOTECHNICAL REPORT. ALL LANDSCAPE AREAS SHALL HAVE POSITIVE DRAINAGE AWAY FROM STRUCTURES AT THE MINIMUM SLOPE SPECIFIED IN THE REPORT AND ON THE GRADING PLANS, AND AREAS OF POTENTIAL PONDING SHALL BE REGRADED TO BLEND IN WITH THE SURROUNDING GRADES AND ELIMINATE
- PONDING POTENTIAL. THE LANDSCAPE CONTRACTOR SHALL DETERMINE WHETHER OR NOT THE EXPORT OF ANY SOIL WILL BE NEEDED, TAKING INTO ACCOUNT THE ROUGH GRADE PROVIDED, THE AMOUNT OF SOIL AMENDMENTS

ROCCA VILLA

(BENT CREEK CONDO)

UNIT 101. BUILDING 101 LAKE MEADOWS DR ZONING: MF-14

- TO BE ADDED (BASED ON A SOIL TEST, PER SPECIFICATIONS), AND THE FINISH GRADES TO BE ESTABLISHED ENSURE THAT THE FINISH GRADE IN SHRUB AREAS IMMEDIATELY ADJACENT TO WALKS AND OTHER WALKING SURFACES, AFTER INSTALLING SOIL AMENDMENTS, IS 3" BELOW THE ADJACENT FINISH SURFACE, IN ORDER TO ALLOW FOR PROPER MULCH DEPTH. TAPER THE SOIL SURFACE TO MEET FINISH GRADE, AS SPECIFIED ON THE
- GRADING PLANS, AT APPROXIMATELY 18" AWAY FROM THE WALKS. ENSURE THAT THE FINISH GRADE IN TURF AREAS IMMEDIATELY ADJACENT TO WALKS AND OTHER WALKING SURFACES, AFTER INSTALLING SOIL AMENDMENTS, IS 1" BELOW THE FINISH SURFACE OF THE WALKS. TAPER THE SOIL SURFACE TO MEET FINISH GRADE. AS SPECIFIED ON THE GRADING PLANS, AT APPROXIMATELY 18"
- AWAY FROM THE WALKS. SHOULD ANY CONFLICTS AND/OR DISCREPANCIES ARISE BETWEEN THE GRADING PLANS, GEOTECHNICAL REPORT, THESE NOTES AND PLANS, AND ACTUAL CONDITIONS, THE CONTRACTOR SHALL IMMEDIATELY BRING SUCH ITEMS TO THE ATTENTION OF THE LANDSCAPE ARCHITECT, GENERAL CONTRACTOR, AND OWNER.
- ALL PLANT LOCATIONS ARE DIAGRAMMATIC. ACTUAL LOCATIONS SHALL BE VERIFIED WITH THE LANDSCAPE ARCHITECT OR DESIGNER PRIOR TO PLANTING. THE LANDSCAPE CONTRACTOR SHALL ENSURE THAT ALL REQUIREMENTS OF THE PERMITTING AUTHORITY ARE MET (I.E., MINIMUM PLANT QUANTITIES, PLANTING METHODS, TREE PROTECTION METHODS,
- THE LANDSCAPE CONTRACTOR IS RESPONSIBLE FOR DETERMINING PLANT QUANTITIES; PLANT QUANTITIES SHOWN ON LEGENDS AND CALLOUTS ARE FOR GENERAL INFORMATION ONLY. IN THE EVENT OF A DISCREPANCY BETWEEN THE PLAN AND THE PLANT LEGEND, THE PLANT QUANTITY AS SHOWN ON THE PLAN (FOR INDIVIDUAL SYMBOLS) OR CALLOUT (FOR GROUNDCOVER PATTERNS) SHALL
- TAKE PRECEDENCE. NO SUBSTITUTIONS OF PLANT MATERIALS SHALL BE ALLOWED NITHOUT THE WRITTEN PERMISSION OF THE LANDSCAPE ARCHITECT. IF SOME OF THE PLANTS ARE NOT AVAILABLE, THE

LANDSCAPE CONTRACTOR SHALL NOTIFY THE LANDSCAPE

- ARCHITECT IN WRITING (VIA PROPER CHANNELS). THE CONTRACTOR SHALL, AT A MINIMUM, PROVIDE REPRESENTATIVE PHOTOS OF ALL PLANTS PROPOSED FOR THE PROJECT. THE CONTRACTOR SHALL ALLOW THE LANDSCAPE ARCHITECT AND THE OWNER/OWNER'S REPRESENTATIVE TO INSPECT, AND APPROVE OF REJECT, ALL PLANTS DELIVERED TO THE JOBSITE, REFER TO SPECIFICATIONS FOR ADDITIONAL REQUIREMENTS FOR SUBMITTALS. THE CONTRACTOR SHALL MAINTAIN THE LANDSCAPE IN A HEALTHY CONDITION FOR 90 DAYS AFTER ACCEPTANCE BY THE OWNER. REFER TO SPECIFICATIONS FOR CONDITIONS OF ACCEPTANCE FOR THE START OF THE MAINTENANCE PERIOD, AND FOR FINAL ACCEPTANCE AT THE END OF
- THE MAINTENANCE PERIOD SEE SPECIFICATIONS AND DETAILS FOR FURTHER REQUIREMENTS.

PLANTING LEGEND

SYMBOL	BOTANIC NAME	COMMON NAME	MIN. SIZE	QUANTITY	REMARKS	
TREES						
ACRU	ACER RUBRUM 'OCTOBER GLORY'	OCTOBER GLORY MAPLE	4" cal., 14' high	4	CANOPY TREE	
CECA	CERCIS CANADENSIS	EASTERN REDBUD	2" cal., 6'-8' high	7	ACCENT TREE	
QUVI	QUERCUS VIRGINIANA	LIVE OAK	4" cal., 14' high	4	CANOPY TREE	

NOTE: ALL TREES SHALL BE CONTAINER-GROWN, CONTAINER SIZE AS APPROPRIATE FOR THE CALIPER SPECIFIED. SEE SPECS. FOR PROPER ROOT QUALITY.

SHRUBS					
BETH	BERBERIS THUN. 'CRIMSON PYGMY'	CRIMSON PYGMY BARBERRY	5 gallon	13	
HEPA	HESPERALOE PARVIFLORA	RED YUCCA	5 gallon	25	
ILCO	ILEX CORNUTA 'BURFORDII NANA'	DWARF BUFORD HOLLY	5 gallon	23	
JUCO	JUNIPERUS CONFERTA 'PACIFIC BLUE'	PACIFIC BLUE SHORE JUNIPER	5 gallon	29	
LOPE	LOROPETALUM CHINENSE 'RUBRUM'	CHINESE FRINGEFLOWER	5 gallon	9	

TURF AND S	SEED			
	Cynodon 'Tifway 419'	Tifway Hybrid Bermuda Grass	Sod	
	2"-4" Texas River Cobble, 3" De	eep, Lay over permeable landscape fabric		

NOTE: THE DEVELOPER SHALL ESTABLISH GRASS AND MAINTAIN THE SODDED AREA, INCLUDING WATERING, UNTIL A PERMANENT STAND OF GRASS IS OBTAINED AT WHICH TIME THE PROJECT WILL BE ACCEPTED BY THE CITY. A STAND OF GRASS SHALL CONSIST OF 75%-80% COVERAGE AND A MINIMUM O F 1" IN HEIGHT AS DETERMINED BY THE CITY.

LAKE MEADOWS DR 50' R.O.W. ROCCA VILLA, LOT 3 0.85 ACRES, EXEMPT - 5 - CECA 1 - EXISTING CREPE MYRTLE TO BE REMOVED 10' LANDSCAPE SHADED AREAS INDICATE (UNDER 4" CALIPER) BUFFER ZONE SIGHT TRIANGLES 5 - JUCO 16 - JUCO - EXISTING ØRN. PEAR TO REMAIN /(UNDER 4" CALIPER)/ 2 - EXISTING CREPE 2 - EXISTING CREPE MYRTLES TO BE REMOVED MYRTLES TO REMAIN (UNDER 4" CALIPER) (UNDER 4" CALIPER) - ROTARY SIGN ROCCA VILLA (BENT CREEK CONDO) 10' LANDSCAPE UNIT 102, BUILDING 1 **BUFFER ZONE** 102 LAKE MEADOWS DR ZONING: MF-14 9 - LOPE -EXISTING PLANT MATERIAL TO REMAIN - REPLACE AS NEEDED AFTER POWER POLE 2 - CECA -CONSTRUCTION ROCCA VILLA 0.69 ACRES 23 - ILCO -- Y-fant 1-1 + hamma 2-ACRU 10 - BETH

LANDSCAPE STANDARDS

05.01 LANDSCAPE BUFFERS - NON-RESIDENTIA REQ. ABUTTING A PUBLIC RIGHT-OF-WAY:

S. GOLIAD ST. - ±116' STREET FRONTAGE:

2 MAPLE (CANOPY), 2 REDBUD (ACCENT) PROVIDED LAKE MEADOWS DR. ±225' STREET FRONTAGE:

5 CANOPY TREES, 5 ACCENT TREES REQUIRED 4 LIVE OAK (CANOPY), 5 REDBUD (ACCENT) PROVIDED UNABLE TO MEET CANOPY REQ. DUE TO SITE CONSTRAINTS

HEAD-IN PARKING ADJ. TO STREET SHALL INCORP. MIN. 2' BERM W/ MATURE EVERGREEN SHRUBS

10' WIDE LANDSCAPE BUFFER W/ GROUND COVER. BERM. AND SHRUBBERY 30" HIGH + 1 CANOPY TREE &

1 ACCENT TREE PER 50 LIN. FEET OF FRONTAGE

2 CANOPY TREES, 2 ACCENT TREES REQUIRED

05.02 LANDSCAPE SCREENING REQ. HEADLIGHT SCREENING

ALONG ENTIRE PARKING AREAS PROVIDED SCREENING HOLLY SHRUBS PLANTED ALONG PARKING SPACES

05.03 LANDSCAPE REQUIREMENTS - COMMERCIAL (C) DISTRICT

TOTAL SITE AREA: LANDSCAPE AREA REQUIRED TOTAL SITE:

LANDSCAPE PROVIDED, TOTAL SITE:

LOCATION OF LANDSCAPING:

MIN. SIZE OF AREAS

DETENTION BASINS

PARKING LOT LANDSCAPING

PROPOSED PARKING AREA: REQ. PARKING LOT LANDSCAPING: PROPOSED PARKING LOT LANDSCAPING;

±35,301 SF ±7,060 SF (20%) ±10,769 SF (30%)

MIN. 50% OF REQ. LANDSCAPING SHALL BE LOCATED IN THE FRONT OF & ALONG THE SIDE OF BUILDINGS W/ STREET FRONTAGE.

ALL REQ. LANDSCAPING SHALL BE NO LESS THAN 5' WIDE AND A MIN. OF 25 SF IN AREA

NONE PROPOSED

MIN. 5% OR 200 SF OF LANDSCAPING, WHICHEVER IS GREATER, IN THE INTERIOR OF THE PARKING LOT AREA. ±11,824 SF

±750 SF (6.3%) REQ. PARKING SPACES MUST BE WITHIN 80' OF A CANOPY TREE TRUNK

IRRIGATION CONCEPT

 AN AUTOMATIC IRRIGATION SYSTEM SHALL BE INSTALLED AND OPERATIONAL BY THE TIME OF FINAL INSPECTION. THE ENTIRE IRRIGATION SYSTEM SHALL BE INSTALLED BY A LICENSED AND QUALIFIED IRRIGATION CONTRACTOR.

±591 SF

- 2. THE IRRIGATION SYSTEM WILL OPERATE ON POTABLE WATER, AND THE SYSTEM WILL HAVE APPROPRIATE BACKFLOW PREVENTION DEVICES INSTALLED TO PREVENT CONTAMINATION OF THE POTABLE SOURCE.
- 3. ALL NON-TURF PLANTED AREAS SHALL BE DRIP IRRIGATED. SODDED AND SEEDED AREAS SHALL BE IRRIGATED WITH SPRAY OR ROTOR HEADS AT 100% HEAD-TO-HEAD COVERAGE.
- 4. ALL PLANTS SHARING SIMILAR HYDROZONE CHARACTERISTICS SHALL BE PLACED ON A VALVE DEDICATED TO PROVIDE THE NECESSARY WATER REQUIREMENTS SPECIFIC TO THAT
- 5. THE IRRIGATION SYSTEM SHALL BE DESIGNED AND INSTALLED, TO THE MAXIMUM EXTENT POSSIBLE, TO CONSERVE WATER BY USING THE FOLLOWING DEVICES AND SYSTEMS: MATCHED PRECIPITATION RATE TECHNOLOGY ON ROTOR AND SPRAY HEADS (WHEREVER POSSIBLE), RAIN SENSORS, AND MULTI-PROGRAM COMPUTERIZED IRRIGATION CONTROLLERS FEATURING SENSORY INPUT CAPABILITIES.

ROOT BARRIERS

THE CONTRACTOR SHALL INSTALL ROOT BARRIERS NEAR ALL NEWLY-PLANTED TREES THAT ARE LOCATED WITHIN FIVE (5) FEET OF PAVING OR CURBS. ROOT BARRIERS SHALL BE "CENTURY" OR "DEEP-ROOT" 24" DEEP PANELS (OR EQUAL). BARRIERS SHALL BE LOCATED IMMEDIATELY ADJACENT TO HARDSCAPE. INSTALL PANELS PER MANUFACTURER'S RECOMMENDATIONS. UNDER NO CIRCUMSTANCES SHALL THE CONTRACTOR USE ROOT BARRIERS OF A TYPE THAT COMPLETELY ENCIRCLE THE ROOTBALL.

KENWAY HILL ADDITION BLOCK A, LOT 1, 0.8161 ACRES

MULCHES

AFTER ALL PLANTING IS COMPLETE, CONTRACTOR SHALL INSTALL 3" THICK LAYER OF 1-1/2" SHREDDED WOOD MULCH, NATURAL (UNDYED), IN ALL PLANTING AREAS (EXCEPT FOR TURF AND SEEDED AREAS). CONTRACTOR SHALL SUBMIT SAMPLES OF ALL MULCHES TO LANDSCAPE ARCHITECT AND OWNER FOR APPROVAL PRIOR TO CONSTRUCTION. ABSOLUTELY NO EXPOSED GROUND SHALL BE LEFT SHOWING ANYWHERE ON THE PROJECT AFTER MULCH HAS BEEN INSTALLED (SUBJECT TO THE CONDITIONS AND REQUIREMENTS OF THE "GENERAL GRADING AND PLANTING NOTES" AND SPECIFICATIONS)

SITE PLAN SIGNATURE BLOCK

APPROVED:

POWER POLE

I hereby certify that the above and foregoing site plan for a development in the City of Rockwall, Texas, was approved by the Planning & Zoning Commission of the City of Rockwall on the 11 day of May, 2021

WITNESS OUR HANDS, this _ M _ day of May, 2021

Plathing & Zoning Commission, Chairman Director of Planning and Zoning

EVERGREEN (800) 680-6630 15455 Dallas Pkwy., Ste 600 Addison, TX 75001

www.EvergreenDesignGroup.com



05/11/2021

0 Ø O 0 Rota **3** Street 75086


CKW Goliad Wall, TX 7

Landscape Planting Plan

Date	Comment

Project Number SP2021-013 05/05/2021

Drawn By Checked By DB/RM

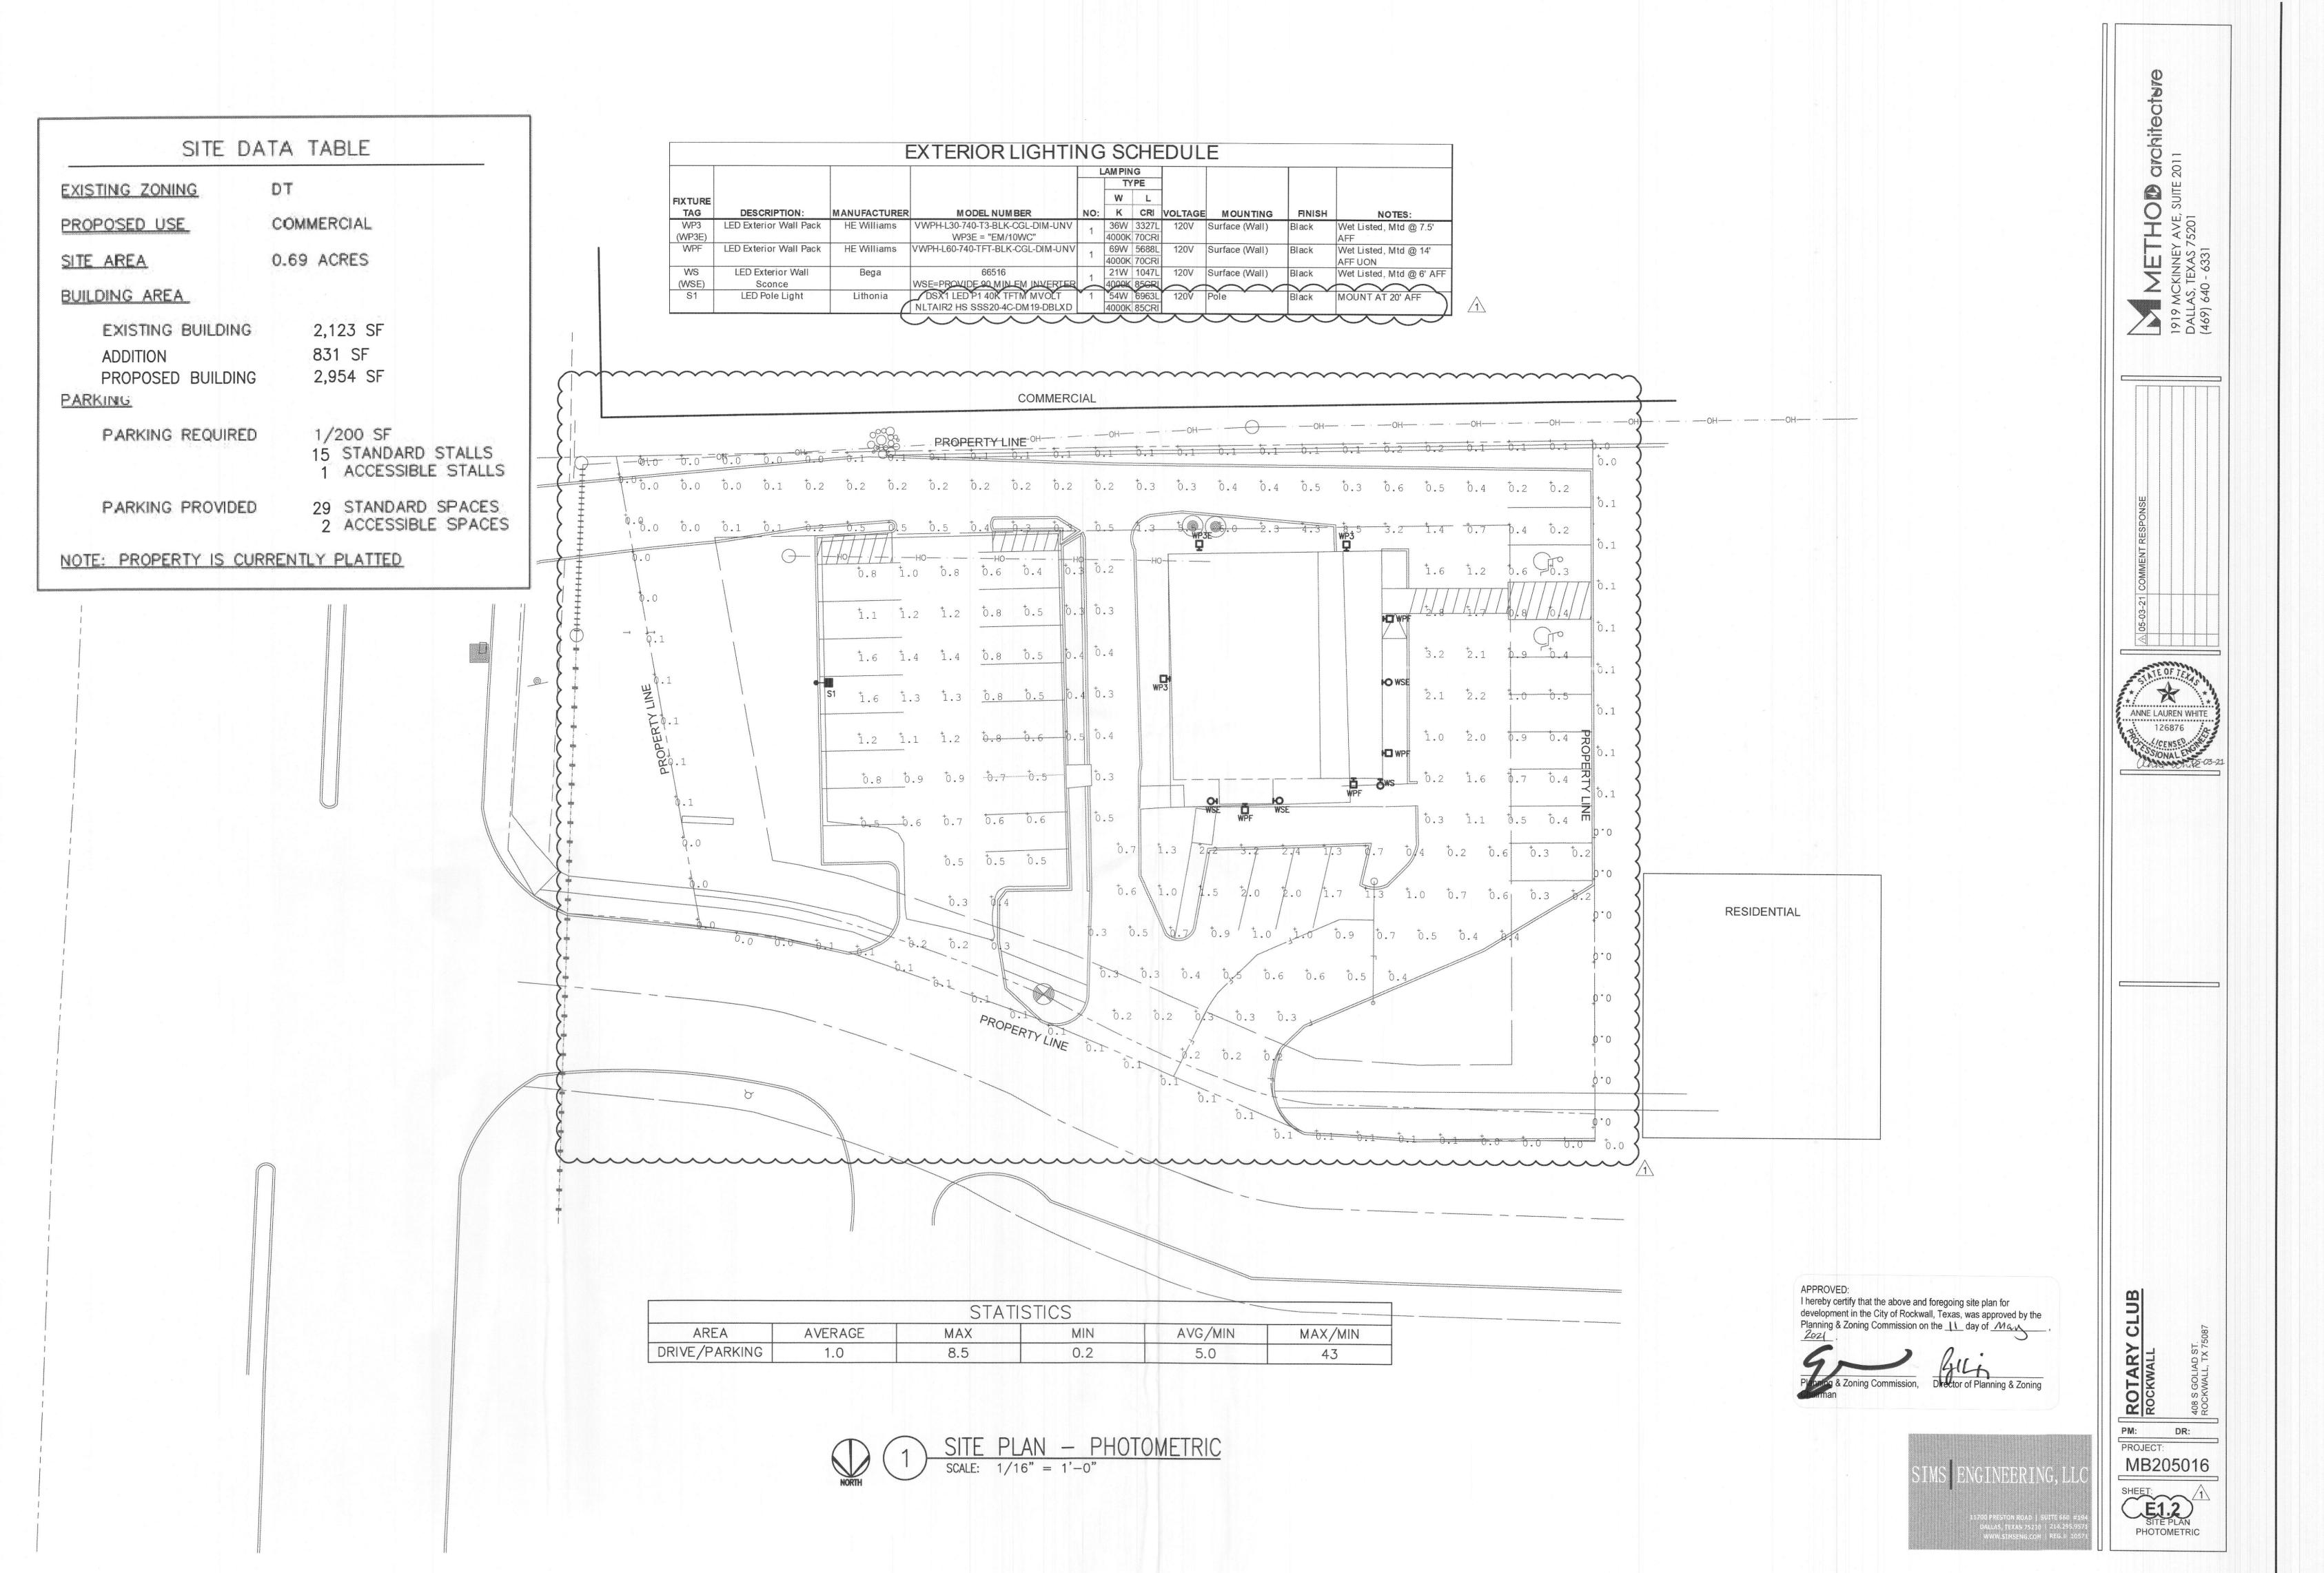

N C THIS FOR LIFE #95E



using extension when specified with conduit ture depth. Conduit entry provided with 1/2° hread and plug, increases fixture height.


icludes housing extension increases fixture ily; not available with CR and CD options. See DETAILS.


e supplied by others. Left and right when

xtension (increases fixture depth), must age 3 for OCCUPANCY SENSOR DETAILS.

tool must be ordered separately. Please senated ner reniers

viewed from behind fixture. viewed from behind fixture.

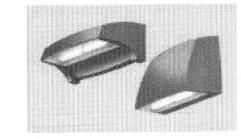

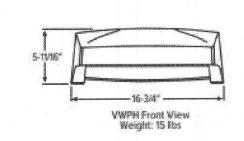



FEATURES

- Designed to illuminate sidewaks, entryways, perimeters or lacades Intended for use in both uplight and
- downight applications Savings of up to 80% energy compared to HID systems
- Blends seamlessly with a variety of architectural styles Made Right Here® in the USA

SPECIFICATIONS

- HOUSING Die-cast aluminum enclosure. THERMAL MANAGEMENT - Integral die-cast aluminum heatsink and LED assembly provide passive thermal management. Rated -30°C to 40°C ambient operating temperature (-20°C to 40°C with EM/10WC; 0°C to 39°C with
- OPTICAL SYSTEM Precision, injectionmolded, refractive acrylic lensing
- produces standard IES distributions. LED ASSEMBLY - ANSI 3000K, 4000K, or 5000K CCT, minimum 70 CRI LEDs.
- LED DRIVER 0-10V dimming. ELECTRICAL -- 120-277, 347, and 480 VAC input range; 50-60Hz; power factor > 90; THD < 20% at full load. FCC Class A compliant, 10kA/10kV surge protection
- standard. Quick-disconnect wiring provided. £70 >50,000 hours per lES TM-21. FINISH - Super durable polyester powder cost bonded to phosphate-free, multi-stage pretreated metal, meets and exceeds AAMA 2504 specifications for
- outdoor durability. MOUNTING - Surface mounts directly over a 4" maximum outlet box. Must be anchored to adequate structure that can
- safely support fixture weight (VWPH = 15 lbs., VWPV = 23 lbs). · LISTINGS --
- cCSAus certified as luminaire suitable for

- DesignLights Consortium qualified

ORDERING EXAMPLE: VWP H + L30/740 + T3 + DBZ + SDGL + OPTIONS + DIM - UNV

ORDERING INFO

LUMENS (1) CRI CCT DISTRIBUTION (2) SERIES TYPE VWP H Horizontal L30 3,000km 7 70 30 3000K T3 Type III V Vertical L60 6,000km 40 4000K TFT Type forward throw **50** 5000K

FINISH OPTIONS (3) SHIELDING SDGL Micro-prismatic tempered glass lens BLK Black (RAL #9004) CGL Clear tempered glass lens DBZ Dark bronze DBR Medium bronze

GRAY Standard gray SLV Satin aluminum (RAL #9006) WHT White (RAL #9003)


CONTROL OPTIONS DIM Dimming driver prewired for 120 120V 208 208V EM/4W 4-watt integral emergency LED driver [4] 208 208 V **SF** Single fuse [5] 240 240V Double fuse [6] Factory-installed button-style photocell [7] 277 277W HSGX Empty housing extension used to match units with EM, OCC, or conduit entry options. UNV 120-277V 347 347V (14) 480 480VIII Tamper-resistant Tork head screws [8]


CONDUIT ENTRY (8) CR Right side conduit entry [19] CL Left side conduit entry [54] CD Dual conduit entry

VWPH ONLY EM/10WC 10-walt emergency LED driver [12] OCCWS FSP-311-L_Factory-installed occupancy sensor [19]


TPTX-25 TOOL Tamper-resistant tool for Torx head screws. [96]


					CLEAR GLA	SS(CGL)	SCRUTE GLAS												
	LED PACKAGE	DISTRIBUTION	WATTAGE	CET	DELIVERED LUMENS	EFFICACYIIm/W	DELIVERED LUMBNS	EFFSCACY(Int/M)	BUG RATING										
				3000	3174	88.2	2953	82.3											
		T3	1 1	4000	3327	92.4	3106	86.3	81-00-61										
		10	_	5000	3438	95.5	3209	89.1											
	L30	230 26 3000 2715 75.4 2	2533	70.4															
		TET		4000	2844	79.0	2855	73.8	81-00-61										
HOMA				5000	2939	81.6	2743	75.2											
8				3000	5933	84.8	5897	84.1											
		T3		4000	6631	94.4	61772	88.2	81-00-61										
				5000	5821	97.6	6376	91.1											
	1.60		70	3000	5470	78.1	5065	72.4	2 1 2 2 2										
		TET	TET	TFT	TET		4000	5688	813	5309	75.8	B2-00-61							
				5000	5876	83.9	5486	78.4											
				400			400							3000	385	86.5	2908	80.8	
		13		4000	3403	94.5	3177	88.3	81-00-61										
	1.22			5000	3385	94.0	3160	87.8											
	1.30		35	3000	2840	78.9	2651	73.6											
		TFT		4000	3103	86.2	2896	80.4	82-00-61										
2				5000	3086	85.7	2881	80.0											
Ì				3000	6171	88.2	5813	83.0	ATTENDED										
		13		4000	6804	97.2	6351	90.7	82-00-G2										
	160		70	5000	6767	96.7	6317	90.2											
	1.00		1 10	3000	5822	83.2	5176	73.2											
		TET		4000	5999	85.7	5600	90.0	B3-U0-G1										
				5000	5967	85.2	5570	79.6											

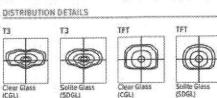


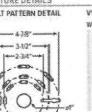




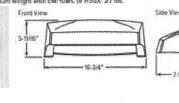

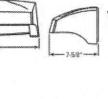

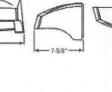

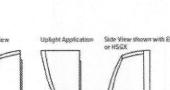

Wall luminaire - two-sided narrow beam light distribution

Application LCD wall mounted luminaire with light emission on two sides. The narrow beam light distribution of the luminaire is identical in both directions. Arranged individually or in groups, they are great design elements for a host of lighting applications.

Materials Luminaire housing and faceplates constructed of extruded and die-cast marine grade, copper free (<0.3% copper content) A360.0 aluminum alloy Clear safety glass Reflectors made of pure anodized aluminum High temperature silicone gaskets

Mechanically captive stainless steel fasteners Stainless steel helicoils NRTL listed to North American Standards, suitable for wet locations Protection class IP 65

Weight: 7.5lbs Electrical 120-277V AC Operating voltage -40°C 15.8W Minimum start temperature LED module wattage 21.0W System wattage 0-10V dimmable Controllability Color rendering index Ra > 80 1,047 lumens (3000K) Luminaire lumens LED service life (L70) LED color temperature

☐ 4000K - Product number + K4 3500K - Product number + K35 3000K - Product number + K3 2700K - Product number + K27 ☐ Amber - Product number + AMB Wildlife friendly amber LED - Optional


6 - Beam angle

Luminaire is optionally available with a narrow bandwidth, amber LED source (585-600nm) approved by the FWC. This light output is suggested for use within close proximity to sea turtle nesting and hatching habitats. Electrical and control information may vary from standard luminaire. 18.0W (Amber) LED module wattage

22.5 W (Amber) System wattage 384 lumens (Amber) Luminaire lumens BEGA can supply you with suitable LED replacement modules for up to 20 years after the purchase of LED luminaires - see website for details

All BEGA standard finishes are matte, textured polyester powder coat with minimum 3 mil thickness... Available colors D Black (RLK) D White (WHT) D BALL

☐ Bronze (BRZ) ☐ Silver (SLV) ☐ CUS:

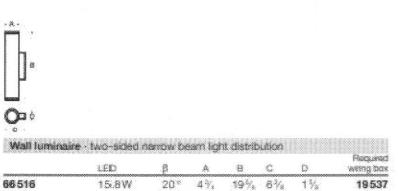


BEGA

Available Accessories ☐ 79547 Surface mounted wiring box See individual accessory spec sheet for details.

BEGA Product:

Project:

Modified:

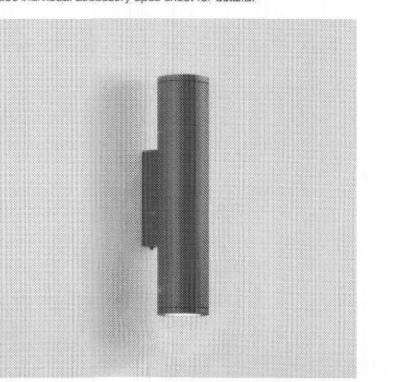

D-Series Size 1 LED Area Luminaire DLG DLG 🙃 🛜

Width: Height H1: Height H2: Weight (max):

Introduction

The modern styling of the D-Series is striking

yet unobtrusive - making a bold, progressive statement even as it blends seamlessly with its environment. The D-Series distills the benefits of the latest in LED technology into a high performance, high efficacy, long-life luminaire. The outstanding photometric performance results in sites with excellent uniformity, greater pole spacing and lower power density. It is ideal for replacing up to 750W metal halide in pedestrian and area lighting applications with typical energy savings of 65% and expected service life of over 100,000 hours.

DSKT LED	Forward optics P1 P4' P7' P2 P5' P8 P3 P6' P9' Rotated optics P10' P12' P11' P13'4	308 X00 K 408 400 K 508 X00 K	TIS Type I short (Automotive) T2S Type II short T2M Type II short T2M Type III short T3M Type III short T3M Type III short T3M Type III short T4M Type IV medium	TSVS Spe V very sheet * TSS Spe V very sheet * TSM Spe V very sheet * TSW Spe V very sheet	MVOLT ⁴ XVOLT (2777-480V) ^{4,73} 120 ³ 208 ³ 240 ³ 277 ⁴ 347 ³	RPA Bound WBA Whithe SPUMBA Square	pole mounting ¹⁶ pole mounting ¹⁶ pole universal mounting adaptor ¹⁷
PIRHN No			PIR High/low, m ambient see	otion/an intent sensor, 8-15' mounting to ser enabled at Sic ²⁰⁰ of Sic Amburning office familiaring sensor, 15-30' mounting see enabled at Sic ²⁰⁰	egist, Shippedii HS Has heigist, SF Sin	(specify	Int moverling bracket adapter y friesb) 10 DDBXD Dark bionus DBLXD Black DNAXO Natural algorithms DWHXD White

PER7 Seeso-pin receptacle unity (controls archered separates) **** PIRHTFGW 8s-level, monitors/ambient servag 15-30 mounting beside. 890 Right not ared uptics * DBLEXD lextures black

	man arr mrig marro	gurations not i	encement caeries.							d the circley.																						
	11.73																															
				Tis	6.457	1 2			128	6.5%																						
				135	6,450	1 2		ź	119	6,949	1 2		1	129	7,0-4 7,0-7	12	1 6	H														
				TIN	6.483 6.279				128	6,984 6,784	+2		1	129 125	7,011 4,8:0	2		1														
				TM	6,468				108	6,967 8,816	17		1	129	7,016	III		12														
30	538	Pi	54W	TETM	6,464			Ź	128	6,963	li		1	126	8,992 7,851			11														
				1515	6.722 6.728				24	7.240 7.248	+		-	134	73.4			1-1-														
				TSW	6,711	3		1	124 123	7,229 7,182	H		1	134	7,3,1			12														
				844	5,299			-1	98	5,789			2	133 106	1,2:1 5,781	H																
				0000 0000	1,943	-		1	73	Q8 Q8	++	8	2	79	4,302	1-1-	-	H														
				<u>T35</u>	8,249	1 2	-		111	8,886 8,877	1		2	127	8,989	1-1	-															
				TZN	1,20	2		2	118	8,923	12	0		127	9,0%	12																
				T3S T3M	8,021 8,263	2		1	115	8,641 8,961	12		2	123 127	8,723 9,014	1-2		Hż														
1.0				TAM	8,083 8,257	1 2		2	115	£.786 £.8%	1 2	-	1	124	8.818	2 2	0	1														
30	700	P2	7084	1536 155	8,588	H		0	123	9,252	13		ļ.	132	9,369		0	1														
		000000000		133	8,395 8,373	<u>li</u>		Ż	120	9,259 9,236				132	9,376 9,313	1		1														
	-			TSW	\$517 \$770	1		1	97	9,173 7,281	-			131	12 ⁹ 1 7,386	4		2														
	***************************************			14(0		1		2	72	- G				78	3.4%																	
		***************************************		711	11,661	12		- 2	114	12,562				78	5,4% 12,701																	
				128	11,648	13		1	114	12,548	1-1			123	12,771	1																
		\$\$0. ₽3			10.510000	TIS	11.338	2		- 2	111	12,2%	13			128	12,376															
				T3M T4M	11,680	2	0	3	115	12,582	2 2		2	123	12,742	1 2	-	1 1														
30	1450		P3	P3	P3	P3	P3	P3	P3	P2	P3	P3	P3	P3	P3	102W	102W	TETM	11,673	3		2	114	12,575	1		-	123	12,84			
				355	12,150	- 3			119	13,089	13			128	13,264			III														
				TSM TSM	12,119	4	0	2	118	12,978				128	13,321	H	+	1 1														
				<u>BLC</u>	9.570 7.321	1	0	3	94 70	0.310 7,671	++-	H	2	181 75	10,440 7,746																	
***************************************				#(0)	7,121	1	0	3	70	7,871				75	7,718																	
	***************************************			715 125	13,435	1 3	0	3	107	94473 94488				116 116	14,667	1 3																
	-			T2M T35	13,490	3	0	3	188	94,532 14,074	1			116	14,716	1	- 8															
				Tak Tak	11,457	2 2	0	1	108	14,497	1 2	0	<u> </u>	116	14.81	1 2		I 2														
- 38	1250	P4	125W	IFM	0.440	1.2		1	108	14,182 14,488	12			113	14,852	12																
				1985 155	13.987	3			112	15,068 15,080	13			121	15,259	1	H															
				TSM	13,963	4 4			112	15,042 11,944	14		1	128	15,283	4		12														
				M.	11,827	İ		2	- 88	11,879			1	95	12,029	1 4		1 2														
				RXXD	8,285 8,265	1			66 66	8,839 8,839	1			71	1.81	1																
				785 125	14,679 14,664	3			186	15,814	1 3			115	16,884 15,997																	
				128	14,739	1		3	187	15,878	13		3	135	16,0%																	
				ZET MET	14,784	3	0	1	163	55.377 55.840	3			1115	15,972 16,048		÷															
	7.60.11			TANA	14,384	2	0		104	15,496 15,830	3 3		3	112 115	15,692	1		13														
	1400	P5	13890	DW	15283	4	0	1	111	16,464	4			119	16,698 16,672	4																
				TSM	15,295 15,257	3	0	2	111	16,477 16,485	4	0	2	119 119	16,686 16,644	4	-															
				TSW BLC	15,157 12,048	4	0.0	3	110 87	14,328	4	0		118	16,94	4																
				100	8,965	T	0	3	65	9,657	Ηź	0	1	70	13,143 9,780	-	8	1														

ROCKWALL

ROCKWALL

1408 S GOLIAD ST

ROCKWALL

ROCKWALL

ROCKWALL

ANNE LAUREN WHITE 126876

5 8

O N.

TH(EY AVE, S 75201

(a)

