

BENCHMARK:
PK NAIL IN E OF CARUTH LANE & ALLEY INTER-
SECTION 150'± EAST OF MORNINGSTAR DRIVE.
ELEV. 491.68

BENCHMARK:
"X" CHISELED IN E OF ALLEY EAST OF MORNINGSTAR
DRIVE WITHIN 3RD LOT NORTH OF MIDNIGHT PASS.
ELEV. 513.26


PAVING TANGENT DATA

TANGENT	BEARING	LENGTH
T1	S48°01'00"E	316.61'
T2	S40°16'00"E	381.40'
T3	S25°48'00"E	82.08'

LUMBERMEN'S INVESTMENT CORPORATION



PAVING CURVE DATA

CURVE	DELTA	RADIUS	TANGENT	LENGTH	BEARING	CHORD
C-1	07°45'00"	750.00'	50.80'	101.46'	S44°08'30"E	101.37'
C-2	14°28'00"	500.00'	63.46'	126.24'	S33°02'00"E	125.91'

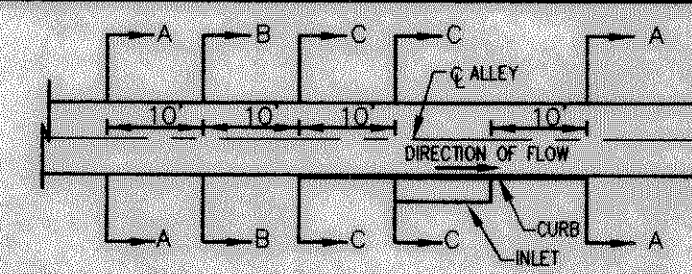


STORM SEWER CURVE DATA

CURVE	RADIUS	DELTA	TANGENT	LENGTH	BEARING	CHORD
CV-1	85.00'	62°37'59"	51.71'	92.92'	S78°02'13"E	86.36'
CV-2	750.00'	06°27'14"	42.28'	84.48'	S43°29'37"E	84.44'
CV-3	55.00'	90°00'00"	55.00'	86.39'	N85°16'00"W	77.78'
CV-4	45.00'	54°50'01"	23.34'	43.07'	N12°50'58"W	41.44'
CV-5	60.00'	90°28'39"	60.50'	94.75'	S04°58'19"W	85.21'

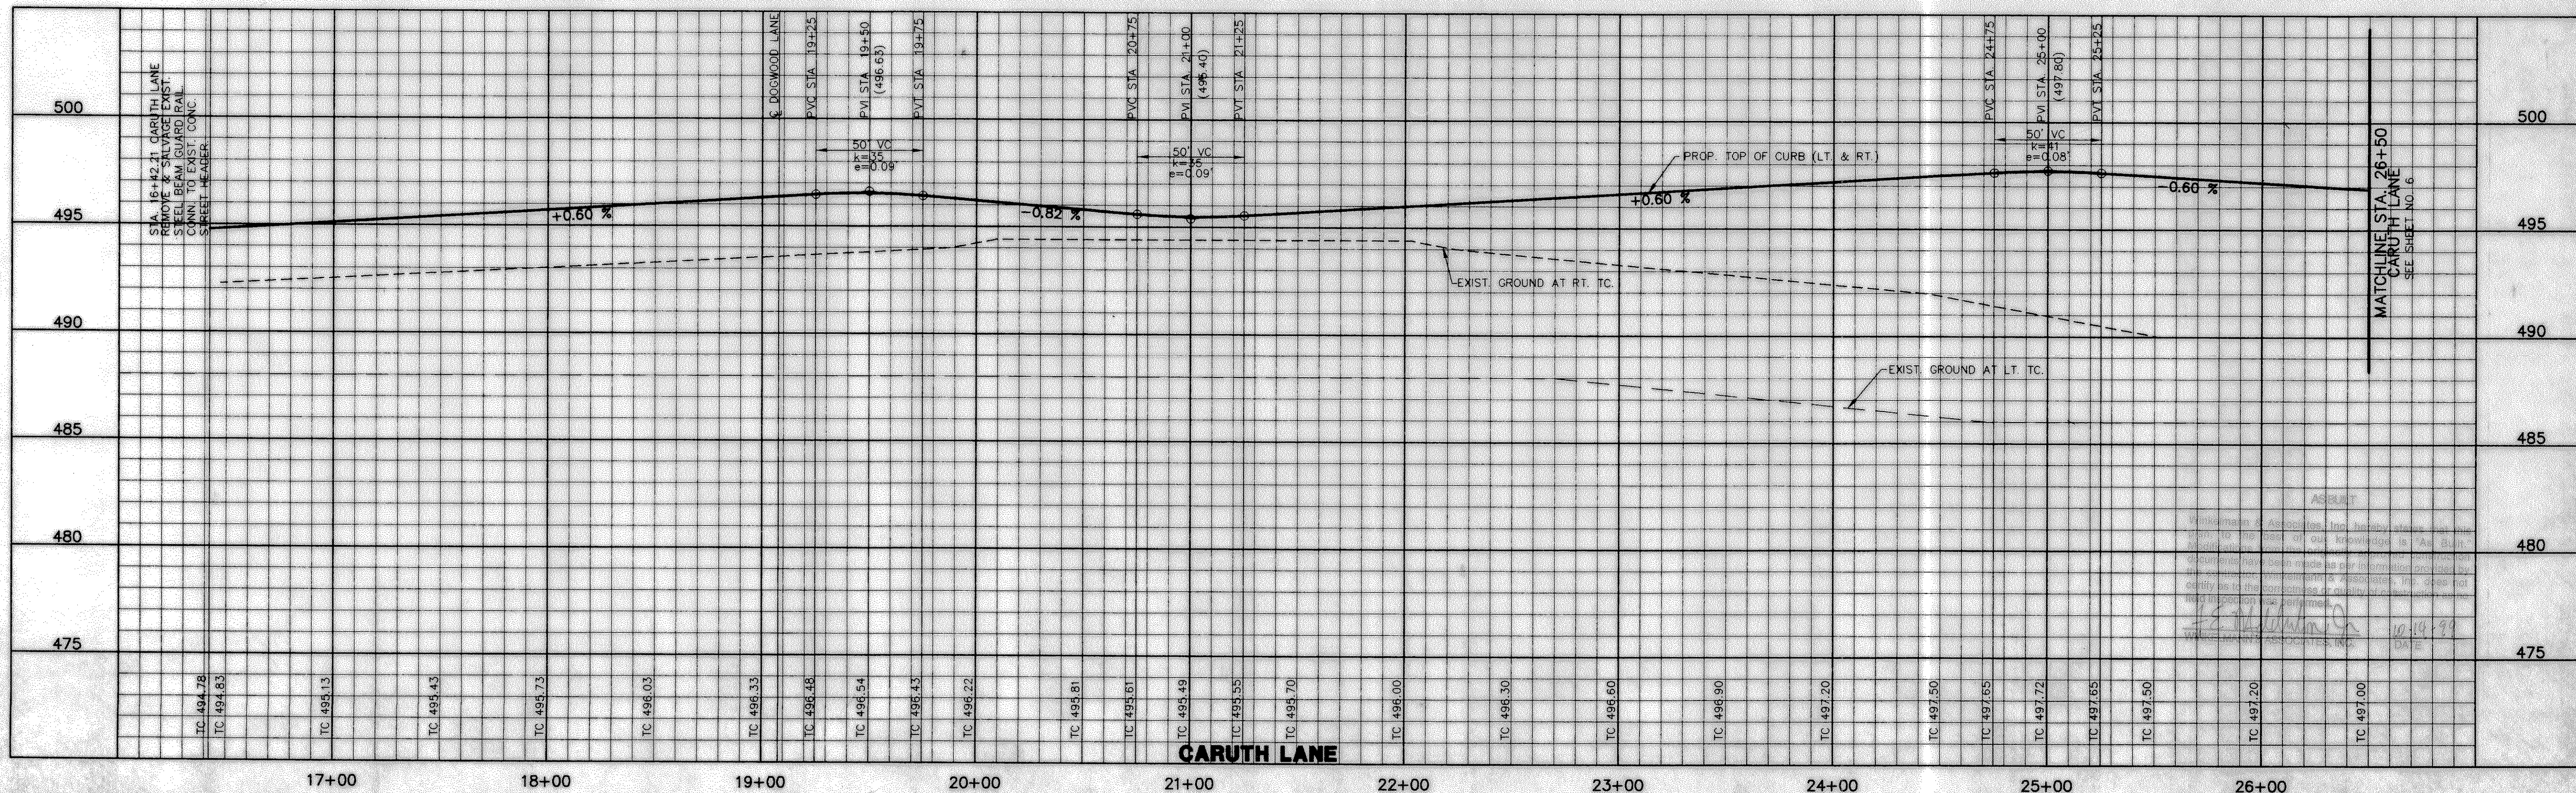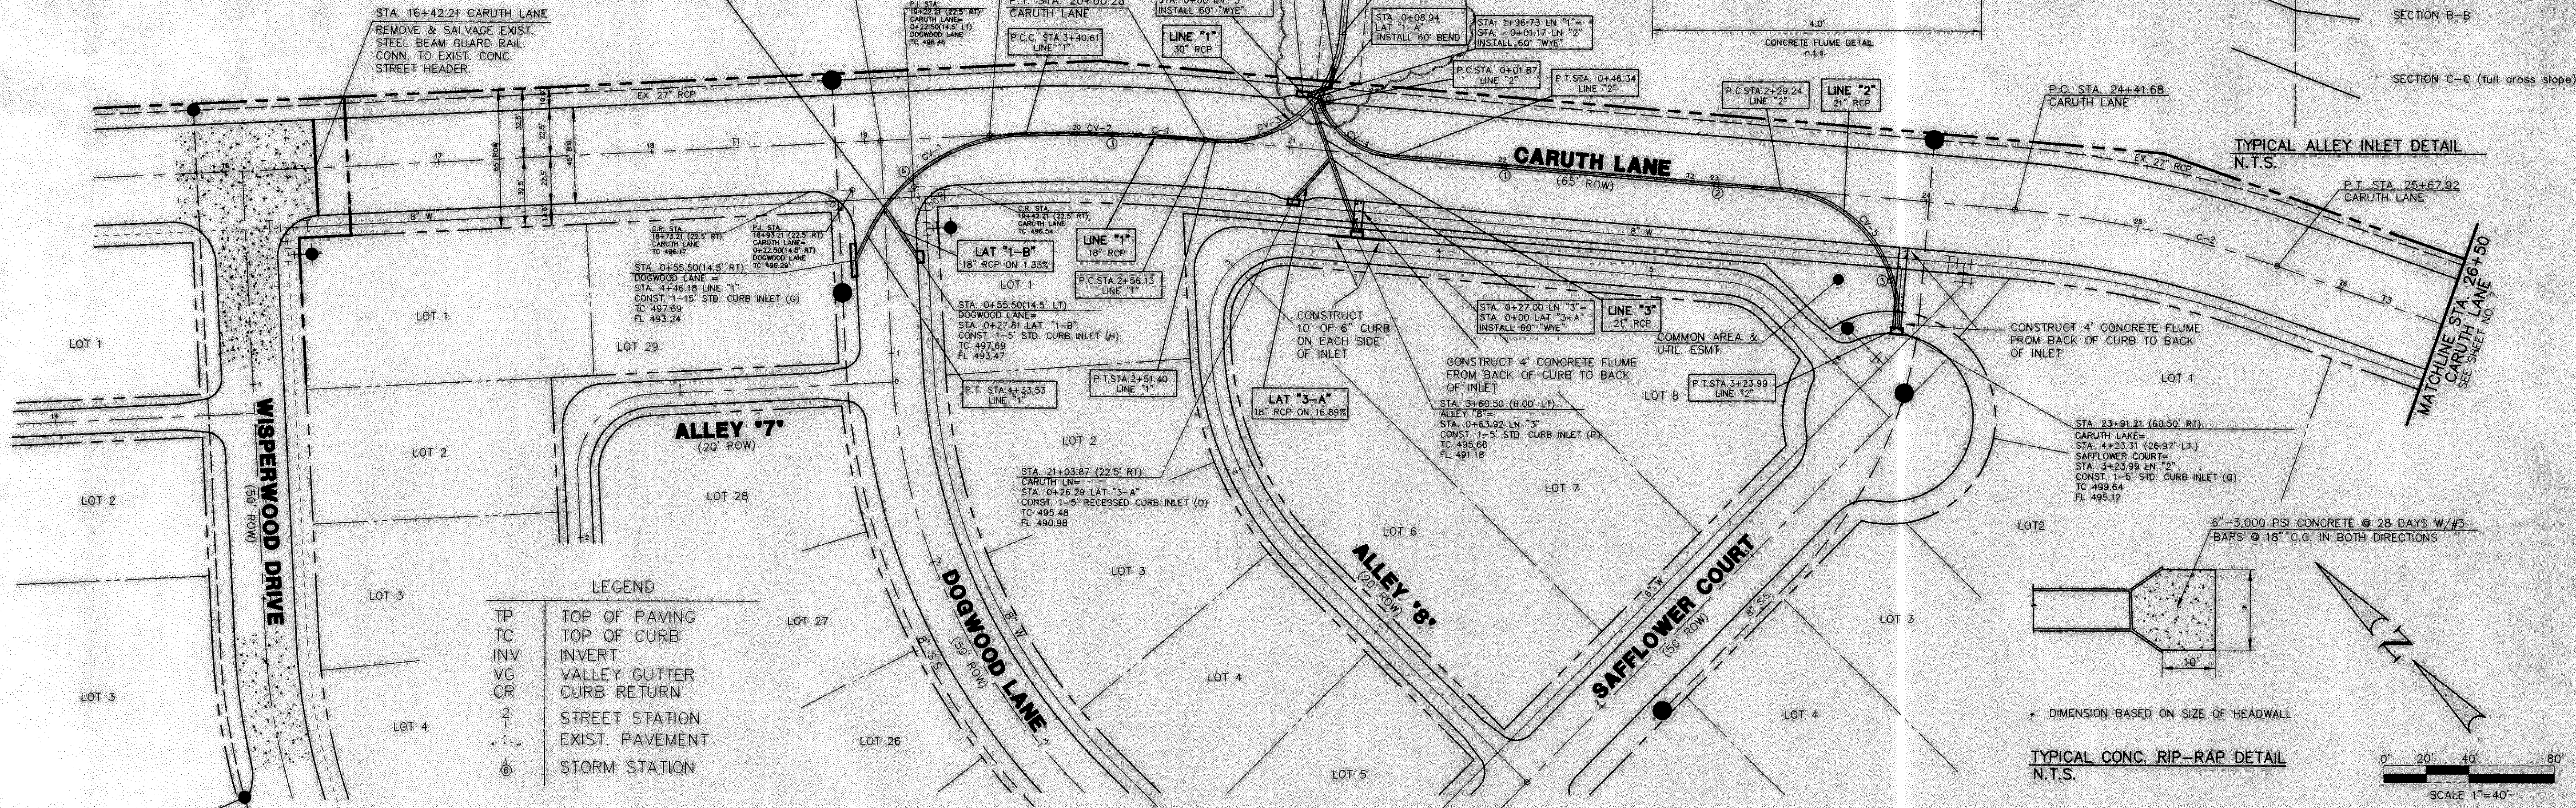

Winkelmann
& Associates, Inc.

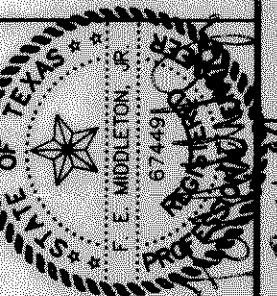

CARUTH LAKE PHASE FIVE
S.S. MCCURRY SURVEY, ABSTRACT NO. 146
M.B. JONES SURVEY, ABSTRACT NO. 122
ROCKWALL COUNTY, TEXAS
LUMBERMEN'S INVESTMENT CORPORATION
5495 BELTLINE ROAD, SUITE 225
DALLAS, TEXAS 75240

PAVING & DRAINAGE PLAN / PAVING PROFILE
CARUTH LAKE STA. 16+42.21 TO STA. 26+50

Scale: 1"=40' Date: 5/28/98
Designed By: RB / KG
Drawn By: MK / KG
Checked By: F.E.M.
File: 14633P32.DWG
Project No.: 14633 01