SCREENING LEGEND

- STONE COLUMN
- ORNAMENTAL IRON FENCE
- STONE WALL
- HIKE/BIKE TRAIL

30 15 0 30 60

1" =30' - 0"

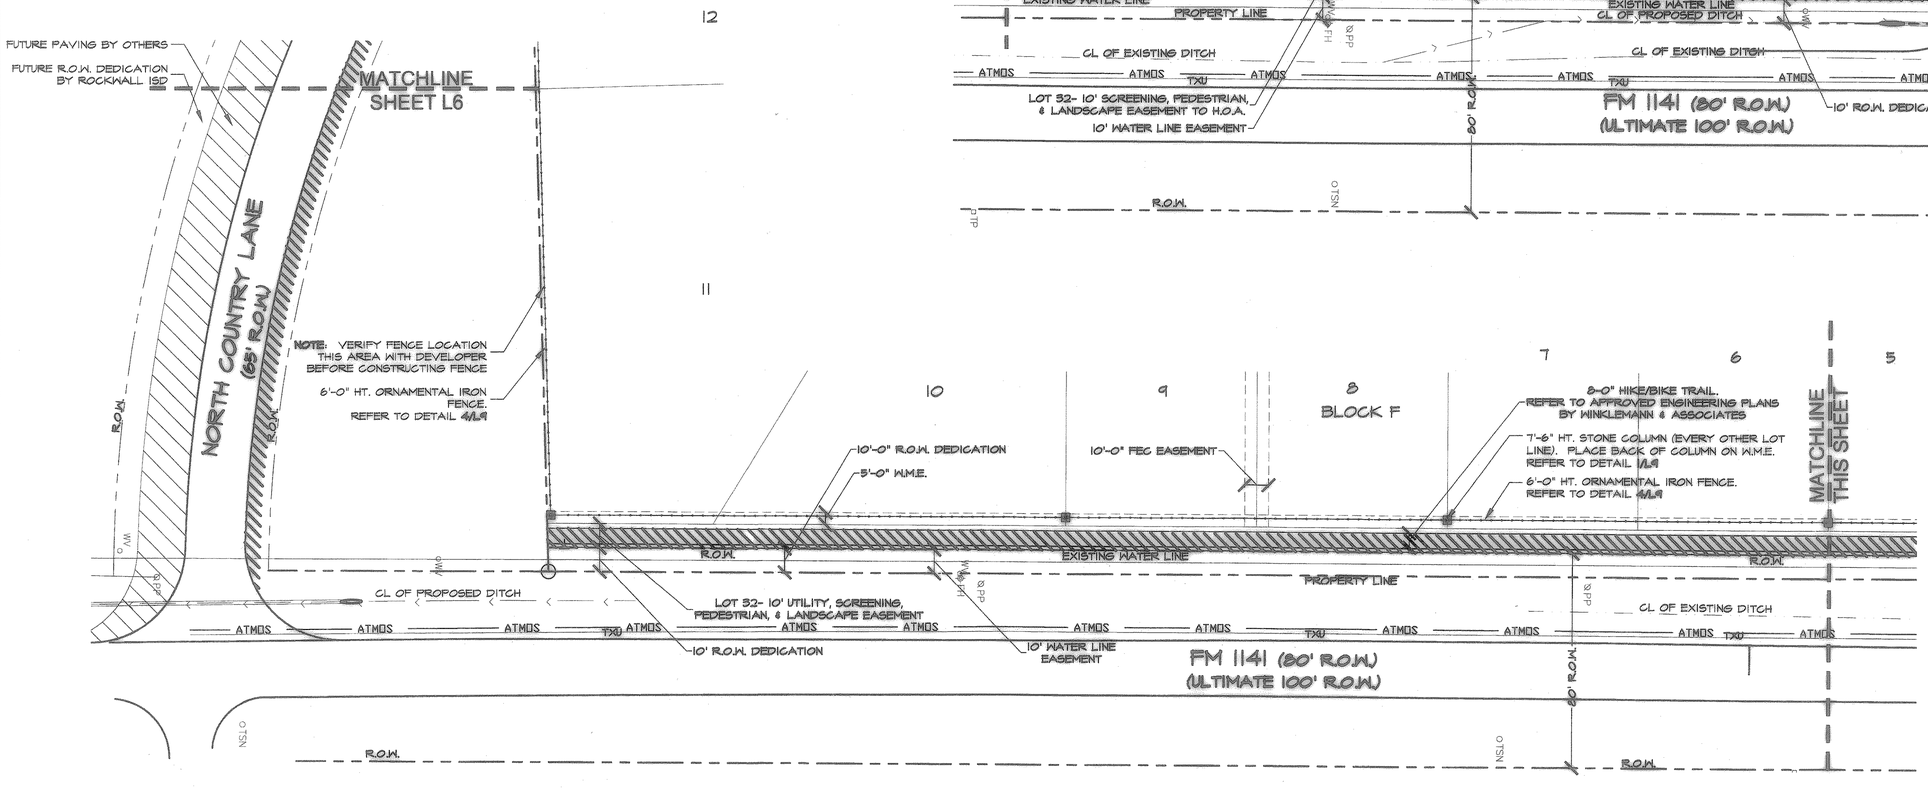

NOTE:
NO PORTION OF SIGNAGE OR FOUNDATIONS SHALL BE IN UTILITY EASEMENTS

RECORD DOCUMENTS

THESE RECORD DOCUMENTS HAVE BEEN PREPARED BASED ON INFORMATION PROVIDED BY OTHERS. JONES & BOYD, INC., HAS NOT VERIFIED THE ACCURACY AND/OR COMPLETENESS OF THIS INFORMATION, UNLESS OTHERWISE NOTED ON THESE DOCUMENTS. JONES & BOYD, INC., SHALL NOT BE RESPONSIBLE FOR ANY ERRORS OR OMISSIONS THAT MAY BE INCORPORATED AS A RESULT OF ERRONEOUS INFORMATION PROVIDED BY OTHERS.

JONES & BOYD, INC.

BY: [signature]

DATE: 10.18.2007

NO.	REVISIONS DURING CONSTRUCTION	BY	DATE

NO.	REVISIONS DURING PLAN REVIEW	BY	DATE
5	CITY COMMENTS	TLM	4/26/07
4	CITY COMMENTS	TLM	4/16/07
3	REVISED SCREENING LAYOUT	TLM	4/10/07
2	CITY COMMENTS	TLM	9/6/06
1	CITY COMMENTS	TLM	8/18/06

REGISTERED LANDSCAPE ARCHITECT — JAMES B. BOYD — 1415 — STATE OF TEXAS — 5/2/07

Jones & Boyd, Inc.
17090 Dallas Parkway, Suite 200
Dallas, Texas 75248
972.248.7676 office
972.248.1414 fax
www.jones-boyd.com

- Engineering
- Surveying
- Planning
- Landscape Architecture
- Construction Management

SCREENING/LANDSCAPE PLAN

Screening Plan– FM 1141

Dalton Ranch

City of Rockwall, Rockwall County, Texas

PROJECT NO. HOE048

SHEET NO. L4

Drawing: H:\Projects\HOE048\dwg\Landscape\HOE048-LS.dwg Saved By: tmiller Save Time: 4/25/2007 4:12 PM

Plotted by: tmiller Plot Date: 5/7/2007 11:06 AM