DIMCONT2

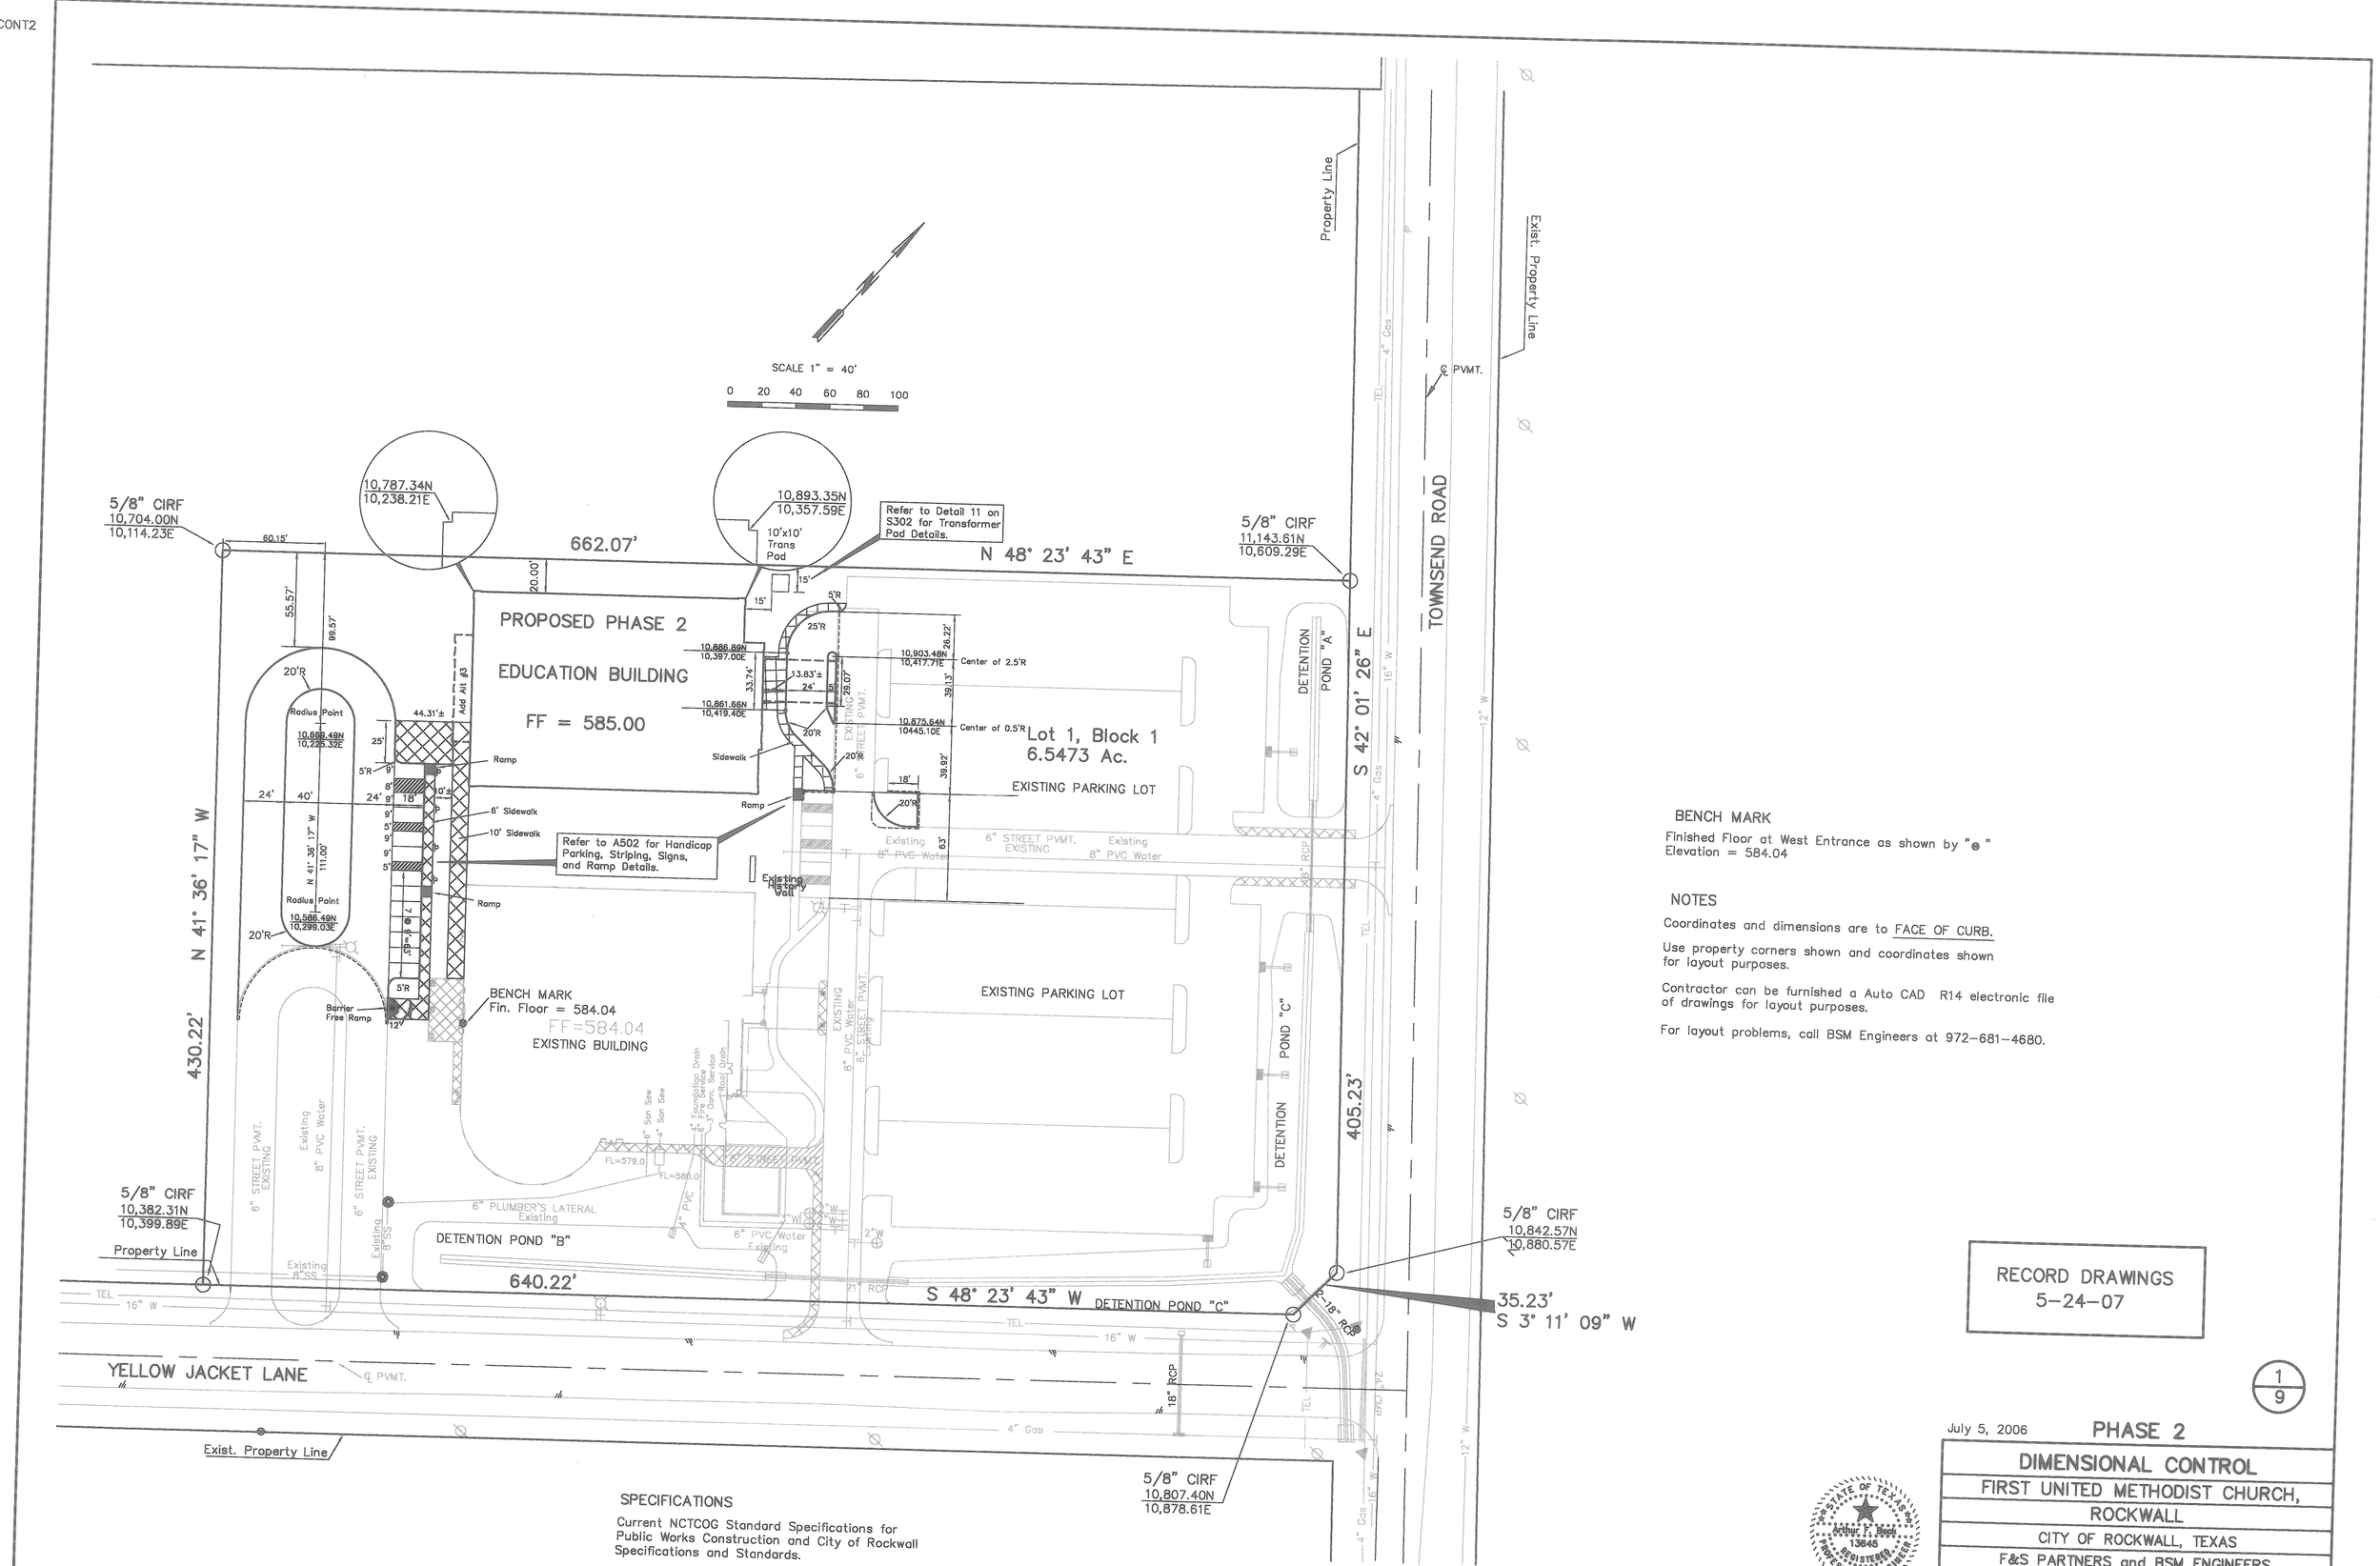

BENCH MARK

Finished Floor at West Entrance as shown by "⊗"
Elevation = 584.04

NOTES

Coordinates and dimensions are to FACE OF CURB.

Use property corners shown and coordinates shown for layout purposes.

Contractor can be furnished a Auto CAD R14 electronic file of drawings for layout purposes.

For layout problems, call BSM Engineers at 972-681-4680.

SPECIFICATIONS

Current NCTCOG Standard Specifications for Public Works Construction and City of Rockwall Specifications and Standards.

RECORD DRAWINGS
5-24-07

1/9

July 5, 2006 PHASE 2

DIMENSIONAL CONTROL						
FIRST UNITED METHODIST CHURCH,						
ROCKWALL						
CITY OF ROCKWALL, TEXAS						
F&S PARTNERS and BSM ENGINEERS						
DESIGN	DRAWN	DATE	SCALE	NOTES	FILE	NO
F&S	BSM	4-06		BSM		552