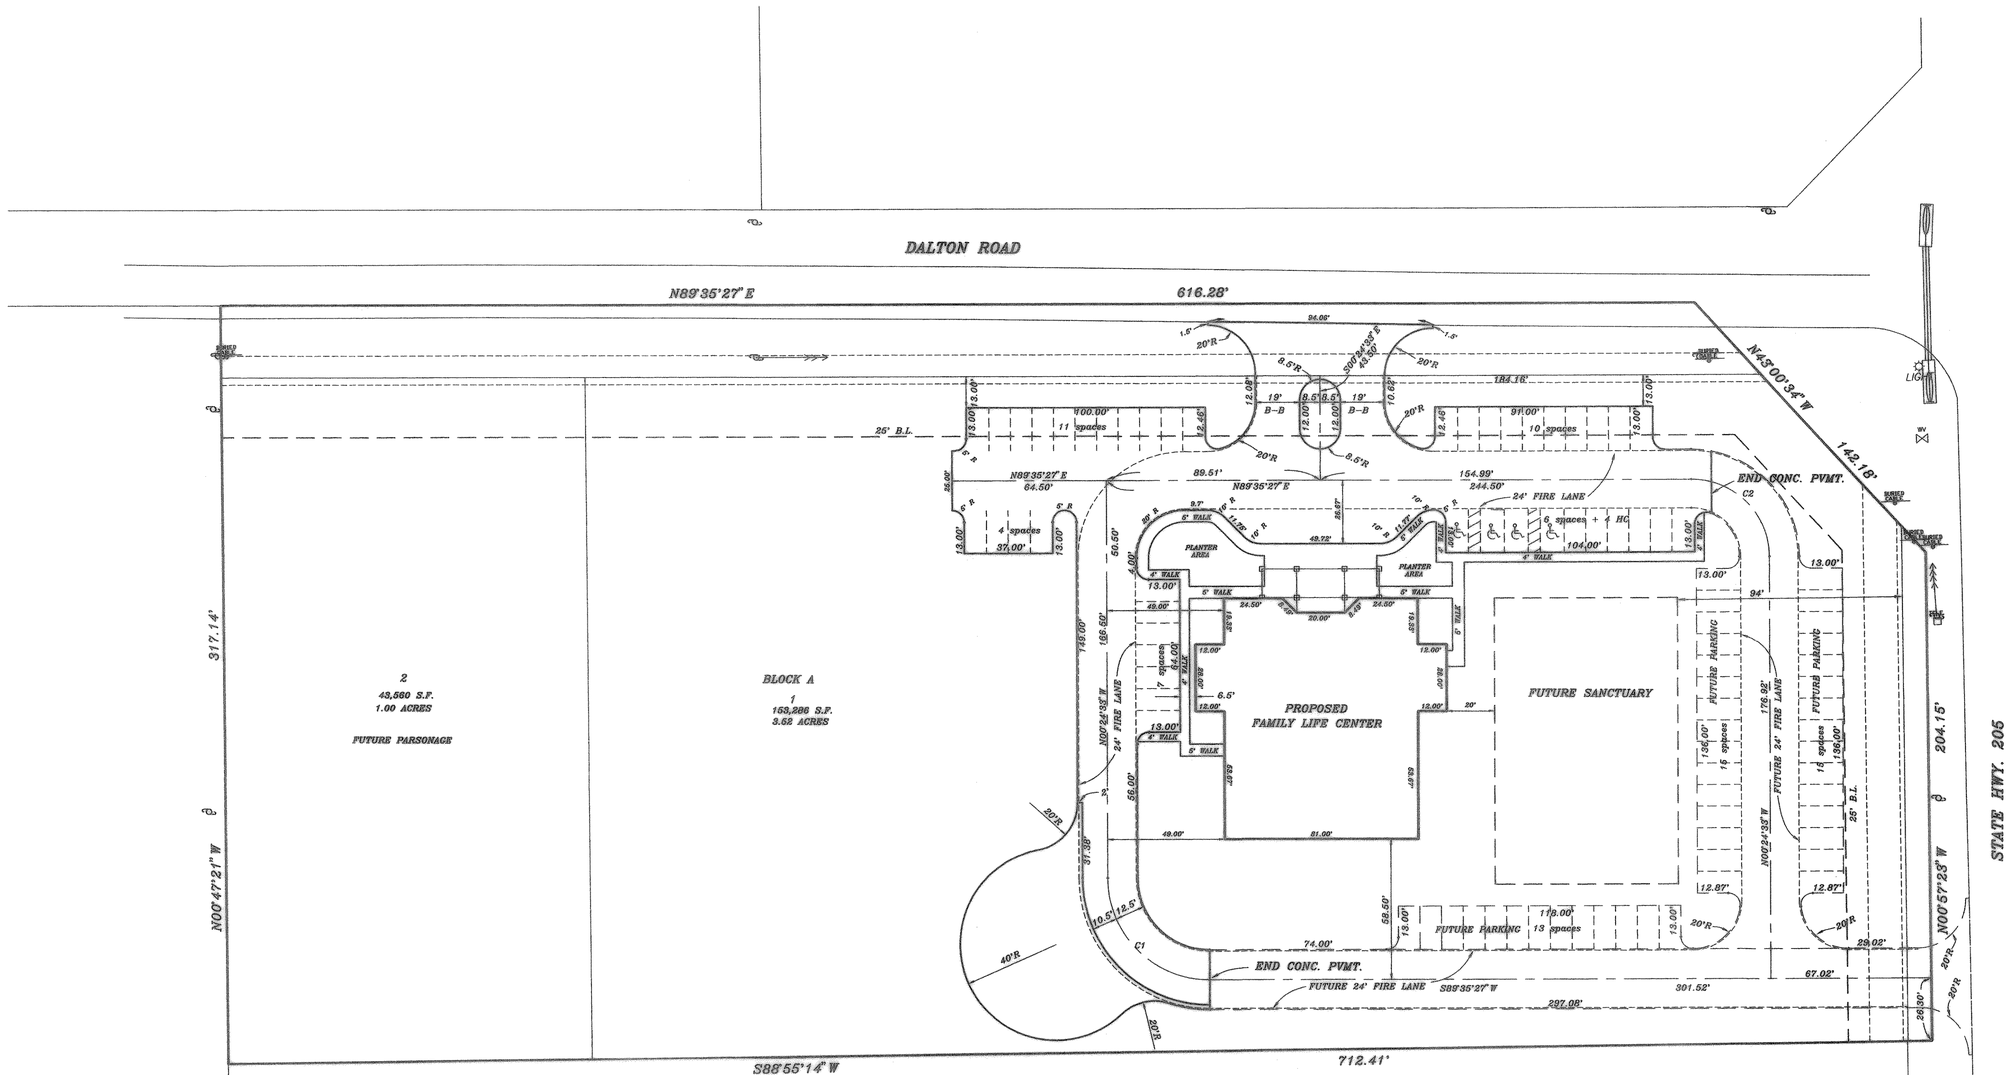

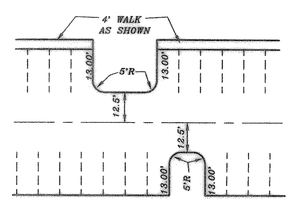

TYPICAL PARKING DIMENSIONS
ALL RADII ARE 5' UNLESS OTHERWISE NOTED.
PARKING SPACES ARE 9'X18'
ALL DIMENSIONS ARE TO BACK OF CURB

CURVE	RADIUS	LENGTH	TANGENT	CHORD	BEARING	DELTA
C1	42.50'	66.76'	42.50'	60.10'	S45°24'33" E	90°00'00"
C2	32.50'	51.05'	32.50'	45.96'	N45°24'33" W	90°00'00"

AS BUILT

STATE OF TEXAS
HAROLD L. EVANS
23155
REGISTERED
PROFESSIONAL ENGINEER

REVISION DESCRIPTION	DATE
REV. JMA	8/8/00
REV.	3/3/99
REV. PER CITY REVIEW	12/23/98

9878DIM

HAROLD L. EVANS
CONSULTING ENGINEER
P.O. BOX 28355
2331 GUS THOMASSON ROAD, SUITE 102
DALLAS, TEXAS 75228, (214) 328-8133

DATE	SCALE	DESIGN	DRAWN
11/19/98	1" = 30'	H.L.E.	

DIMENSION CONTROL
THE FREE METHODIST CHURCH OF NORTH AMERICA ADDITION
CITY OF ROCKWALL

SHEET NO. 3 / 5

JOB NO. 9878