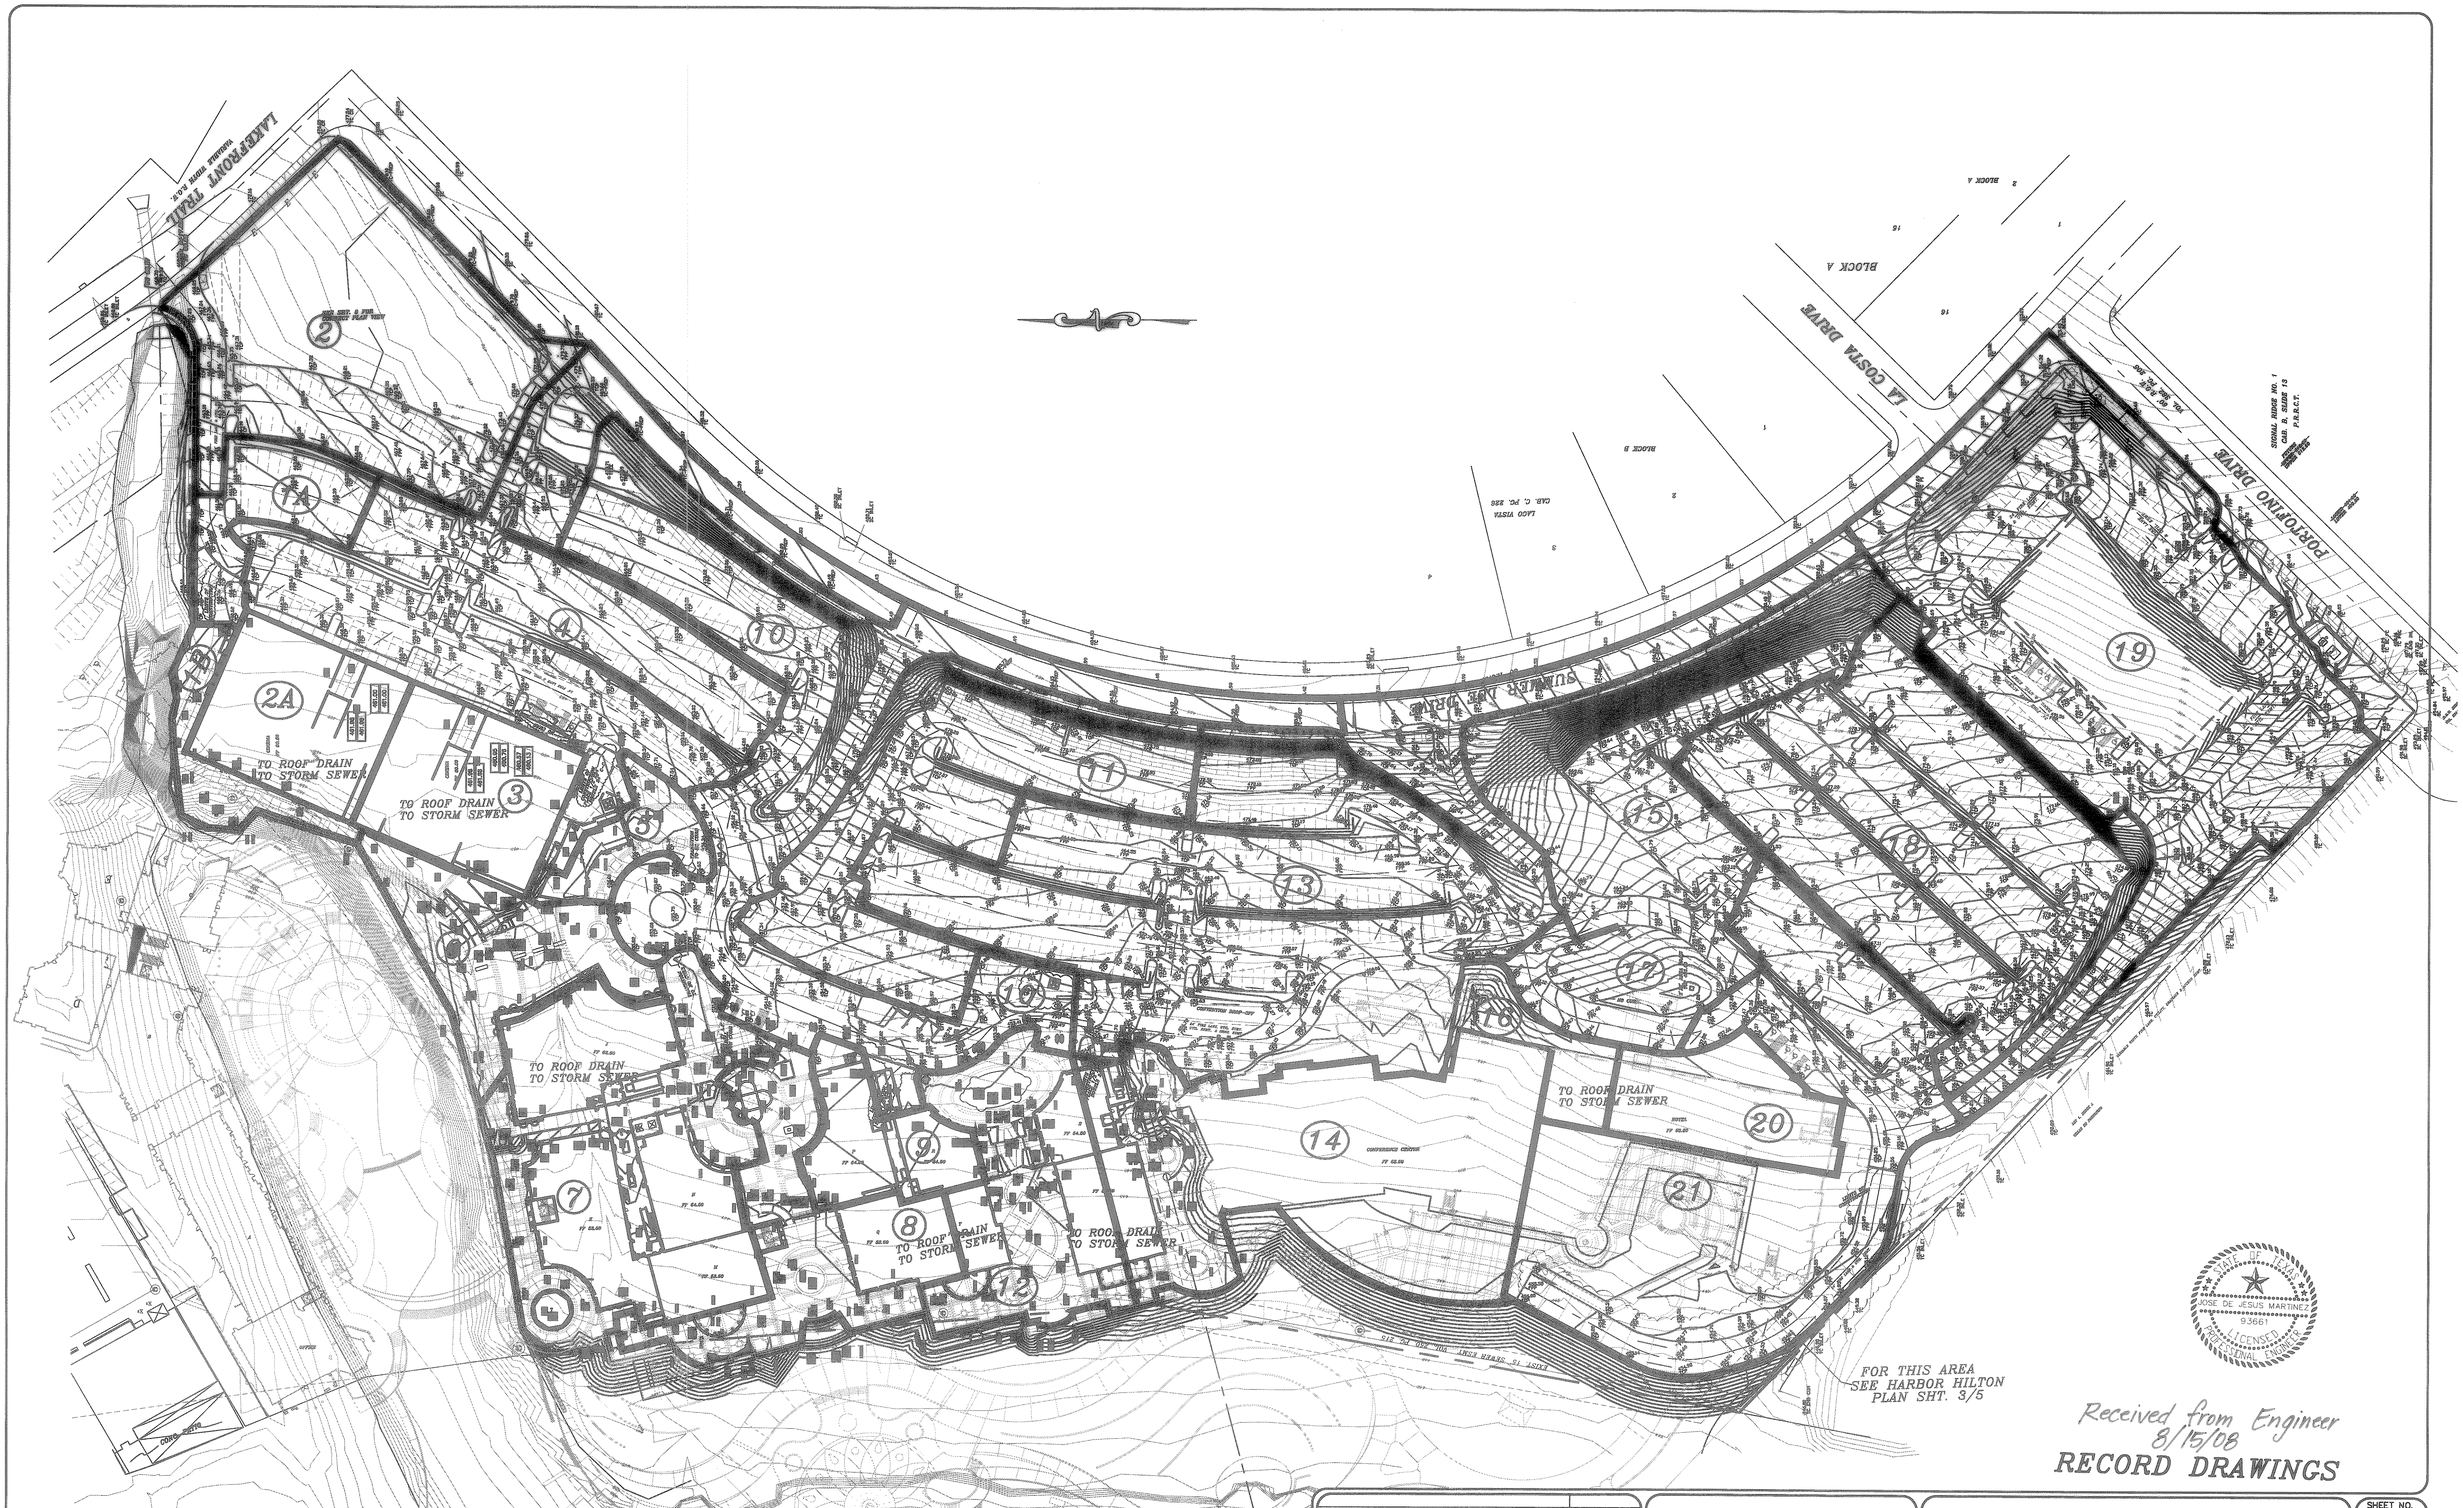


Received from Engineer
8/15/08

**RECORD DRAWINGS**

| | |
|---|---|
| REV. | 5/3/04 |
| REV. | 3/30/08 |

REVISION DESCRIPTION

0136DRNA


SOLID STRUCTURAL SOLUTIONS, INC.
P.O. BOX 851830
MESQUITE, TX 75185-1830
PHONE: 214.417.6520
FAX: 972.288.5714


| DATE | SCALE | DESIGN | DRAWN |
|---|---|---|---|
| 12/15/03 | 1"=60' | H.L.E. | |

DRAINAGE AREA MAP

THE HARBOR – ROCKWALL

CITY OF ROCKWALL

SHEET NO. 15 / 26

JOB NO. 0136

C:\PROJECTS\HLE\0136\0136DRN2A.dwg, 06/03/07 12:19:53 PM, GCW