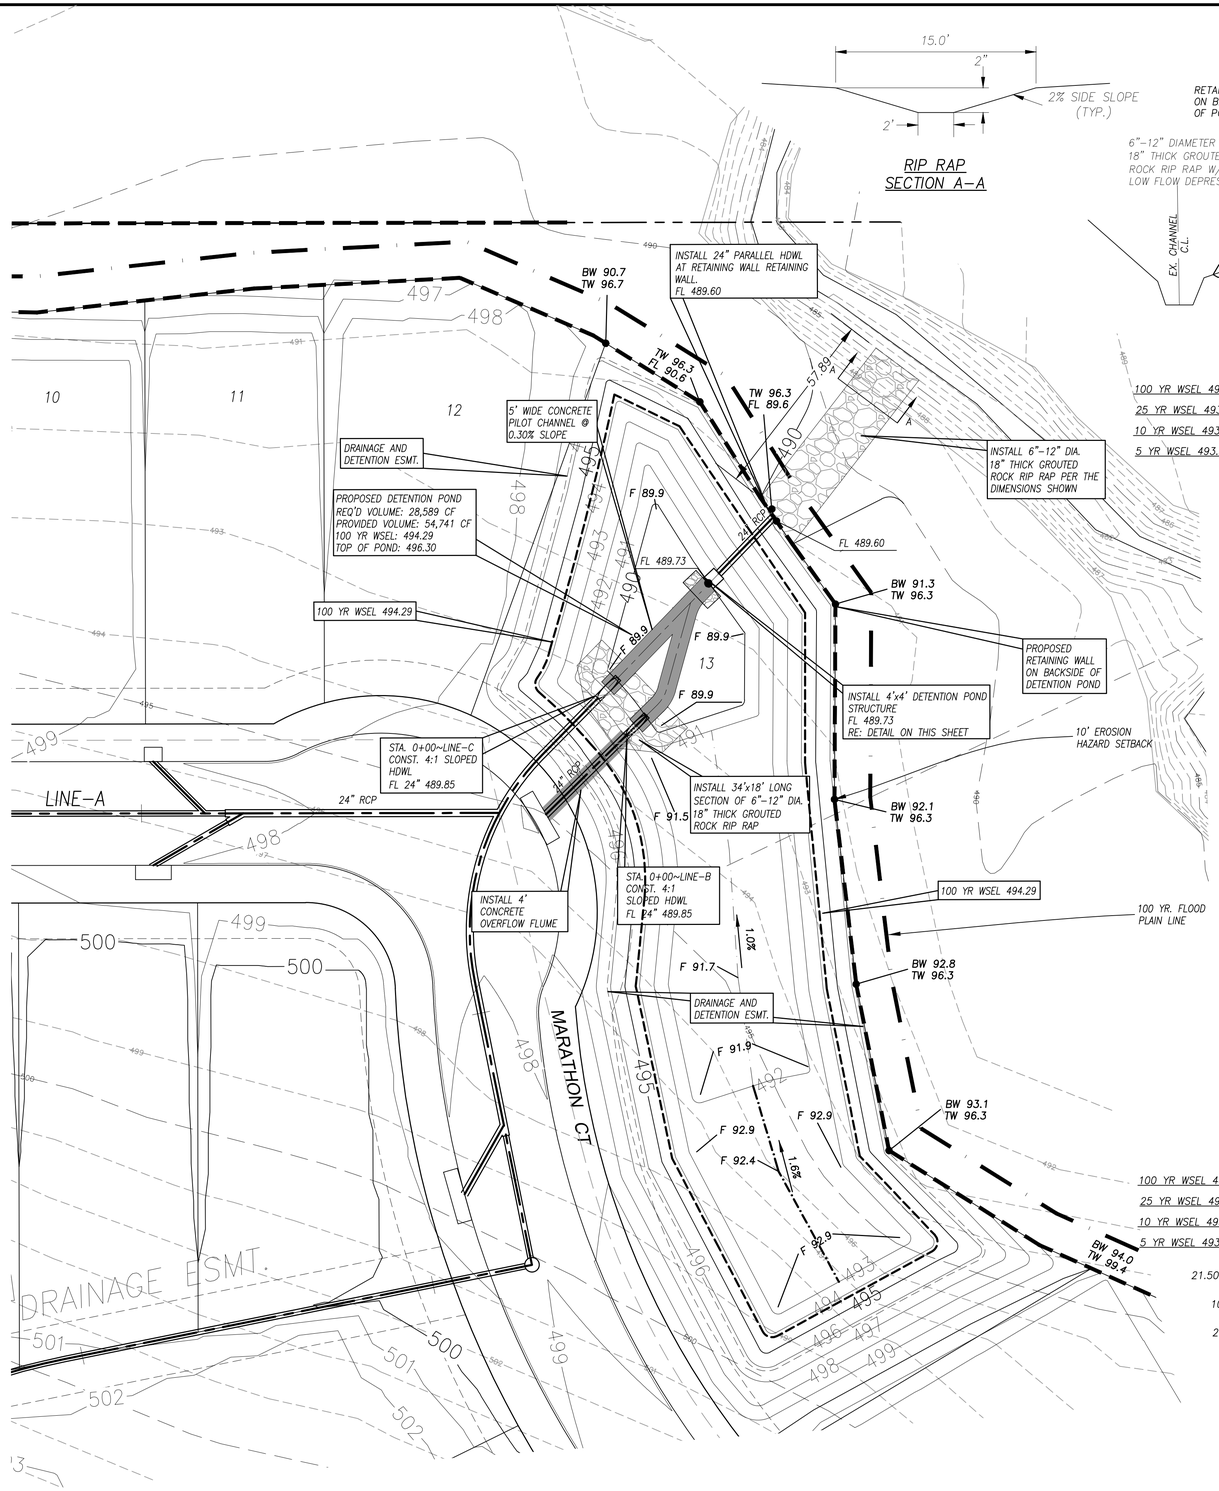

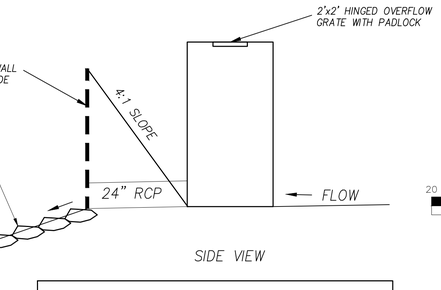

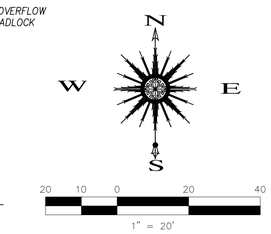

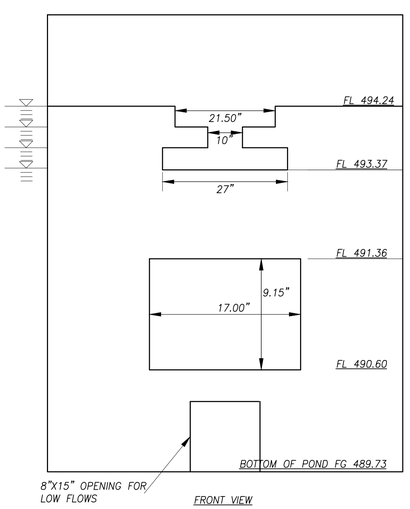

4'x4' BOX MULTI STAGE OUTLET STRUCTURE DETAIL
N.T.S.

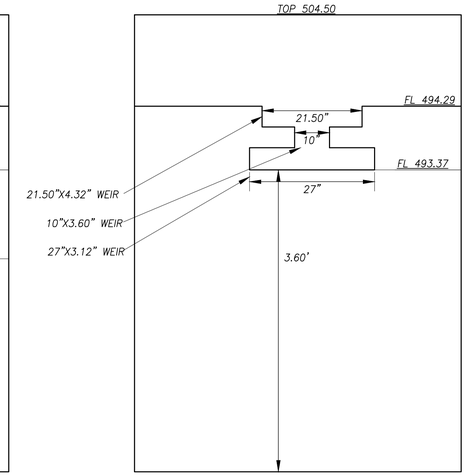

4'x4' BOX MULTI STAGE OUTLET STRUCTURE DETAIL
N.T.S.

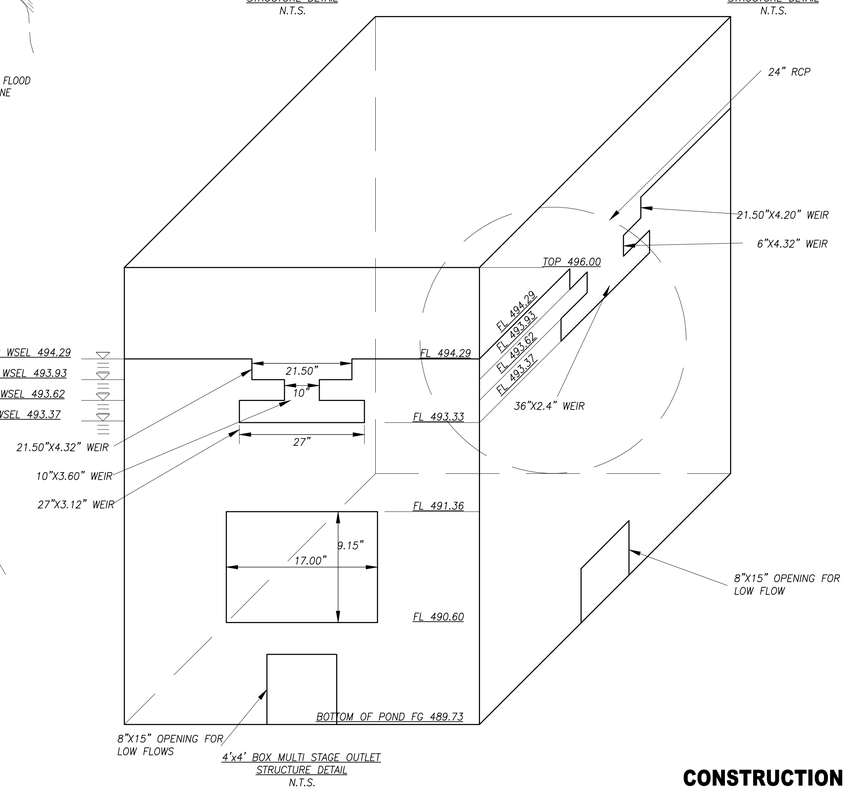

4'x4' BOX MULTI STAGE OUTLET STRUCTURE DETAIL
N.T.S.

CONSTRUCTION RECORD

Revision	Date	Description

Owner/Developer:
WHITTLE DEVELOPMENT
P.O. Box 369
Rockwall, Texas 75087
Phone 972.771-5253

Engineer:
F.C. CUNY CORPORATION
172 Horizon Court • Ste. 500 • Heath, Texas 75032
Phone: 469-402-7700
Fax: 469-402-0700
Texas Registered Engineering Firm F-7449

The Highlands
City of Rockwall, Rockwall County, Texas

THE SEAL APPEARING ON THIS DOCUMENT WAS AUTHORIZED BY CHRISTOPHER R. CUNY, P.E. 65642

STATE OF TEXAS
CHRISTOPHER R. CUNY
65642
LICENSED
PROFESSIONAL ENGINEER
2/11/2021

Sheet Title:
Detention Pond Plan

Drawn By: FC CUNY	Checked By: FC CUNY
Date: 08-18	Project No.:
Scale: 1"=20'	Sheet No.: 9 of 12