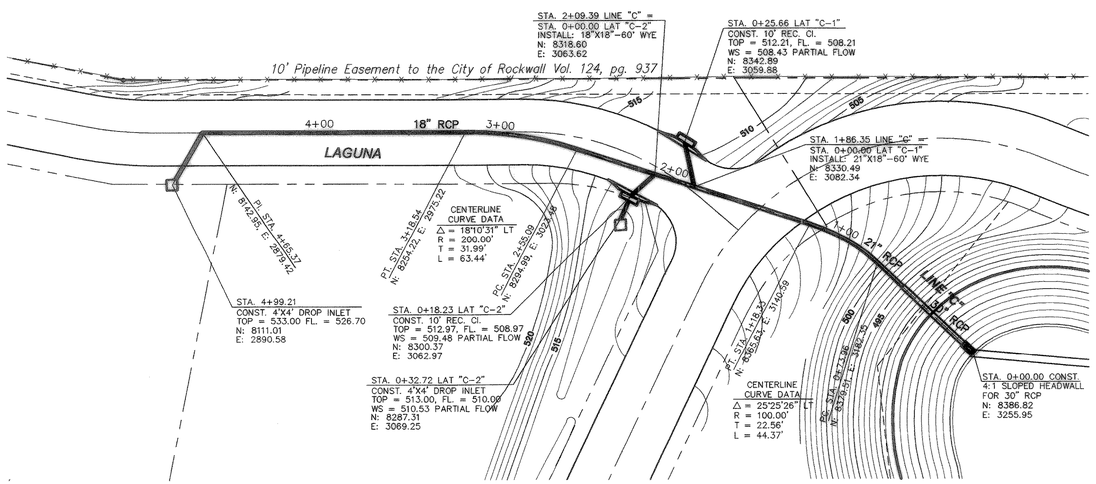

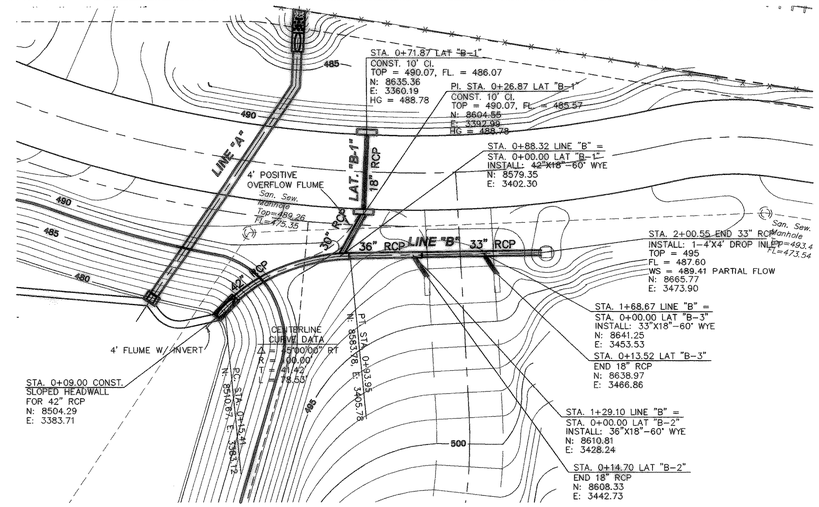

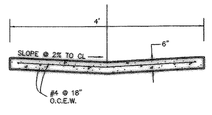

CONCRETE FLUME

N.T.S.

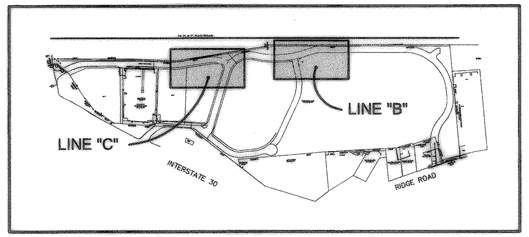

VICINITY MAP

N.T.S.

RECORD DRAWINGS
AS PROVIDED BY:
I.C.S. COMMERCIAL
MICHAEL S. ALLEN, P.E.
DATE: 9/25/03

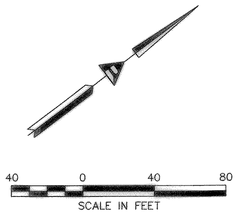

STORM SEWER LINE "C"

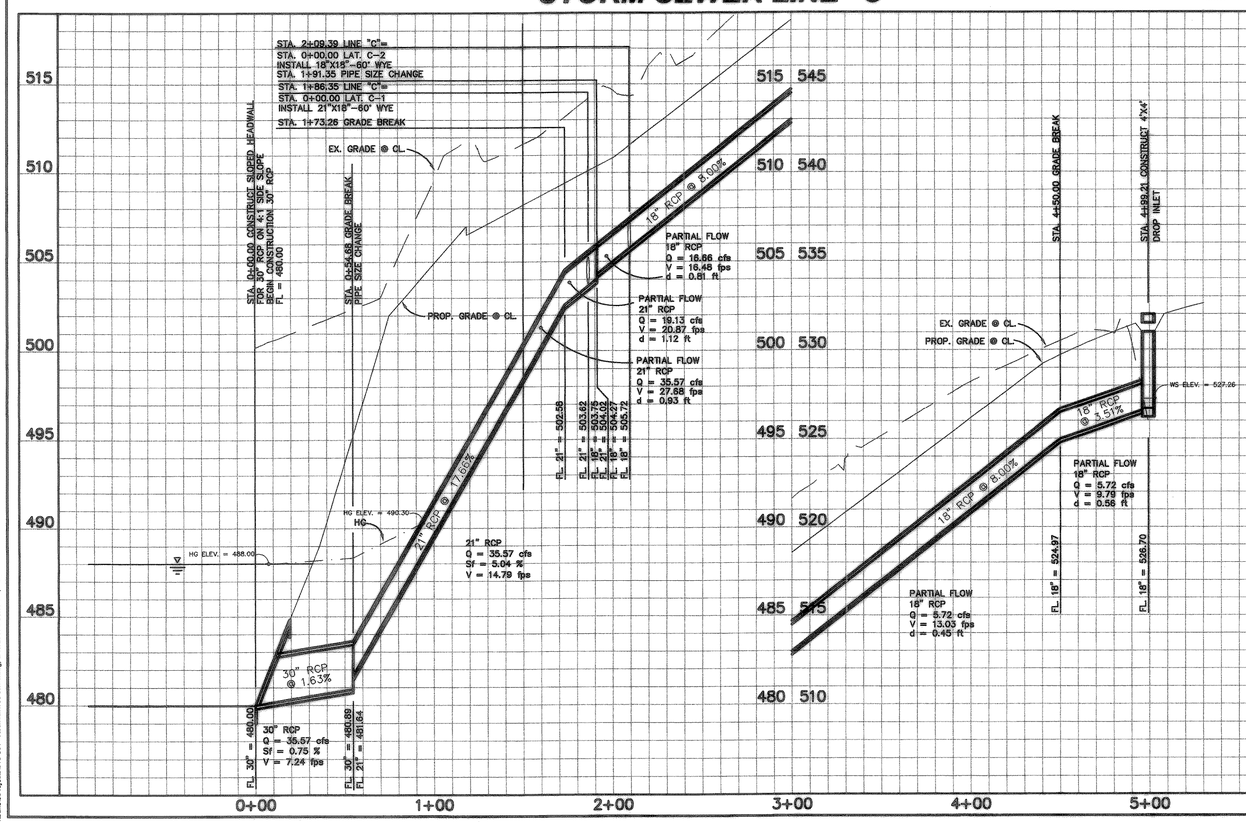

STORM SEWER LINE "B"

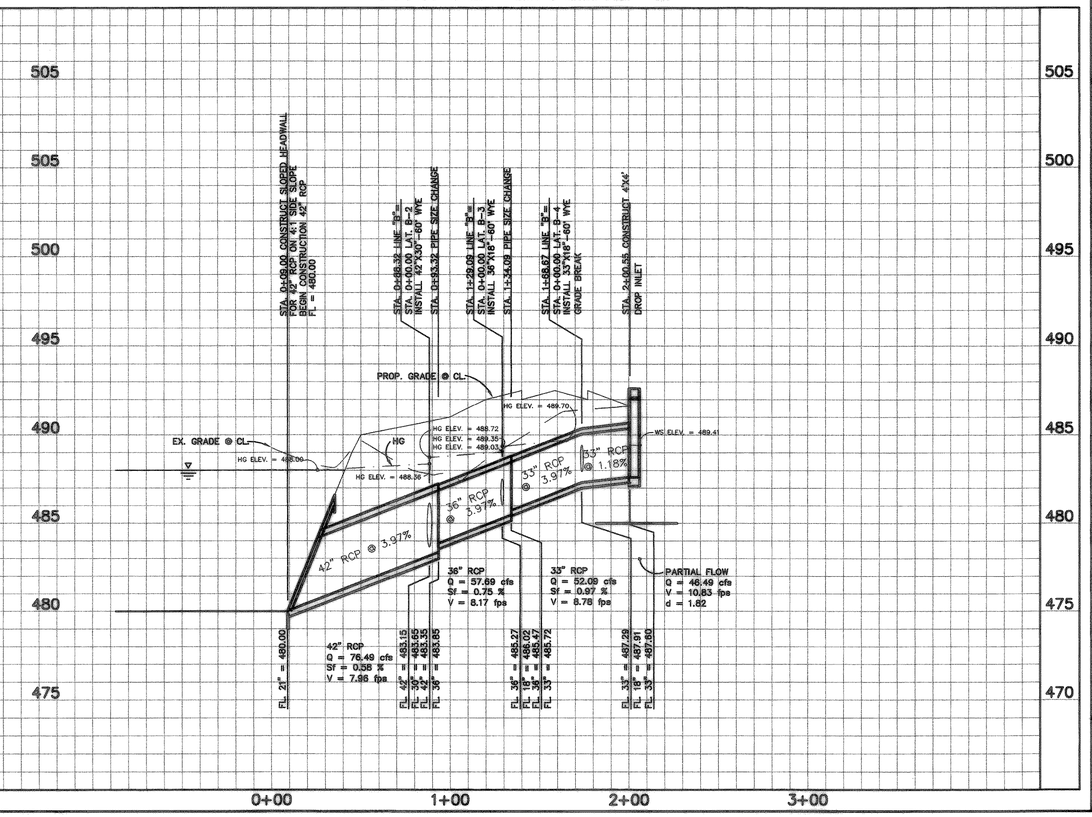

No.	Date	Revisions	App.

Allen & Ridinger Consulting, Inc.
109 W. Main Street
Lewisville, Texas 75057
Tel. No. (972) 353-8000
Fax No. (972) 353-8011

STATE OF TEXAS
MICHAEL S. ALLEN
86188
LICENSED
PROFESSIONAL ENGINEER
3/14/03

La Jolla Pointe Addition
ROCKWALL, TEXAS

STORM SEWER PLAN AND PROFILE

LINE "B" & LINE "C"

STA 0+00 TO END

Scale: 1"=40' HOR., 1"=4' VERT.
Designed by: MSA
Drawn by: MSA
Checked by: MSA
Date: March 14, 2003
Project No. 018-001

SHEET
C-9
OF 25

\\Drive\Projects\018-001 - Rockwall\10c-stm-c.dwg, 3/13/2003 4:39:10 PM, 1:40