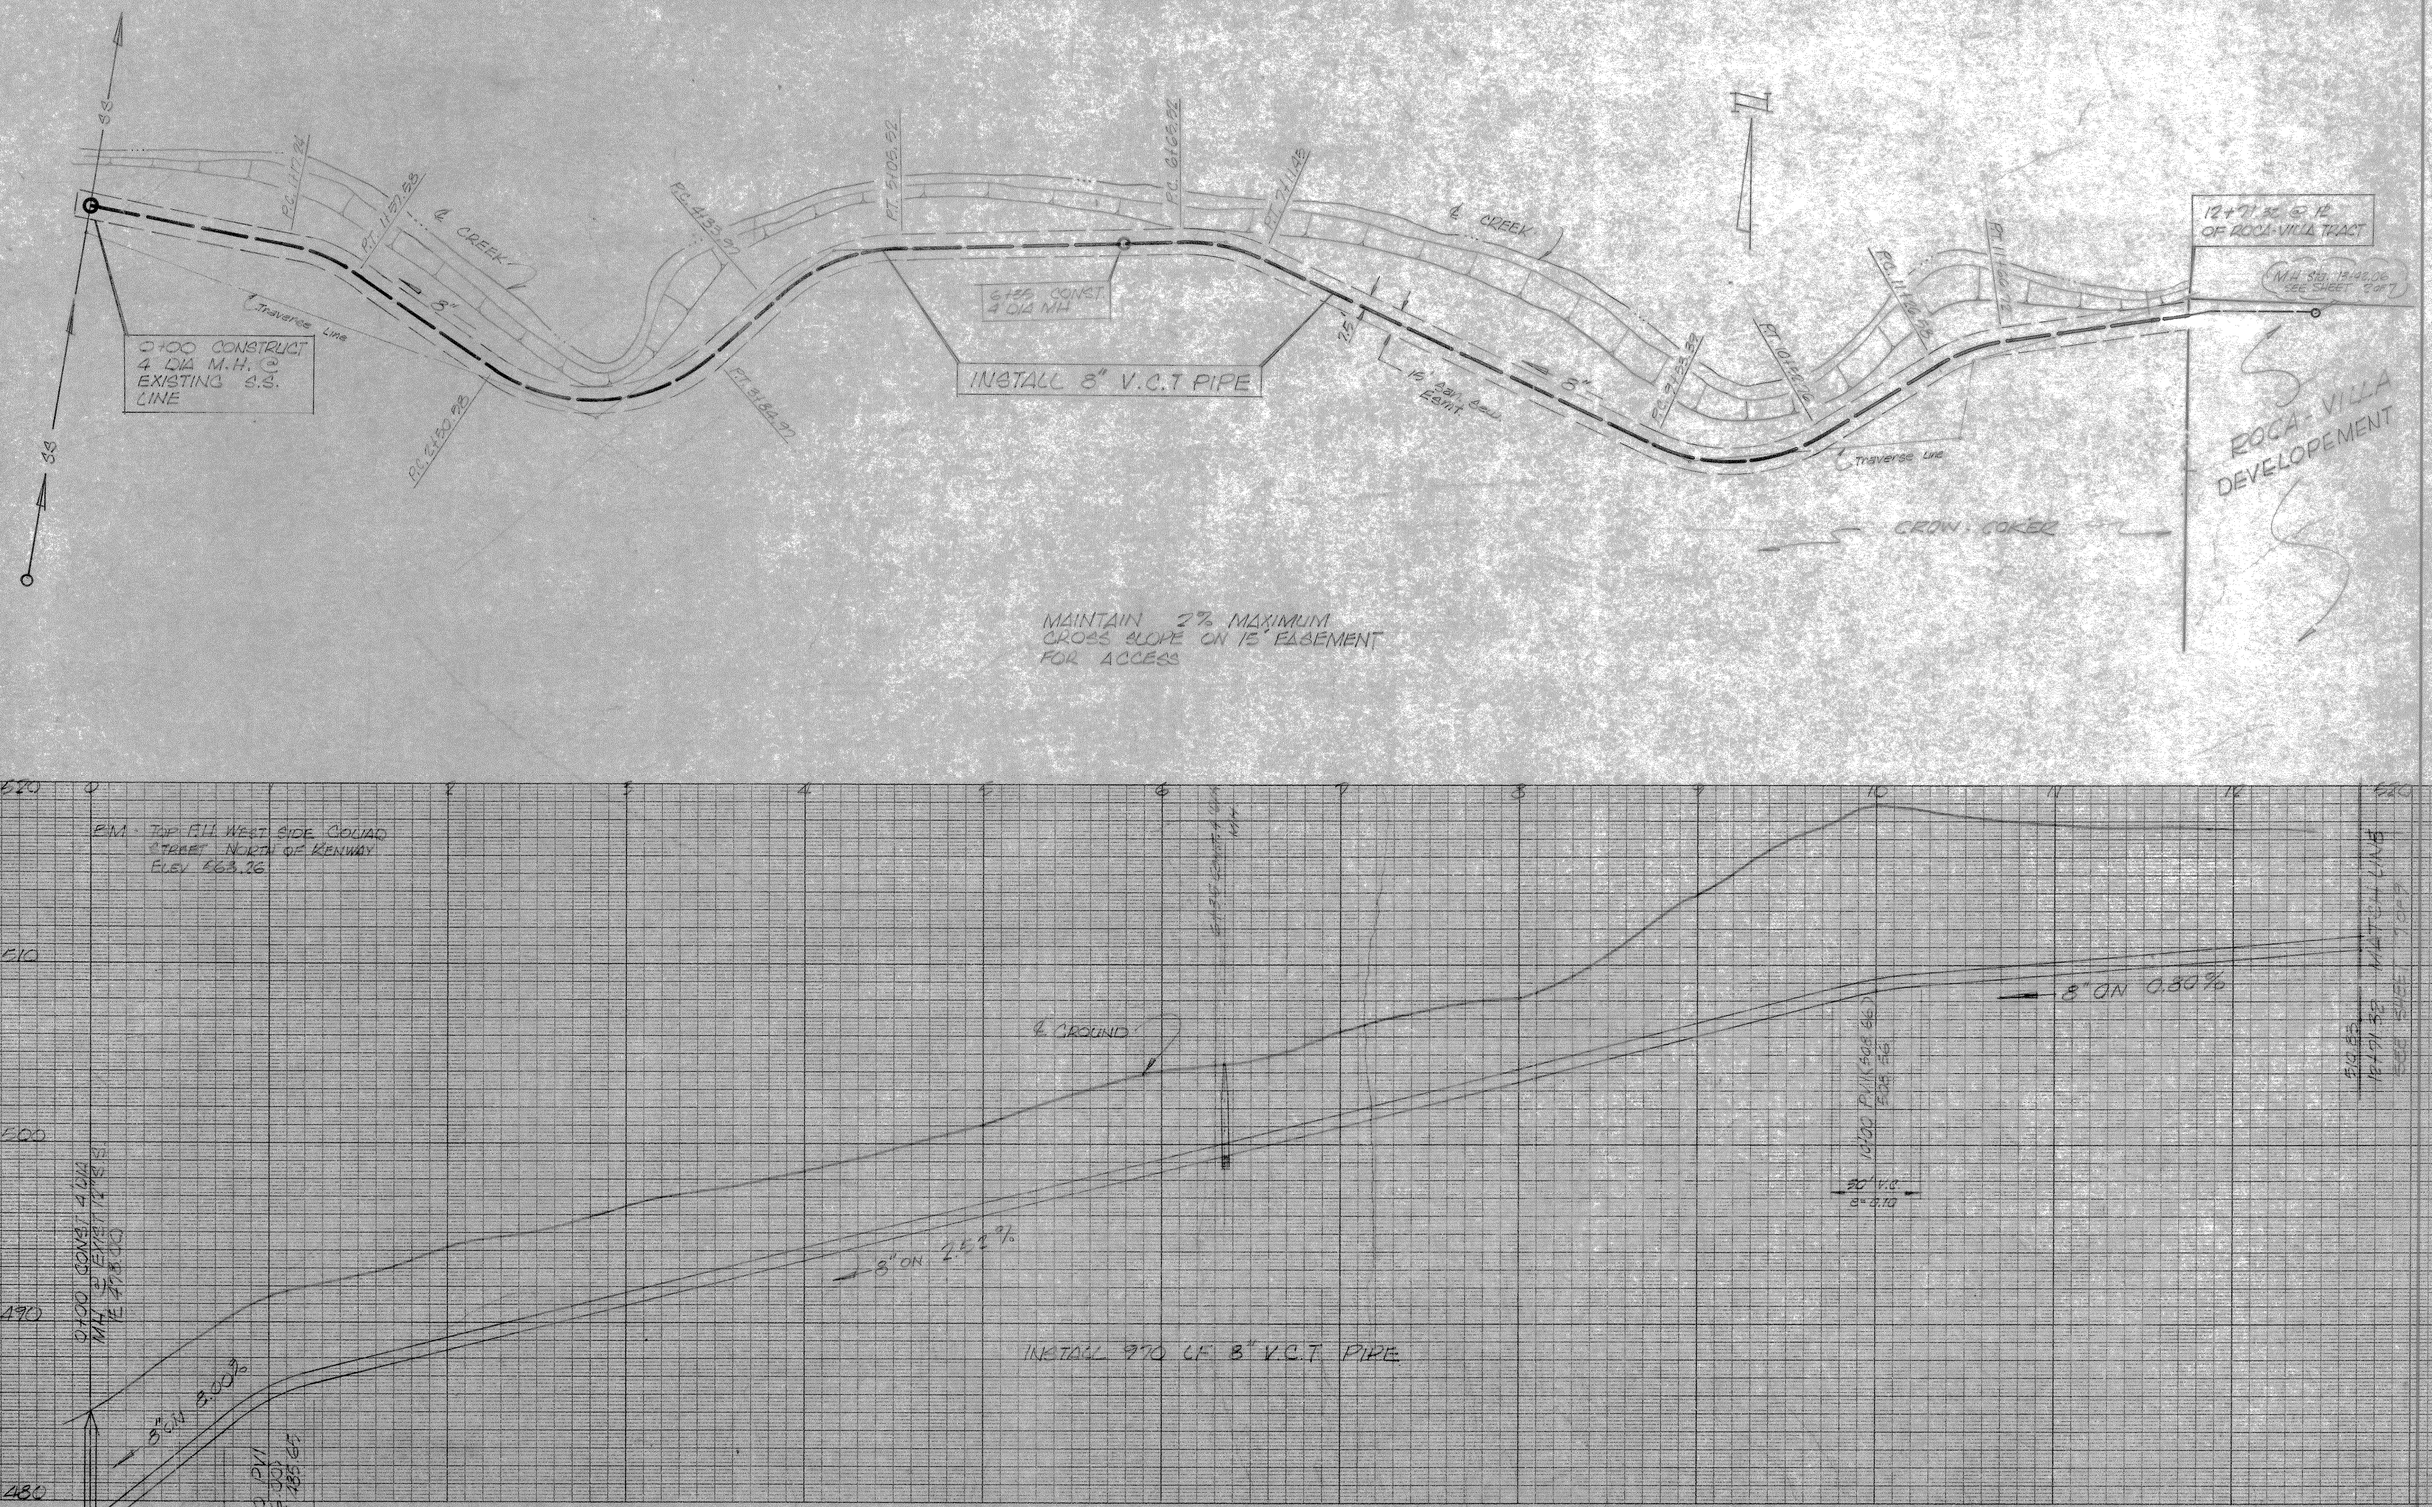

"CLEARPRINT" PROFILE PLAN PLATE 4
"CLEARPRINT" PAPER CO.
MADE IN U.S.A.

ACREY ASSOCIATES, INC. CONSULTING ENGINEERS P.O. BOX 28902 DALLAS, TEXAS (214) 328-4613					SANITARY SEWER OUTFALL FOR ROCA-VILLA LTD. ROCKWALL, TEXAS	SHEET NO. 7/11
DESIGN	DRAWN	DATE	SCALE	REVISION		
	JEC	2 OCT 78	1"=40'	10/8/78		72077