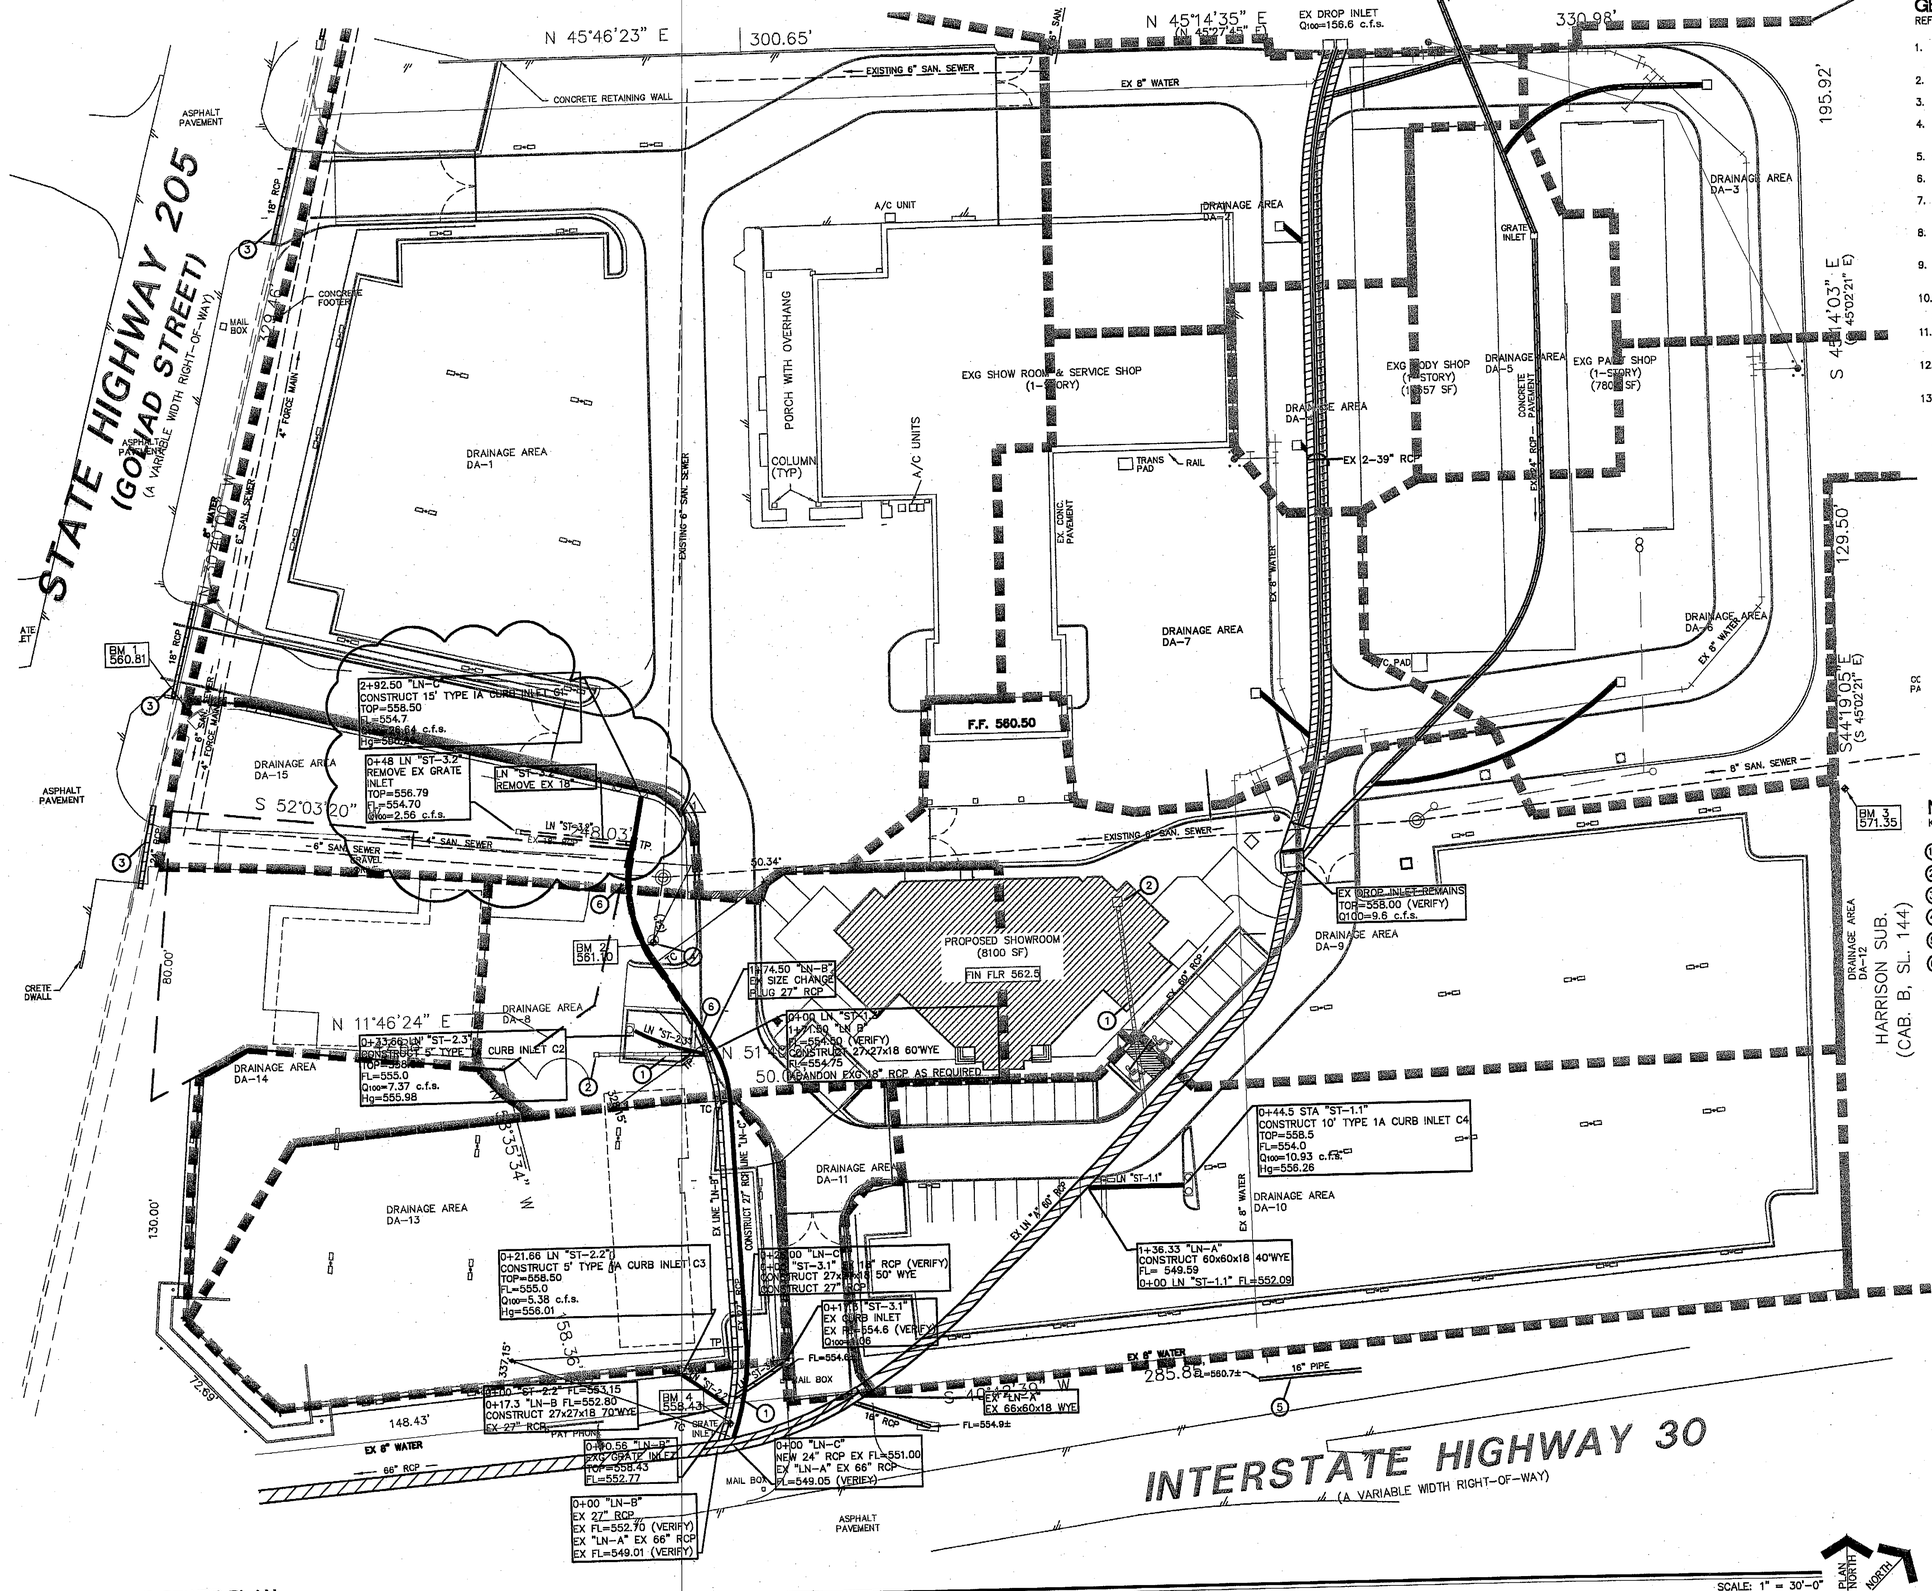

GENERAL NOTES:

REFER TO KEYED NOTES FOR SPECIFIC PLAN INFORMATION

1. ALL STORM SEWER NOT SHOWN TO BE REMOVED REMAINS.
2. REFER TO SHEET-C1 FOR SITE DEMOLITION PLAN.
3. REFER TO SHEET-C2 FOR SITE IMPROVEMENT PLAN.
4. REFER TO SHEET-C3 FOR SITE EASEMENT ADDITION & ABANDONMENTS.
5. REFER TO SHEET-C4 FOR SITE GRADING PLAN.
6. REFER TO SHEET-C5 FOR SITE DRAINAGE PLAN.
7. REFER TO SHEET-C7 FOR SITE STORM WATER SYSTEM CALCULATION AND DETAILS.
8. REFER TO SHEET-C8 FOR STORM WATER SEWER SYSTEM PROFILES.
9. REFER TO SHEET-C9 FORE SITE WATER & WASTE WATER DETAILS.
10. REFER TO CITY DETAILS FOR ALL STORM WATER SYSTEM INSTALLATION DETAILS.
11. REFER TO SHEET-C10 FOR STORM WATER PROTECTION SITE PLAN.
12. REFER TO SHEET-C11 FOR STORM WATER PROTECTION DETAILS.
13. REFER TO SHEET-C5 FOR CURRENT DRAINAGE AT DRAINAGE AREA #12.

NOTES:

KEYED NOTES DESIGNATED BY: ⬡

1. REMOVE EXG 18"ø RCP STORM SEWER.
2. REMOVE EXG STORM DRAINAGE STRUCTURE.
3. EXG RCP CULVERT REMAINS.
4. EXG CITY LIFT STATION.
5. REMOVE EXG 16"ø RCP CULVERT.
6. REMOVE EXG 24"ø RCP.

PROJECT RECORD

Calliar Construction, Inc.
ASBUILT PLANS AS OF: 1/3/04
SIGNED BY: CM

STORM WATER SEWER PLAN

SCALE: 1" = 30'-0"

STATE OF TEXAS
S.P. DAUGHTRY
60172
REGISTERED
PROFESSIONAL ENGINEER

THE SEAL APPEARING ON THIS DOCUMENT WAS AUTHORIZED BY STEVEN P. DAUGHTRY, P.E. 60172

ALLIED ASSOCIATES CONSULTING ENGINEERS
STRUCTURAL · ELECTRICAL · MECHANICAL
2525 74TH ST. LUBBOCK, TX 79423
FAX (806) 745-1225 (806) 745-1103
www.alliedassociates.com

Architectural Resources
2525 74TH ST., SUITE 200
(806) 745-1103
LUBBOCK, TX 79423
BBS/FAX (806) 745-1225

PARKING LOT IIMPROVEMENTS TO LAKESIDE CHEVROLET
2005 SOUTH GOLIAD STREET
ROCKWALL TEXAS

SITE STORM WATER SEWER PLAN

PROJECT NO:	P05-0101
DATE:	10/5/2006
DRW BY: SPD	CHK BY: SPD
REVISIONS:	
1	10-05-06

SHEET NO.
C6
OF: 12

M:\LAKESIDE\SC\LAKESIDE CHREVROLET - ROCKWALL TEXAS\Sheets\C6 SITE STORM WATER SEWER PLAN.dwg, C6 SITE STORM WATER SEWER PLAN, 10/5/2006 5:43:17 PM, steven, STORM - 11.pgp