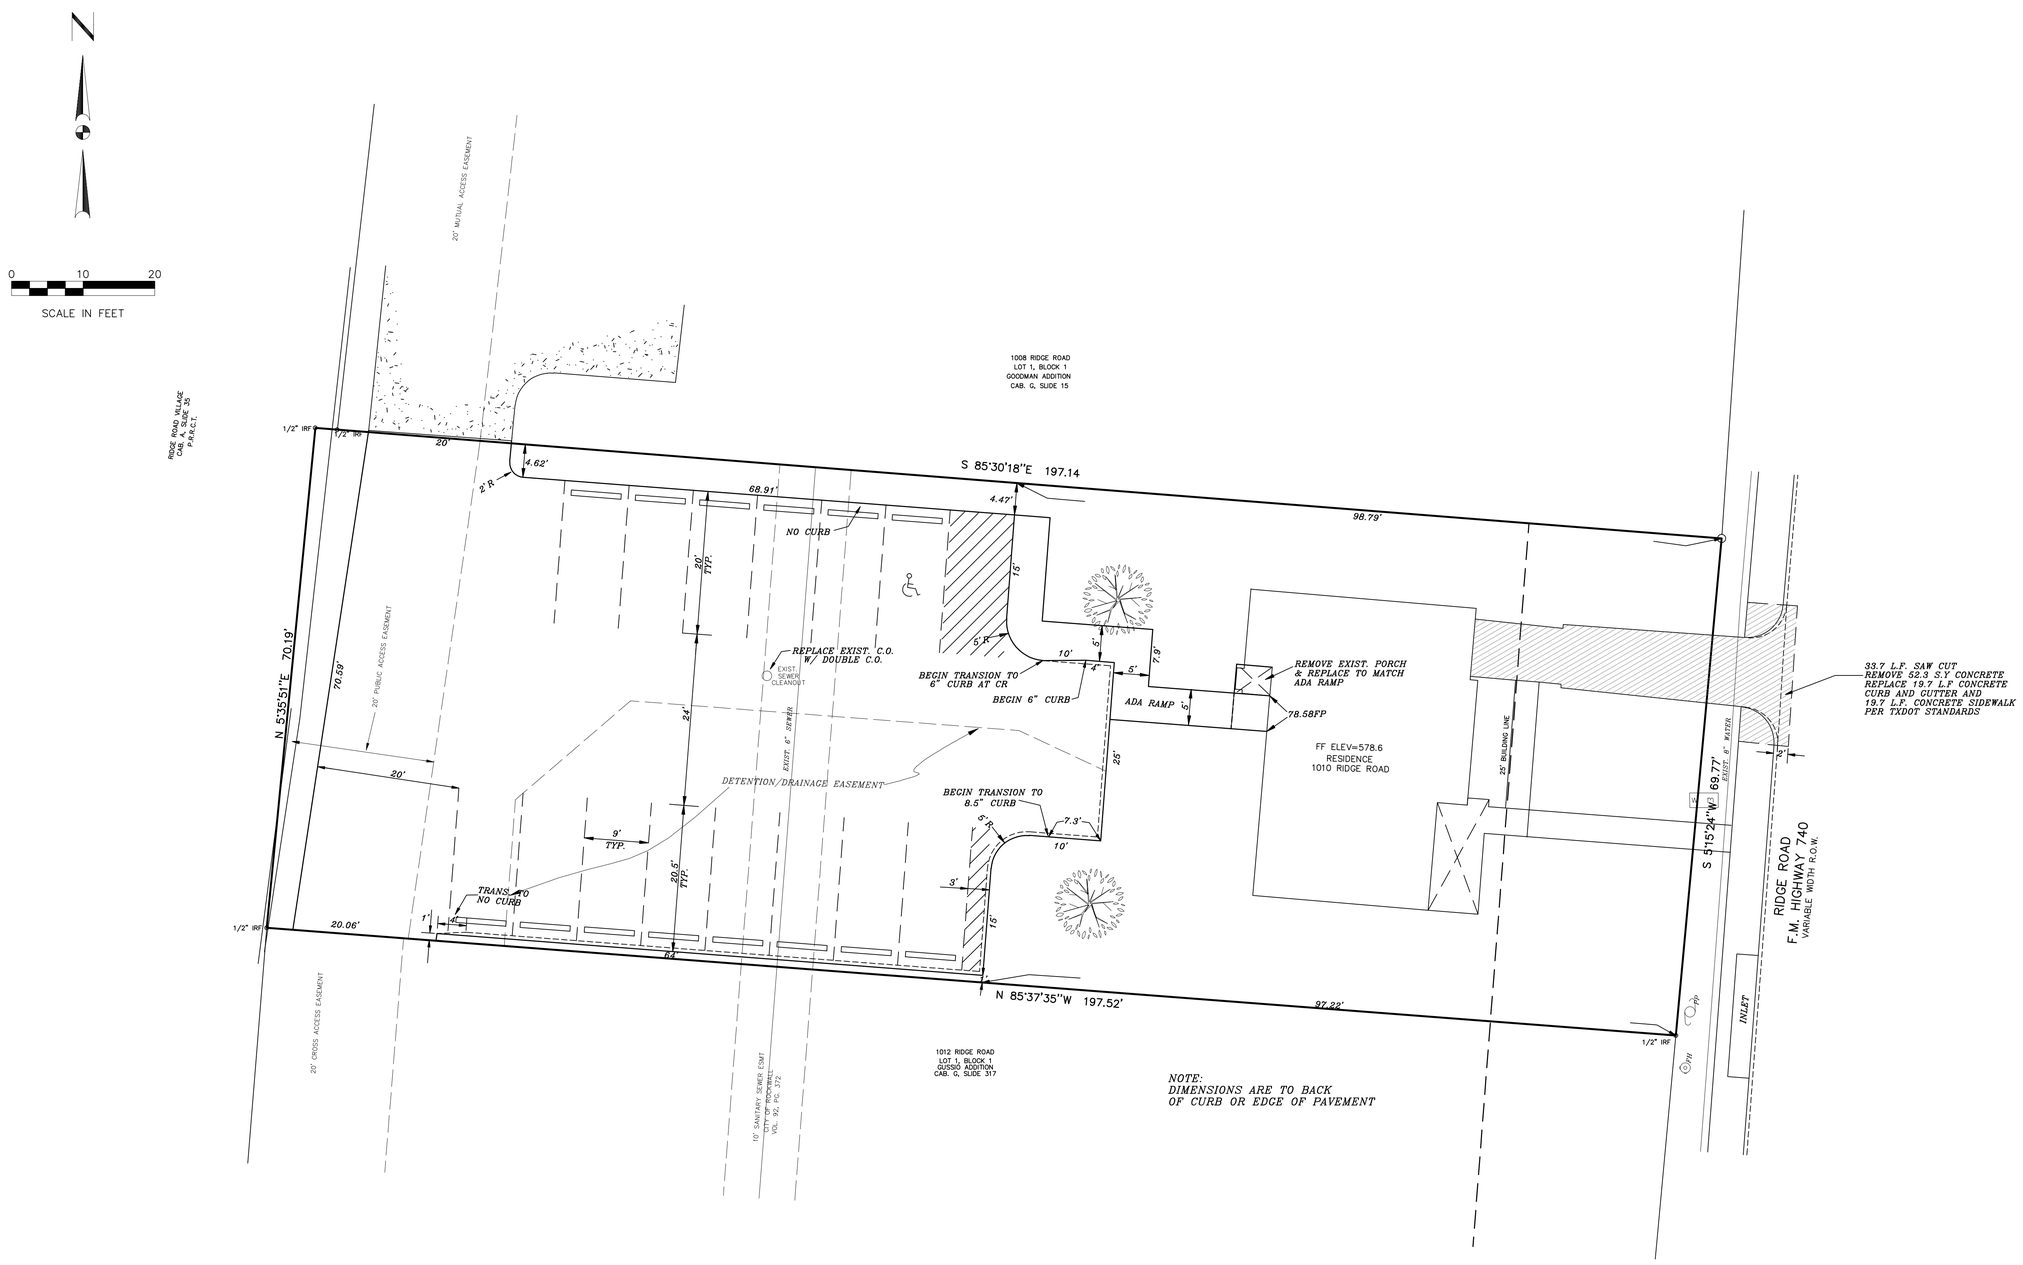

NOTE:
DIMENSIONS ARE TO BACK
OF CURB OR EDGE OF PAVEMENT

REVISED TO CONFORM TO CONSTRUCTION RECORDS.

DATE: 12/17/15

CITY CASE NO. SP2015-014

THE SEAL APPEARING ON THIS DOCUMENT WAS AUTHORIZED BY WL. DOUPHRATE II TEXAS P.E. NO. 60102. T-886. ON DATE: JUNE 16, 2015

DOUPHRATE & ASSOCIATES, INC.
ENGINEERING • PROJECT MANAGEMENT • SURVEYING
2235 RIDGE RD., # 200 ROCKWALL, TEXAS 75087
PHONE: (972)771-9004 FAX: (972)771-9005

DIMENSION CONTROL AND DEMOLITION PLAN
PREGNANCY RESOURCE CENTER
1010 RIDGE ROAD
CITY OF ROCKWALL
ROCKWALL COUNTY, TEXAS

REVISION	
CHECKED	W.L.D.
DRAWN	G.C.W.
SCALE	1"=10' H 1" = V
DATE	JUNE 16, 2015
PROJECT	15011