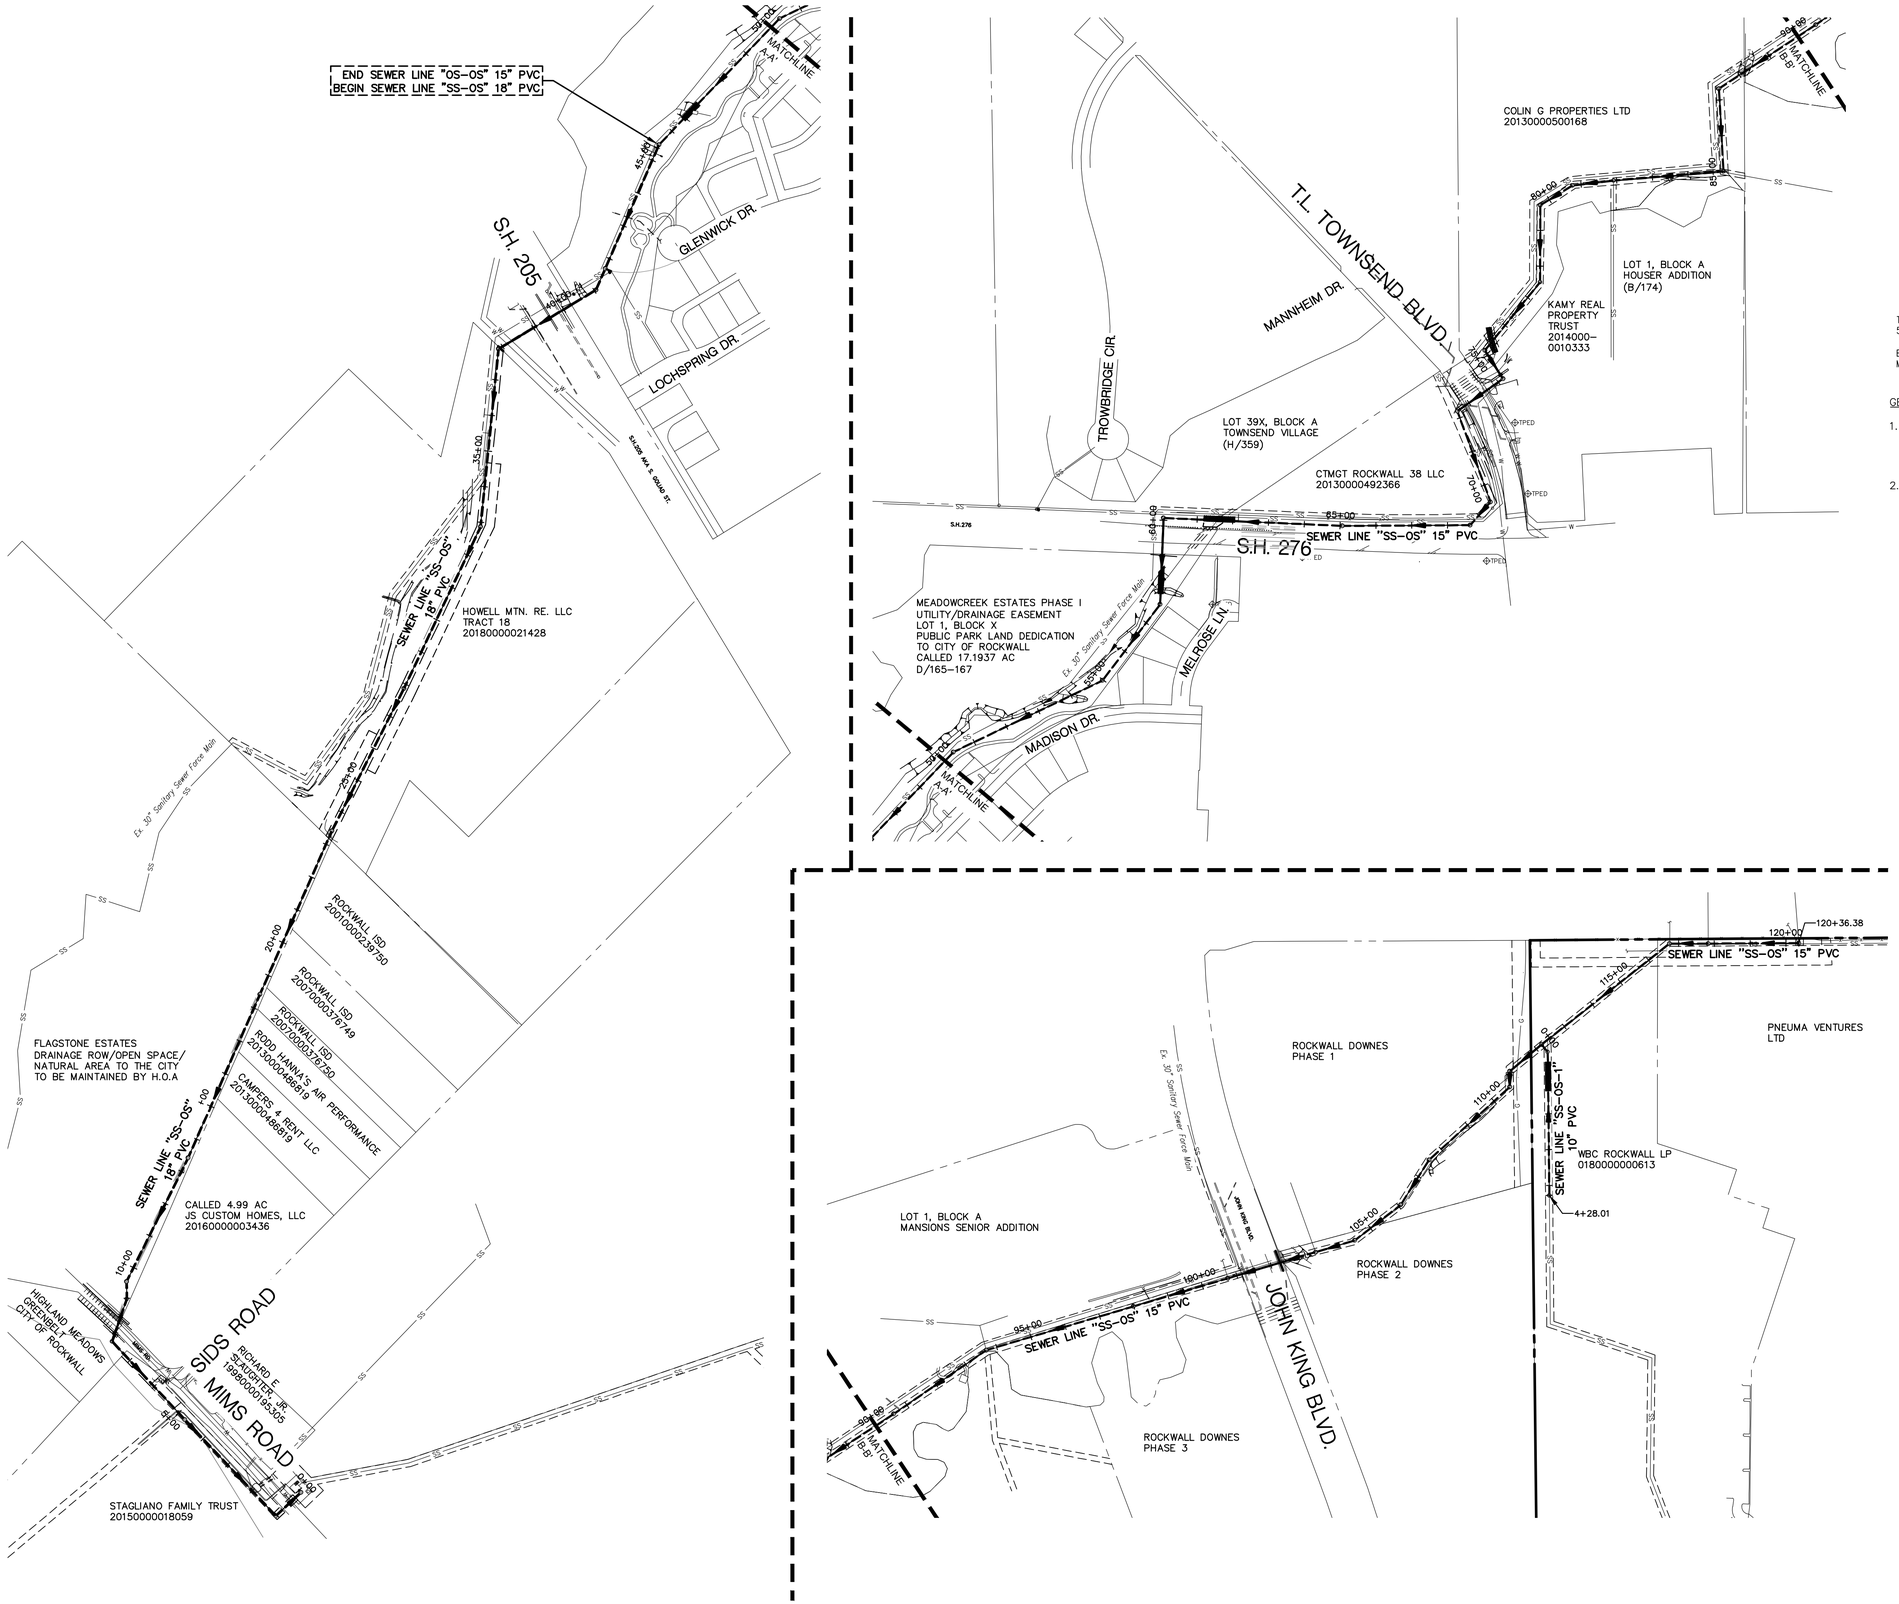

200 0 200 400 600 Feet

SCALE: 1"=200'

TBM: "X" CUT ON CURB INLET ALONG NORTHSIDE OF DISCOVERY BLVD. APPROXIMATELY 570 FEET FROM EAST PROPERTY LINE. ELEV.= 564.92

BM: CITY OF ROCKWALL CONTROL MONUMENT " N1495". CALLED ELEV.= 566.71. MEASURED ELEV. = 566.83

GENERAL NOTES

1. ALL RESPONSIBILITY FOR ADEQUACY OF DESIGN REMAINS WITH THE DESIGN ENGINEER. THE CITY OF ROCKWALL, IN REVIEWING AND RELEASING PLANS FOR CONSTRUCTION, ASSUMES NO RESPONSIBILITY FOR ADEQUACY OR ACCURACY OF DESIGN.
2. TREES SHOWN HEREON ARE FOR INFORMATIONAL PURPOSES. ADDITIONAL NON-SUBSTANTIAL TREES MAY BE PRESENT ALONG THE SANITARY SEWER ROUTE. CONTRACTOR TO VERIFY PROPOSED ROUTE PRIOR TO CONSTRUCTION.

AS-BUILT
RECORD DRAWING

THE INFORMATION ON THESE PLANS HAS BEEN REVISED TO REFLECT CHANGES TO PUBLIC IMPROVEMENTS MADE DURING CONSTRUCTION. UNLESS OTHERWISE NOTED, THE CONSTRUCTION OF THE PUBLIC IMPROVEMENTS IS IN GENERAL CONFORMANCE WITH THESE PLANS, BASED UPON INFORMATION PROVIDED BY THE CONTRACTOR AND FIELD VERIFICATIONS. THE RESPONSIBILITY FOR ACCURACY AND COMPLETENESS BELONGS TO THE CONTRACTOR.

Matthew G. St. Marie
THE JOHN R MCADAMS COMPANY, INC.
Date: 11/25/2020

STATE OF TEXAS
MATTHEW G. ST. MARIE
110326
LICENSED
PROFESSIONAL ENGINEER

MCADAMS
TBPE: 19762

DEVELOPER
SWBC BUILDERS
5949 SHERRY LANE #750
DALLAS, TX 75225
Ph. (214) 987-6317
Contact: SPENCER BYINGTON

The John R. McAdams Company, Inc.
111 Walker Drive
Lewisville, Texas 75057
972. 436. 9712

201 Country View Drive
Roanoke, Texas 76262
940. 240. 1510

TBPE: 19762 TBPLS: 10194440
www.mcadamsco.com
www.gacon.com

EAST BUFFALO CREEK TRUNK SEWER

EAST BUFFALO CREEK TRUNK SEWER
in the
W. BARNES SURVEY, ABSTRACT NO. 26, J.D. MCFARLAND SURVEY, ABSTRACT NO. 145, CHAS. CLARK SURVEY, ABSTRACT NO. 67, HENDERSON SURVEY, ABSTRACT NO. 189, N.A. BALLARD SURVEY, ABSTRACT NO. 24, J.M. ALLEN SURVEY, ABSTRACT NO. 2
CITY OF ROCKWALL
ROCKWALL COUNTY, TEXAS

OVERALL SANITARY SEWER PLAN

Drawn By:	MGSM
Date:	04/12/2018
Scale:	1"=200'
Revisions:	
09/19/18	
12/26/18	
02/06/19	
03/29/19	
08/12/19	
11/25/20 – AS BUILTS	

17193A

C2

File: Z:\2017\17193\Drawing\As Built& Offsite Sewer\Offsite Sanitary Sewer As-Built Sheets\17193A OVERALL PLAN AB
Plotted: 12/10/2020 11:29 AM, by St. Marie, Matthew; Sweet: 12/10/2020 11:25 AM, by simone