



PAR. NO.	STATION TO STATION	OWNER	TYPE OF CONV.	CONVEYANCE		AREA TO BE ACQ.	REMAINDER	
				VOL.	PAGE		LEFT	RIGHT
62A	146+34.45 - 147+24.76	RONALD C. PERKINS, DDS	FEE			0.0192 AC.		0.39 AC.
62B	147+24.76 - 148+12.83	ROCKWALL RENTAL PROPERTIES, L.P.	FEE			0.0555 AC.		0.25 AC.
63	146+35.29 - 146+48.78	DRAGO & CEDO RAKICH	FEE			0.0029 AC.	0.19 AC.	
64	147+73.11 - 149+80.81	BEN ALLEN KLUTTS, JR. & BETTY BARTON	FEE			0.4933 AC.	0.00 AC.	0.00 AC.
65	147+68.90 - 147+88.64	LAND HEADQUARTERS COMPANY, INC.	FEE			0.0046 AC.		0.34 AC.
66	148+19.34 - 149+21.04	DAVID H. & LILA M. WHITE	FEE			0.3085 AC.	0.00 AC.	
68	149+21.04 - 149+89.56	BETTYE L. GUNN & JOAN SIMMONS MCINTYRE	FEE			0.2065 AC.	0.00 AC.	
69	149+89.56 - 150+41.31	SARRAT WHITE PARTNERS, L.P.	FEE			0.0119 AC.	0.24 AC.	
71	150+41.31 - 151+20.31	LDEG 1, LLC	FEE			0.0181 AC.	0.18 AC.	
73	151+20.31 - 152+04.71	STAINED GLASS CREATIONS	FEE			0.0194 AC.	0.23 AC.	
75	152+04.71 - 152+84.97	ARTVENTURES STUDIO, L.L.C.	FEE			0.0046 AC.	0.21 AC.	
92	145+81.63 - 147+31.86	JOY PROPERTIES, INC.	FEE			0.0202 AC.		0.66 AC.
93	152+84.97 - 154+52.33	JOHN M. & SUSAN L. WRIGHT	FEE			0.0096 AC.	0.42 AC.	
100	147+58.02 - 148+62.46	OLIN R. KILLION	FEE	INS NO. 200800398360		0.0212 AC.	0.44 AC.	

LEGEND

PROPOSED ROW
EXISTING ROW
PROPERTY LINE
COUNTY LINE
CONTROL OF ACCESS LINE
SURVEY LINE
FENCE LINE
CITY LIMITS

EASEMENT
RAILROADS
STRUCTURE
POINT OF COMMENCING
POINT OF BEGINNING
FOUND CONC. MONUMENT
SET 5/8" STEEL ROD WITH ALUMINUM TXDOT CAP
SET OR FOUND MONUMENTATION

P.O.C.
P.O.B.

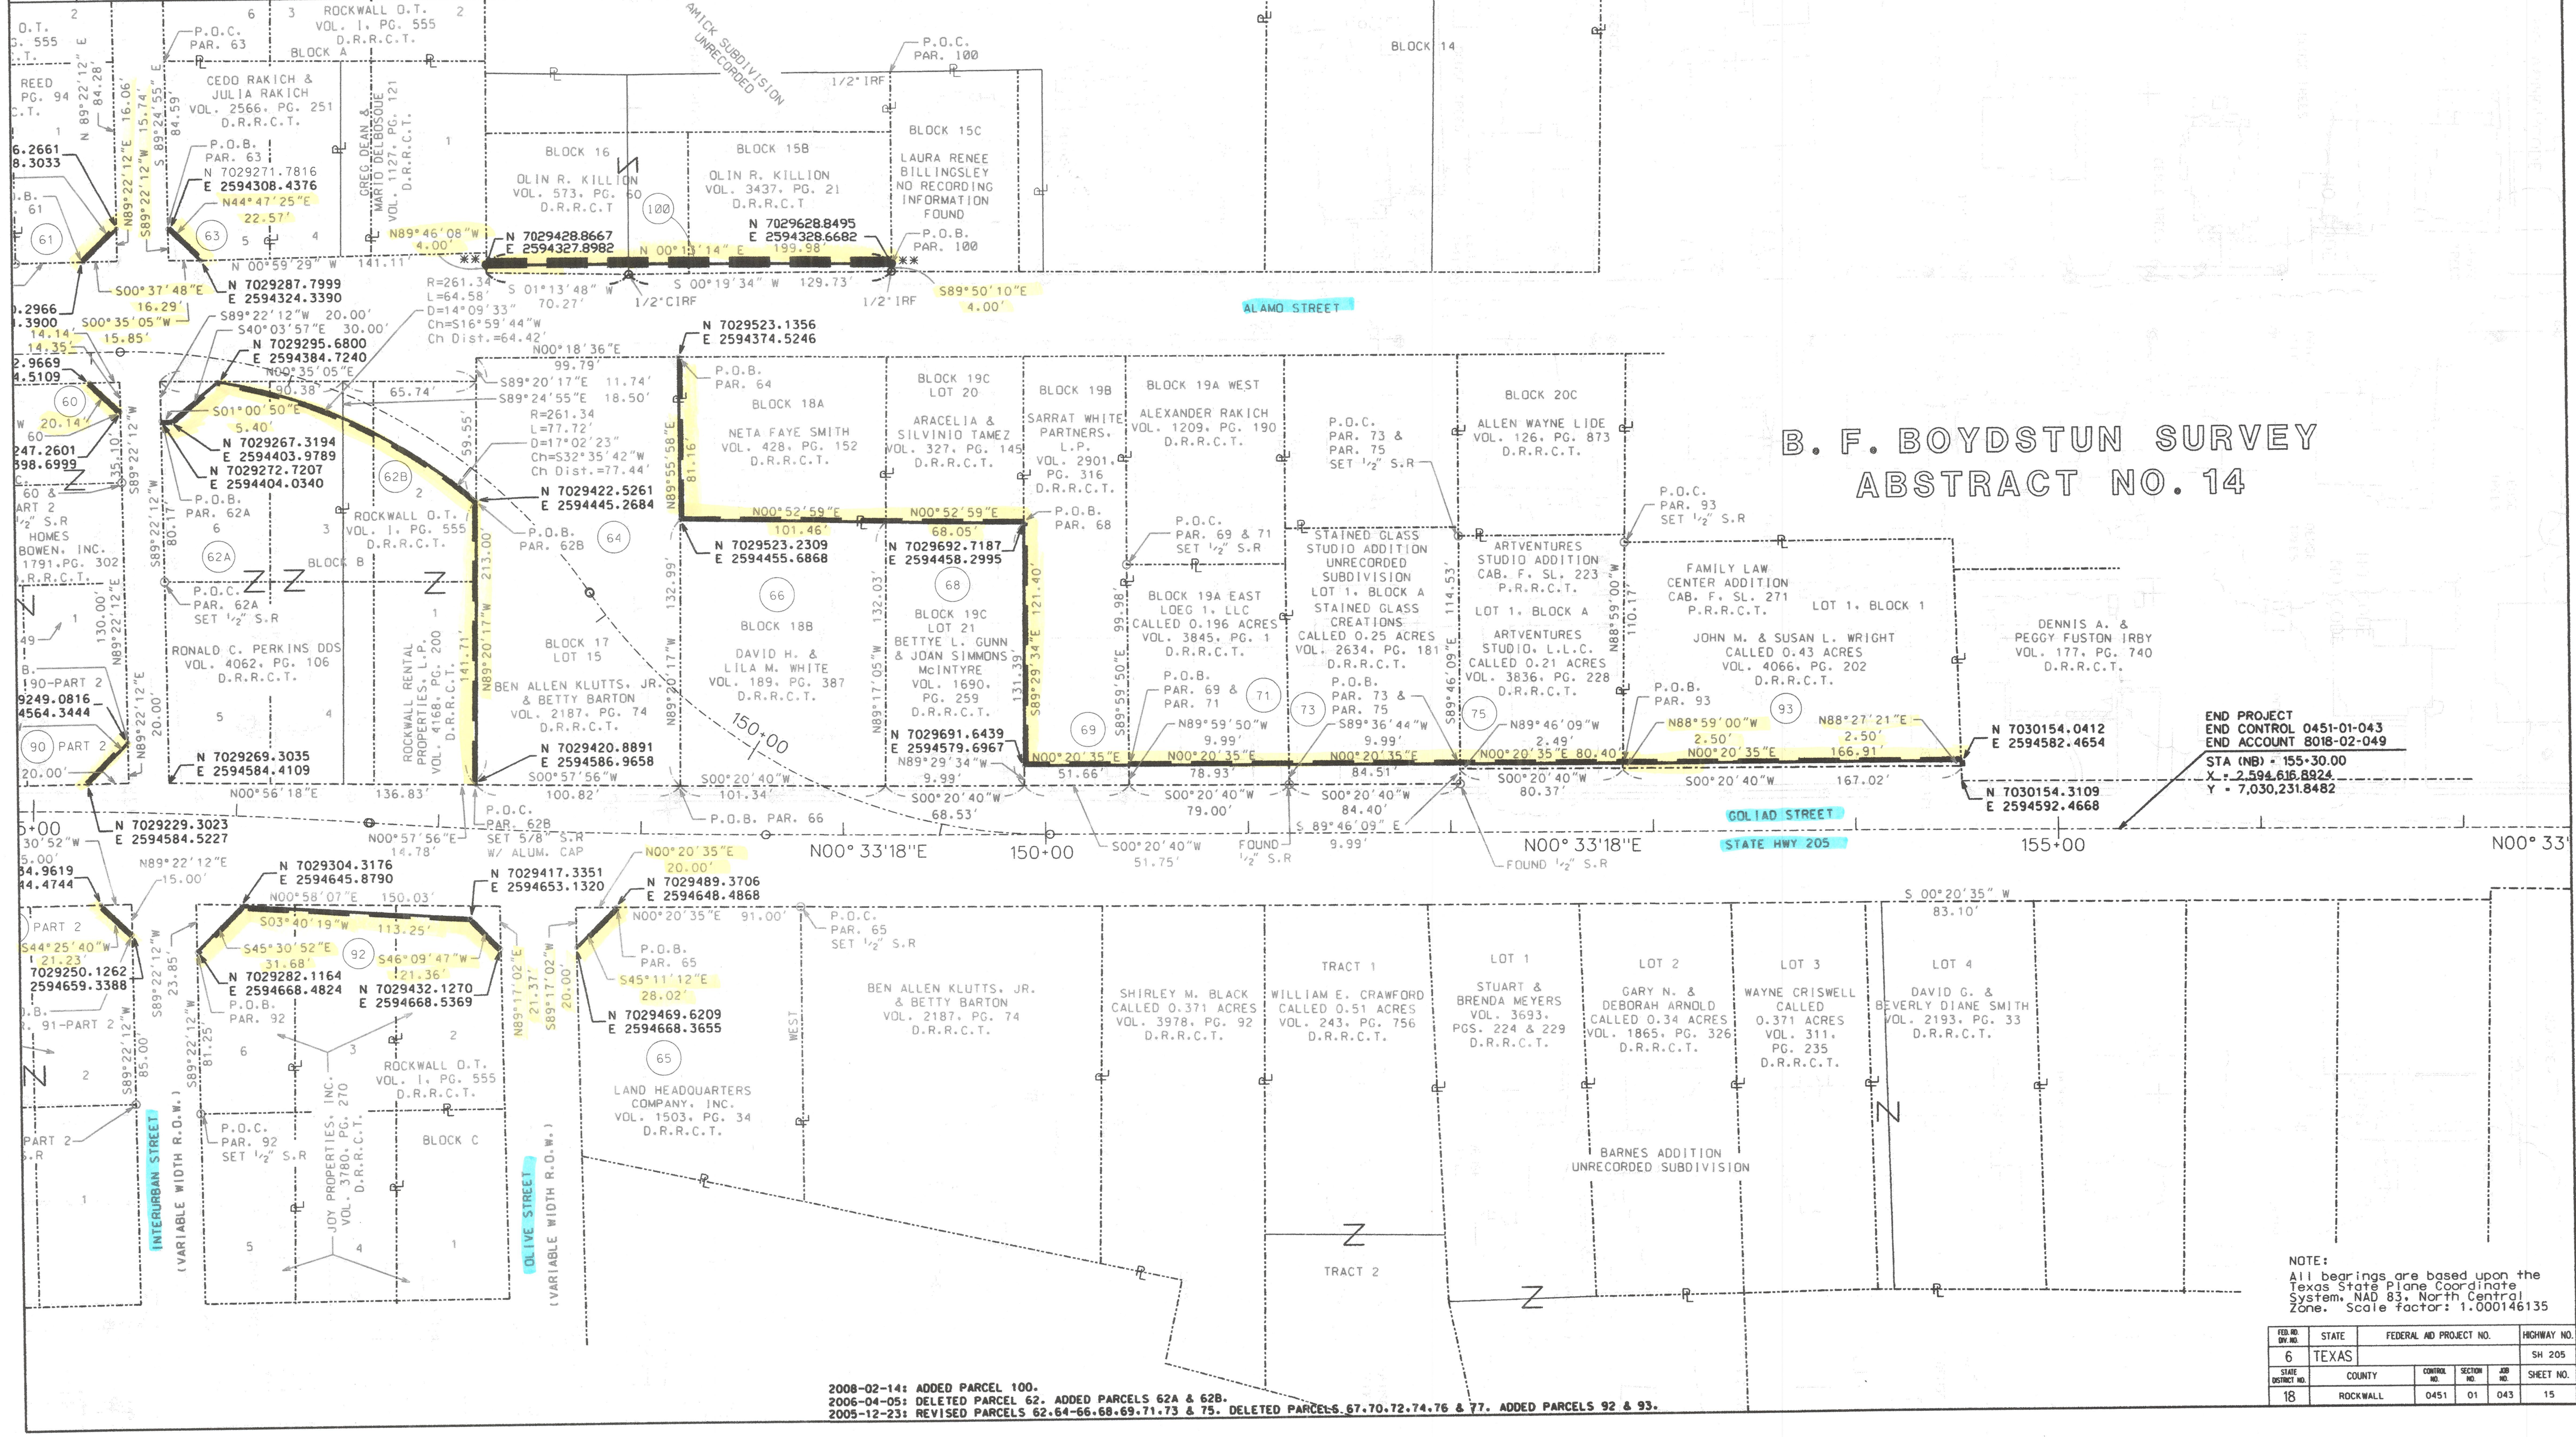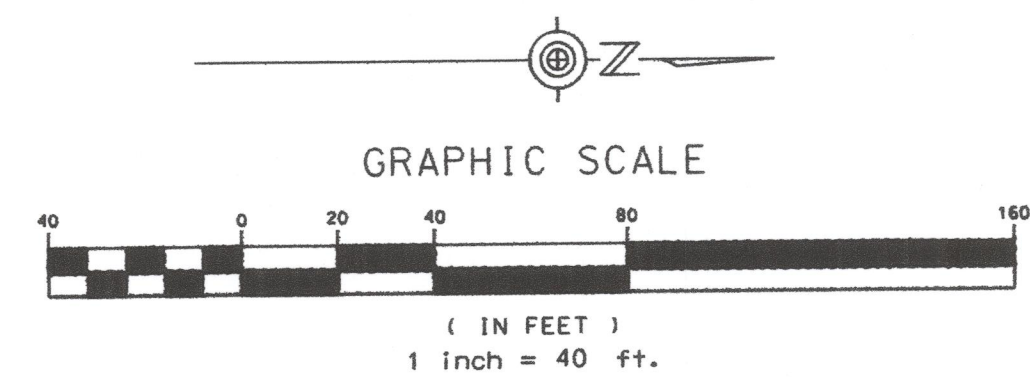

END PROJECT
END CONTROL 0451-01-043
END ACCOUNT 8018-02-049
STA (NB) = 155+30.00
X = 2,594,616.8824
Y = 7,030,231.8482

NOTE:
All bearings are based upon the Texas State Plane Coordinate System, NAD 83, North Central Zone. Scale factor: 1.000146135

2008-02-14: ADDED PARCEL 100.
2006-04-05: DELETED PARCEL 62. ADDED PARCELS 62A & 62B.
2005-12-23: REVISED PARCELS 62, 64-66, 68, 69, 71, 73 & 75. DELETED PARCELS 67, 70, 72, 74, 76 & 77. ADDED PARCELS 92 & 93.

FED. RD. DIST. NO.	STATE	FEDERAL AID PROJECT NO.	HIGHWAY NO.
6	TEXAS		SH 205
STATE DISTRICT NO.	COUNTY	CONTROL NO.	SECTION NO.
18	ROCKWALL	0451	01