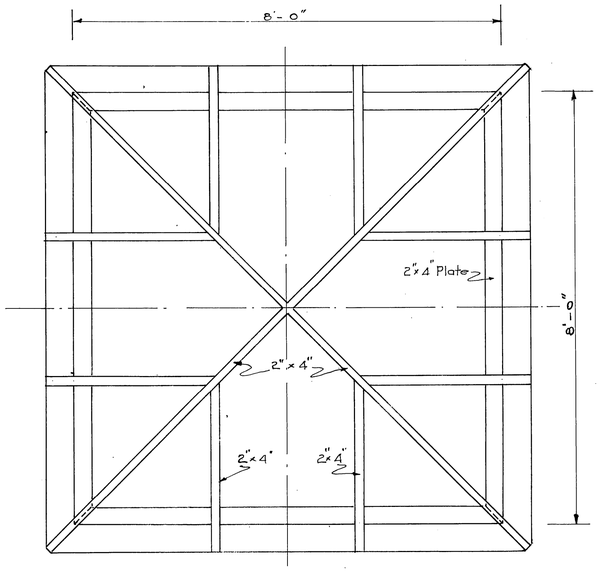

ROOF FRAMING
Scale: 3/4" = 1'-0"

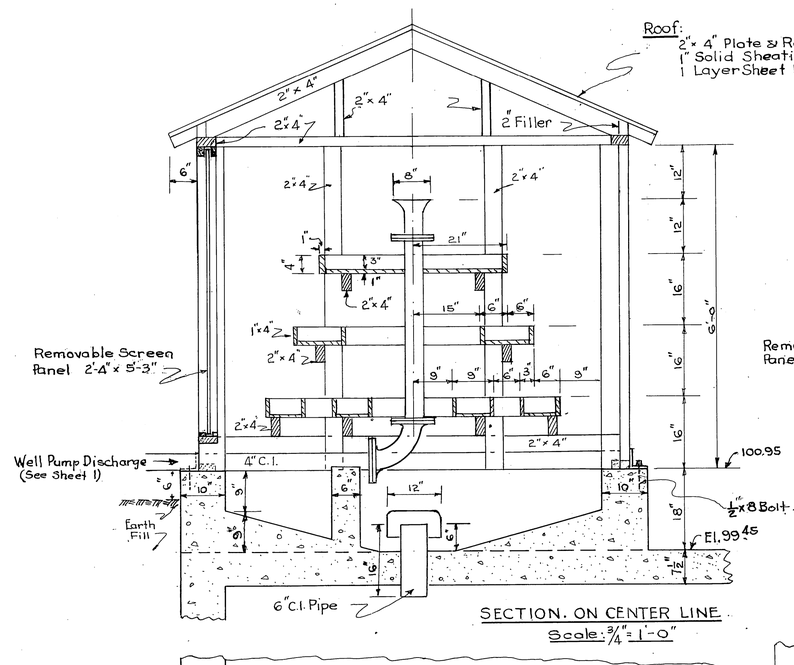

SECTION. ON CENTER LINE
Scale: 3/4" = 1'-0"

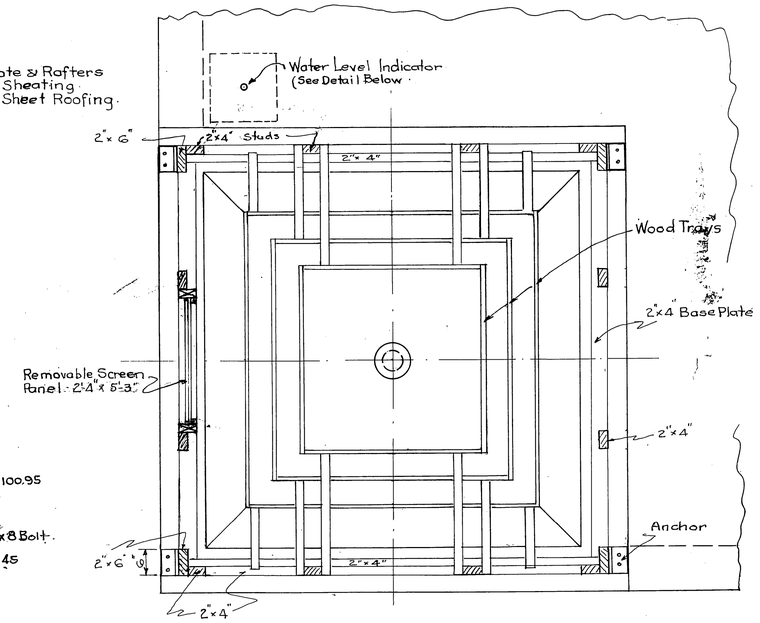

PLAN AT TOP OF BELL MOUTH
Scale: 3/4" = 1'-0"

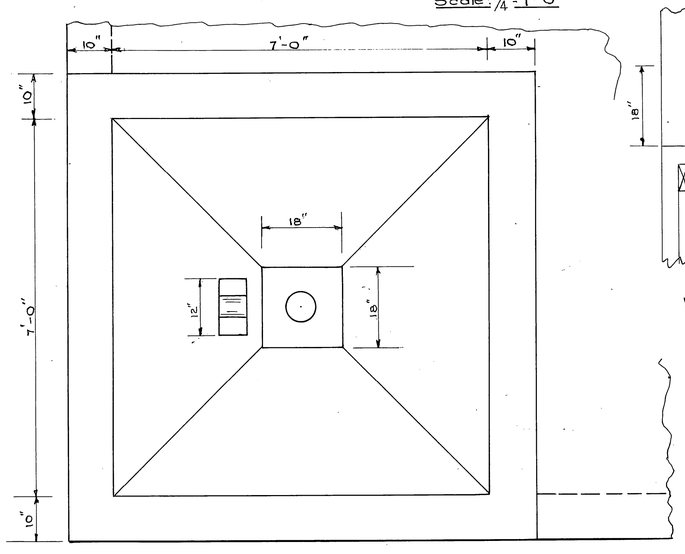

PLAN OF CONCRETE
Scale: 3/4" = 1'-0"

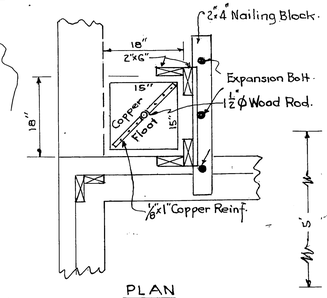

PLAN
WATER LEVEL INDICATOR
Scale: 3/4" = 1'-0"

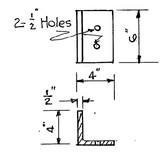

DETAIL OF ANCHOR
Scale: 1/2" = 1'-0"

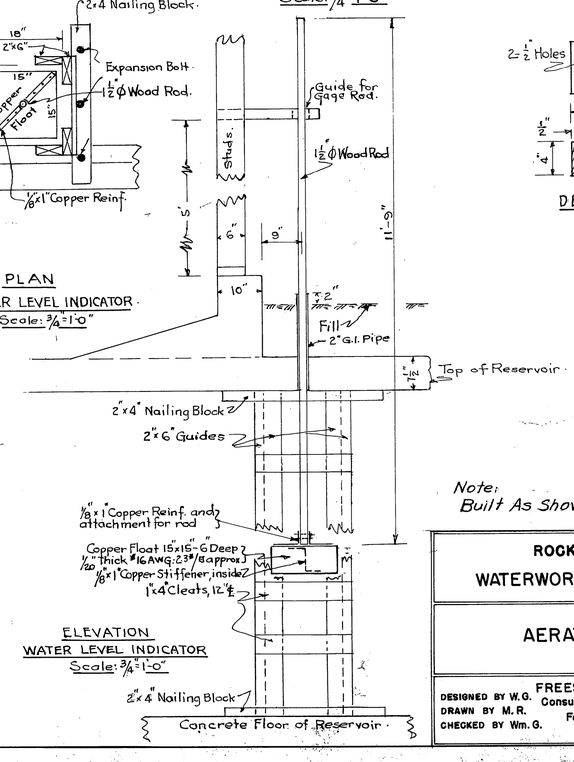

ELEVATION
WATER LEVEL INDICATOR
Scale: 3/4" = 1'-0"

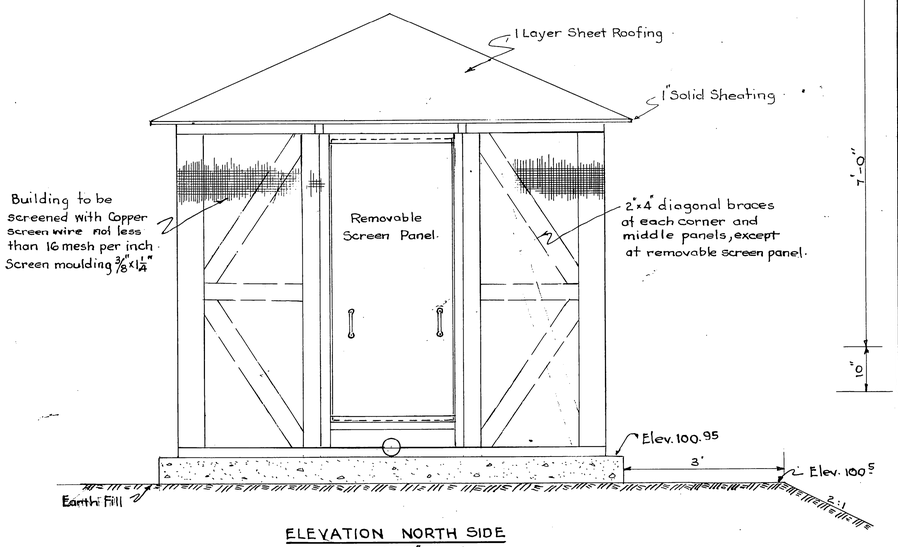

ELEVATION NORTH SIDE
Scale: 3/4" = 1'-0"

Note:
Built As Shown

ROCKWALL, TEXAS	
WATERWORKS IMPROVEMENTS	
AERATOR DETAILS	
DESIGNED BY W.G. DRAWN BY M.R. CHECKED BY Wm. G.	FREESE & NICHOLS Consulting Engineers Fort Worth, Texas
4504-5	AUGUST 1945

002