UNDERGROUND UTILITIES

THE LOCATION OF EXISTING UTILITIES SHOWN ON THESE PLANS ARE APPROXIMATE AND BASED ON DATA FURNISHED BY UTILITY COMPANIES. IT IS THE RESPONSIBILITY OF THE CONTRACTOR TO LOCATE AND VERIFY ON-SITE THE UTILITIES THAT MAY CONFLICT WITH THE CONSTRUCTION.

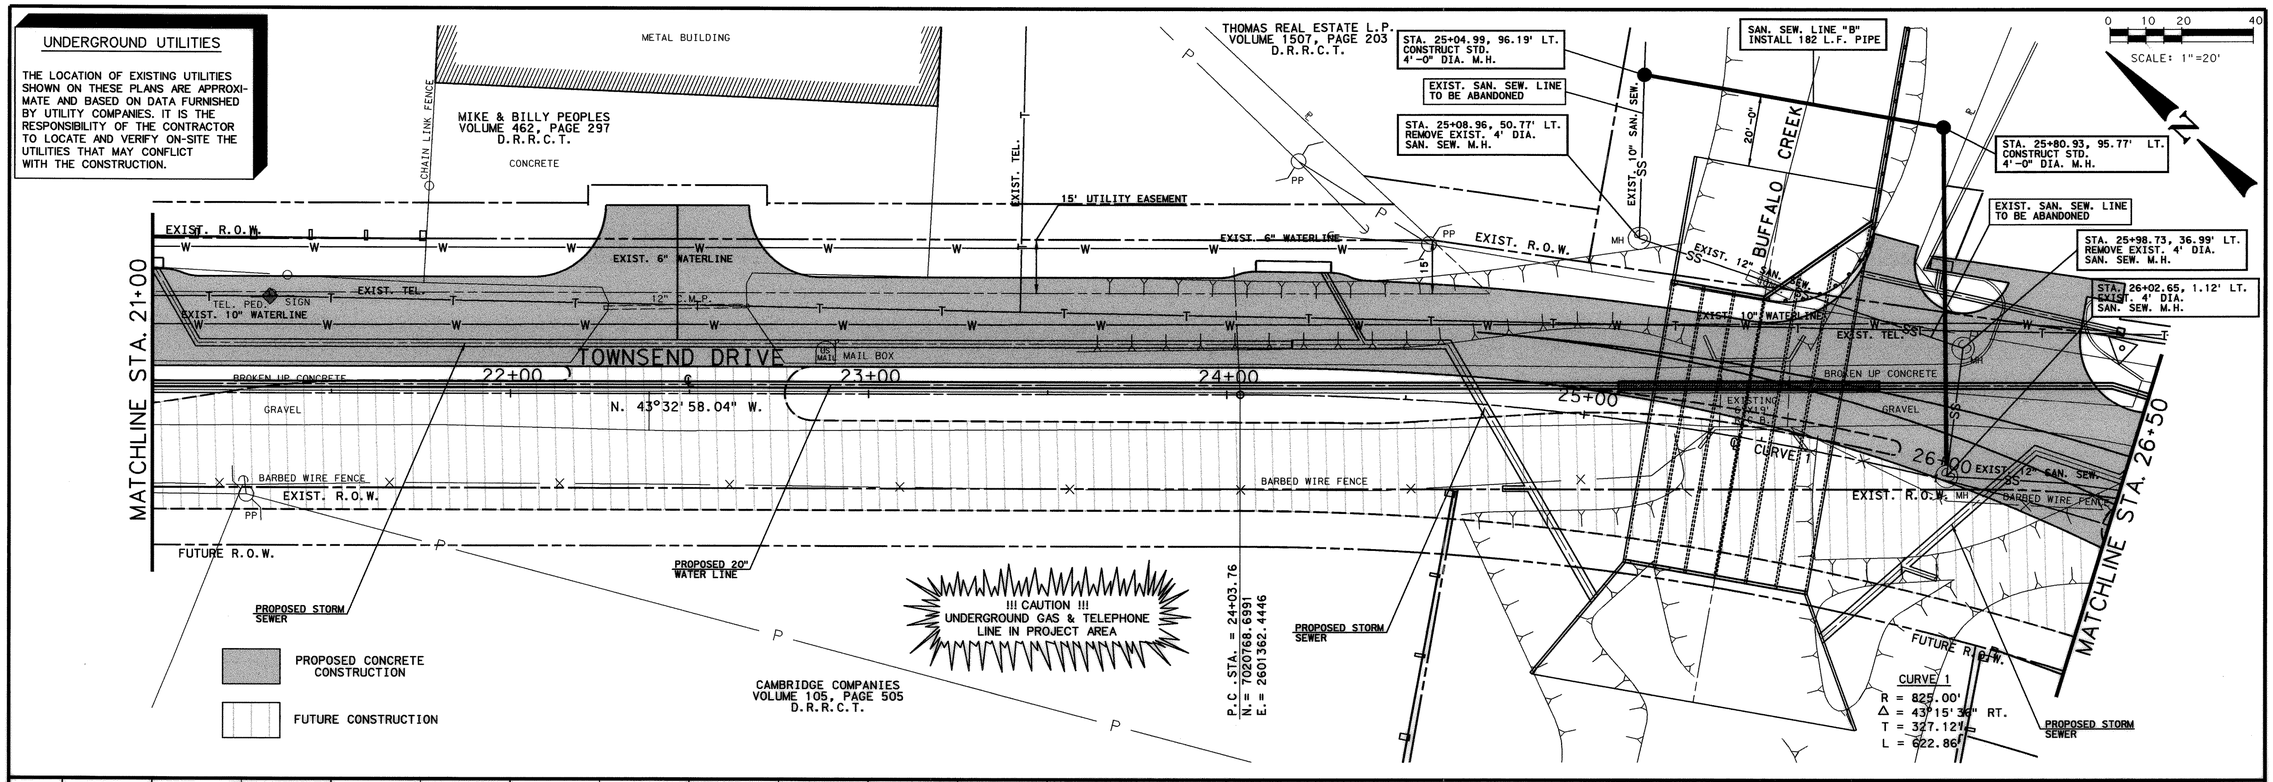

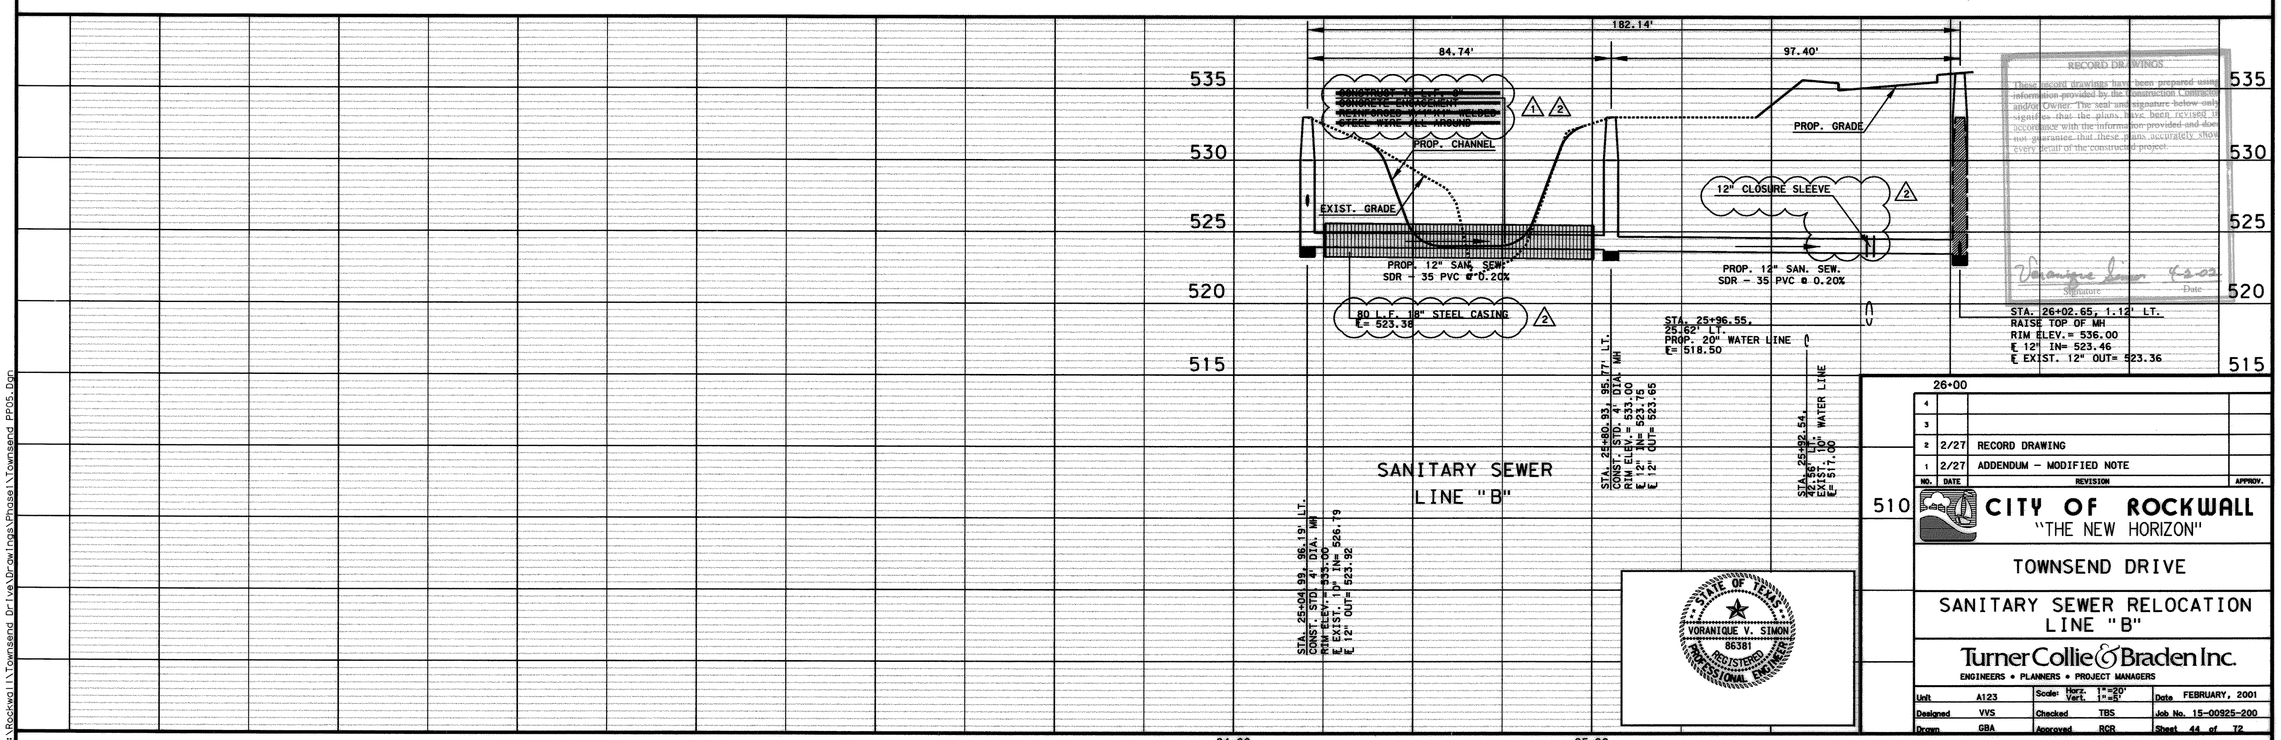

RECORD DRAWINGS

These record drawings have been prepared using information provided by the Construction Contractor and/or Owner. The seal and signature below only signifies that the plans have been revised in accordance with the information provided and does not guarantee that these plans accurately show every detail of the constructed project.

Veronique Simon 4-2-02
Signature Date

STATE OF TEXAS
VORANIQUE V. SIMON
86381
REGISTERED
PROFESSIONAL ENGINEER

NO.	DATE	REVISION	APPROV.
4			
3			
2	2/27	RECORD DRAWING	
1	2/27	ADDENDUM - MODIFIED NOTE	

CITY OF ROCKWALL
"THE NEW HORIZON"

TOWNSEND DRIVE

SANITARY SEWER RELOCATION
LINE "B"

Turner Collie & Braden Inc.
ENGINEERS • PLANNERS • PROJECT MANAGERS

Unit	A123	Scale: Horz. 1"=20' Vert. 1"=5'		Date	FEBRUARY, 2001
Designed	VVS	Checked	TBS	Job No.	15-00925-200
Drawn	GBA	Approved	RCR	Sheet	44 of 72

P:\Rockwall\Townsend Drive\Drawings\Phase1\Townsend_PP05.Dgn