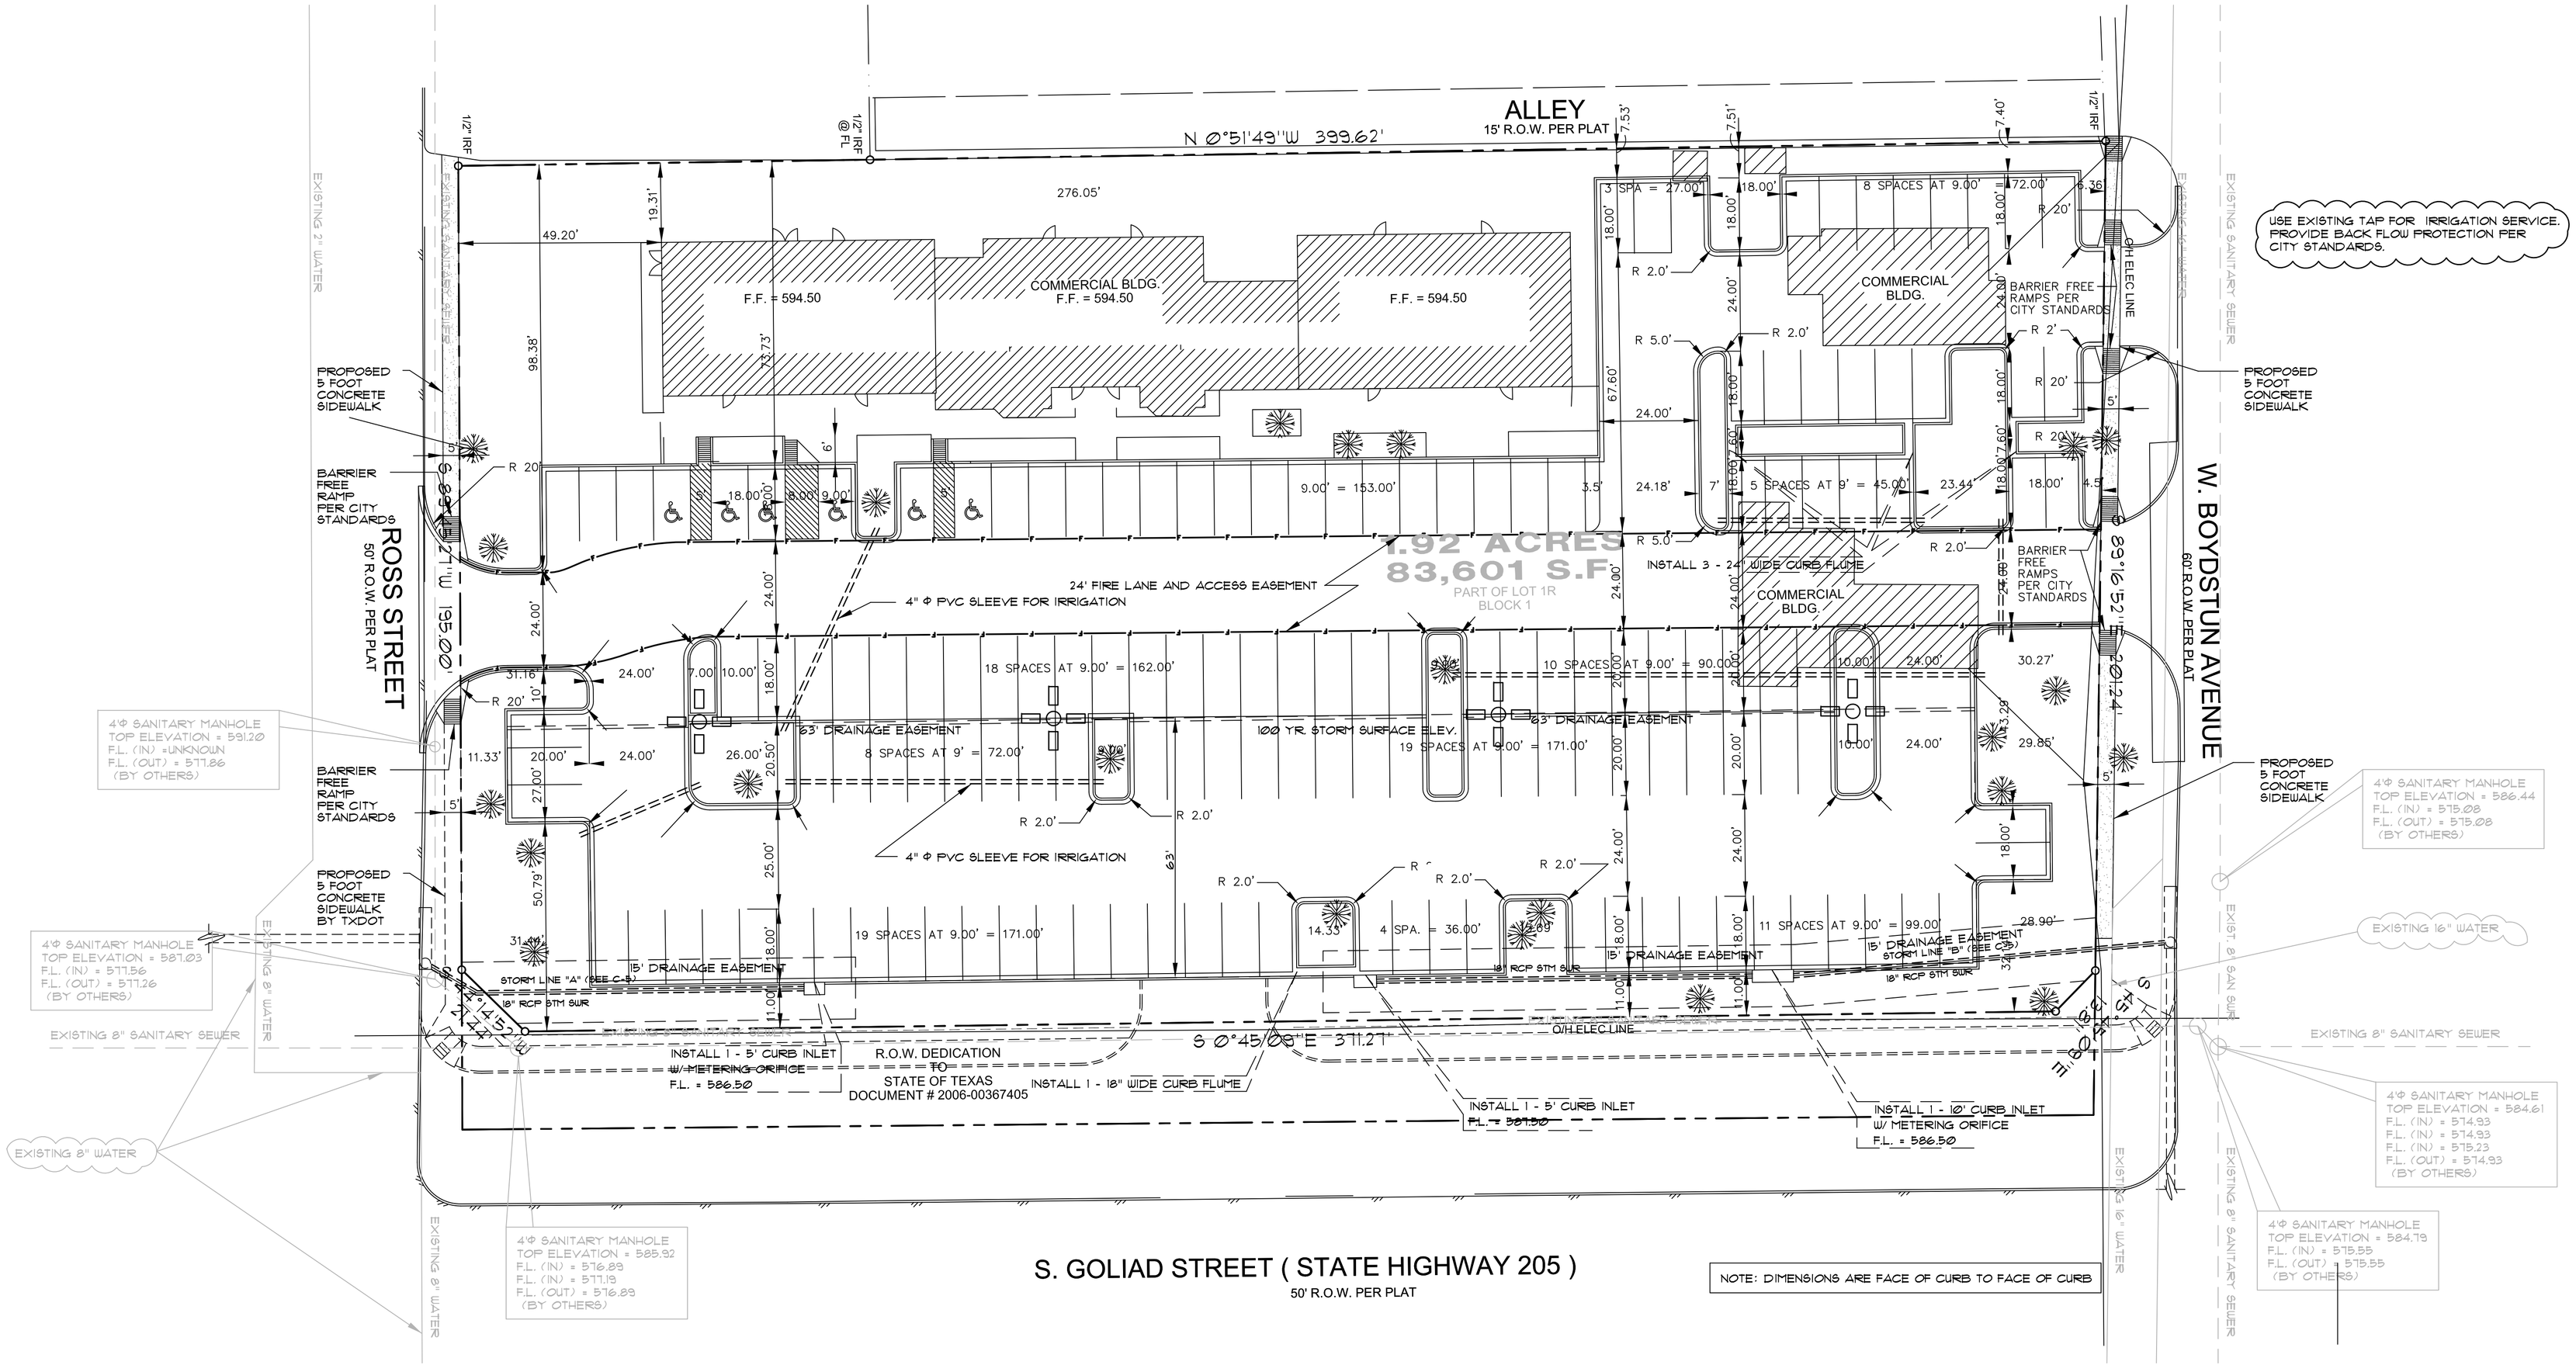

N

SCALE 1"= 20'

0 20 40 60 80 100

RECORD DRAWINGS
FEBRUARY 10, 2010

STATE OF TEXAS
JOSEPH T. PITT
33944
REGISTERED PROFESSIONAL ENGINEER
08/28/08

TMBP
CONSULTING ENGINEERS INC.
2301 NORTH AKARD ST. SUITE 405
DALLAS, TEXAS 75201
(214) 871-2302 (214) 871-8716 FAX

REV. NO.	TYPE OF WORK	ENG.	DATE	CITY OF ROCKWALL	DATE

DIMENSION CONTROL PLAN

2008 PARKING ADDITION

FIRST BAPTIST CHURCH – ROCKWALL, TX

PUBLIC WORKS DEPARTMENT

CITY OF ROCKWALL, TEXAS

DESIGN	DRAWN	DATE	SCALE	NOTES	FILE	NO.
J. PITT	R.MITCH	AUG 28 2008				C-1

FIRST BAPTIST CHURCH PARKING ADDITION