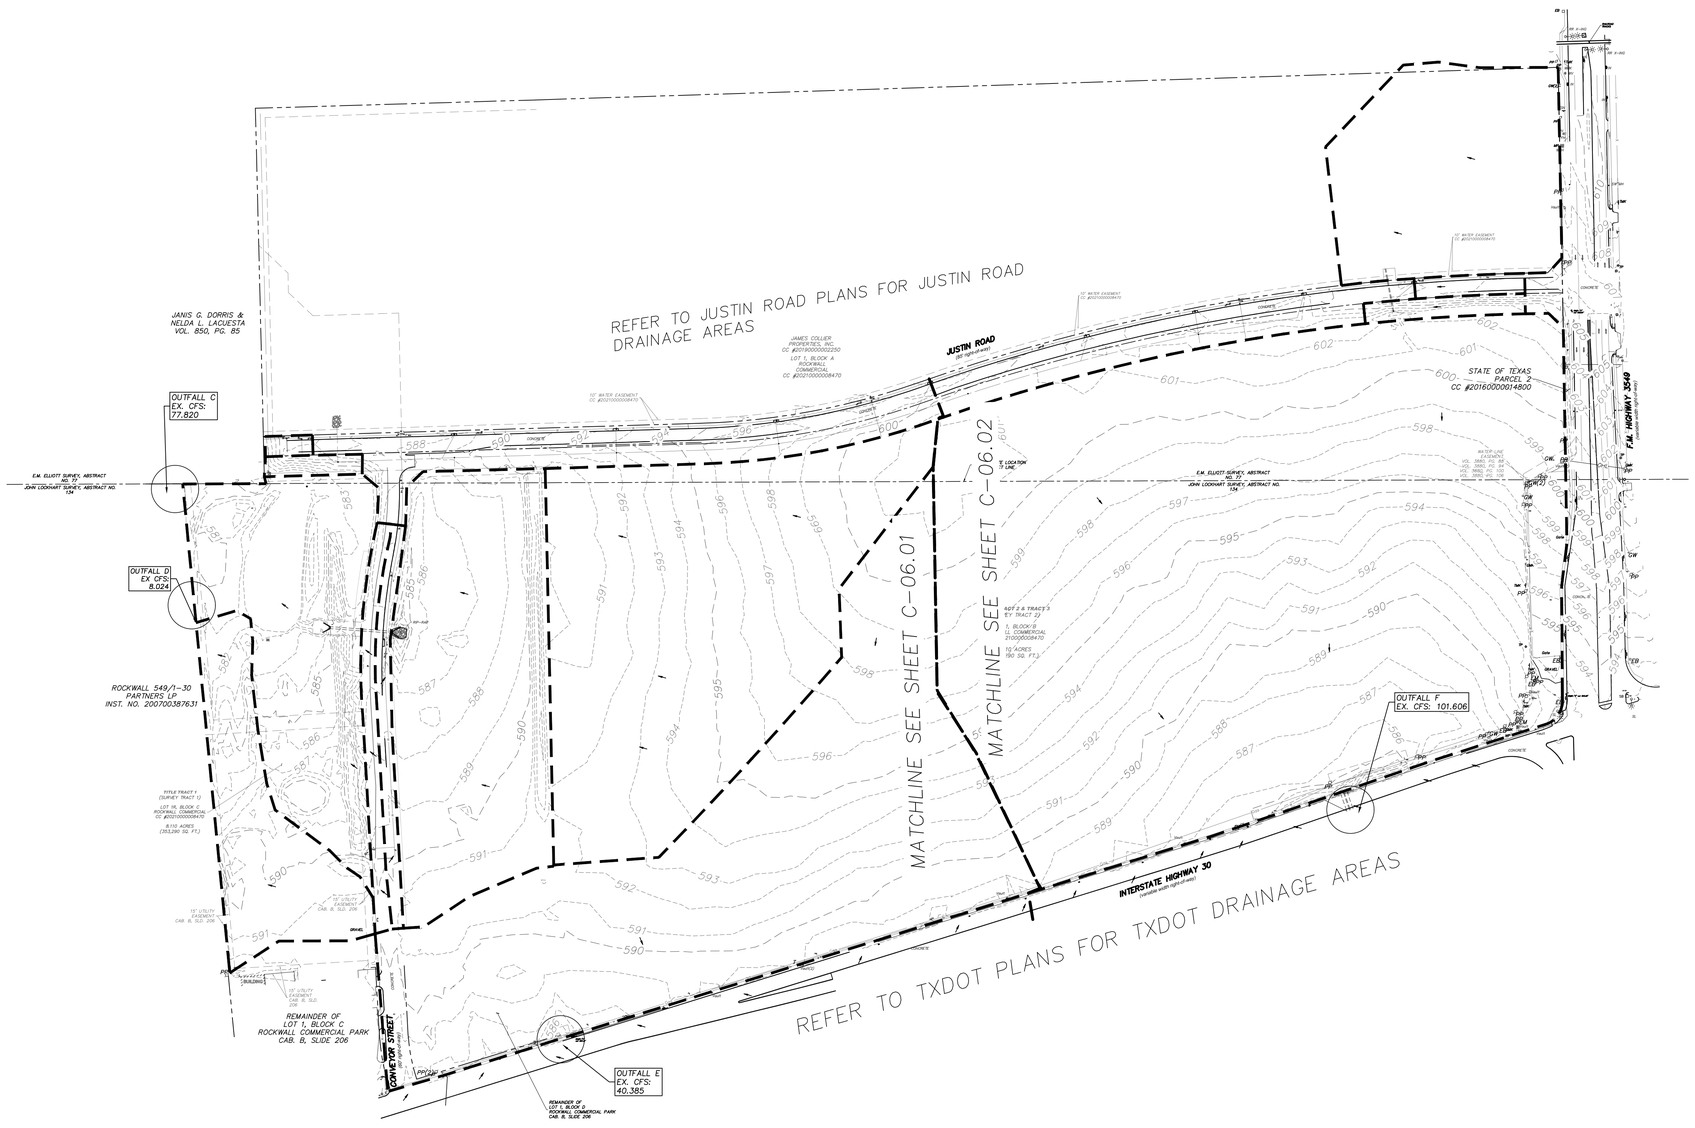

N
W E
S

0 150 300
Scale: 1" = 150'

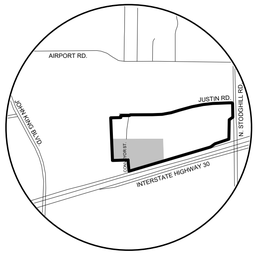

VICINITY MAP
NOT TO SCALE

BEFORE YOU DIG
Texas811

DRAINAGE AREA MAP LEGEND

- #(X) — DRAINAGE AREA I.D.
- 0.151 — OUTFALL I.D.
- 2cfs — ACREAGE
- Q100
- EXISTING DRAINAGE AREA DIVIDES
- FLOW ARROW
- 465 — EXISTING CONTOURS

AS-BUILT

THIS RECORD DRAWING IS COMPILATION OF A COPY OF THE SEALED ENGINEERING DRAWING FOR THIS PROJECT; MODIFIED BY ADDENDA, CHANGE ORDERS, AND INFORMATION FURNISHED BY THE CONTRACTOR. THE INFORMATION SHOWN ON THE RECORD DRAWINGS THAT WAS PROVIDED BY THE CONTRACTOR OR OTHERS NOT ASSOCIATED WITH THE DESIGN ENGINEER CANNOT BE VERIFIED FOR ACCURACY OR COMPLETENESS. THE ORIGINAL SEALED DRAWING ARE ON FILE AT THE OFFICES OF WINKELMANN AND ASSOCIATES, INC.

WINKELMANN AND ASSOCIATES, INC. — 04-20-2026 DATE

No.	DATE	REVISION	APPROV.
1.			
2.			
3.			
4.			
5.			

LAST SAVED BY: COLUCSA April 20, 2026

Winkelmann & Associates, Inc.
CONSULTING CIVIL ENGINEERS ■ SURVEYORS
4750 HILLCREST PLAZA DRIVE, SUITE 215
DALLAS, TEXAS 75230 (972) 490-1099 FAX
Texas Engineers Registration No. F-1046
Texas Surveyors Registration No. 10028800

COPYRIGHT © 2026, Winkelmann & Associates, Inc.

STATE OF TEXAS
WILLIAM R. WINKELMANN
120378
LICENSED
PROFESSIONAL ENGINEER

02-25-2025
THE SEAL APPEARING ON THIS DOCUMENT WAS AUTHORIZED BY WILLIAM R. WINKELMANN, P.E. # 120378

EXISTING DRAINAGE AREA KEYMAP

I-30 FRONTAGE RD & FM 3549
ROCKWALL, TX

63406

IKEA @ ROCKWALL HEIGHTS

C-06.00

C:\63406\ENGINEERING\Construction Plans\63406-EX DAM.dwg