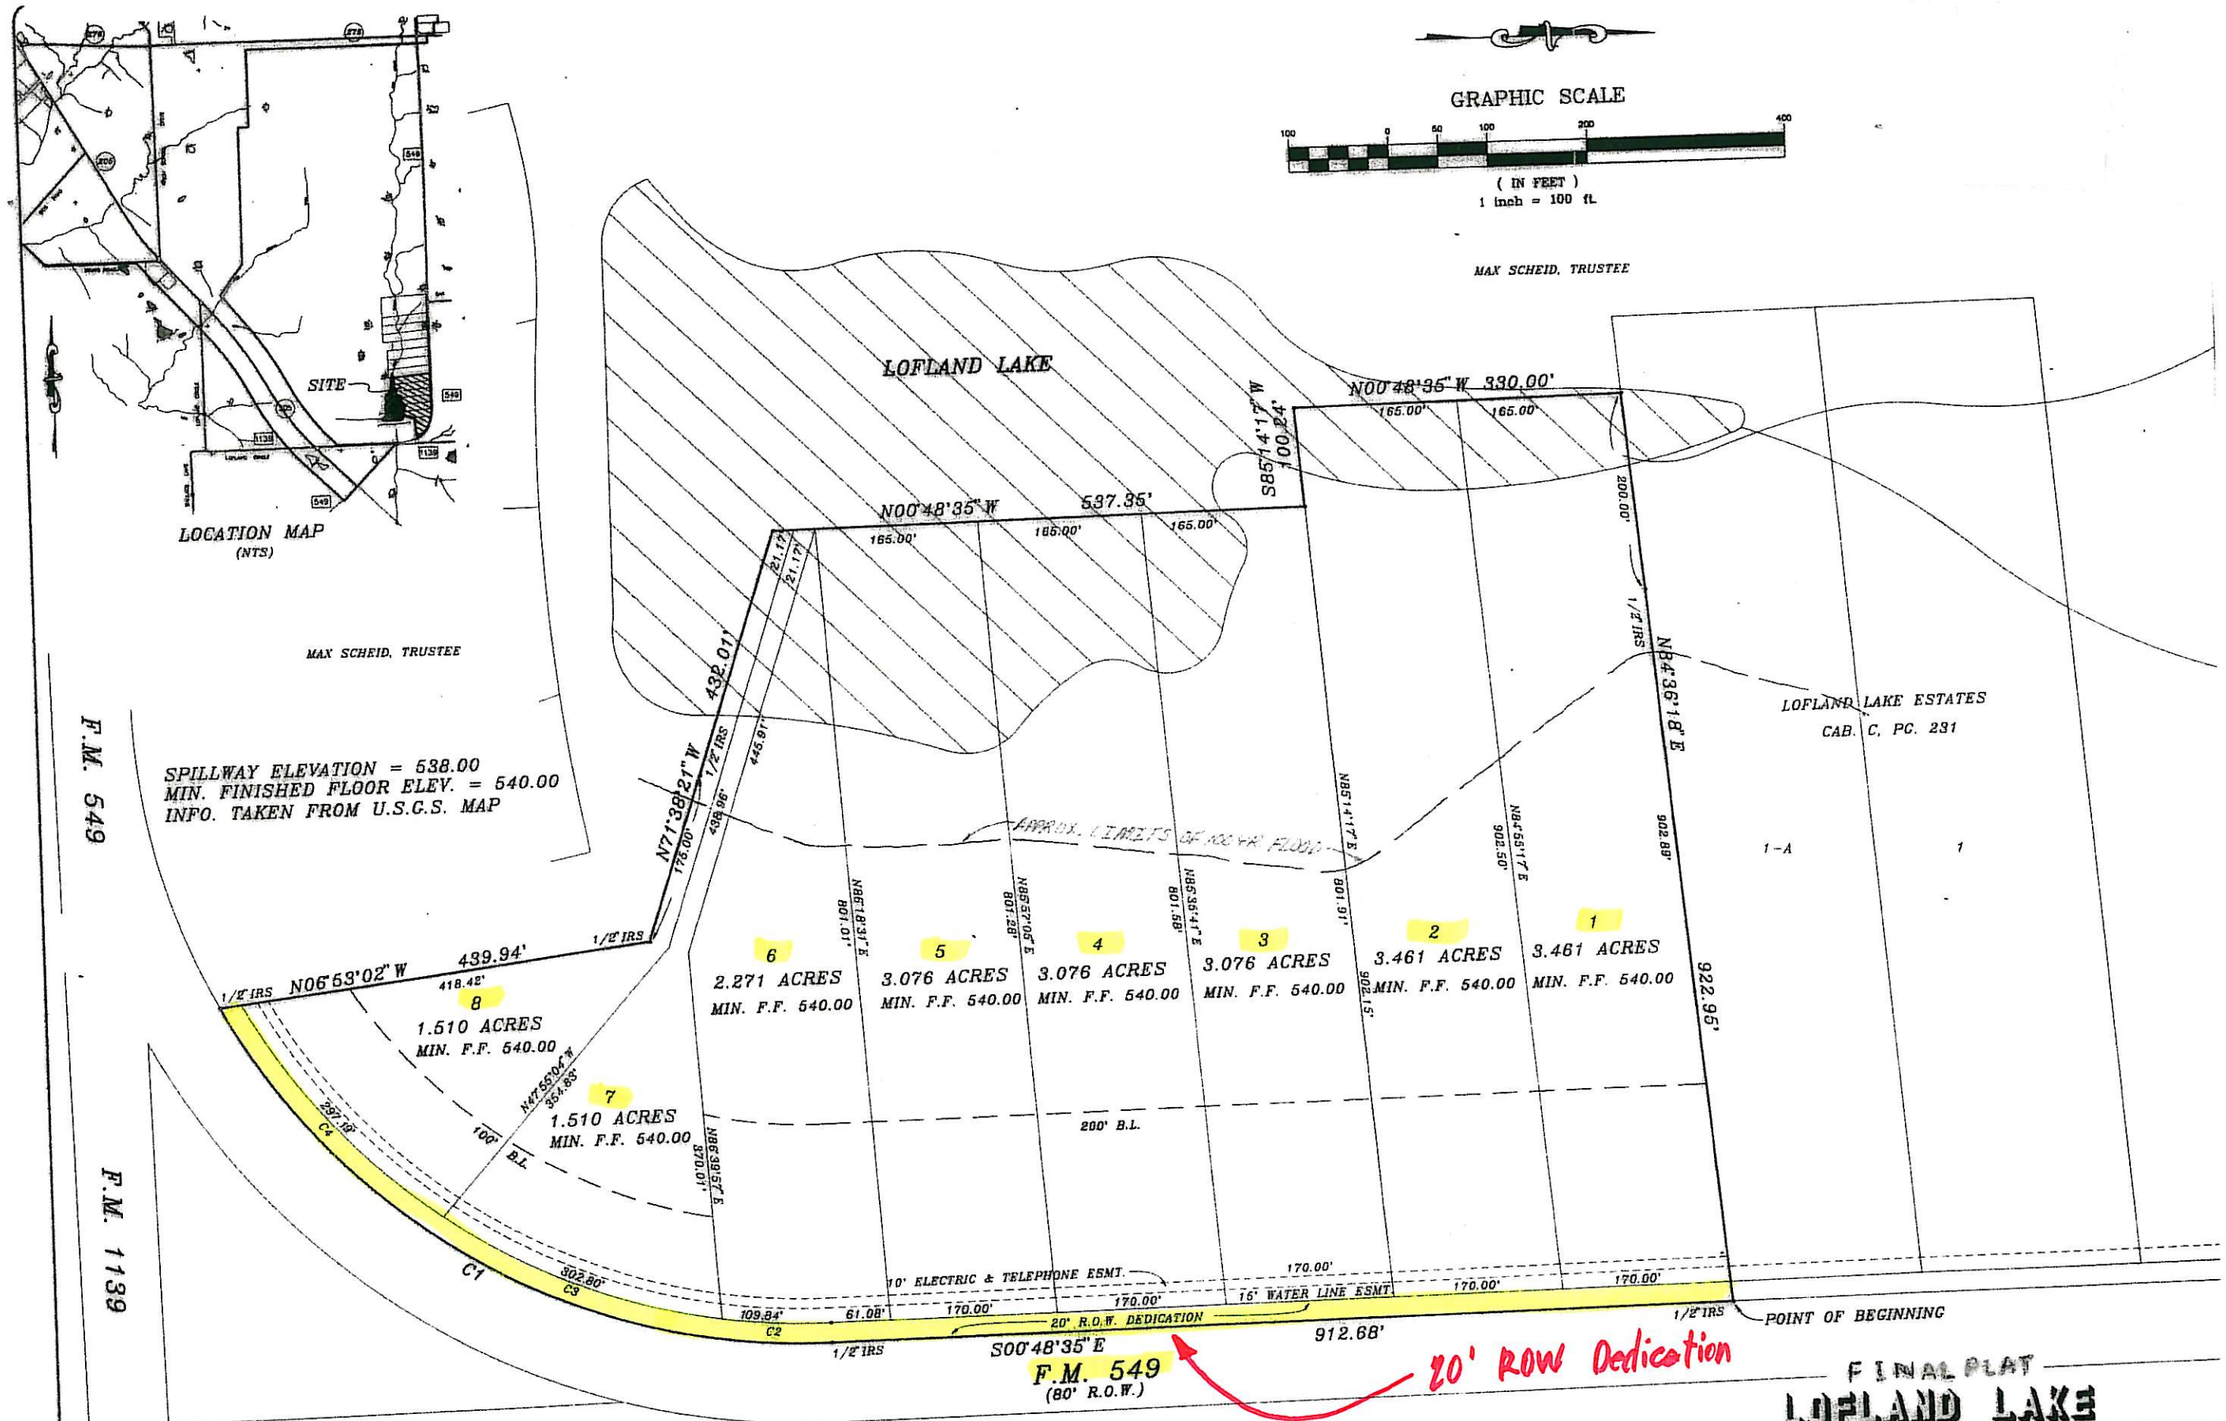

CURVE	RADIUS	LENGTH	TANGENT	CHORD	BEARING	DELTA
C1	676.76'	739.50'	411.54'	703.26'	S30°29'39"W	62°36'28"
C2	656.76'	109.84'	55.05'	109.71'	N03°58'53"E	09°34'57"
C3	656.76'	302.80'	154.14'	300.12'	N21°58'51"E	26°24'58"
C4	656.76'	297.19'	151.18'	294.66'	N48°09'08"E	25°55'36"

FINAL PLAT

LOFLAND LAKE ESTATES NO. 2

A. JOHNSON SURVEY ABST. NO. 123

ROCKWALL COUNTY, TEXAS

MAX SCHEID, TRUSTEE
3409 RIDGEDALE DRIVE, GARLAND, TEXAS 75041 (214) 270-4481

HAROLD L. EVANS
CONSULTING ENGINEER
P.O. BOX 28355
2331 GUS THOMASSON ROAD, SUITE 102
DALLAS, TEXAS 75228, (214) 328-8133

SCALE	DATE	JOB No.
1" = 100'	11/3/94	94142