TECH: RIVKIN F:\P\8770MA\277SZ203.PRF
Mon Apr 21 16:09:51 1997 PEN TABLE: F:\PLT-TBL\GARY1.TBL
DA:\SLD\9332701\GRA\277SZ203
PRF SCALE: 40.000000

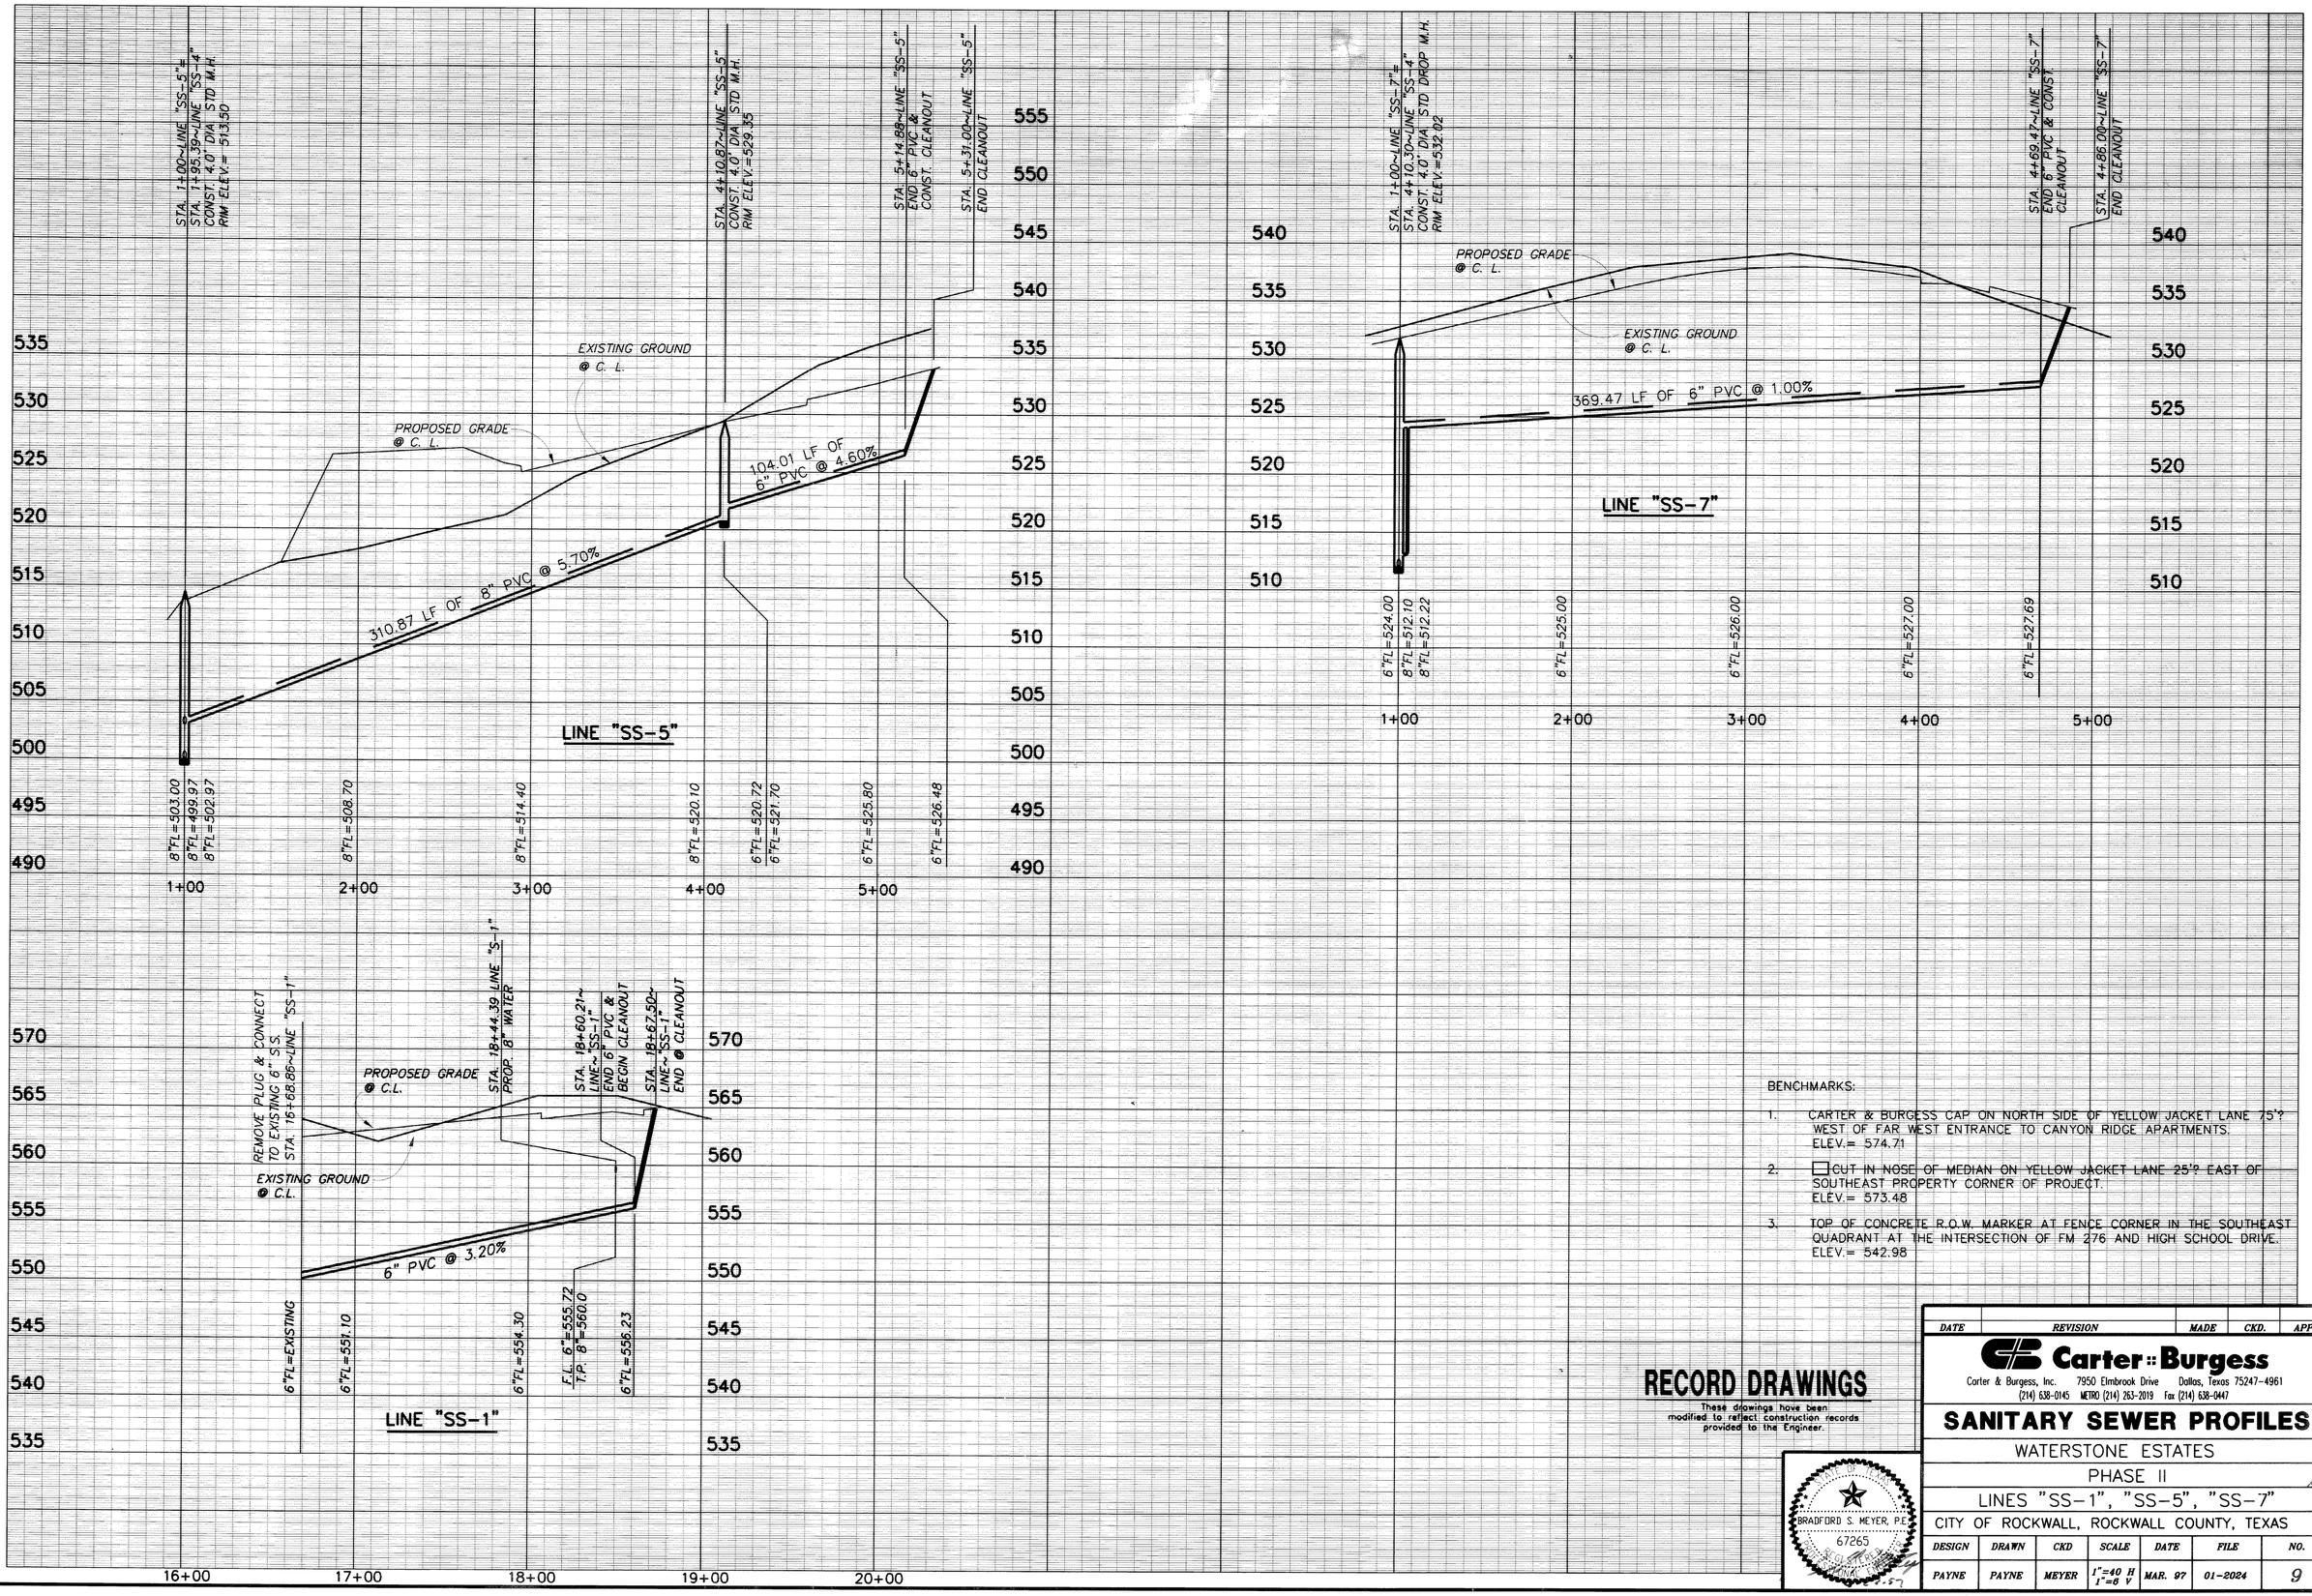

BENCHMARKS:

1. CARTER & BURGESS CAP ON NORTH SIDE OF YELLOW JACKET LANE 75'? WEST OF FAR WEST ENTRANCE TO CANYON RIDGE APARTMENTS. ELEV.= 574.71
2. ☐ CUT IN NOSE OF MEDIAN ON YELLOW JACKET LANE 25'? EAST OF SOUTHEAST PROPERTY CORNER OF PROJECT. ELEV.= 573.48
3. TOP OF CONCRETE R.O.W. MARKER AT FENCE CORNER IN THE SOUTHEAST QUADRANT AT THE INTERSECTION OF FM 276 AND HIGH SCHOOL DRIVE. ELEV.= 542.98

RECORD DRAWINGS

These drawings have been modified to reflect construction records provided to the Engineer.

DATE	REVISION	MADE	CKD.	APPD.

Carter :: Burgess
Carter & Burgess, Inc. 7950 Elmbrook Drive Dallas, Texas 75247-4961
(214) 638-0145 METRO (214) 263-2019 Fax (214) 638-0447

SANITARY SEWER PROFILES

WATERSTONE ESTATES

PHASE II

LINES "SS-1", "SS-5", "SS-7"

CITY OF ROCKWALL, ROCKWALL COUNTY, TEXAS

BRADFORD S. MEYER, P.E. 67265 REGISTERED

DESIGN	DRAWN	CKD	SCALE	DATE	FILE	NO.
PAYNE	PAYNE	MEYER	1"=40' H 1"=8' V	MAR. 97	01-2024	9